


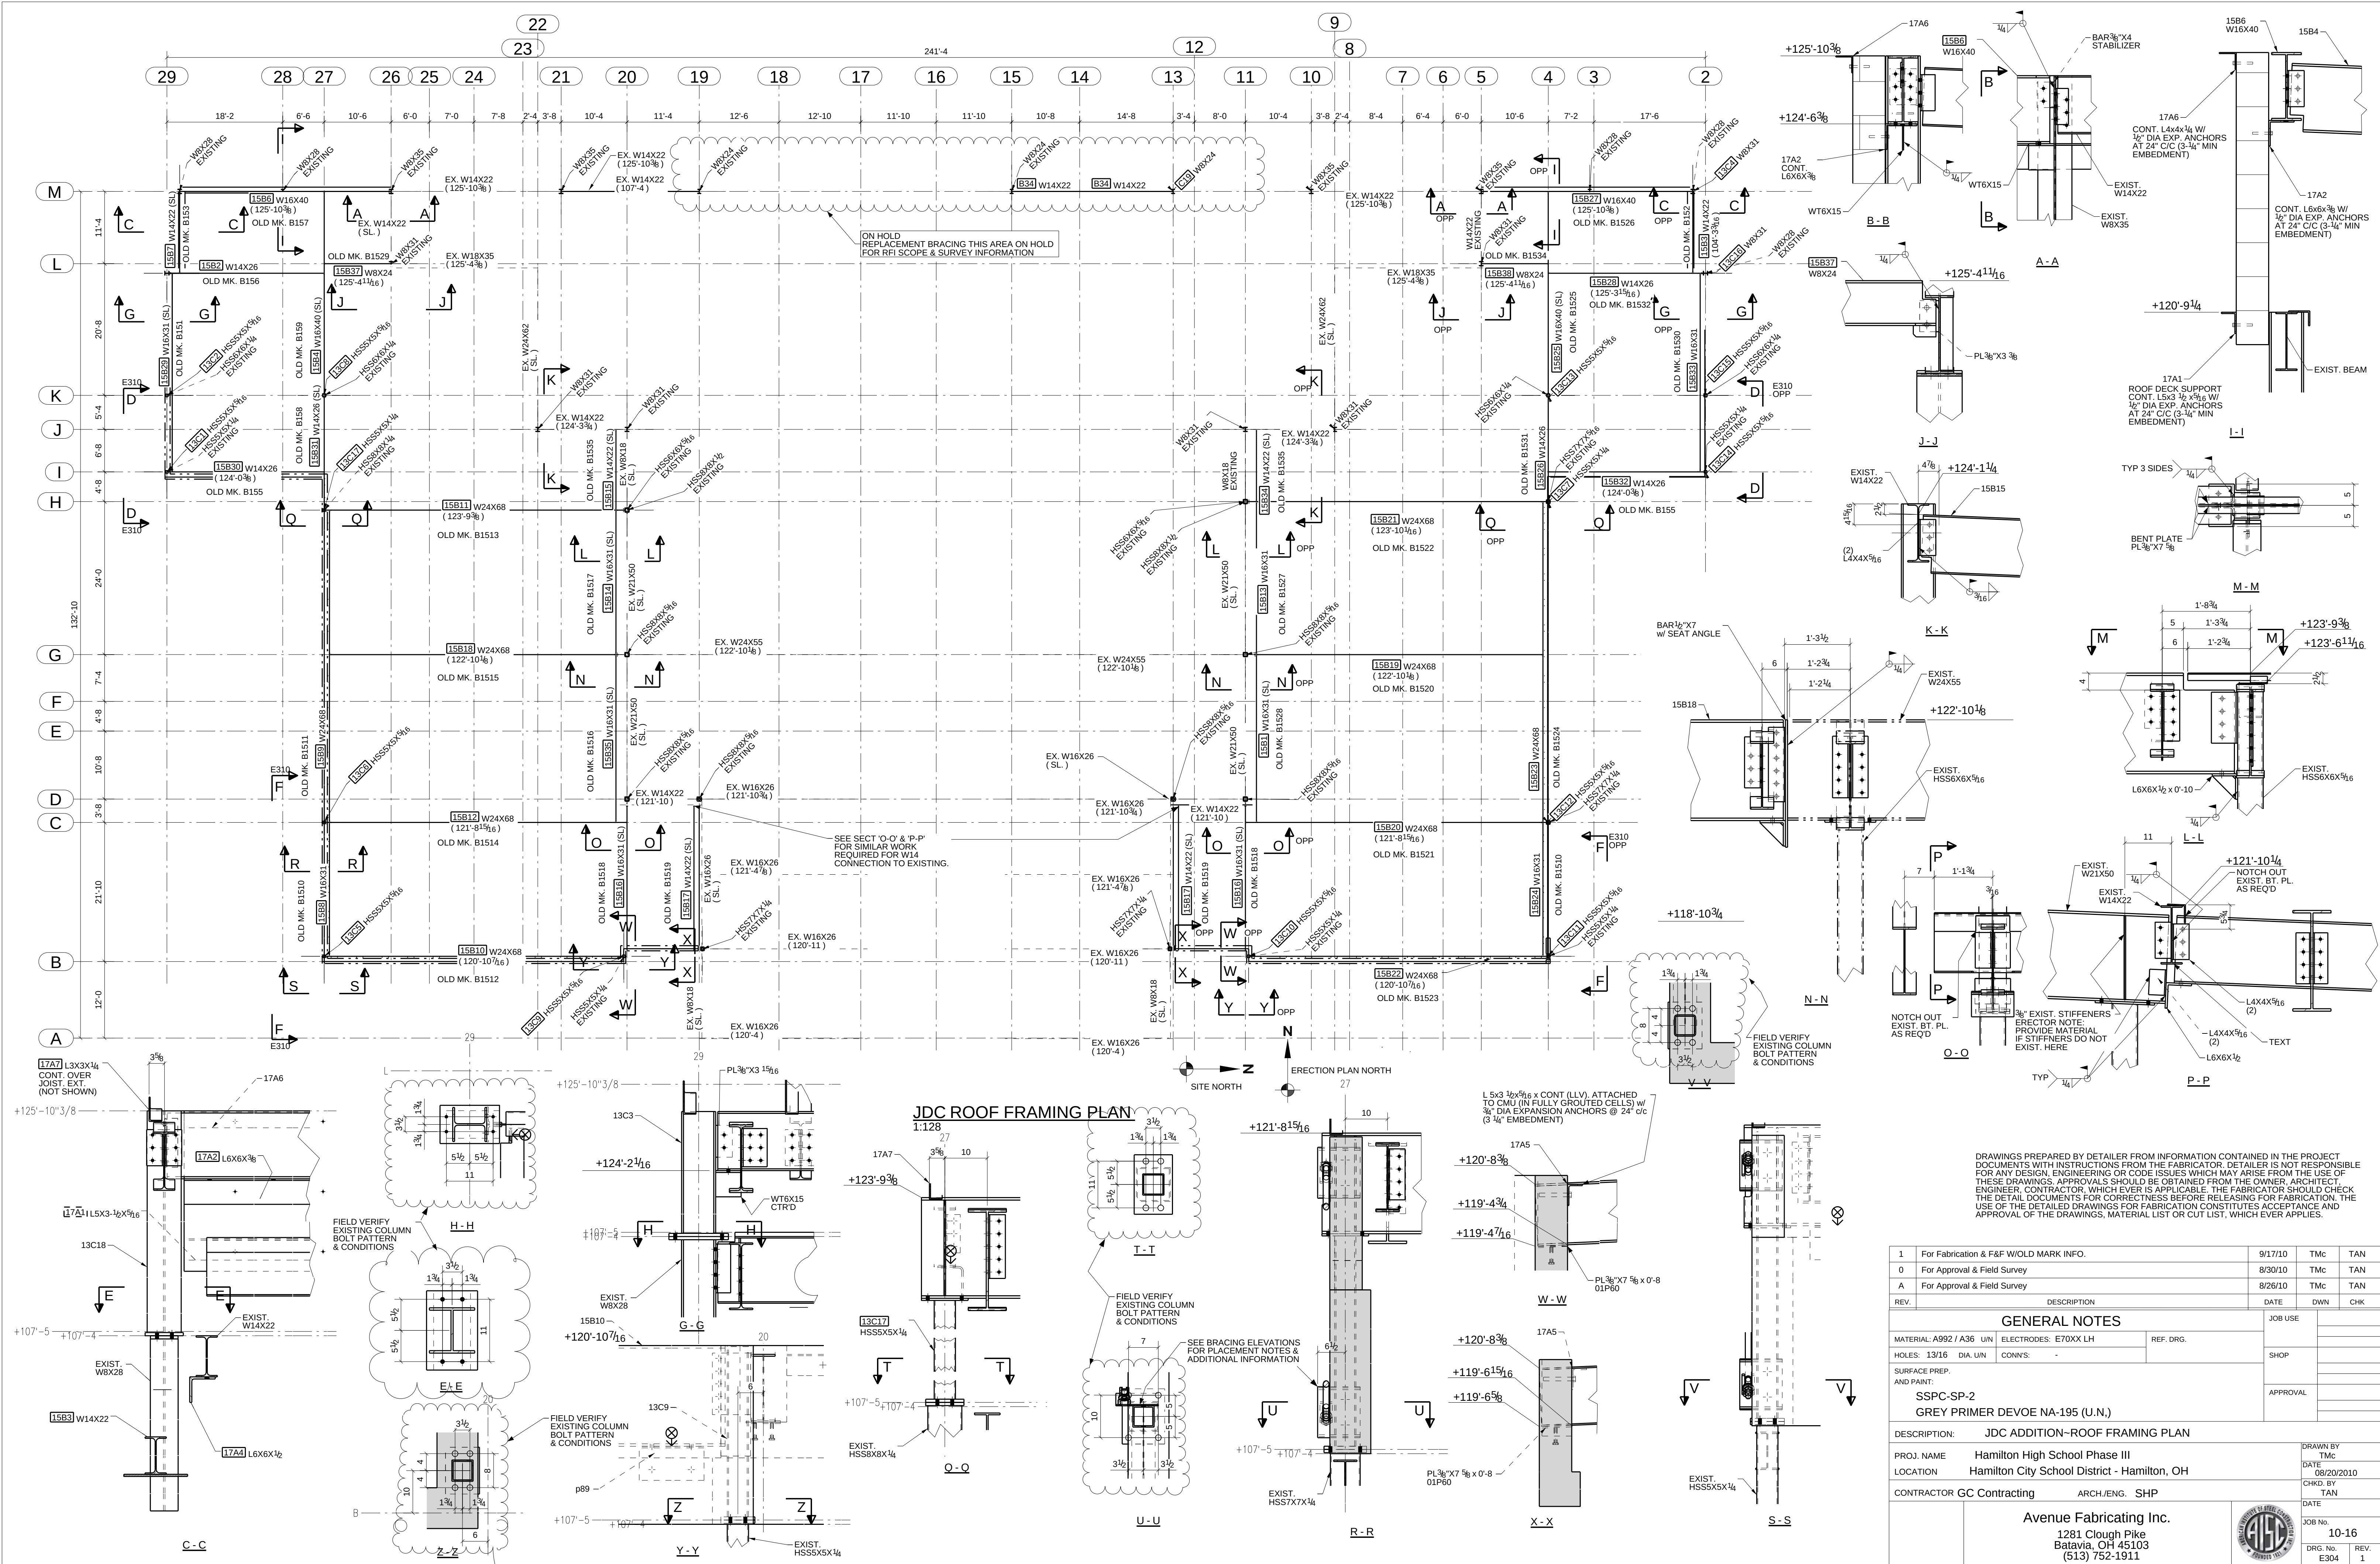
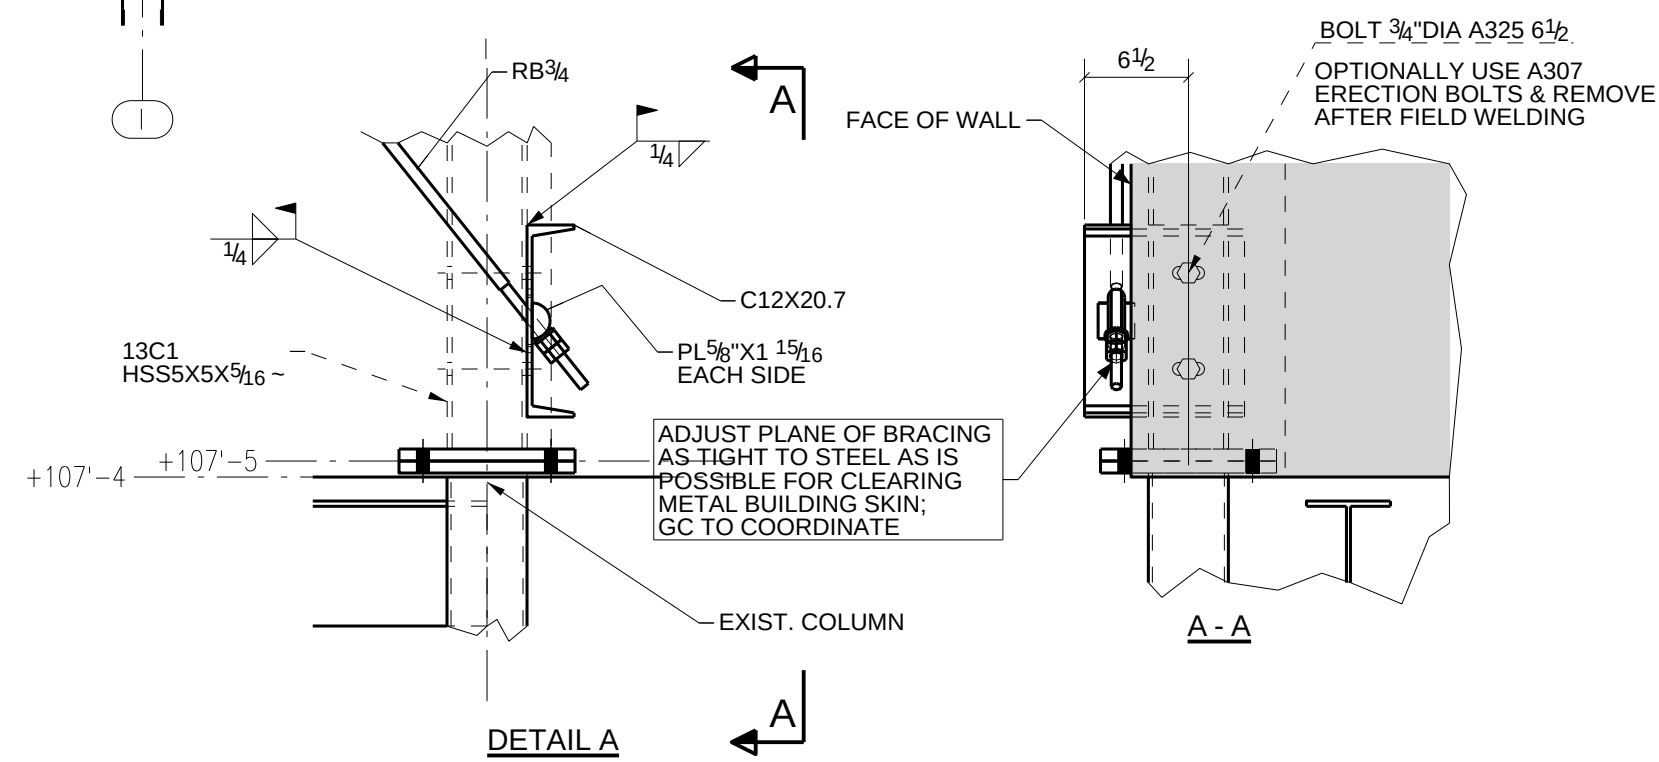


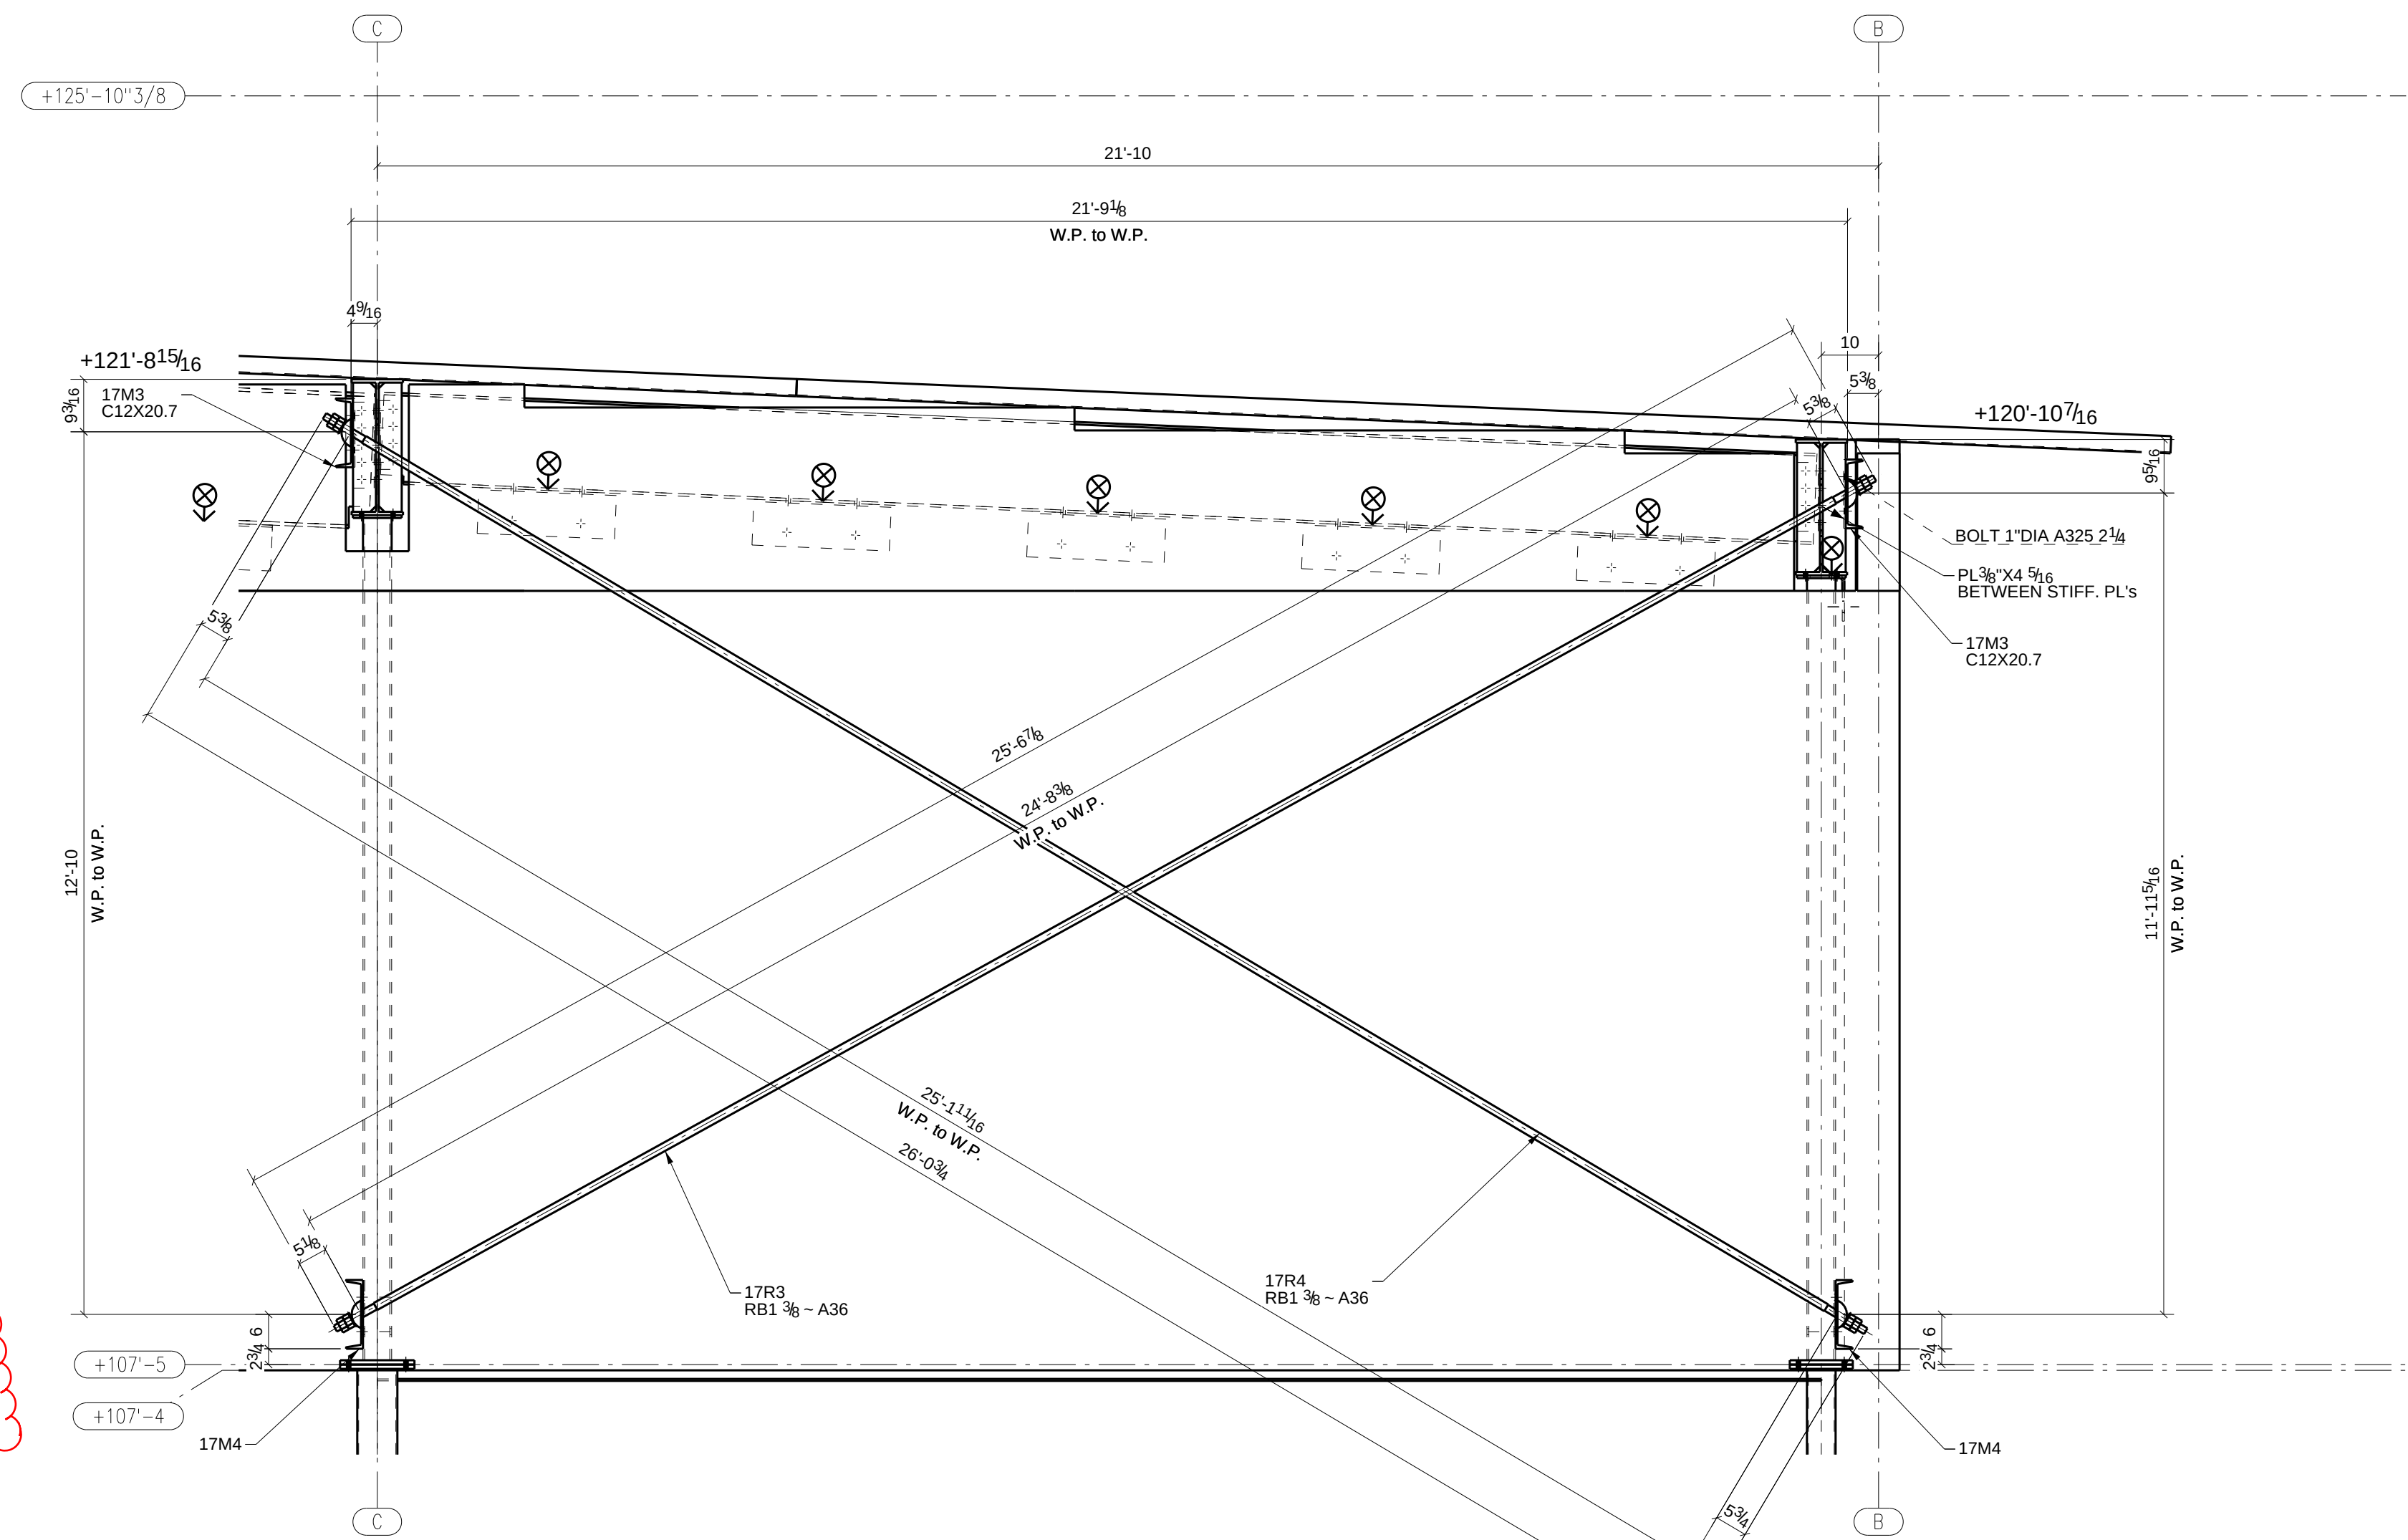

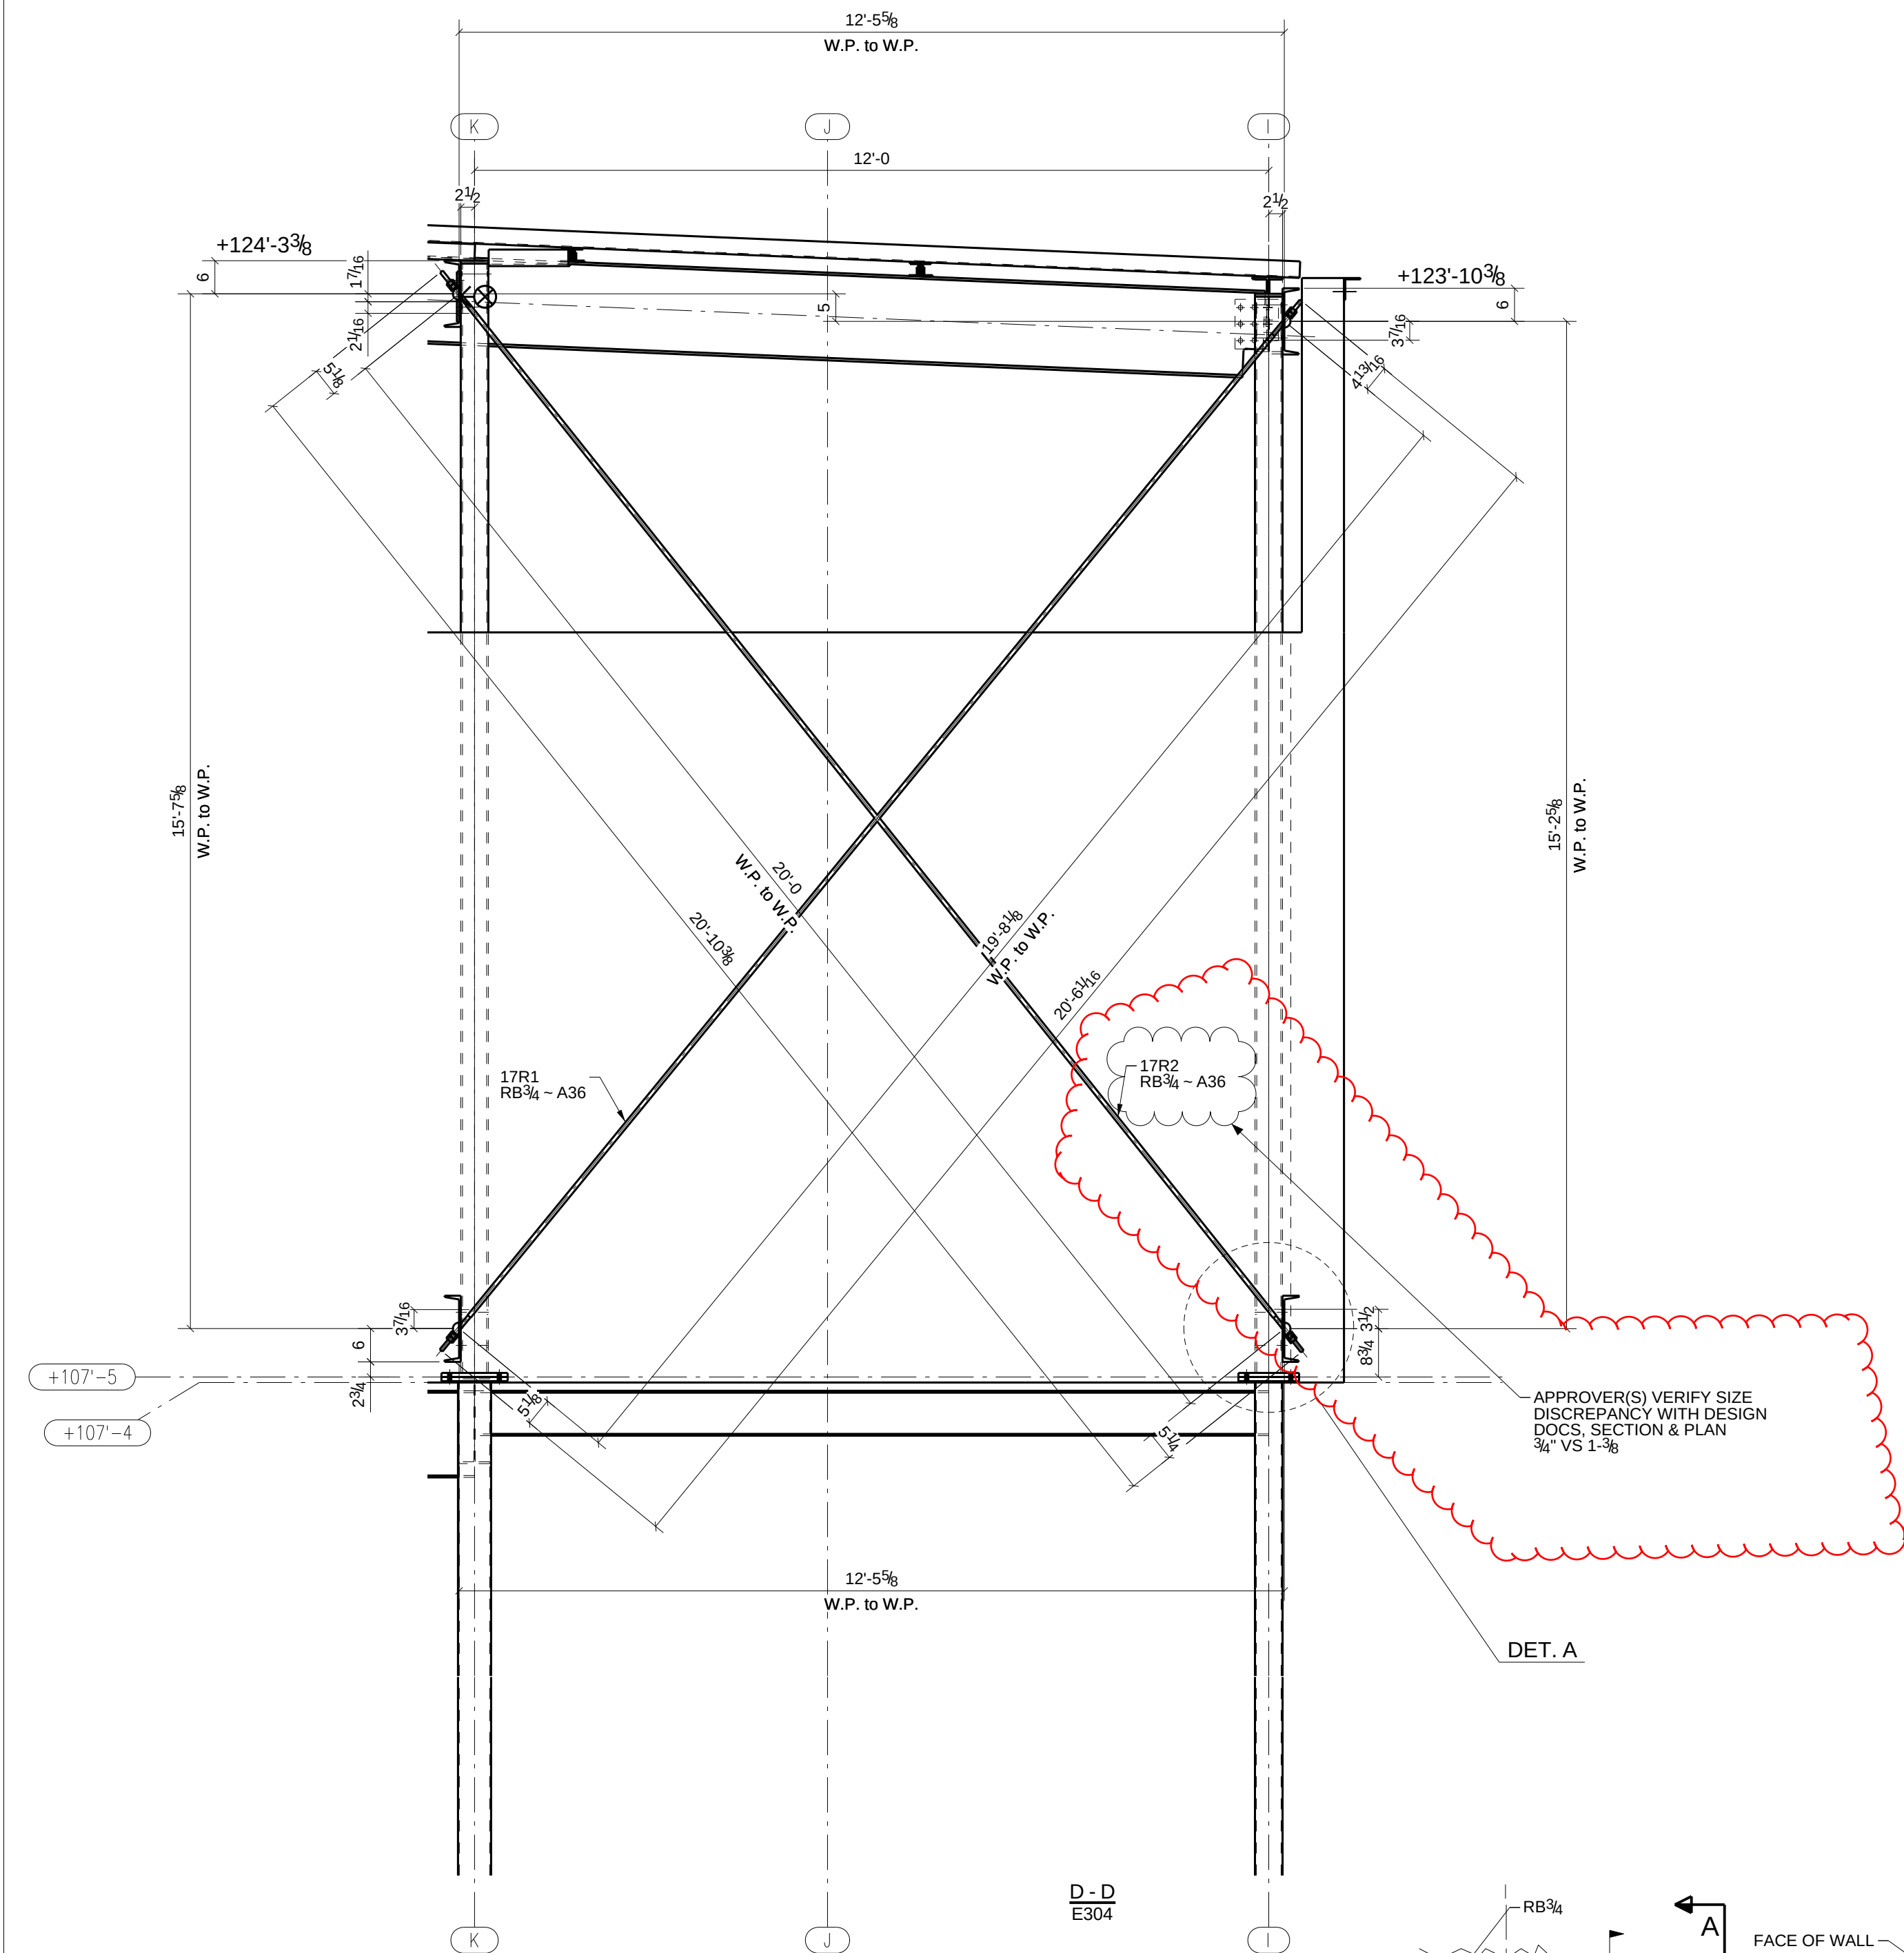

A	For Approval & Field Survey	8/30/10	TMc	TAN
0	For Approval & Field Survey	8/30/10	TMc	TAN
REV.	DESCRIPTION	DATE	DWN	CHK
GENERAL NOTES				JOB USE
MATERIAL: A992 / A36 UN		ELECTRODES: E70XX LH	REF. DRG.	
HOLES: 13/16 DIA. UN		CONN'S: -		SHOP
SURFACE PREP. AND PAINT:				APPROVAL
SSPC-SP-2				
GREY PRIMER DEVOE NA-195 (U.N.)				
DESCRIPTION: JDC ADDITION-SECTIONS/ELEVATIONS				
PROJ. NAME Hamilton High School Phase III			DRAWN BY TMc	
LOCATION Hamilton City School District - Hamilton, OH			DATE 09/02/2010	
CONTRACTOR GC Contracting			CHKD. BY TAN	
ARCH/ENG. SHP			DATE	
Avenue Fabricating Inc.			JOB No. 10-16	
1281 Clough Pike			DRG. No. E310	
Batavia, OH 45103			REV. 0	
(513) 752-1911				

GRID LOCATION	BOTTOM ELEVATION
4/K	107'-5"

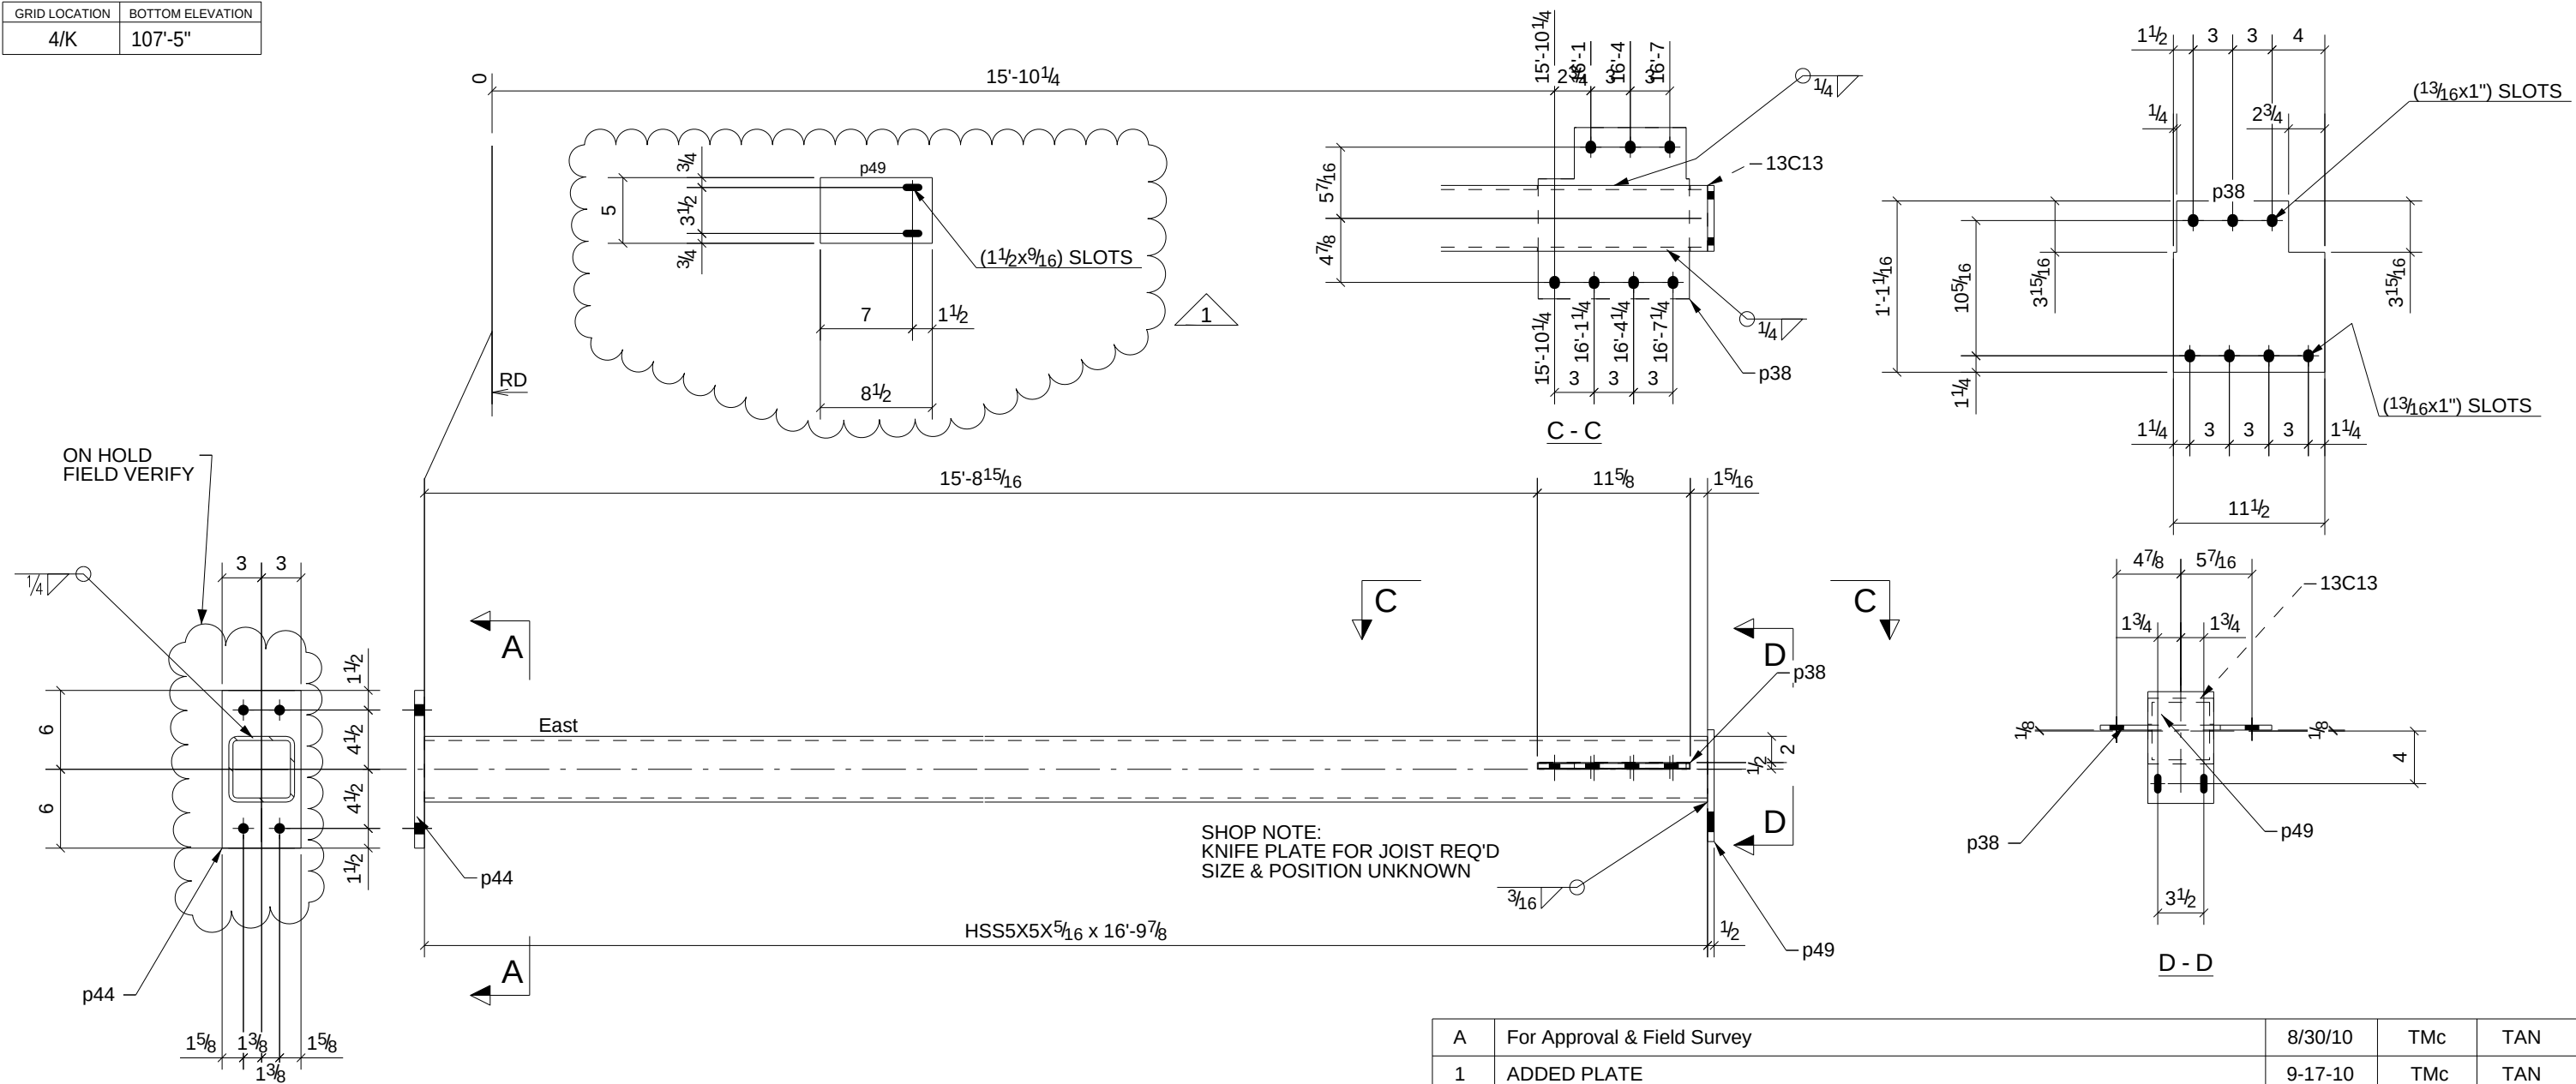

ONE - COLUMN - 13C13


PHASE				
1	2	3	4	5
1	0	0	0	0

BILL OF MATERIAL

SHIP	MARK	NO PCS	DESCRIPTION	LENGTH	PIECE MARK	REMARKS
1	13C13	1	HSS5X5X5/16	16'-9 7/8"		SQ-2 A500-GR.B
		1	BAR3/8"X11 1/2"	1'-1 1/16"	p38	A36
		1	BAR3/4"X6"	1'-0"	p44	A36
		1	BAR1/2"X5"	0'-8 1/2"	p49	A36

A	For Approval & Field Survey		8/30/10	TMc	TAN
1	ADDED PLATE		9-17-10	TMc	TAN
0	For Fabrication & F&F		9/15/10	TMc	TAN
REV.	DESCRIPTION		DATE	DWN	CHK
GENERAL NOTES			JOB USE		
MATERIAL: A992 / A36		ELECTRODES: E70XX LH	REF. DRG.		
HOLES: 13/16 DIA. U/N		CONN'S.: -		SHOP	
SURFACE PREP. SSPC-SP-2			APPROVAL		
AND PAINT: GREY PRIMER DEVOE NA-195 (U.N.)					
DESCRIPTION: COLUMN					
PROJECT NAME		Hamilton High School Phase III			
LOCATION		Hamilton City School District - Hamilton			
CONTRACTOR		GC Contracting			
	Avenue Fabricating Inc. 1281 Clough Pike Batavia, OH 45103 (513) 752-1911		DRAWN BY TMc		DATE 08/20/2010
			CHKD. BY TAN		DATE
			JOB No. 10-16		DRG. No. 13C13
			REV. 3		

GRID LOCATION	BOTTOM ELEVATION
29-28/M	107'-4"

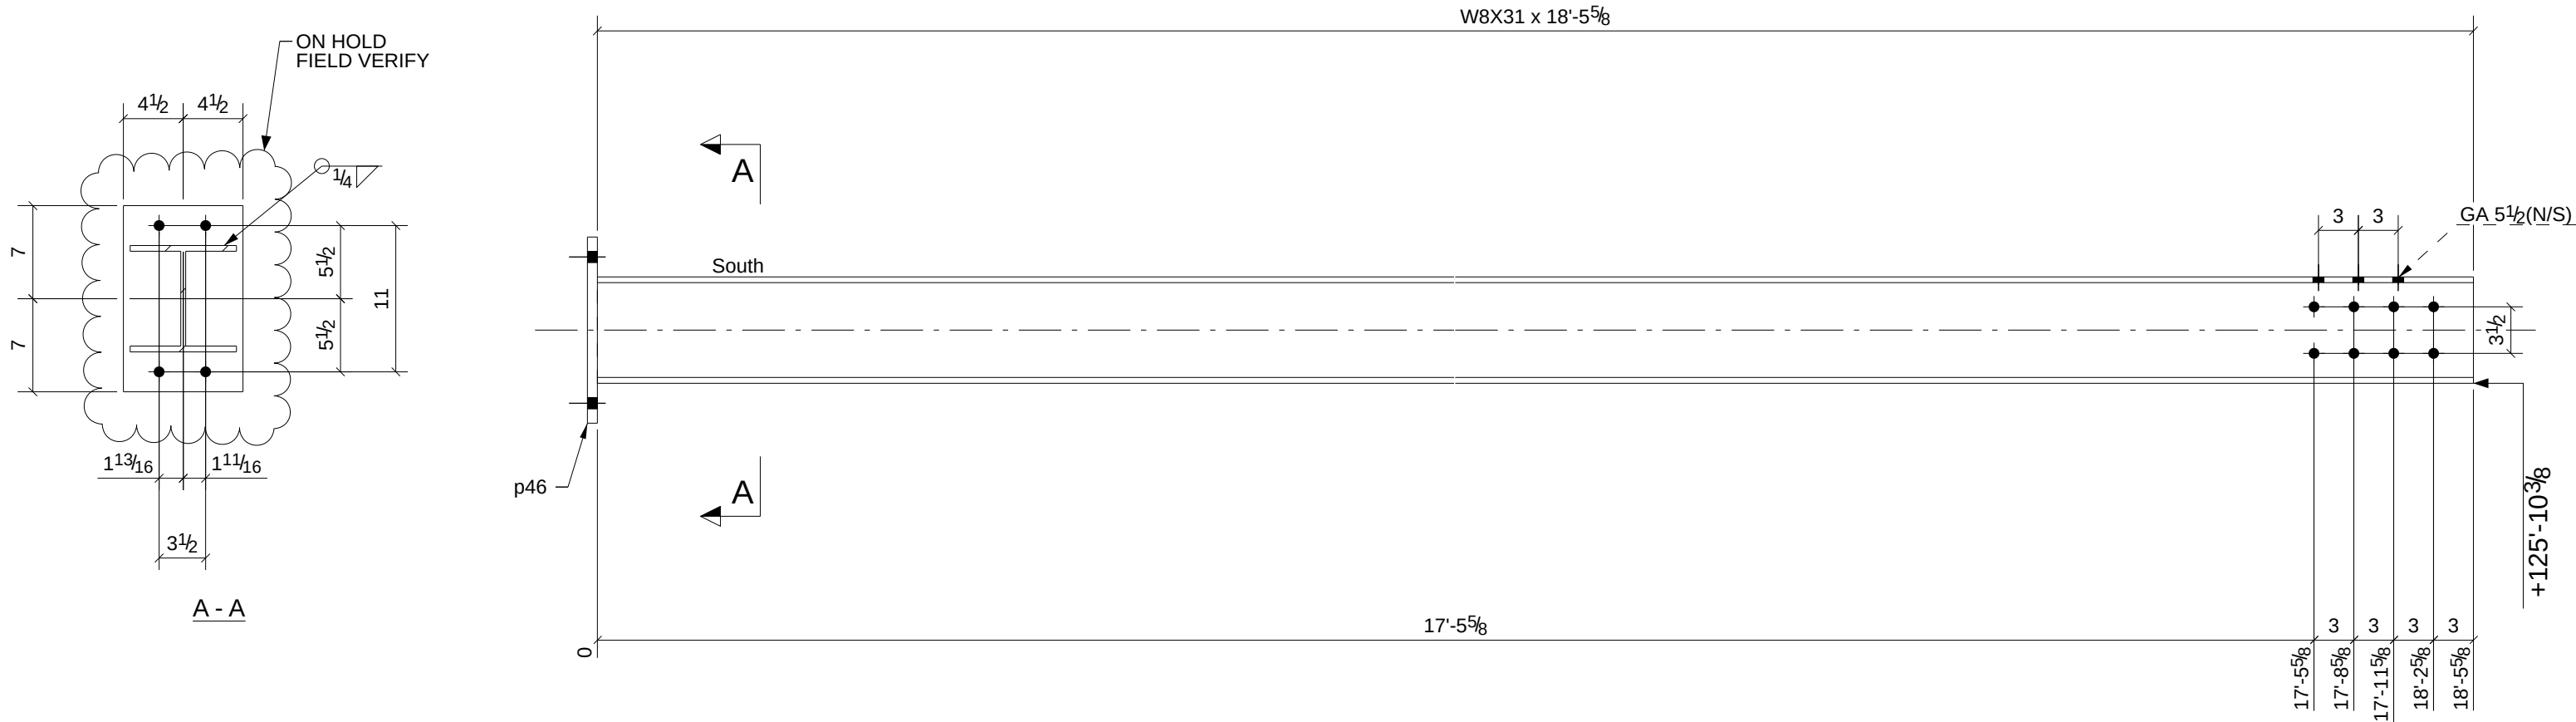

ONE - COLUMN - 13C18

PHASE				
1	2	3	4	5
1	0	0	0	0

W	8" x 1/4"
F	8" x 7/16"


A	For Approval & Field Survey		8/30/10	TMc	TAN			
0	For Fabrication & F&F		9/15/10	TMc	TAN			
REV.	DESCRIPTION		DATE	DWN	CHK			
GENERAL NOTES			JOB USE					
			MATERIAL: A992 / A36	ELECTRODES: E70XX LH	REF. DRG.	SHOP		
			HOLES: 13/16 DIA. U/N	CONN'S.: -				
SURFACE PREP. SSPC-SP-2 AND PAINT: GREY PRIMER DEVOE NA-195 (U.N,)			APPROVAL					
DESCRIPTION: COLUMN								
PROJECT NAME		Hamilton High School Phase III						
LOCATION		Hamilton City School District - Hamilton						
CONTRACTOR		GC Contracting						
	Avenue Fabricating Inc. 1281 Clough Pike Batavia, OH 45103 (513) 752-1911		DRAWN BY TMc		DATE 09/02/2010			
			CHKD. BY TAN		DATE			
			JOB No. 10-16		DRG. No. 13C18		REV. 2	

BILL OF MATERIAL

SHIP	MARK	NO PCS	DESCRIPTION	LENGTH	PIECE MARK	REMARKS
1	13C18	1	W8X31	18'-5 5/8"		SQ-2 A992
		1	FL3/4"X9"	1'-2"	p46	A36

Avenue Fabricating Inc.
1281 Clough Pike
Batavia, OH 45103
(513) 752-1911

GRID LOCATION	BOTTOM ELEVATION
29/K-L	107'-4"

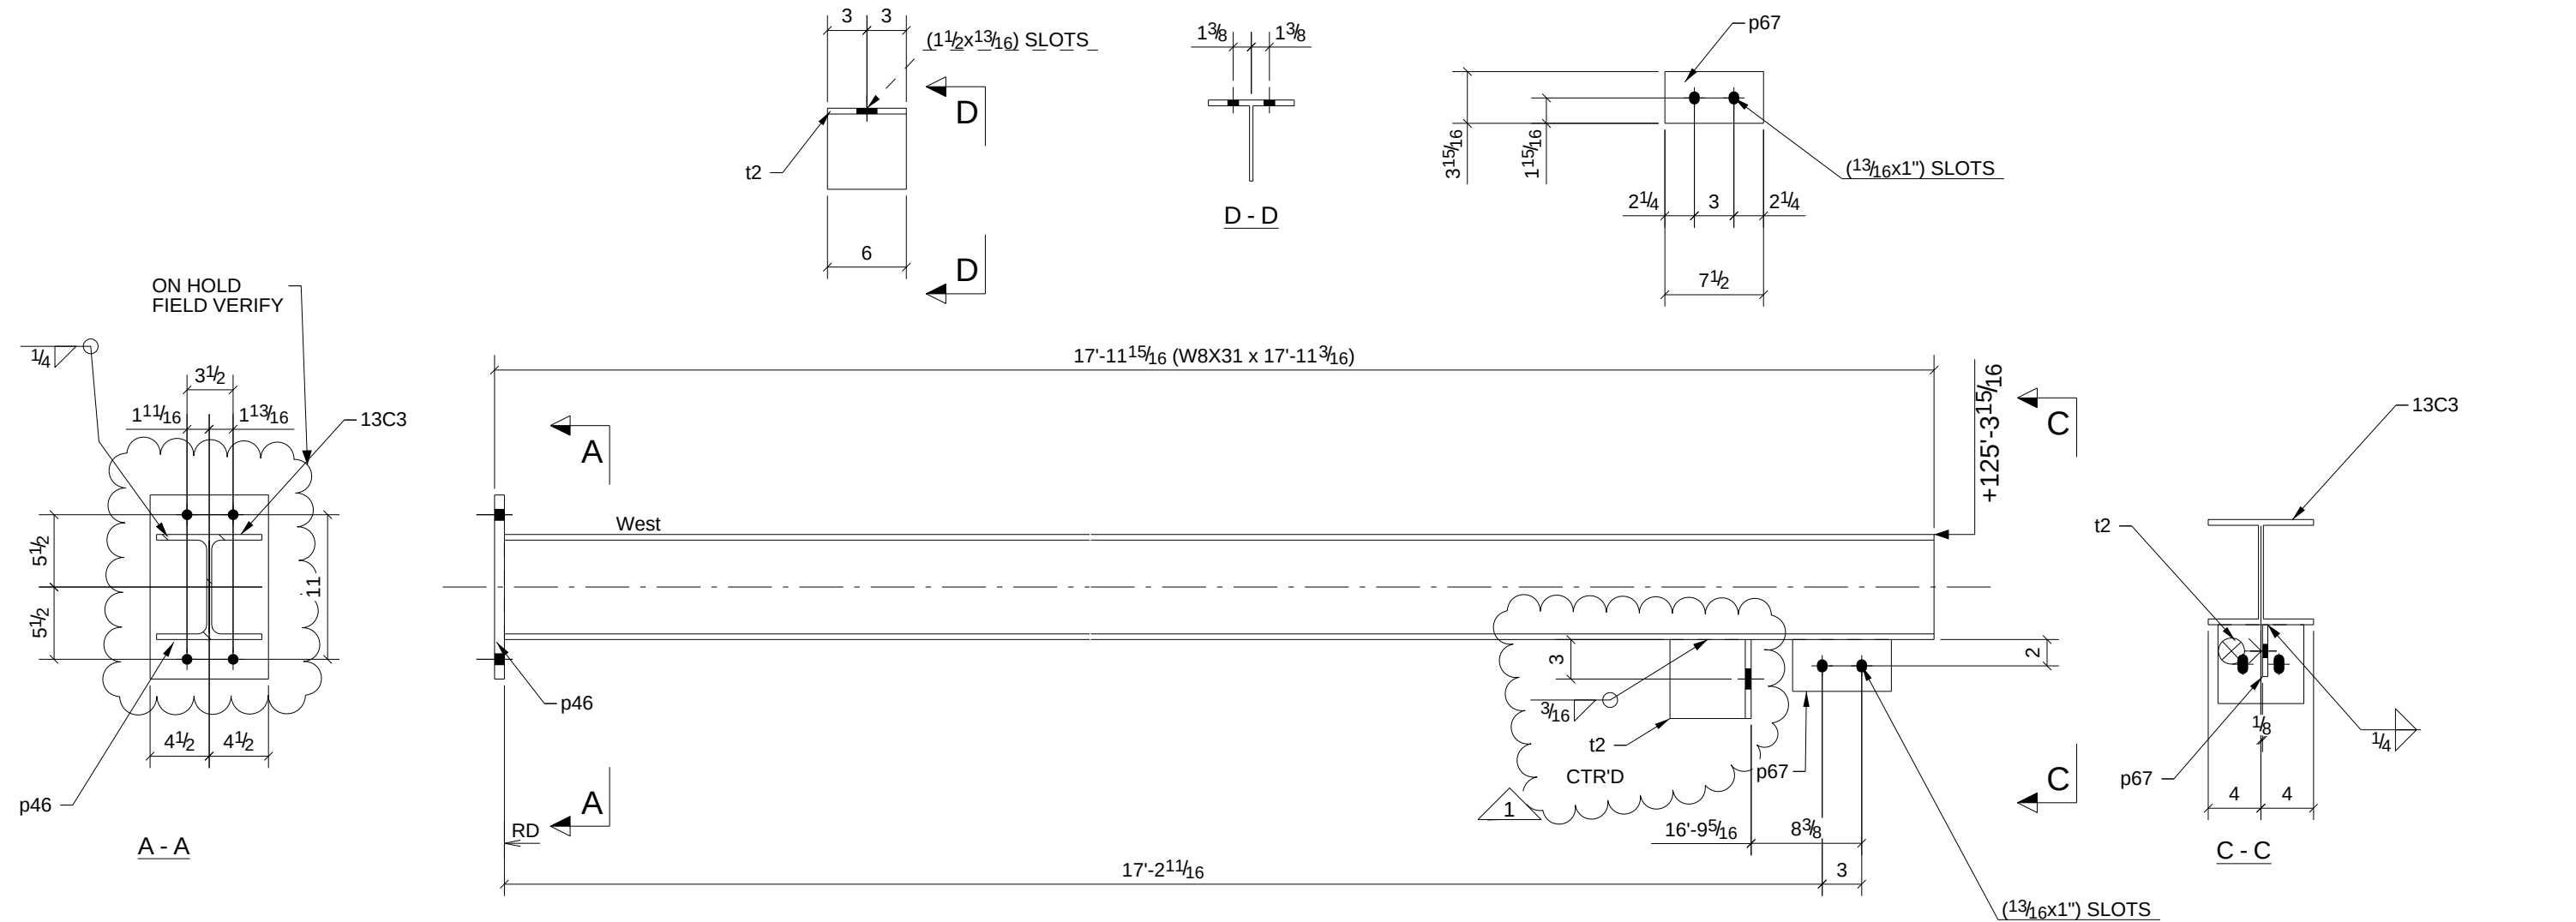

ONE - COLUMN - 13C3



PHASE				
1	2	3	4	5
1	0	0	0	0

W	8"x1/4"
F	8"x7/16"

A	For Approval & Field Survey		8/30/10	TMc	TAN
1	added wt		9-17-10	TMc	TAN
0	For Fabrication & F&F		9/15/10	TMc	TAN
REV.	DESCRIPTION		DATE	DWN	CHK
GENERAL NOTES			JOB USE		
MATERIAL: A992 / A36		ELECTRODES: E70XX LH	REF. DRG.		
HOLES: 13/16 DIA. U/N		CONN'S.: -		SHOP	
SURFACE PREP. SSPC-SP-2			APPROVAL		
AND PAINT: GREY PRIMER DEVOE NA-195 (U.N.)					
DESCRIPTION: COLUMN					
PROJECT NAME Hamilton High School Phase III					
LOCATION Hamilton City School District - Hamilton					
CONTRACTOR GC Contracting					
	Avenue Fabricating Inc. 1281 Clough Pike Batavia, OH 45103 (513) 752-1911		DRAWN BY TMc		DATE 08/20/2010
			CHKD. BY TAN		DATE
			JOB No. 10-16		DRG. No. 13C3

BILL OF MATERIAL						
SHIP	MARK	NO PCS	DESCRIPTION	LENGTH	PIECE MARK	REMARKS
1	13C3	1	W8X31	17'-11 3/16"		SQ-2 A992
		1	BAR3/4"x9"	1'-2"	p46	A36
		1	PL3/8"x3 15/16"	0'-7 1/2"	p67	A36
		1	WT6X15	0'-6"	t2	A36

GRID LOCATION	BOTTOM ELEVATION
3-2/M	107'-4"

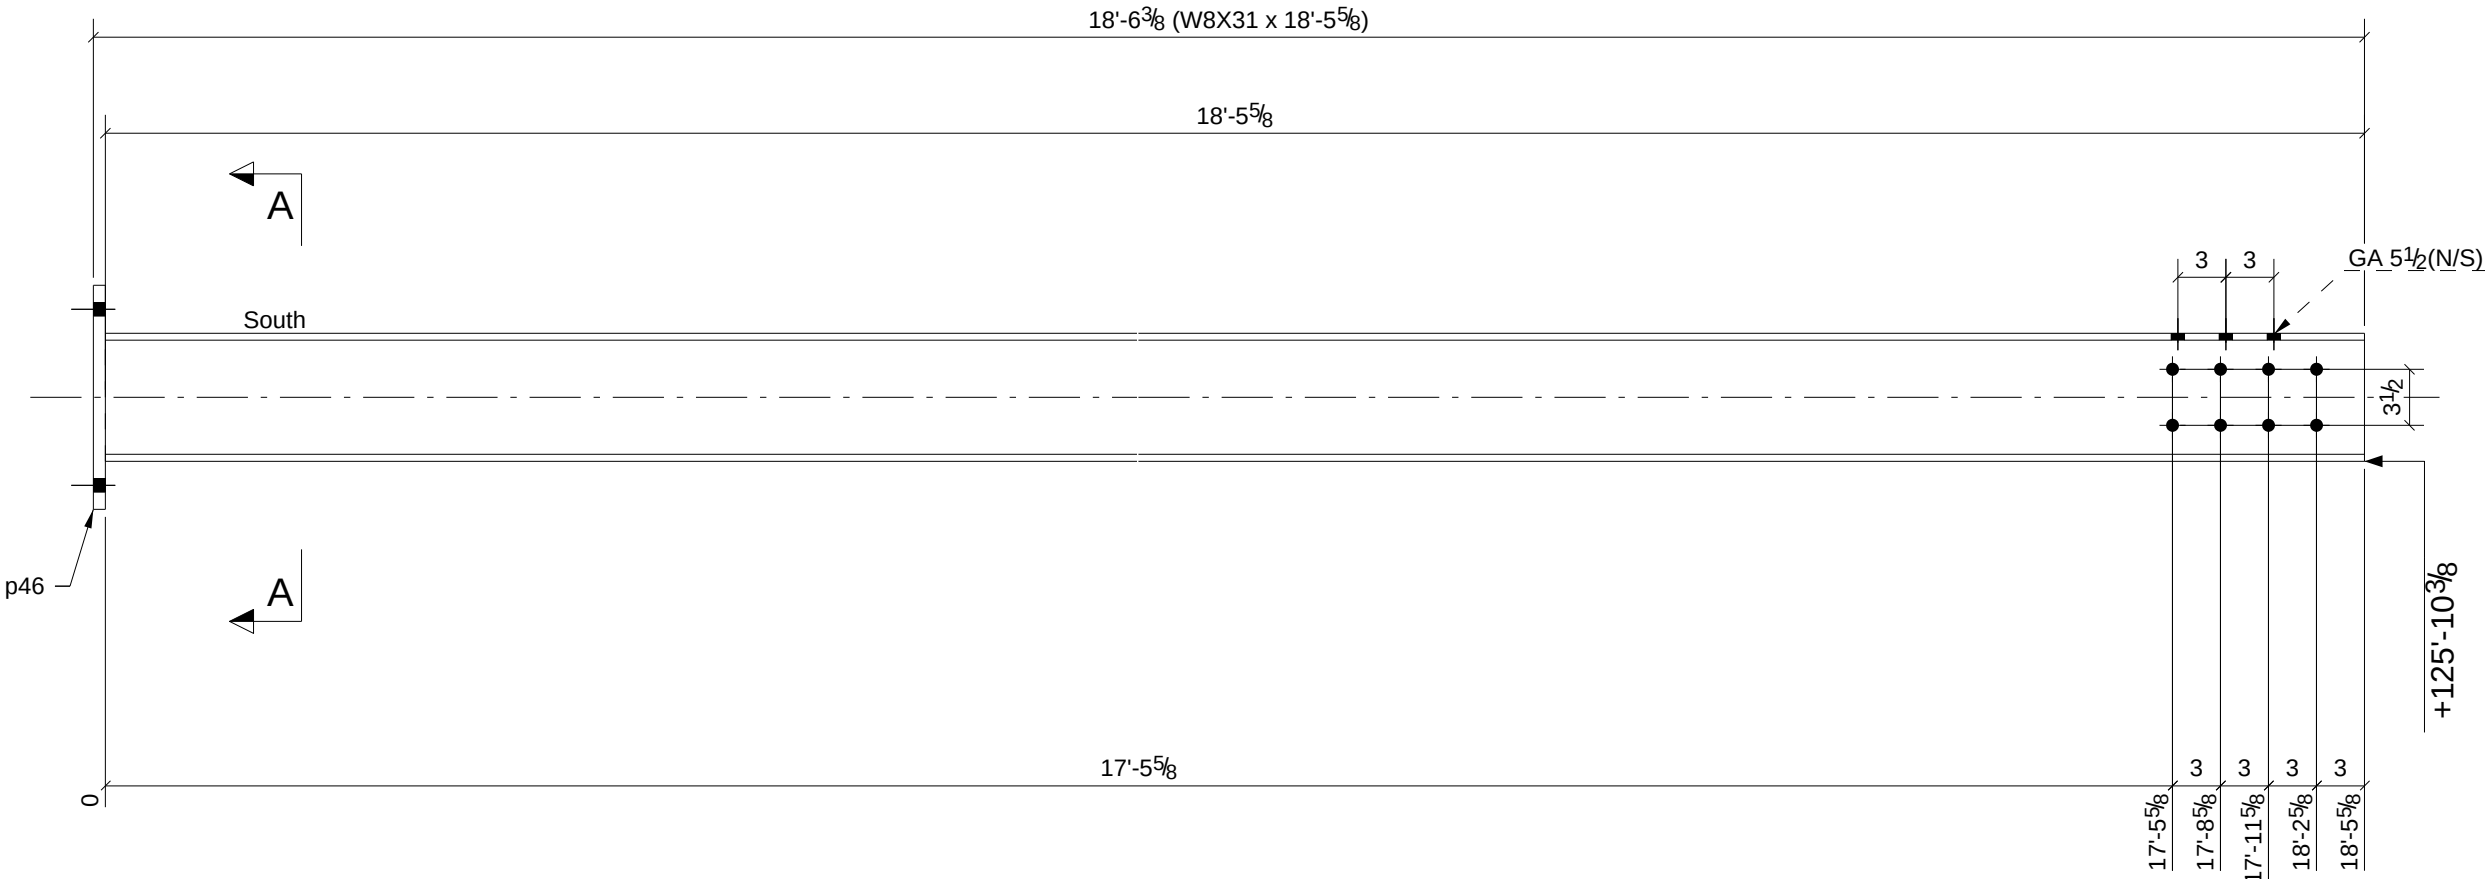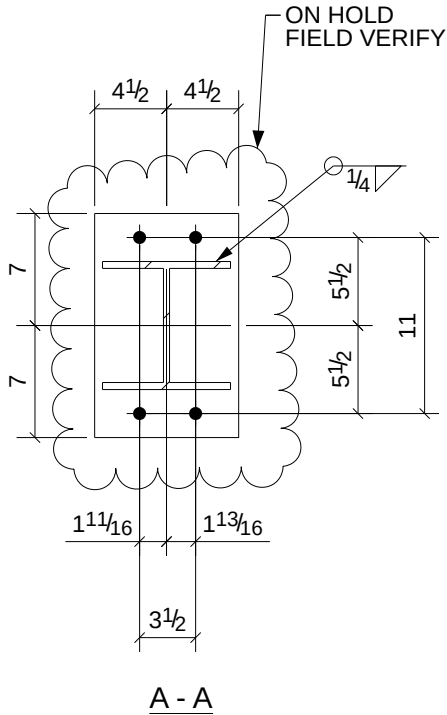

PHASE				
1	2	3	4	5
1	0	0	0	0

ONE - COLUMN - 13C4



W	8" x 1/4"
F	8" x 7/16"

BILL OF MATERIAL

SHIP	MARK	NO PCS	DESCRIPTION	LENGTH	PIECE MARK	REMARKS
1	13C4	1	W8X31	18'-5 5/8"		SQ-2 A992
		1	FL3/4"X9"	1'-2"	p46	A36

A	For Approval & Field Survey		8/30/10	TMc	TAN
0	For Fabrication & F&F		9/15/10	TMc	TAN
REV.	DESCRIPTION		DATE	DWN	CHK
GENERAL NOTES			JOB USE		
MATERIAL: A992 / A36	ELECTRODES: E70XX LH	REF. DRG.	SHOP		
HOLES: 13/16 DIA. U/N	CONN'S.: -				
SURFACE PREP. SSPC-SP-2 AND PAINT: GREY PRIMER DEVOE NA-195 (U.N,)			APPROVAL		
DESCRIPTION: COLUMN					
PROJECT NAME	Hamilton High School Phase III				
LOCATION	Hamilton City School District - Hamilton				
CONTRACTOR	GC Contracting				
	Avenue Fabricating Inc. 1281 Clough Pike Batavia, OH 45103 (513) 752-1911		DRAWN BY TMc	DATE 08/20/2010	
			CHKD. BY TAN	DATE	
			JOB No. 10-16	DRG. No. 13C4	REV. 2

GRID LOCATION	BOTTOM ELEVATION
27/K	107'-5"

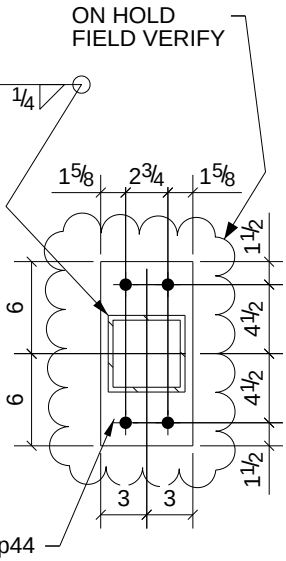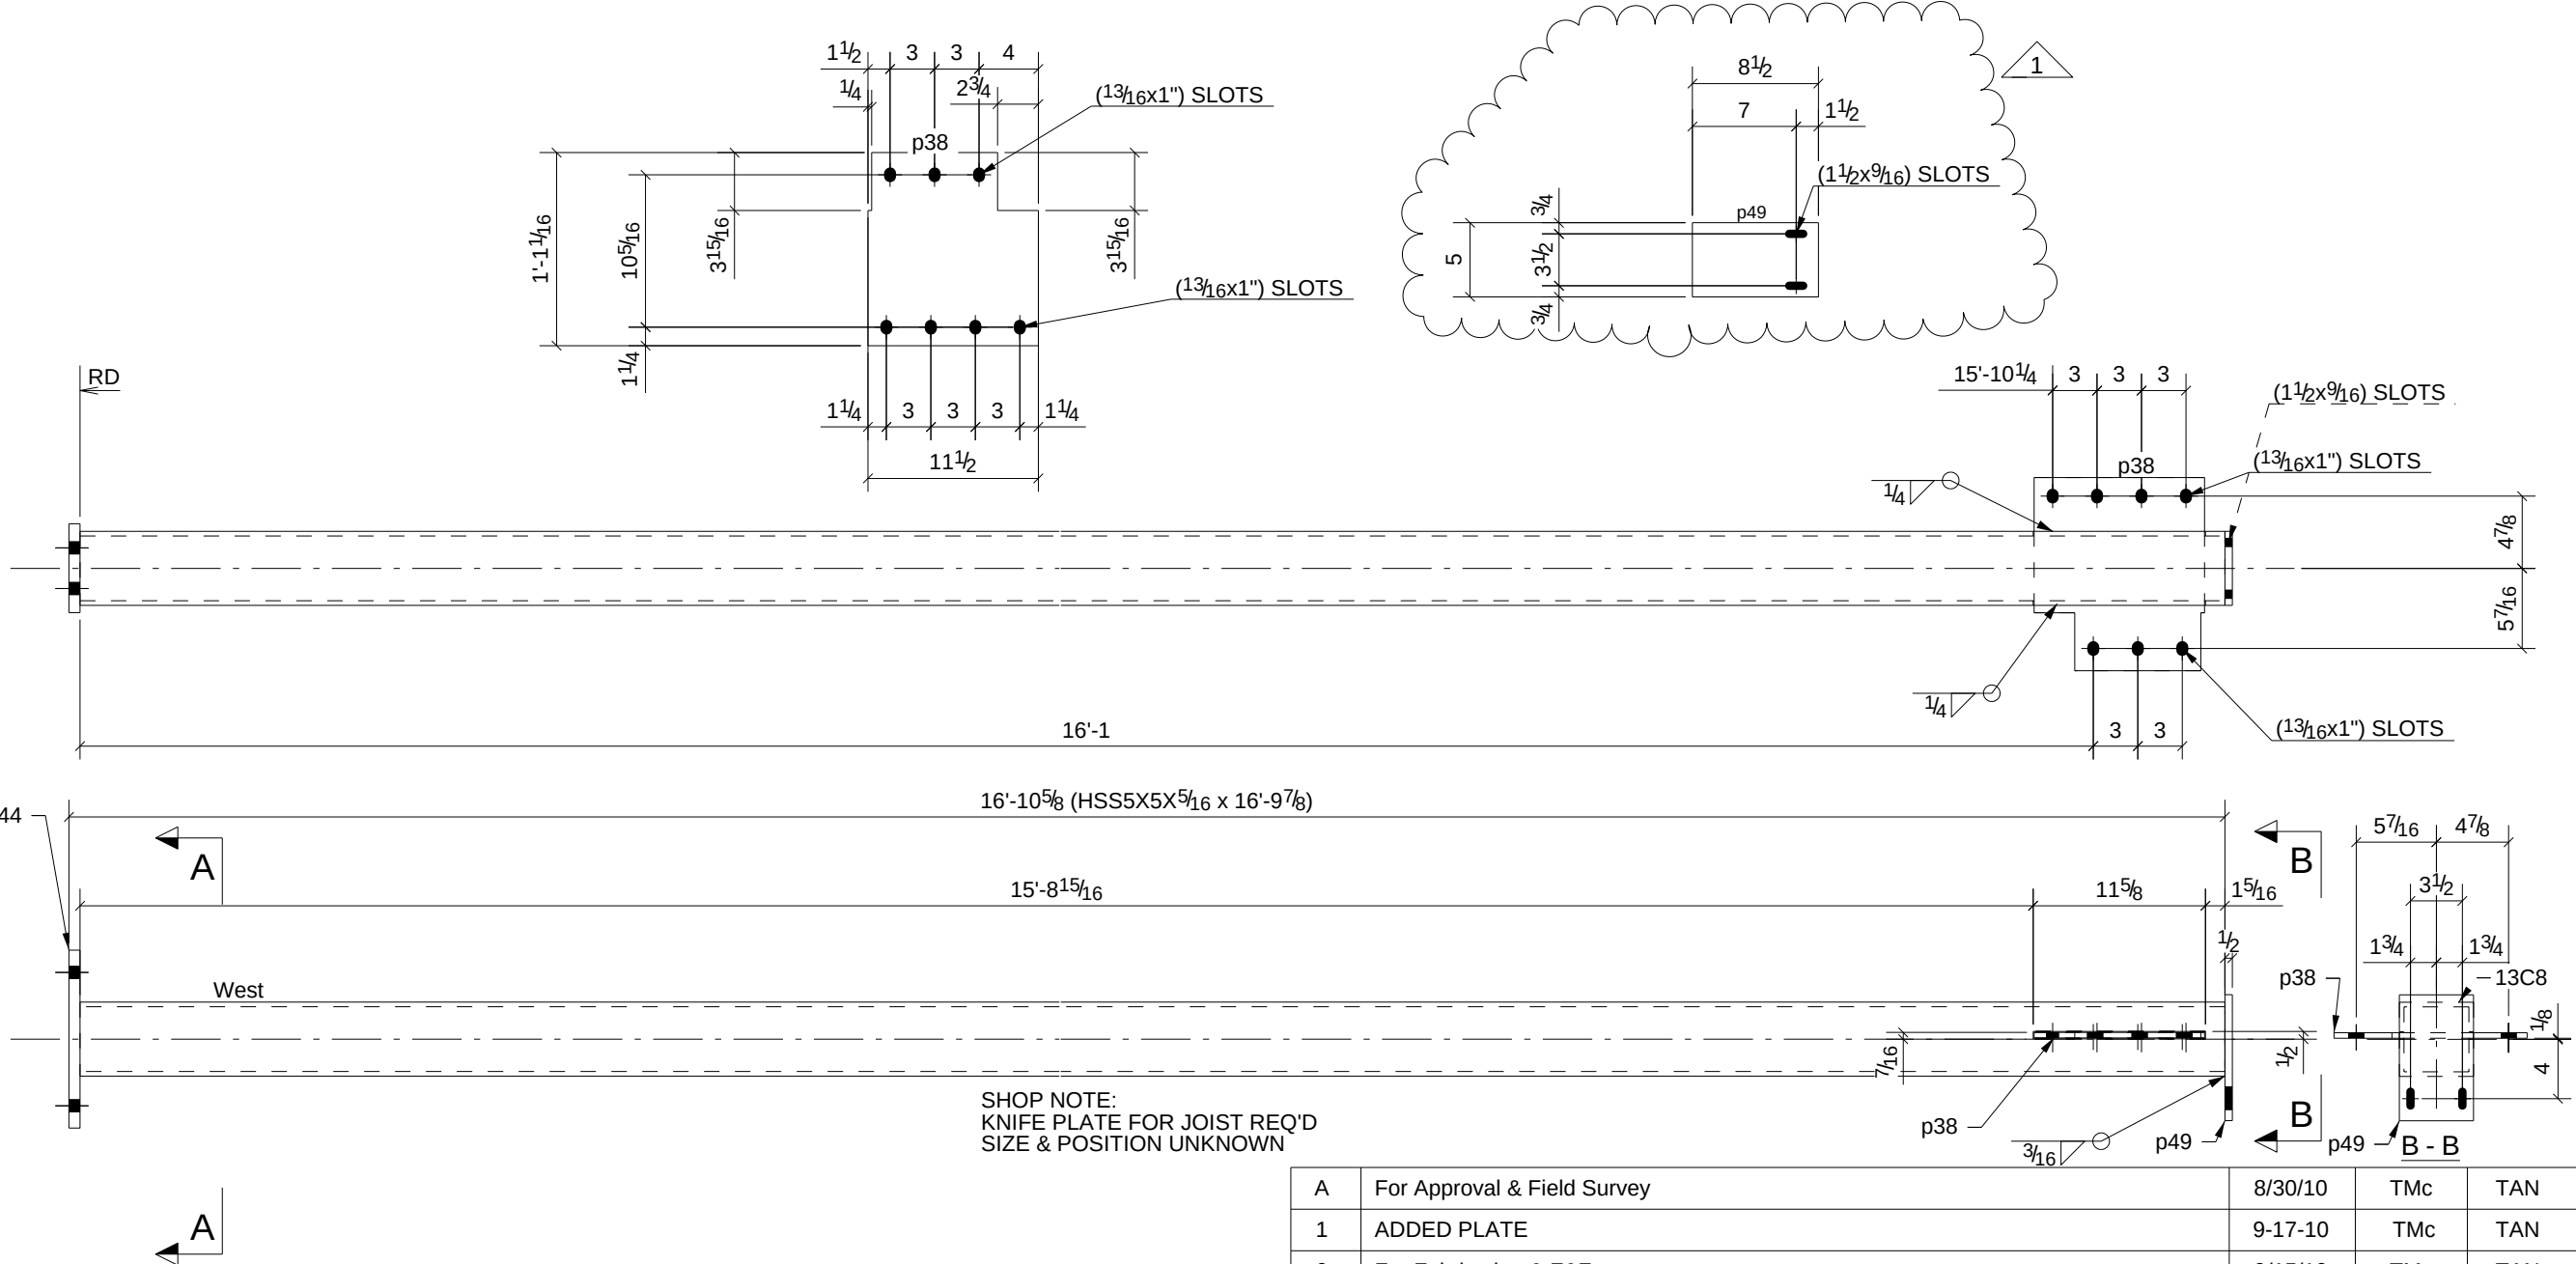


ONE - COLUMN - 13C8

A	For Approval & Field Survey	8/30/10	TMc	TAN
1	ADDED PLATE	9-17-10	TMc	TAN
0	For Fabrication & F&F	9/15/10	TMc	TAN
REV.	DESCRIPTION	DATE	DWN	CHK
GENERAL NOTES		JOB USE		
MATERIAL: A992 / A36	ELECTRODES: E70XX LH	REF. DRG.		
HOLES: 13/16 DIA. U/N	CONN'S.: -		SHOP	
SURFACE PREP. SSPC-SP-2		APPROVAL		
AND PAINT: GREY PRIMER DEVOE NA-195 (U.N.)				
DESCRIPTION: COLUMN				
PROJECT NAME Hamilton High School Phase III				
LOCATION Hamilton City School District - Hamilton				
CONTRACTOR GC Contracting				
	Avenue Fabricating Inc. 1281 Clough Pike Batavia, OH 45103 (513) 752-1911	DRAWN BY TMc	DATE 08/20/2010	
		CHKD. BY TAN	DATE	
		JOB No. 10-16	DRG. No. 13C8	REV. 3

PHASE				
1	2	3	4	5
1	0	0	0	0

BILL OF MATERIAL						
SHIP	MARK	NO PCS	DESCRIPTION	LENGTH	PIECE MARK	REMARKS
1	13C8	1	HSS5X5X5/16	16'-9 7/8"		SQ-2 A500-GR.B
		1	BAR3/8"X11 1/2"	1'-1 1/16"	p38	A36
		1	BAR3/4"X6"	1'-0"	p44	A36
		1	BAR1/2"X5"	0'-8 1/2"	p49	A36

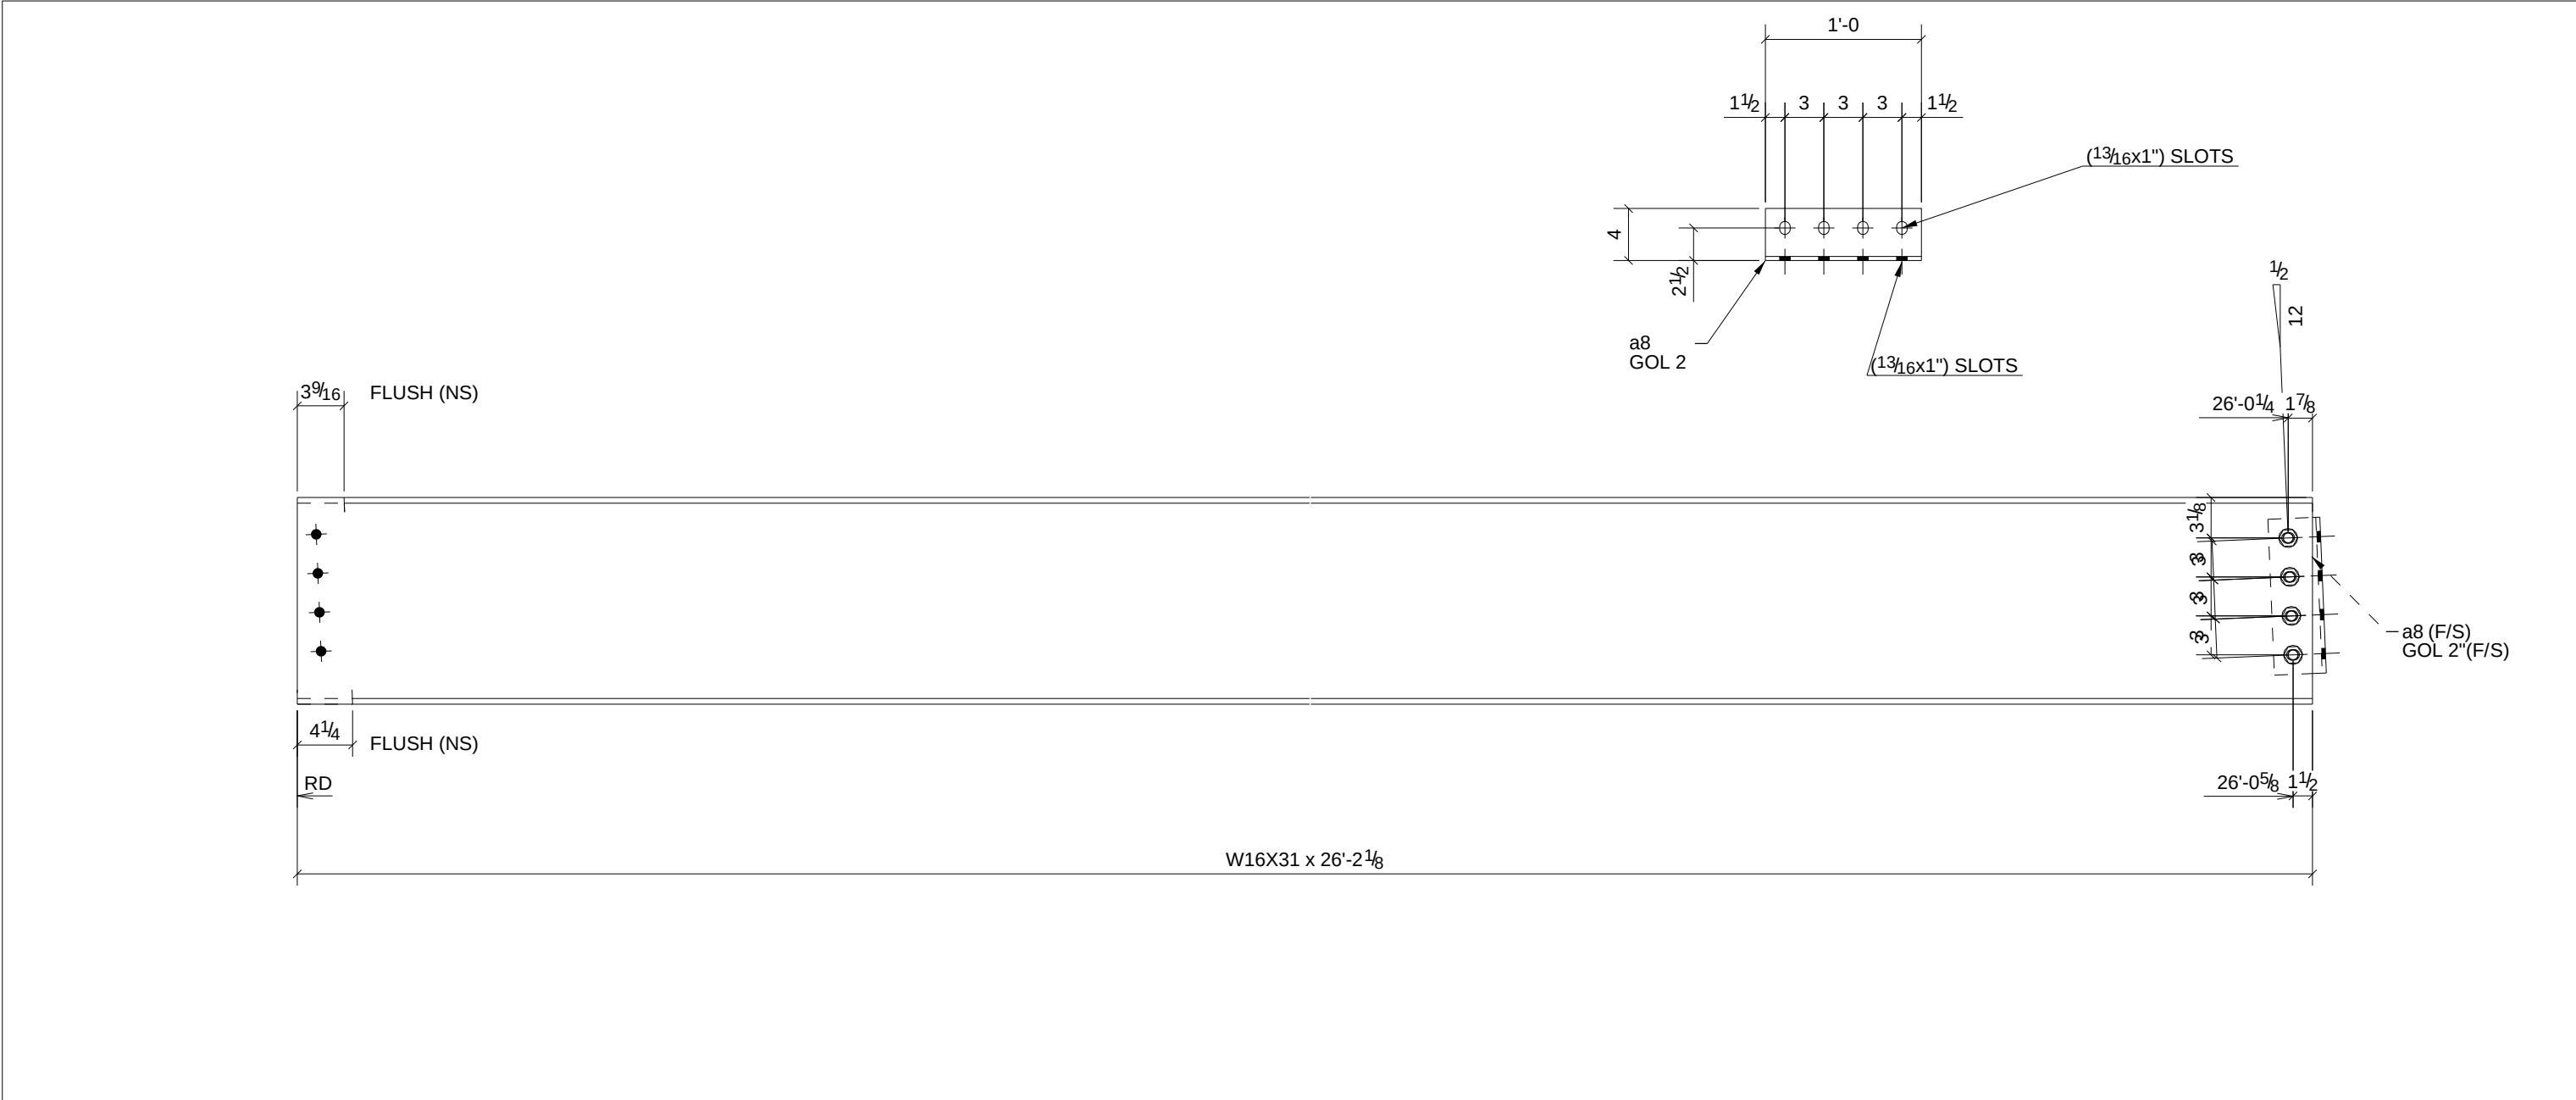







PHASE				
1	2	3	4	5
1	0	0	0	0

ONE - BEAM - 15B1

W	15 7/8"x1/4"
F	5 1/2"x7/16"

BILL OF MATERIAL						
SHIP	MARK	NO PCS	DESCRIPTION	LENGTH	PIECE MARK	REMARKS
1	15B1	1	W16X31	26'-2 1/8"		SQ-2 A992
		1	L4X3-1/2X5/16	1'-0"	a8	A36
		1	BAR3/4"X5 1/2"	0'-5 1/2"	p9	A36
		4	3/4"Ø A325N BOLT	0'-1 3/4"		

0	For Fabrication & F&F				9/15/10	TMc	TAN	
REV.	DESCRIPTION				DATE	DWN	CHK	
GENERAL NOTES					JOB USE			
MATERIAL: A992 / A36		ELECTRODES: E70XX LH		REF. DRG.				
HOLES: 13/16 DIA. U/N		CONN'S.: -			SHOP			
SURFACE PREP. SSPC-SP-2					APPROVAL			
AND PAINT: GREY PRIMER DEVOE NA-195 (U.N,)								
DESCRIPTION: BEAM								
PROJECT NAME		Hamilton High School Phase III						
LOCATION		Hamilton City School District - Hamilton						
CONTRACTOR		GC Contracting						
		Avenue Fabricating Inc. 1281 Clough Pike Batavia, OH 45103 (513) 752-1911			DRAWN BY		DATE	
					TMc		09/14/2010	
					CHKD. BY		DATE	
					TAN			
		JOB No.			DRG. No.		REV.	
		10-16			15B1		1	

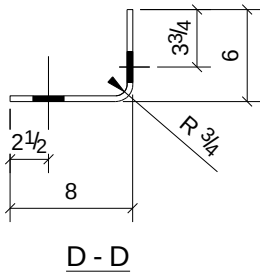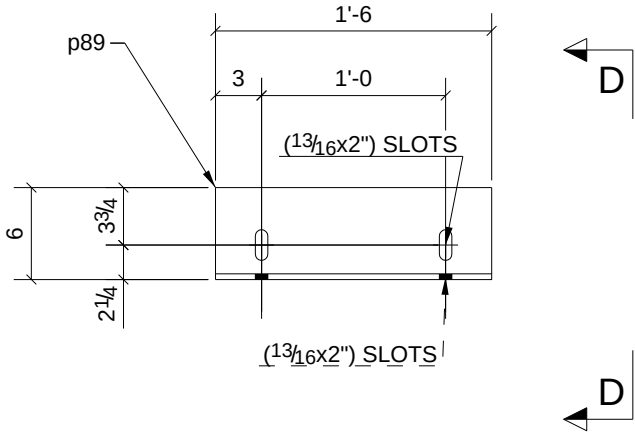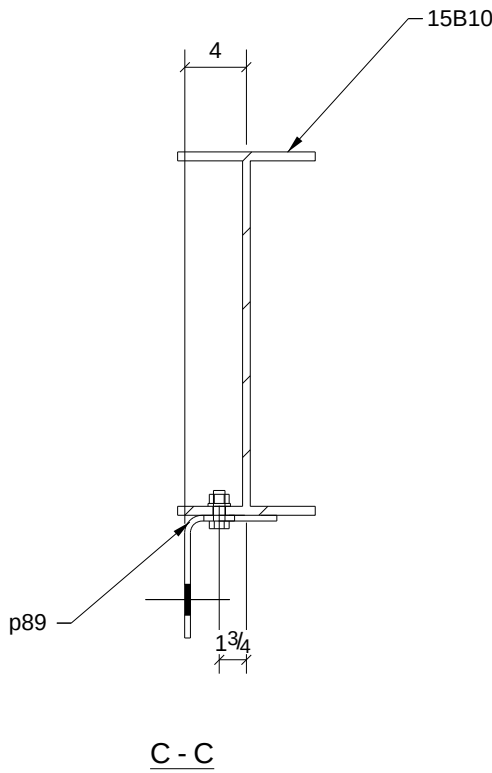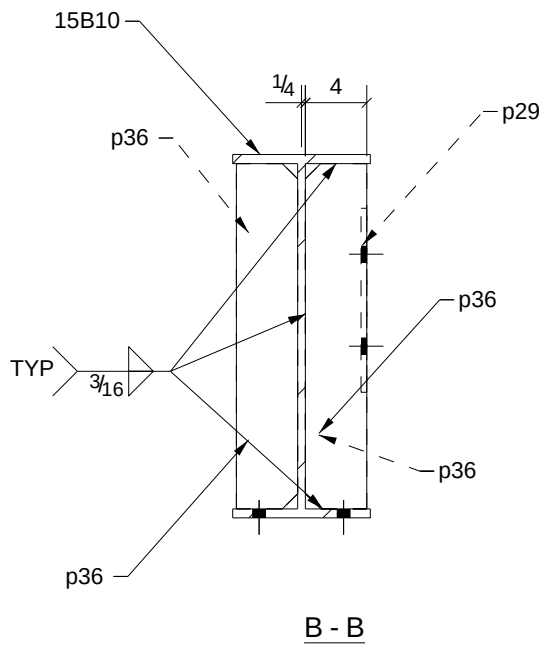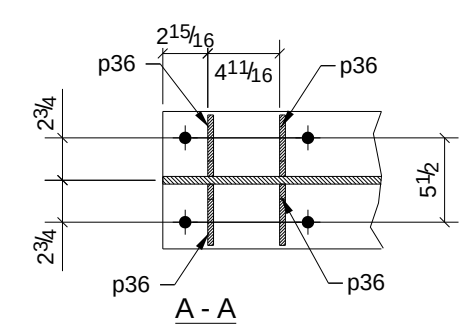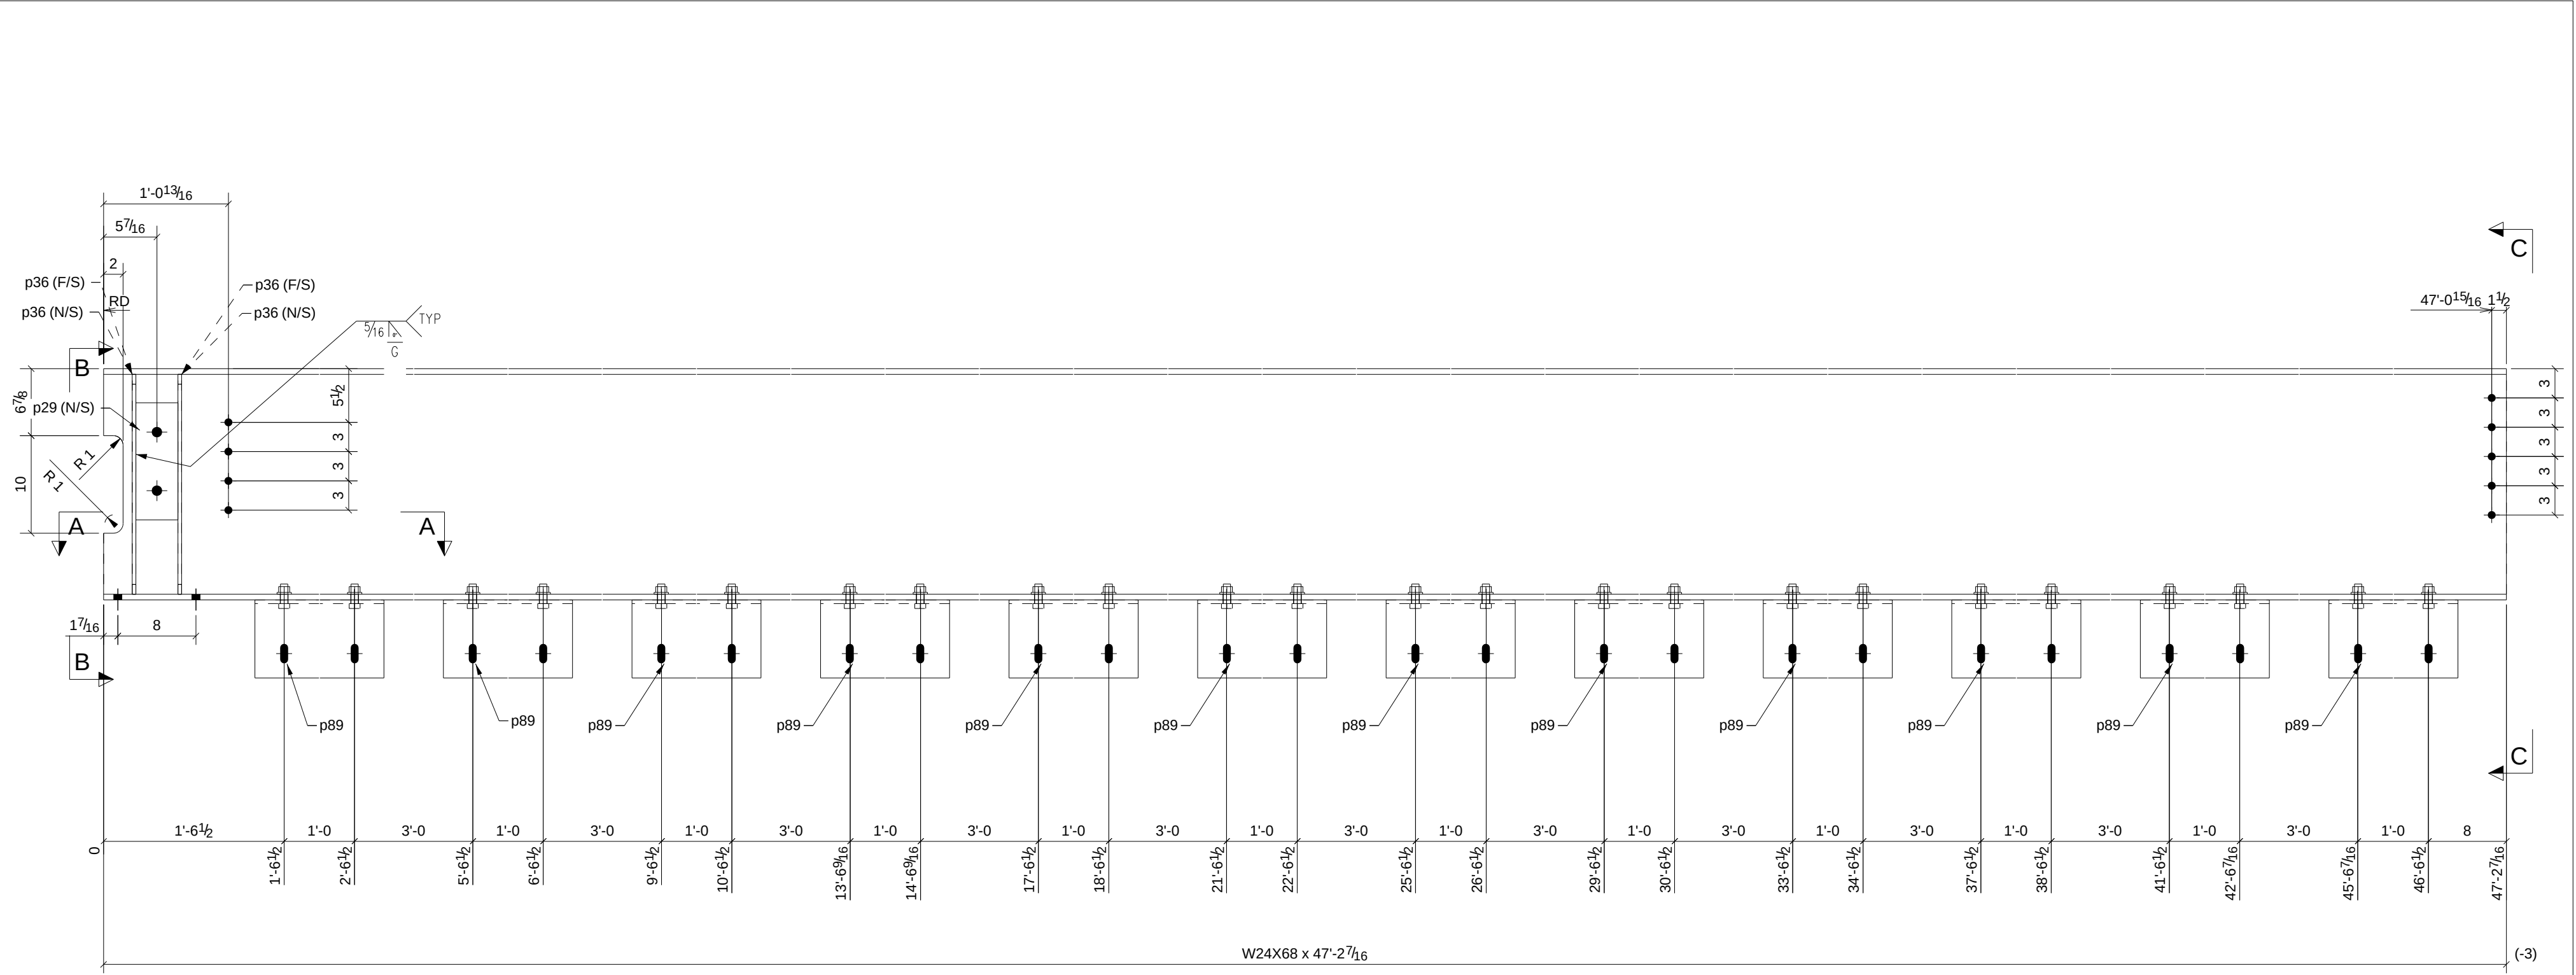


PHASE				
1	2	3	4	5
1	0	0	0	0

ONE - BEAM - 15B10

W 23 11/16"x7/16"
F 9"x9/16"

BILL OF MATERIAL					
SHIP	MARK	NO PCS	DESCRIPTION	LENGTH	PIECE MARK
1	15B10	1	W24X68	47'-2 7/16"	SQ-2 A992
		1	PL3/8"X4 5/16"	1'-0"	p29 A36
		4	BAR3/8"X4"	1'-10 1/2"	p36 A36
		12	PL3/8"X13 1/4"	1'-6"	p89 A36
		24	3/4"Ø A307 BOLT	0'-2"	

A	For Approval & Field Survey	8/30/10	TMc	TAN
0	For Fabrication & F&F	9/15/10	TMc	TAN
REV.	DESCRIPTION	DATE	DWN	CHK
GENERAL NOTES		JOB USE		
MATERIAL: A992 / A36	ELECTRODES: E70XX LH	REF. DRG.		
HOLES: 13/16 DIA. U/N	CONN'S.: -		SHOP	
SURFACE PREP: SSPC-SP-2		APPROVAL		
AND PAINT: GREY PRIMER DEVOE NA-195 (U.N.)				
DESCRIPTION: BEAM				
PROJECT NAME Hamilton High School Phase III				
LOCATION Hamilton City School District - Hamilton				
CONTRACTOR GC Contracting				
	Avenue Fabricating Inc. 1281 Clough Pike Batavia, OH 45103 (513) 752-1911	DRAWN BY TMc	DATE 08/30/2010	
		CHKD. BY TAN	DATE	
		JOB No. 10-16	DRG. No. 15B10	REV. 2

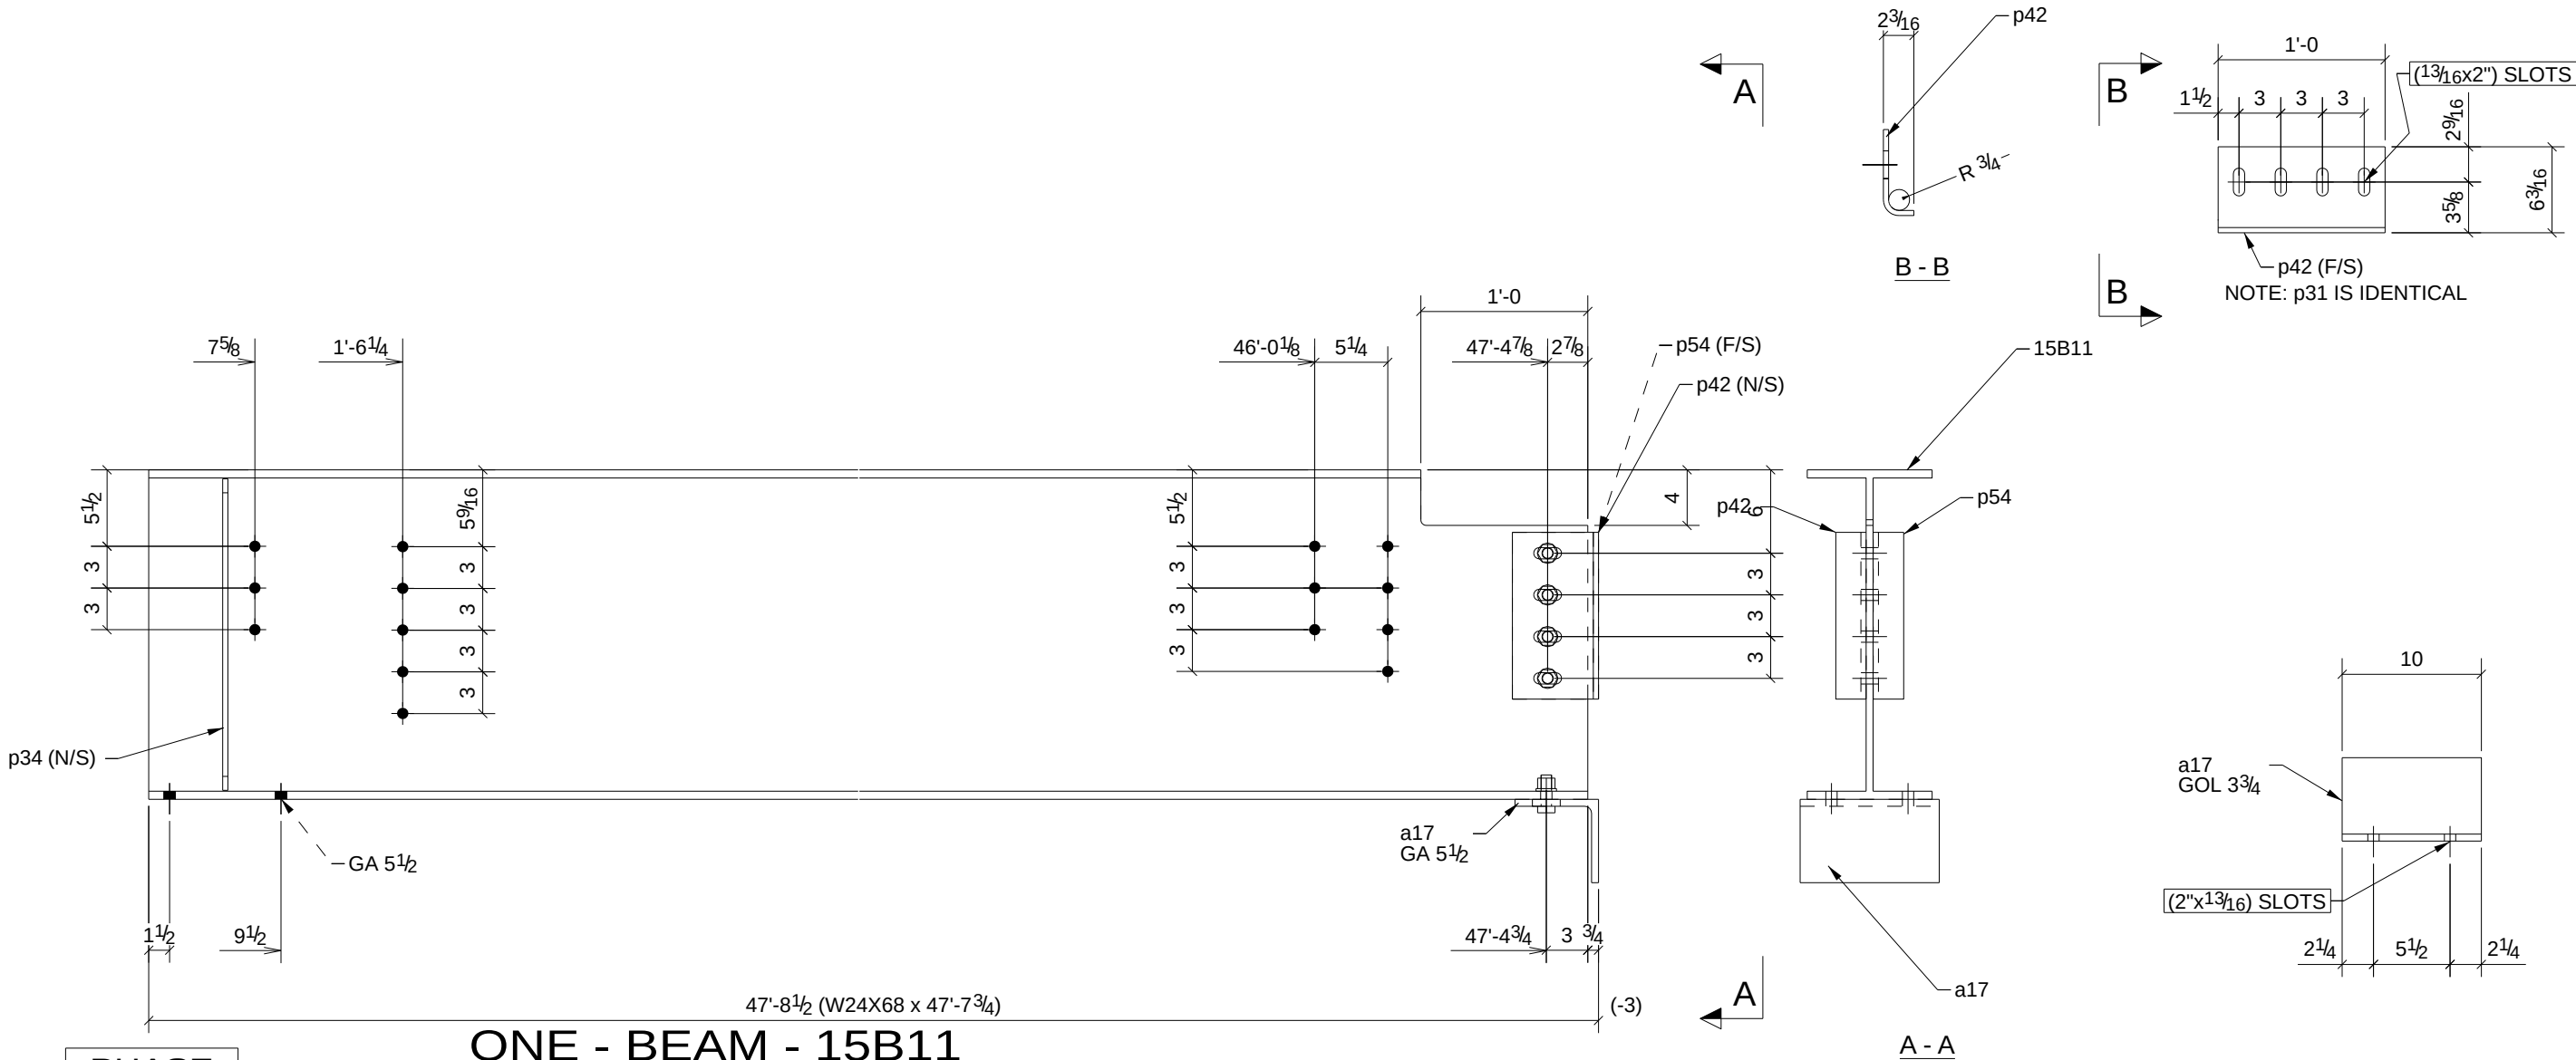

PHASE				
1	2	3	4	5
1	0	0	0	0


ONE - BEAM - 15B11

W	23 11/16" x 7/16"
F	9" x 9/16"

BILL OF MATERIAL

SHIP	MARK	NO PCS	DESCRIPTION	LENGTH	PIECE MARK	REMARKS
1	15B11	1	W24X68	47'-7 3/4"		SQ-2 A992
		1	L6X6X1/2	0'-10"	a17	A36
		1	BAR3/8"X4"	1'-10 3/8"	p34	A36
		1	PL3/8"X7 5/8"	1'-0"	p42	A36 BENT
		1	PL3/8"X7 5/8"	1'-0"	p69	A36 BENT
		2	3/4"Ø A325N BOLT	0'-2 1/4"		
		4	3/4"Ø A325N BOLT	0'-2 1/2"		

A	For Approval & Field Survey		8/30/10	TMc	TAN
0	For Fabrication & F&F		9/15/10	TMc	TAN
REV.	DESCRIPTION		DATE	DWN	CHK
GENERAL NOTES			JOB USE		
MATERIAL: A992 / A36		ELECTRODES: E70XX LH	REF. DRG.		
HOLES: 13/16 DIA. U/N		CONN'S.: -		SHOP	
SURFACE PREP. SSPC-SP-2			APPROVAL		
AND PAINT: GREY PRIMER DEVOE NA-195 (U.N.)					
DESCRIPTION: BEAM					
PROJECT NAME		Hamilton High School Phase III			
LOCATION		Hamilton City School District - Hamilton			
CONTRACTOR GC Contracting					
	Avenue Fabricating Inc. 1281 Clough Pike Batavia, OH 45103 (513) 752-1911		DRAWN BY TMc		DATE 08/30/2010
			CHKD. BY TAN		DATE
			JOB No. 10-16		DRG. No. 15B11

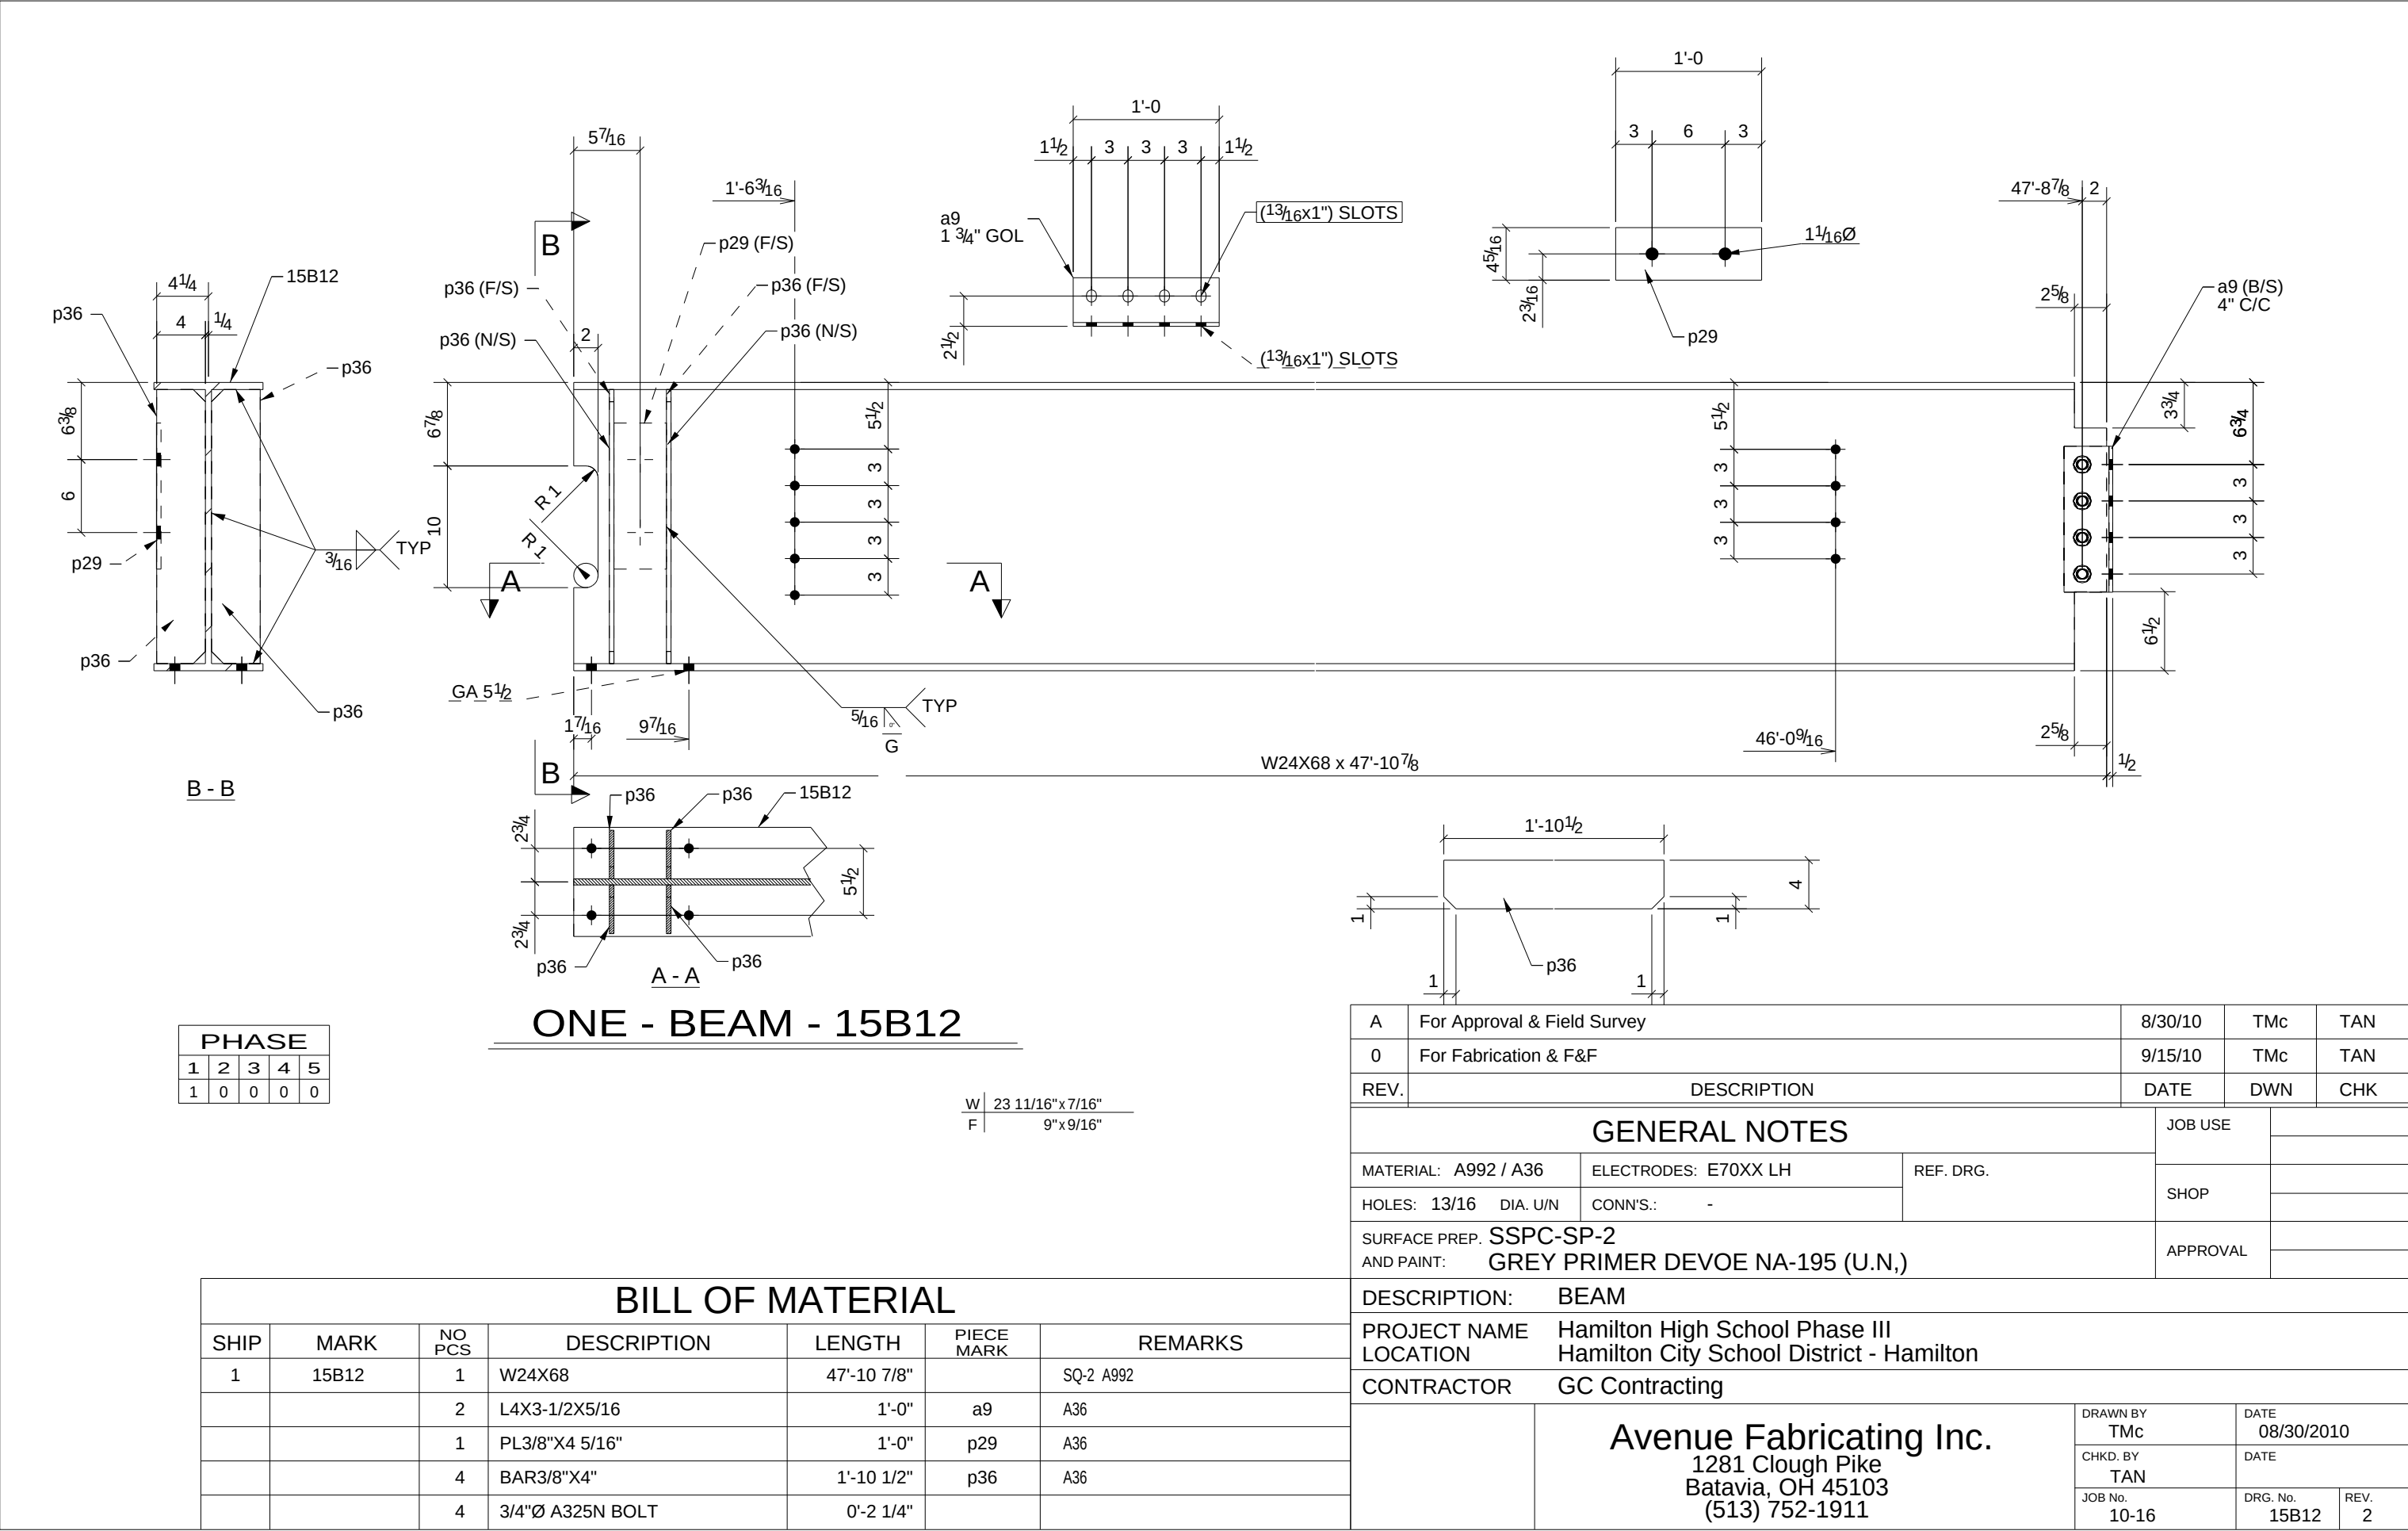

PHASE				
1	2	3	4	5
1	0	0	0	0


W	23 11/16"x 7/16"
F	9"x 9/16"

ONE - BEAM - 15B12

BILL OF MATERIAL

SHIP	MARK	NO PCS	DESCRIPTION	LENGTH	PIECE MARK	REMARKS
1	15B12	1	W24X68	47'-10 7/8"		SQ-2 A992
		2	L4X3-1/2X5/16	1'-0"	a9	A36
		1	PL3/8"X4 5/16"	1'-0"	p29	A36
		4	BAR3/8"X4"	1'-10 1/2"	p36	A36
		4	3/4"Ø A325N BOLT	0'-2 1/4"		

A	For Approval & Field Survey	8/30/10	TMc	TAN
0	For Fabrication & F&F	9/15/10	TMc	TAN
REV.	DESCRIPTION	DATE	DWN	CHK
GENERAL NOTES		JOB USE		
MATERIAL: A992 / A36	ELECTRODES: E70XX LH	REF. DRG.		
HOLES: 13/16 DIA. U/N	CONN'S.: -		SHOP	
SURFACE PREP. SSPC-SP-2			APPROVAL	
AND PAINT: GREY PRIMER DEVOE NA-195 (U.N.)				
DESCRIPTION:	BEAM			
PROJECT NAME	Hamilton High School Phase III			
LOCATION	Hamilton City School District - Hamilton			
CONTRACTOR	GC Contracting			
	Avenue Fabricating Inc.	DRAWN BY	DATE	
	1281 Clough Pike	TMc	08/30/2010	
	Batavia, OH 45103	CHKD. BY	DATE	
	(513) 752-1911	TAN		
		JOB No.	DRG. No.	REV.
		10-16	15B12	2

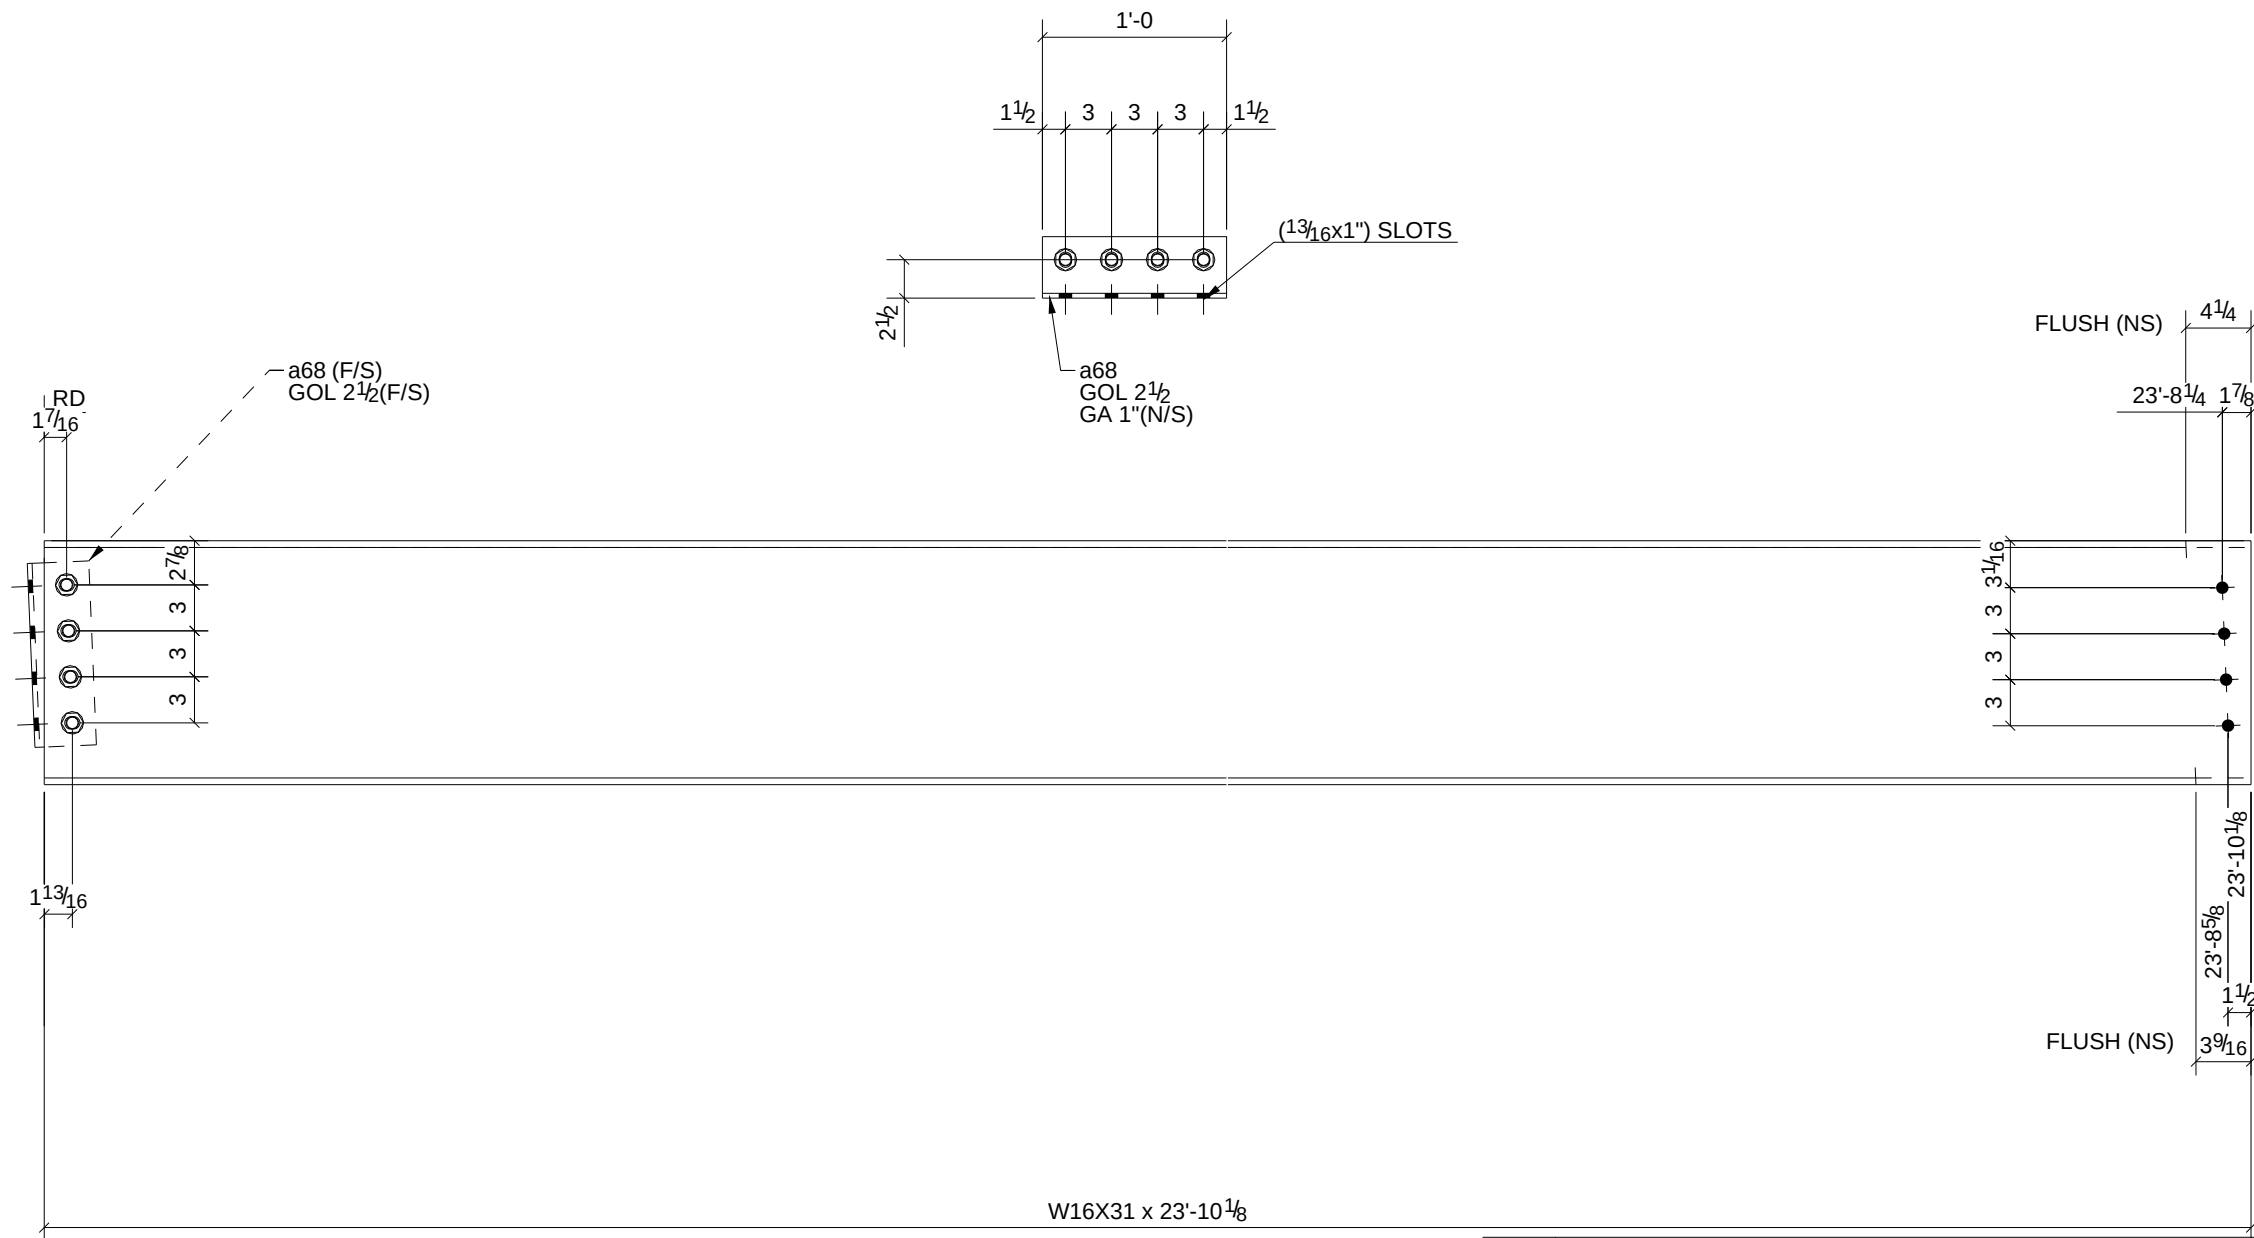

PHASE				
1	2	3	4	5
1	0	0	0	0


ONE - BEAM - 15B13

W	15 7/8"x1/4"
F	5 1/2"x7/16"

BILL OF MATERIAL


SHIP	MARK	NO PCS	DESCRIPTION	LENGTH	PIECE MARK	REMARKS
1	15B13	1	W16X31	23'-10 1/8"		SQ-2 A992
		1	L4X4X5/16	1'-0"	a68	A36
		4	3/4"Ø A325N BOLT	0'-1 3/4"		

0	For Fabrication & F&F			9/15/10	TMc	TAN	
REV.	DESCRIPTION			DATE	DWN	CHK	
GENERAL NOTES				JOB USE			
				MATERIAL: A992 / A36		ELECTRODES: E70XX LH	
HOLES: 13/16 DIA. U/N		CONN'S.: -					
SURFACE PREP: SSPC-SP-2				APPROVAL			
AND PAINT: GREY PRIMER DEVOE NA-195 (U.N,)							
DESCRIPTION: BEAM							
PROJECT NAME Hamilton High School Phase III							
LOCATION Hamilton City School District - Hamilton							
CONTRACTOR GC Contracting							
		Avenue Fabricating Inc. 1281 Clough Pike Batavia, OH 45103 (513) 752-1911		DRAWN BY		DATE	
				TMc		08/30/2010	
				CHKD. BY		DATE	
				TAN			
				JOB No.		DRG. No.	REV.
				10-16		15B13	1

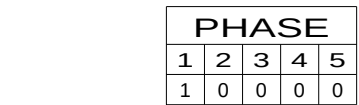

W	15 7/8"x 1/4"
F	5 1/2"x 7/16"

A	For Approval & Field Survey	8/30/10	TMc	TAN
0	For Fabrication & F&F	9/15/10	TMc	TAN
REV.	DESCRIPTION	DATE	DWN	CHK
GENERAL NOTES		JOB USE		
MATERIAL: A992 / A36	ELECTRODES: E70XX LH	REF. DRG.		
HOLES: 13/16 DIA. U/N	CONN'S.: -		SHOP	
SURFACE PREP. SSPC-SP-2		APPROVAL		
AND PAINT: GREY PRIMER DEVOE NA-195 (U.N.)				
DESCRIPTION: BEAM				
PROJECT NAME Hamilton High School Phase III				
LOCATION Hamilton City School District - Hamilton				
CONTRACTOR GC Contracting				
	Avenue Fabricating Inc. 1281 Clough Pike Batavia, OH 45103 (513) 752-1911	DRAWN BY TMC	DATE 08/30/2010	
		CHKD. BY TAN	DATE	
		JOB No. 10-16	DRG. No. 15B14	REV. 2

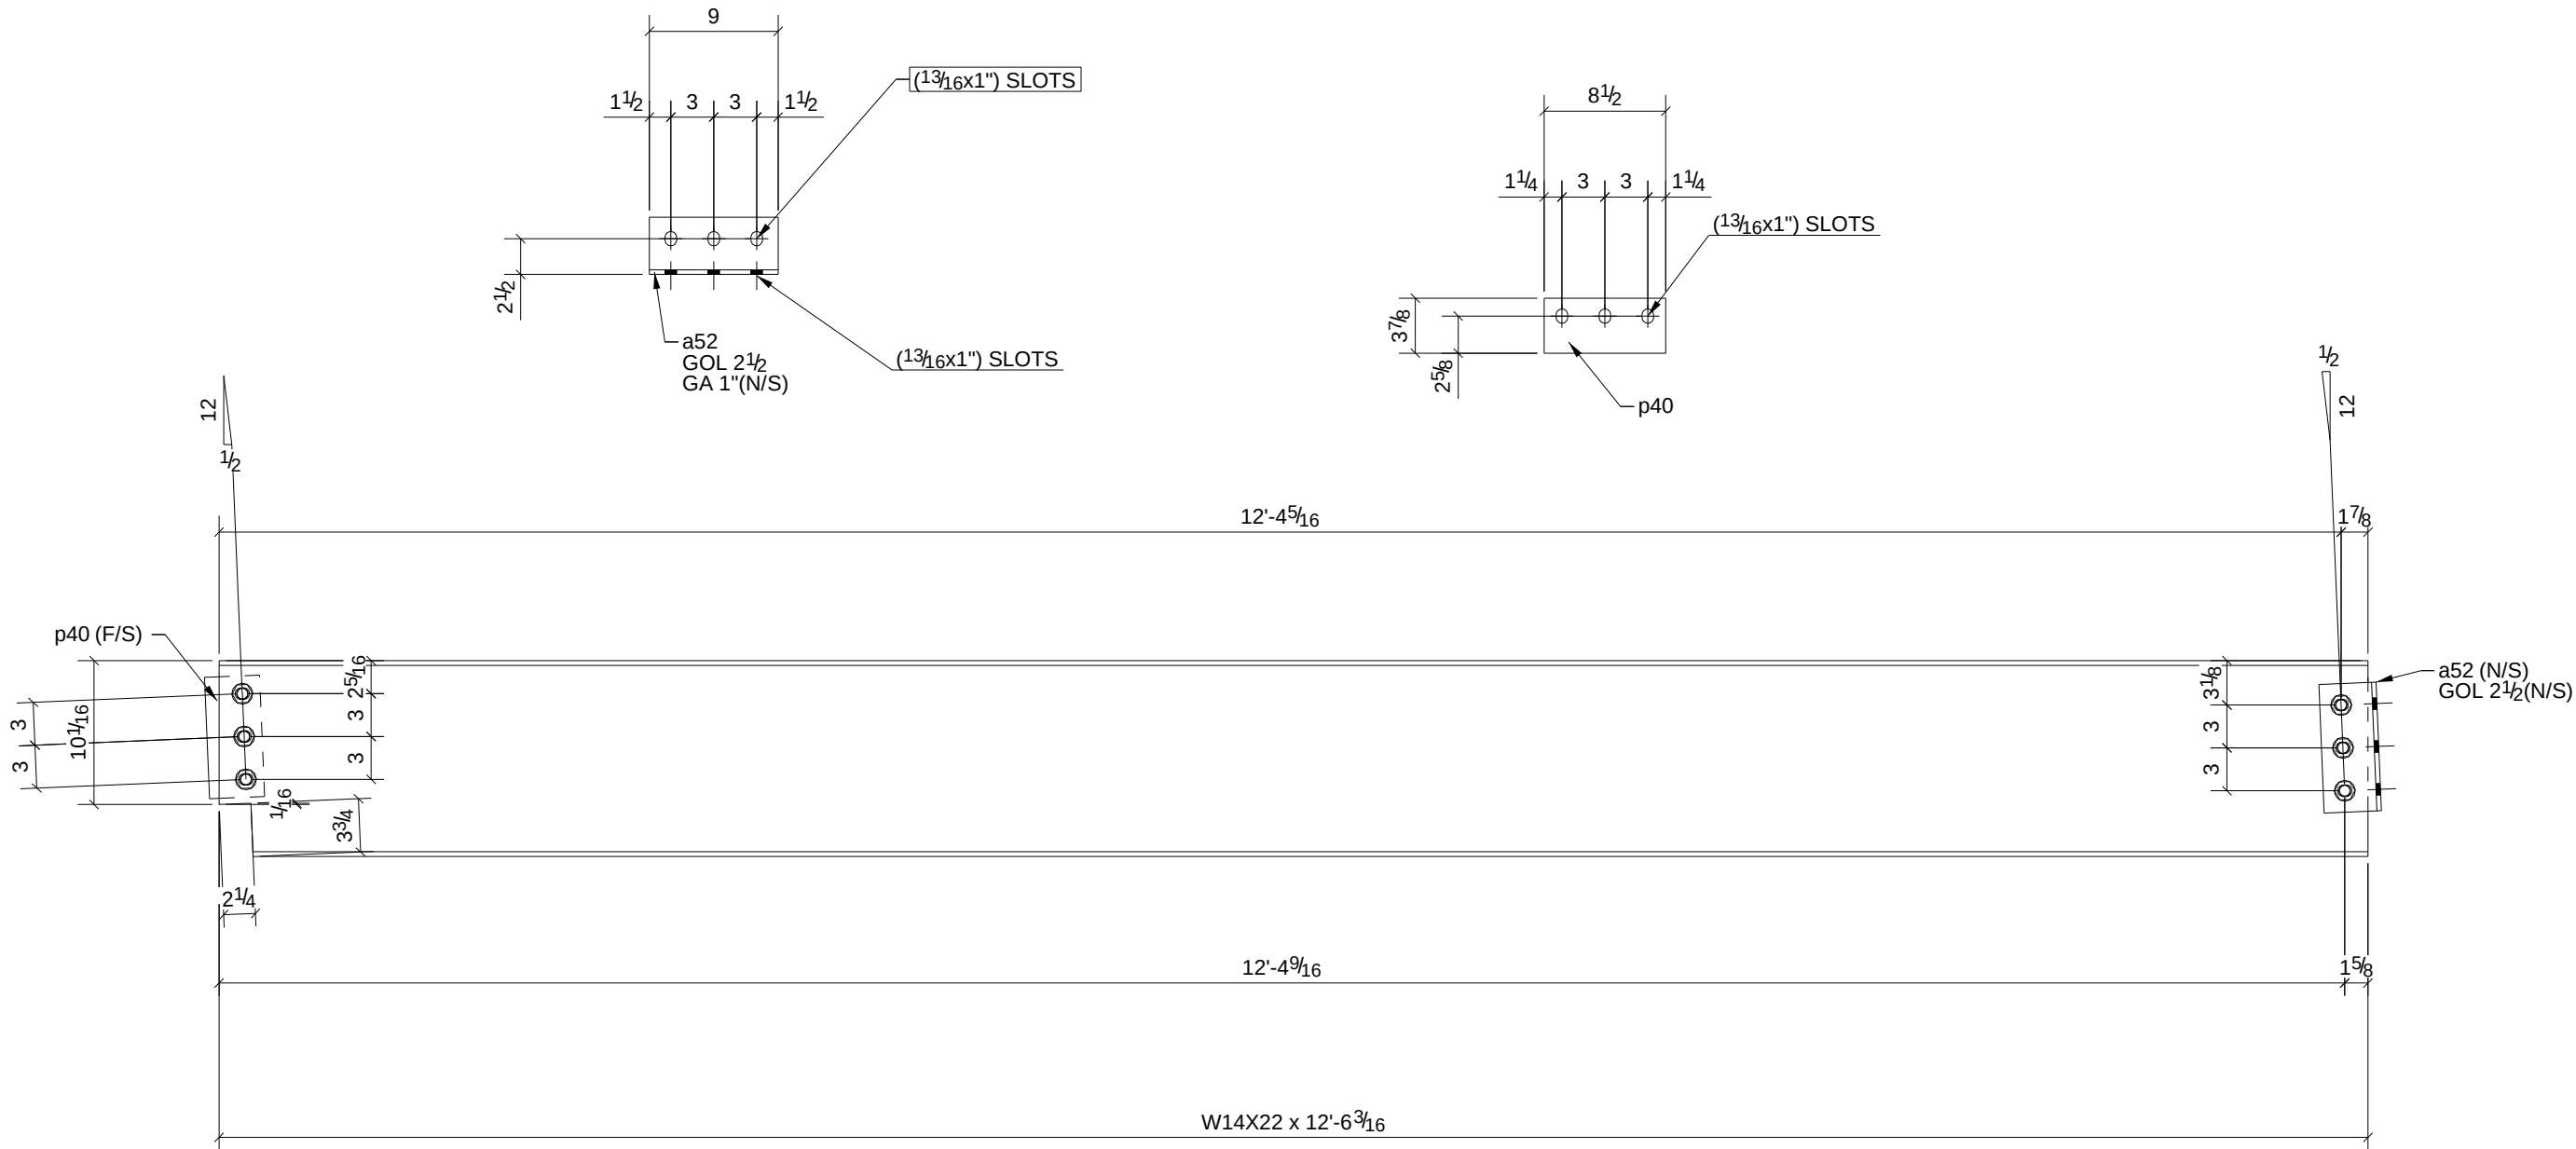

ONE - BEAM - 15B15


PHASE				
1	2	3	4	5
1	0	0	0	0

W	13 11/16"x1/4"
F	5"x5/16"

A	For Approval & Field Survey		8/30/10	TMc	TAN
0	For Fabrication & F&F		9/15/10	TMc	TAN
REV.	DESCRIPTION		DATE	DWN	CHK
GENERAL NOTES			JOB USE		
MATERIAL: A992 / A36		ELECTRODES: E70XX LH	REF. DRG.		
HOLES: 13/16 DIA. U/N		CONN'S.: -			SHOP
SURFACE PREP. SSPC-SP-2			APPROVAL		
AND PAINT: GREY PRIMER DEVOE NA-195 (U.N.)					
DESCRIPTION: BEAM					
PROJECT NAME		Hamilton High School Phase III			
LOCATION		Hamilton City School District - Hamilton			
CONTRACTOR		GC Contracting			
	Avenue Fabricating Inc. 1281 Clough Pike Batavia, OH 45103 (513) 752-1911		DRAWN BY TMc	DATE 08/30/2010	
			CHKD. BY TAN	DATE	
			JOB No. 10-16	DRG. No. 15B15	REV. 2

BILL OF MATERIAL

SHIP	MARK	NO PCS	DESCRIPTION	LENGTH	PIECE MARK	REMARKS
1	15B15	1	W14X22	12'-6 3/16"		SQ-2 A992
		1	L4X4X5/16	0'-9"	a52	A36
		1	PL3/8"X3 7/8"	0'-8 1/2"	p40	A36
		6	3/4"Ø A325N BOLT	0'-1 3/4"		

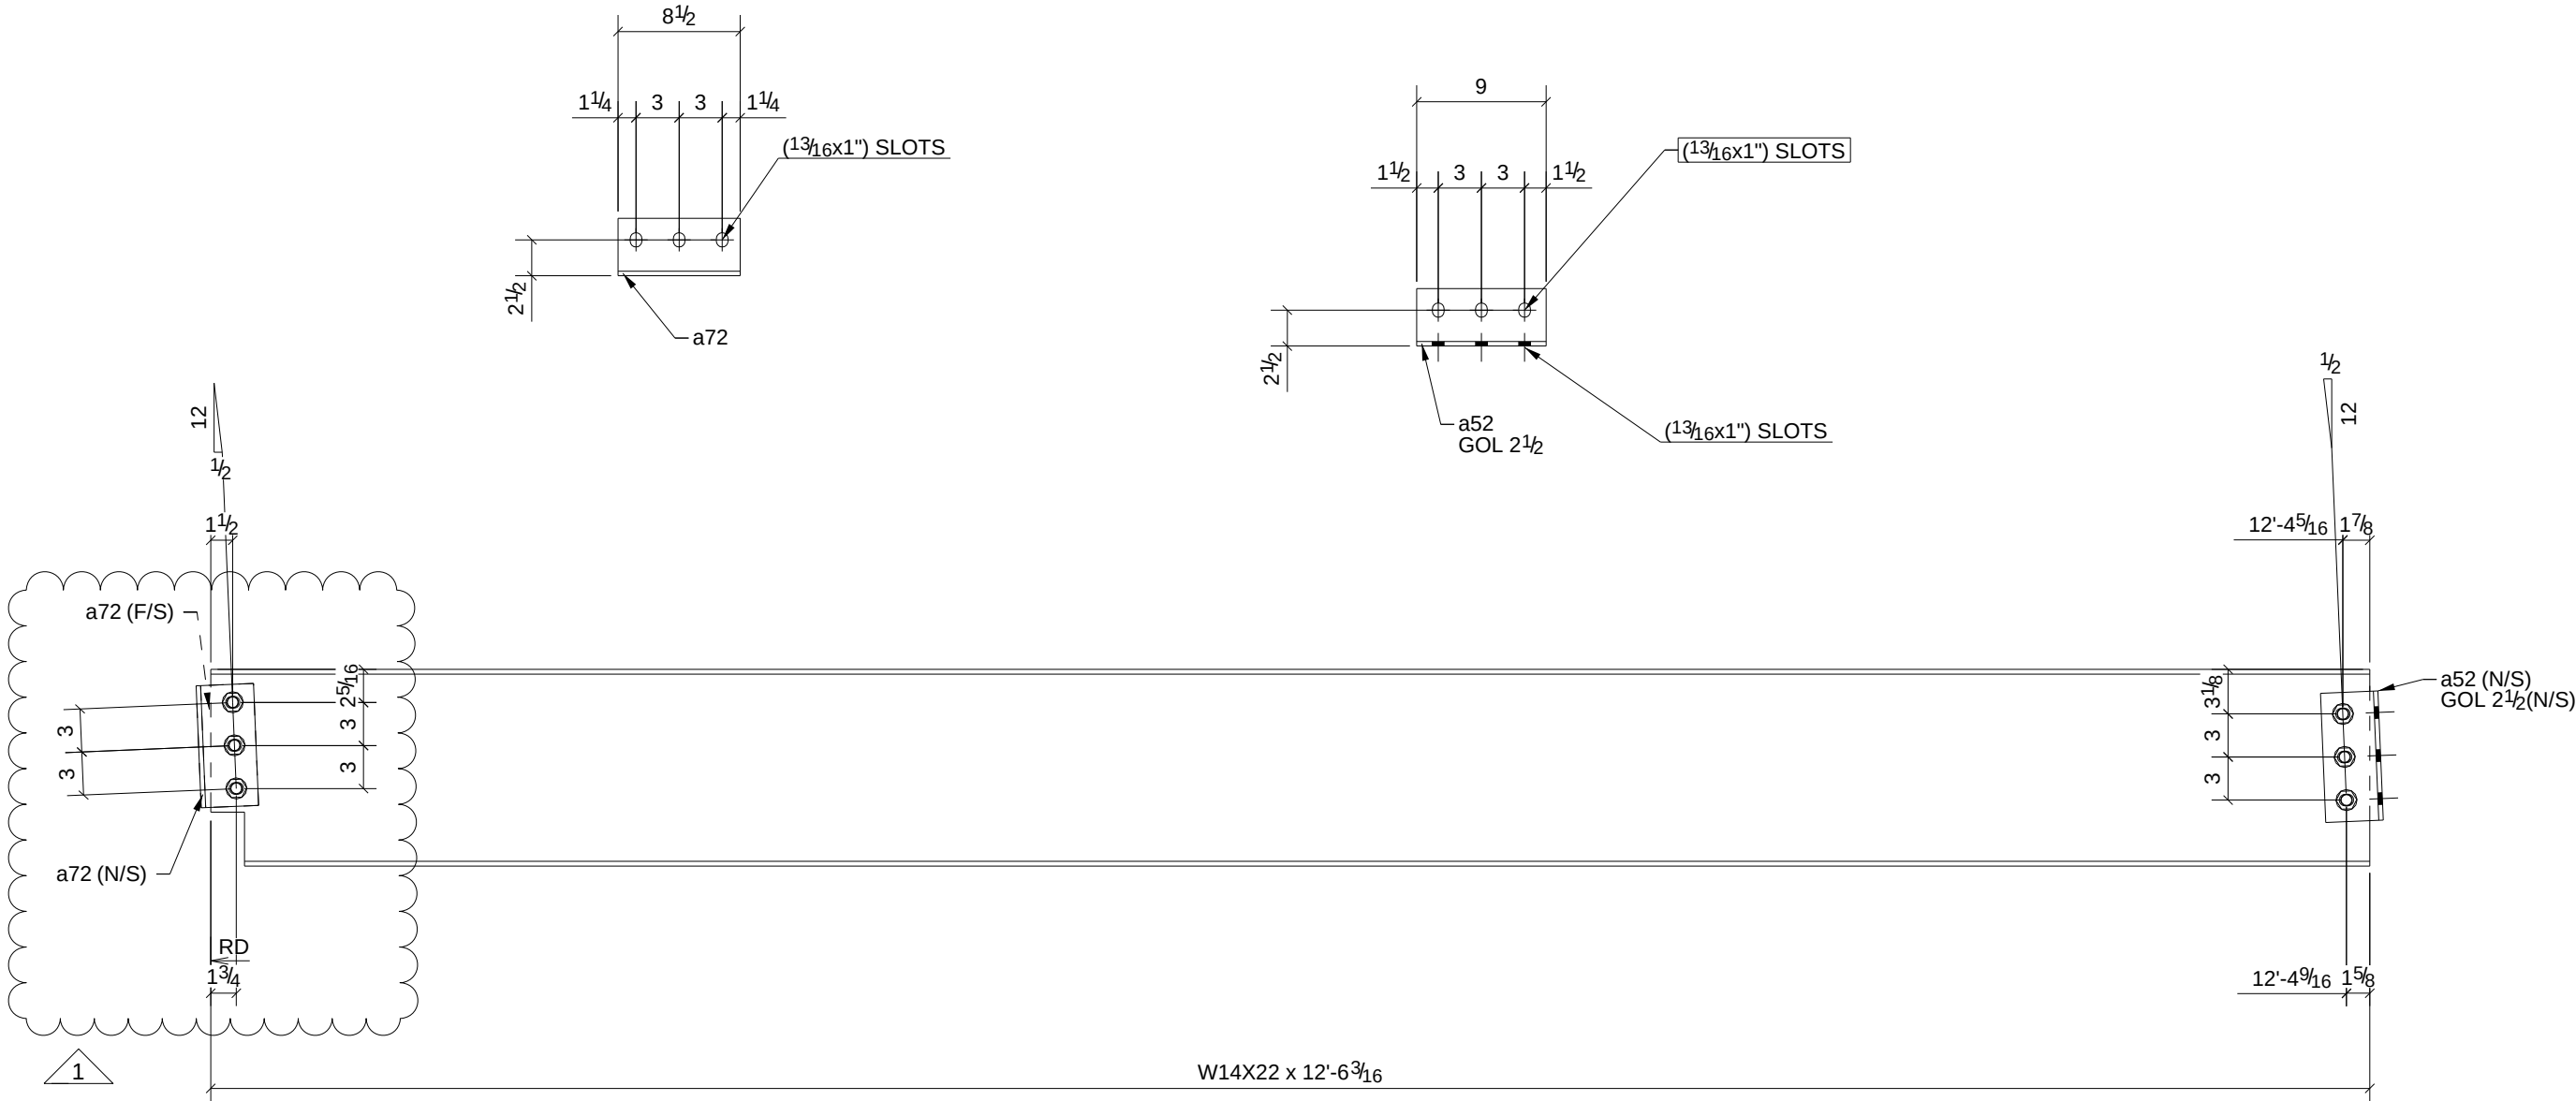

PHASE				
1	2	3	4	5
1	0	0	0	0


ONE - BEAM - 15B15

W	13 11/16"x 1/4"
F	5"x 5/16"

BILL OF MATERIAL

SHIP	MARK	NO PCS	DESCRIPTION	LENGTH	PIECE MARK	REMARKS
1	15B15	1	W14X22	12'-6 3/16"		SQ-2 A992
		1	L4X4X5/16	0'-9"	a52	A36
		2	L4X4X5/16	0'-8 1/2"	a72	A36
		3	3/4"Ø A325N BOLT	0'-2"		
		3	3/4"Ø A325N BOLT	0'-1 3/4"		

A	For Approval & Field Survey		8/30/10	TMc	TAN
1	revised shear bar to angles		9-17-10		
0	For Fabrication & F&F		9/15/10	TMc	TAN
REV.	DESCRIPTION		DATE	DWN	CHK
GENERAL NOTES			JOB USE		
MATERIAL: A992 / A36		ELECTRODES: E70XX LH	REF. DRG.		
HOLES: 13/16 DIA. U/N		CONN'S.: -		SHOP	
SURFACE PREP. SSPC-SP-2			APPROVAL		
AND PAINT: GREY PRIMER DEVOE NA-195 (U.N.)					
DESCRIPTION: BEAM					
PROJECT NAME Hamilton High School Phase III					
LOCATION Hamilton City School District - Hamilton					
CONTRACTOR GC Contracting					
	Avenue Fabricating Inc. 1281 Clough Pike Batavia, OH 45103 (513) 752-1911		DRAWN BY		DATE
			TMc		08/30/2010
			CHKD. BY		DATE
			TAN		
		JOB No.	DRG. No.	REV.	
		10-16	15B15	3	

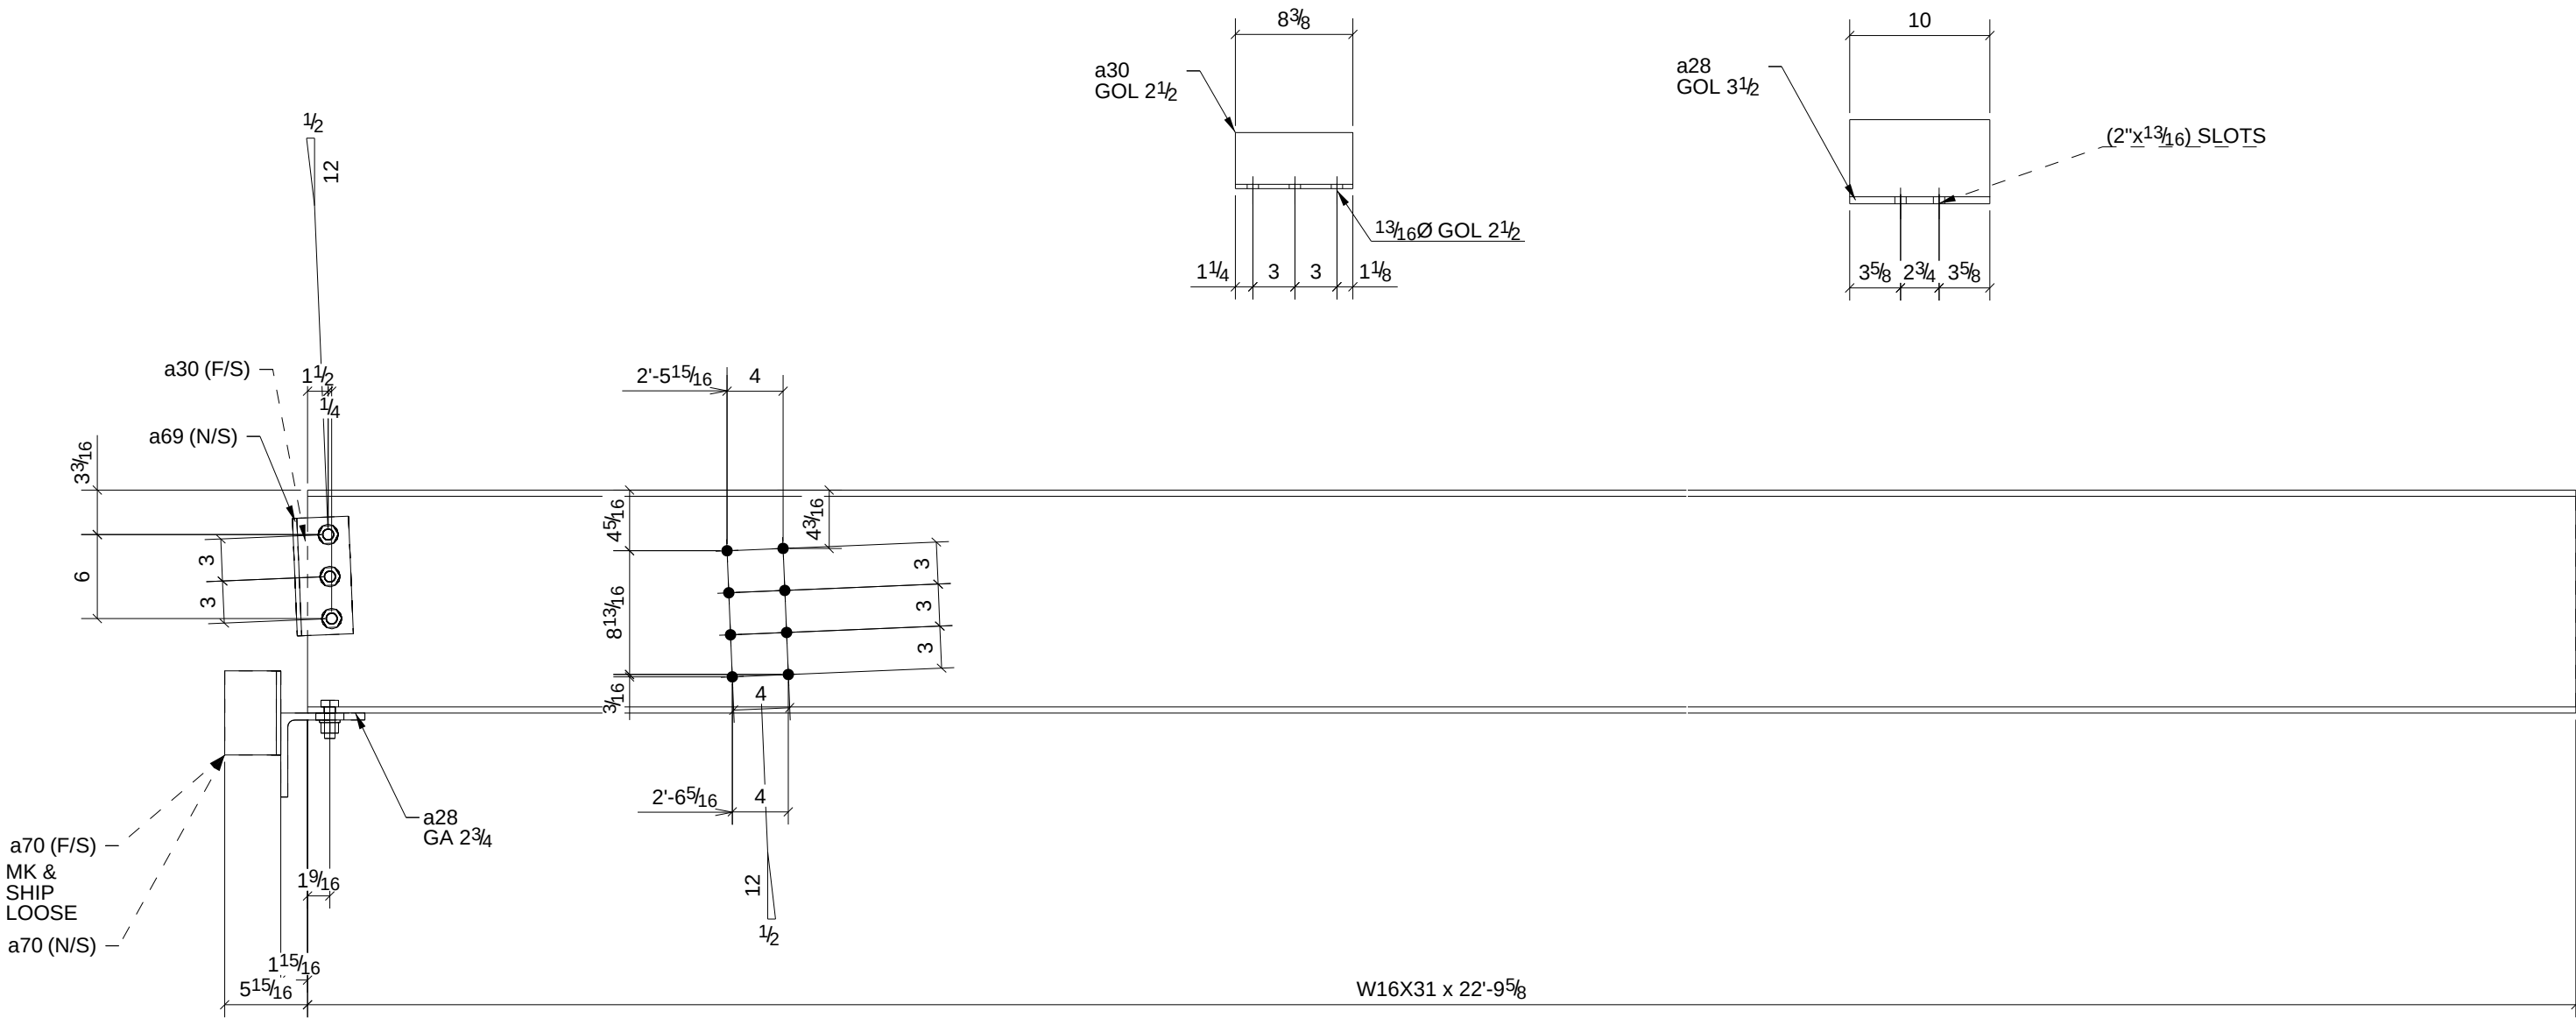


2 - BEAMS - 15B16

PHASE				
1	2	3	4	5
2	0	0	0	0

W	15 7/8" x 1/4"
F	5 1/2" x 7/16"

BILL OF MATERIAL						
SHIP	MARK	NO PCS	DESCRIPTION	LENGTH	PIECE MARK	REMARKS
2	15B16	2	W16X31	22'-9 5/8"		SQ-2 A992
		2	L6X6X1/2	0'-10"	a28	A36
		2	L4X4X5/16	0'-8 3/8"	a30	A36
		2	L4X4X5/16	0'-8 3/8"	a69	A36
		4	L4X4X5/16	0'-6"	a70	A36
		6	3/4"Ø A325N BOLT	0'-2"		
		4	3/4"Ø A325N BOLT	0'-2 1/4"		

0	For Fabrication & F&F		9/15/10	TMc	TAN
REV.	DESCRIPTION		DATE	DWN	CHK
GENERAL NOTES			JOB USE		
MATERIAL: A992 / A36	ELECTRODES: E70XX LH	REF. DRG.	SHOP		
HOLES: 13/16 DIA. U/N	CONN'S.: -				
SURFACE PREP. SSPC-SP-2			APPROVAL		
AND PAINT: GREY PRIMER DEVOE NA-195 (U.N.)					
DESCRIPTION: BEAM					
PROJECT NAME		Hamilton High School Phase III			
LOCATION		Hamilton City School District - Hamilton			
CONTRACTOR		GC Contracting			
	Avenue Fabricating Inc. 1281 Clough Pike Batavia, OH 45103 (513) 752-1911		DRAWN BY TMc	DATE 08/30/2010	
			CHKD. BY TAN	DATE	
			JOB No. 10-16	DRG. No. 15B16	REV. 1

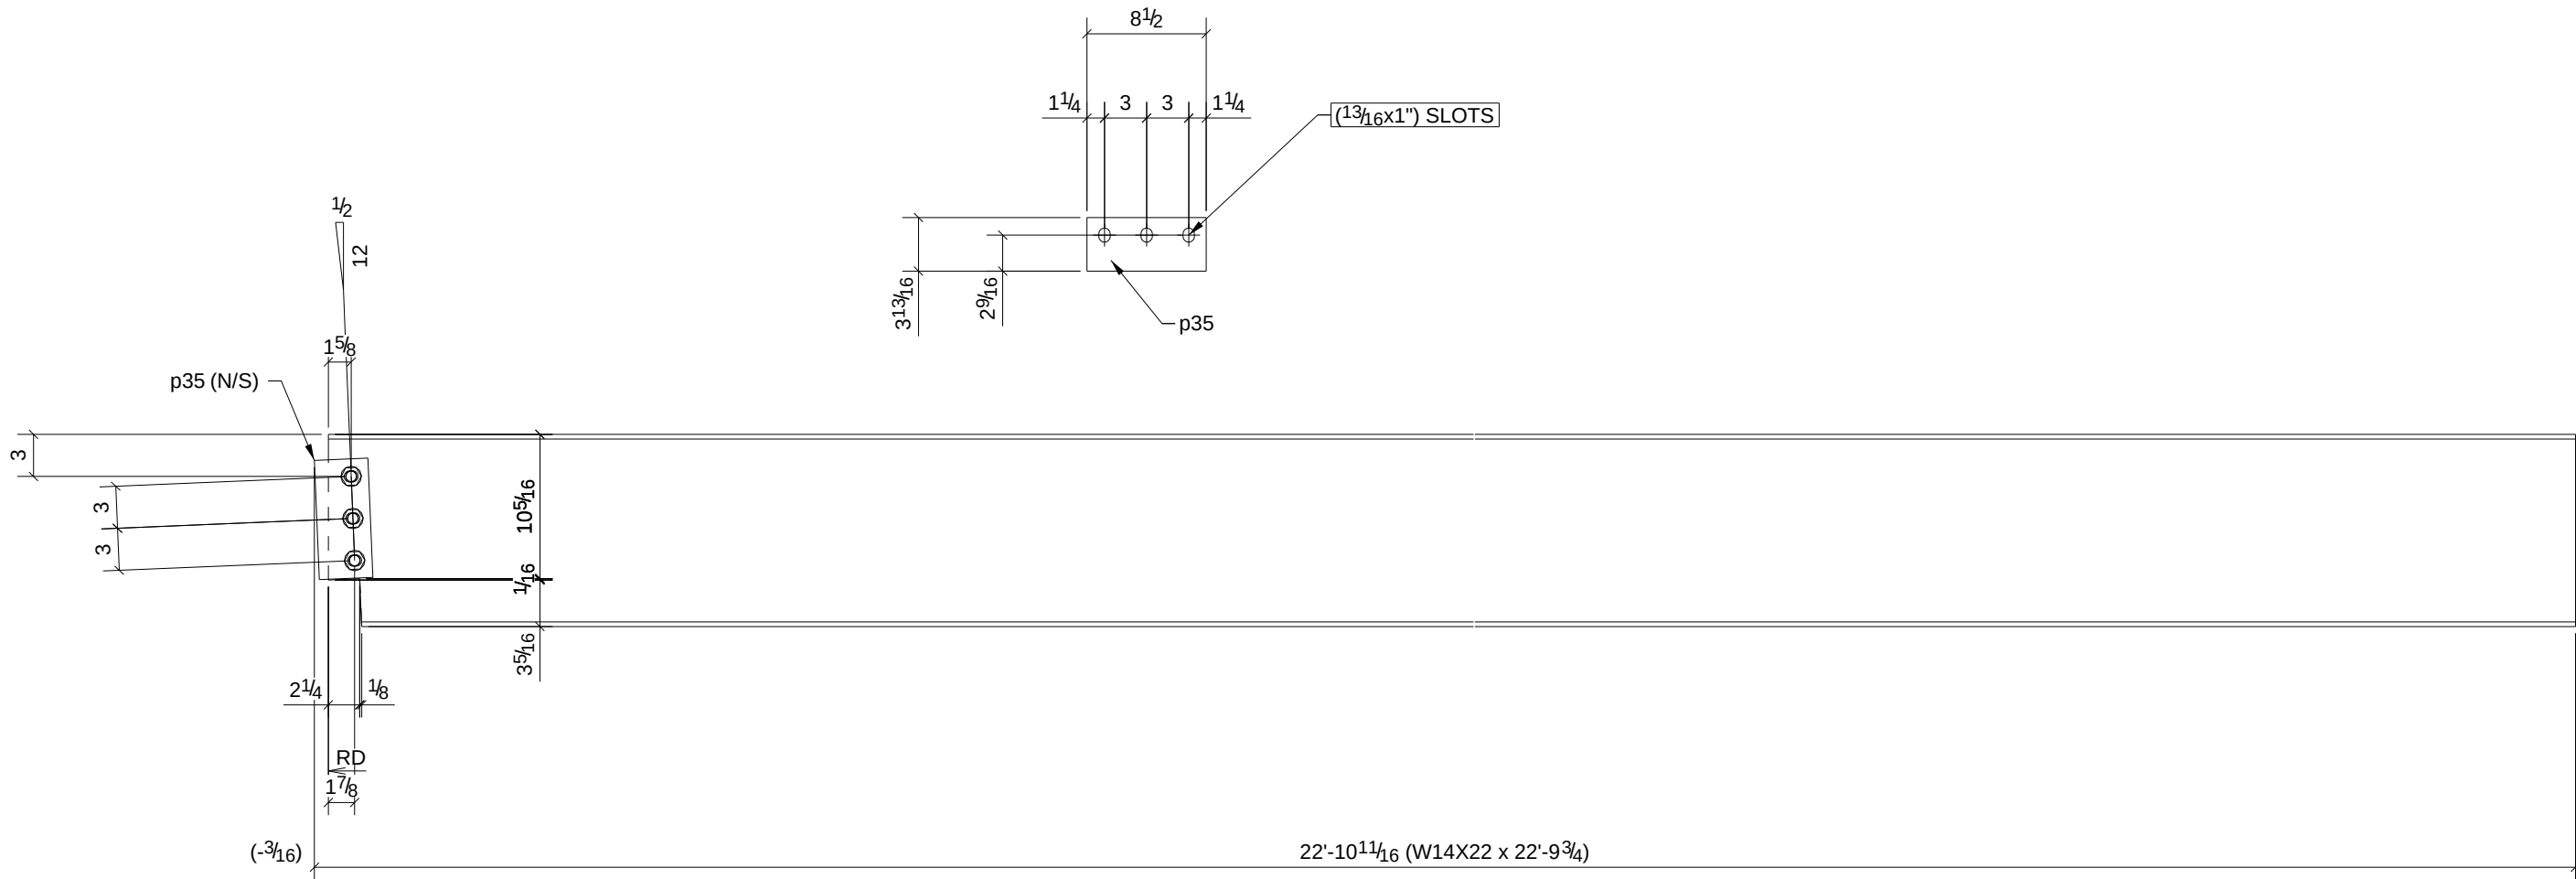

PHASE				
1	2	3	4	5
2	0	0	0	0


2 - BEAMS - 15B17

W	13 11/16"x1/4"
F	5"x5/16"

BILL OF MATERIAL

SHIP	MARK	NO PCS	DESCRIPTION	LENGTH	PIECE MARK	REMARKS
2	15B17	2	W14X22	22'-9 3/4"		SQ-2 A992
		2	PL3/8"X3 13/16"	0'-8 1/2"	p35	A36
		6	3/4"Ø A325N BOLT	0'-1 3/4"		


A	For Approval & Field Survey	8/30/10	TMc	TAN
0	For Fabrication & F&F	9/15/10	TMc	TAN
REV.	DESCRIPTION	DATE	DWN	CHK
GENERAL NOTES			JOB USE	
MATERIAL: A992 / A36	ELECTRODES: E70XX LH	REF. DRG.	SHOP	
HOLES: 13/16 DIA. U/N	CONN'S.: -			
SURFACE PREP. SS-PC-SP-2	AND PAINT: GREY PRIMER DEVOE NA-195 (U.N.)		APPROVAL	
DESCRIPTION:	BEAM			
PROJECT NAME	Hamilton High School Phase III			
LOCATION	Hamilton City School District - Hamilton			
CONTRACTOR	GC Contracting			
	Avenue Fabricating Inc.		DRAWN BY	DATE
	1281 Clough Pike		TMc	08/30/2010
	Batavia, OH 45103		CHKD. BY	DATE
	(513) 752-1911		TAN	
			JOB No.	DRG. No.
			10-16	15B17
				REV.
				2

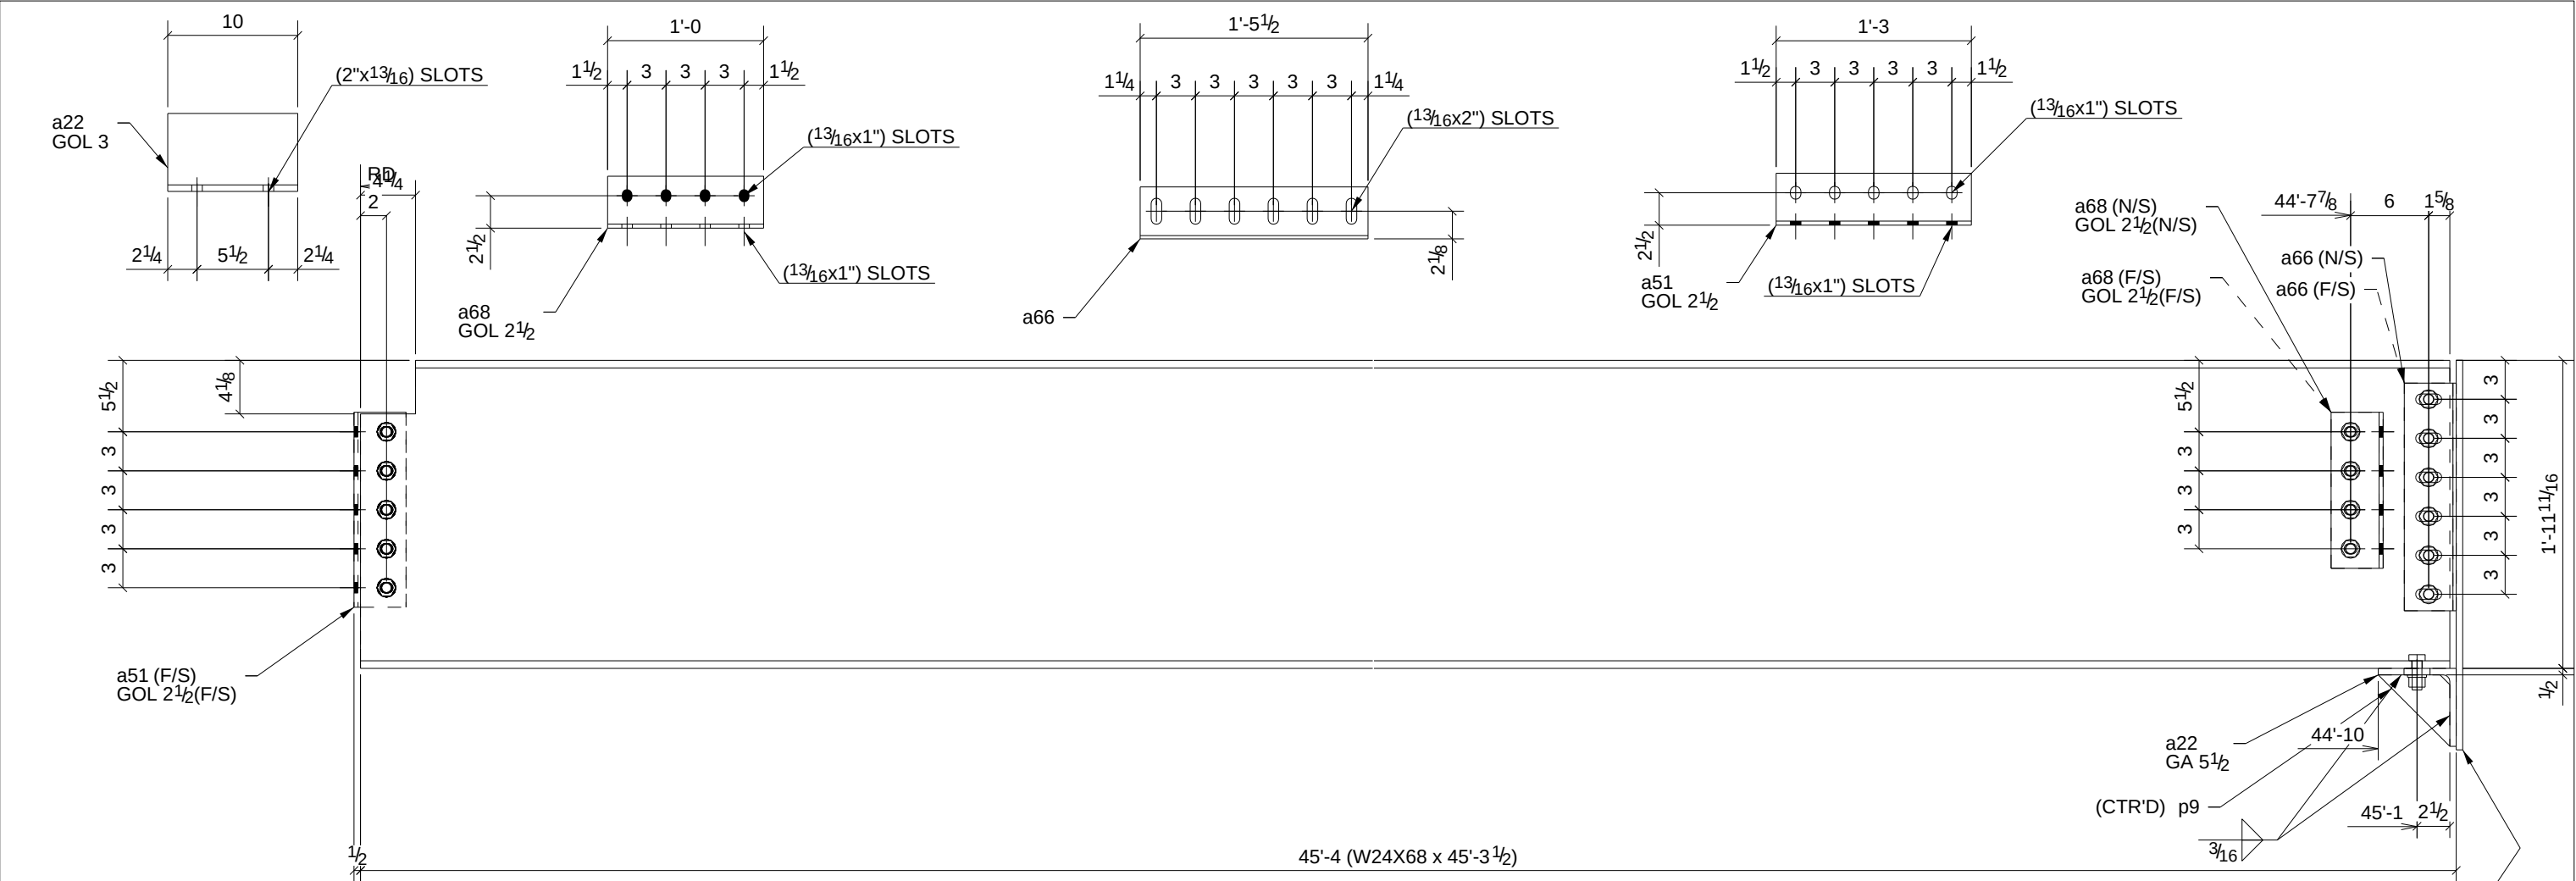

ONE - BEAM - 15B18

PHASE					
1	2	3	4	5	
1	0	0	0	0	


W	23 11/16"x7/16"
F	9"x9/16"

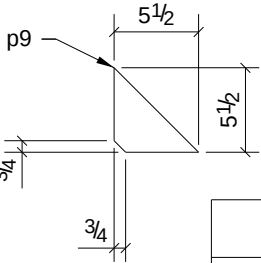


BILL OF MATERIAL

SHIP	MARK	NO PCS	DESCRIPTION	LENGTH	PIECE MARK	REMARKS
1	15B18	1	W24X68	45'-3 1/2"		SQ-2 A992
		1	L6X6X1/2	0'-10"	a22	A36
		1	L4X4X5/16	1'-3"	a51	A36
		2	L4X4X1/4	1'-5 1/2"	a66	A36
		2	L4X4X5/16	1'-0"	a68	A36
		1	BAR3/4"X5 1/2"	0'-5 1/2"	p9	A36
		1	BAR1/2"X7"	2'-6"	p68	A36
		5	3/4"Ø A325N BOLT	0'-2"		
		12	3/4"Ø A325N BOLT	0'-2 1/4"		

0	For Fabrication & F&F	9/15/10	TMc	TAN
REV.	DESCRIPTION	DATE	DWN	CHK
GENERAL NOTES		JOB USE		
MATERIAL: A992 / A36	ELECTRODES: E70XX LH	REF. DRG.		
HOLES: 13/16 DIA. U/N	CONN'S.: -		SHOP	
SURFACE PREP. SSPC-SP-2	AND PAINT: GREY PRIMER DEVOE NA-195 (U.N.)		APPROVAL	
DESCRIPTION:	BEAM			
PROJECT NAME	Hamilton High School Phase III			
LOCATION	Hamilton City School District - Hamilton			
CONTRACTOR	GC Contracting			
Avenue Fabricating Inc. 1281 Clough Pike Batavia, OH 45103 (513) 752-1911		DRAWN BY TMc	DATE 09/01/2010	
		CHKD. BY TAN	DATE	
		JOB No. 10-16	DRG. No. 15B18	REV. 4

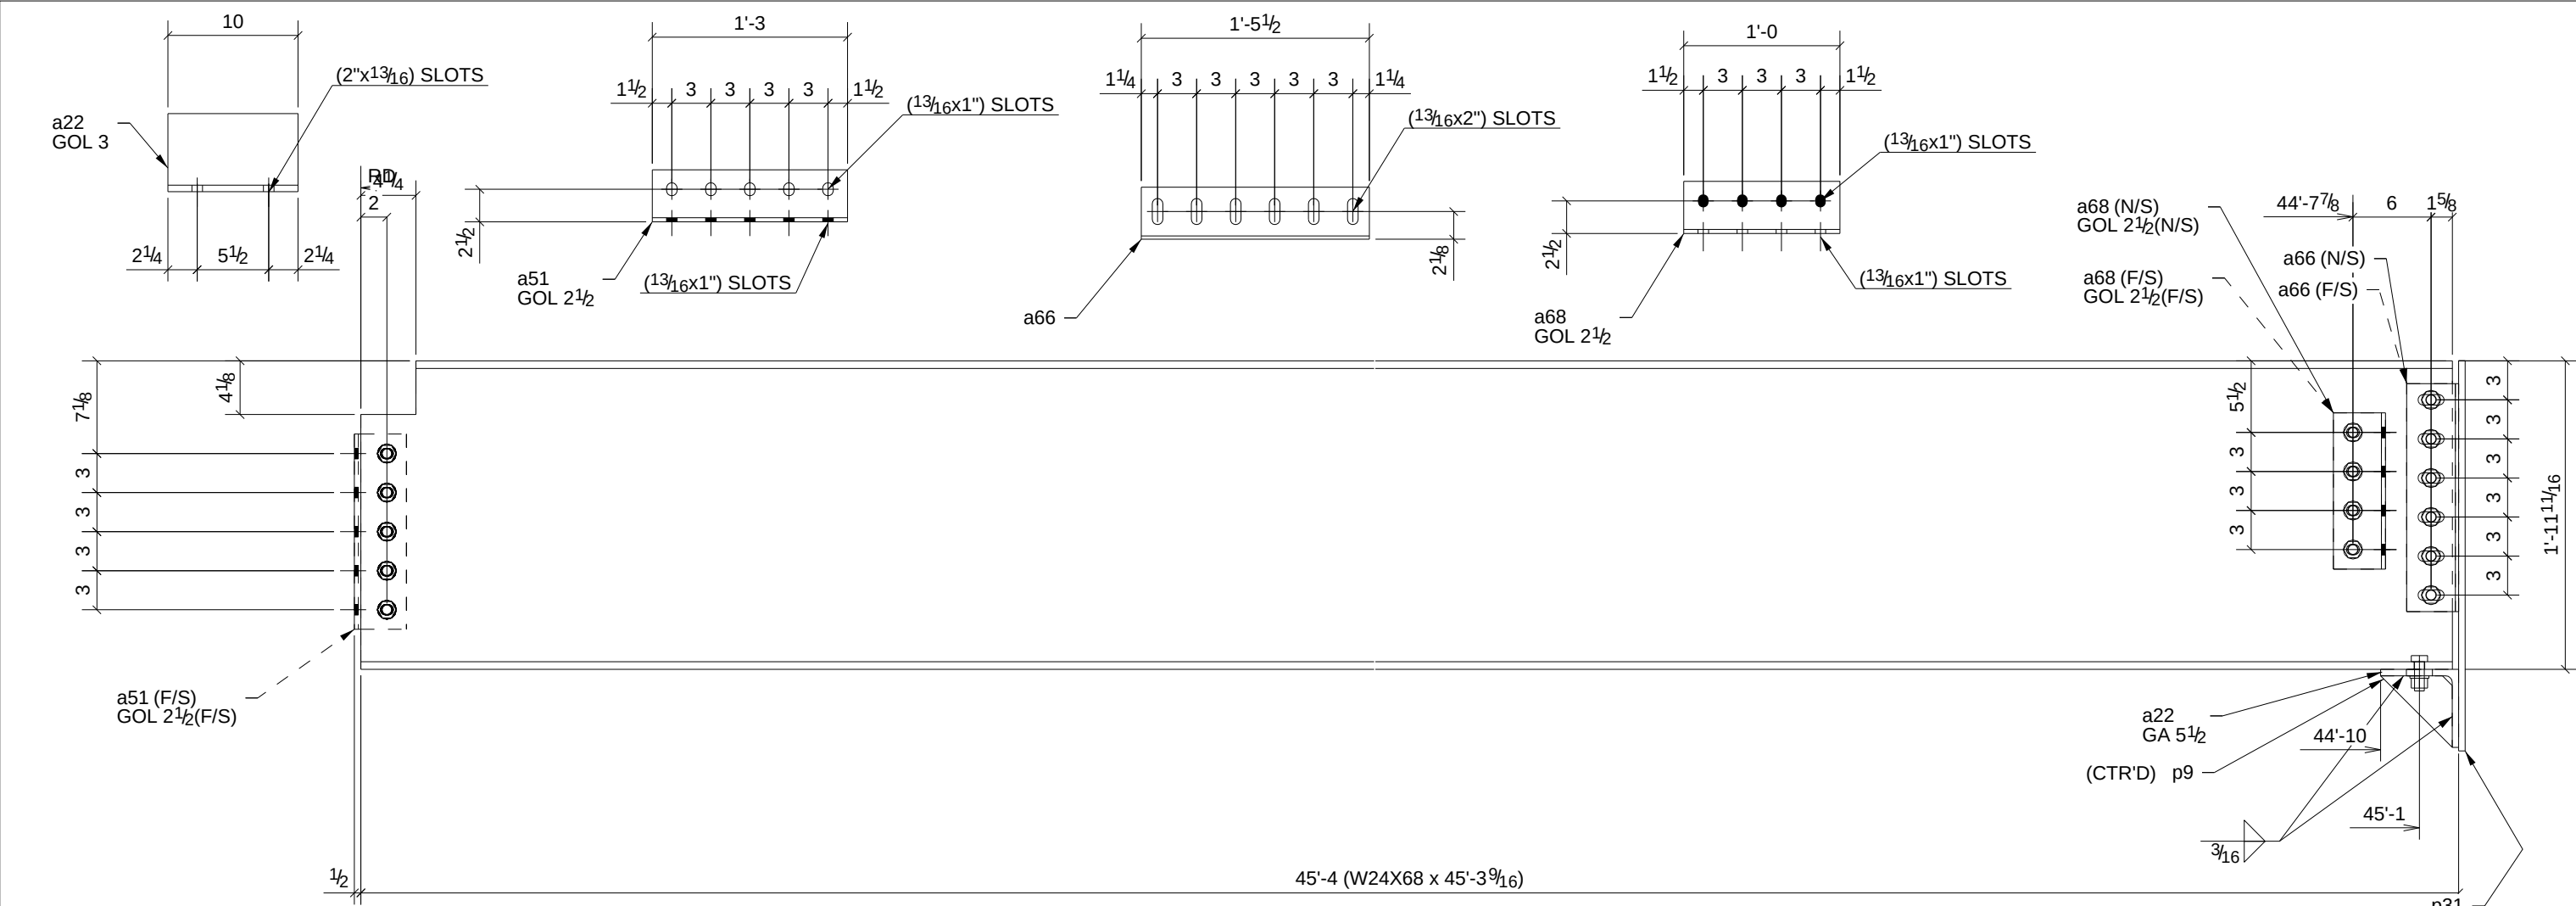

ONE - BEAM - 15B19

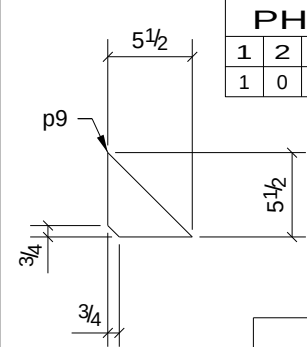


PHASE					
1	2	3	4	5	
1	0	0	0	0	

W	23 11/16"x7/16"
F	9"x9/16"

BILL OF MATERIAL						
SHIP	MARK	NO PCS	DESCRIPTION	LENGTH	PIECE MARK	REMARKS
1	15B19	1	W24X68	45'-3 9/16"		SQ-2 A992
		1	L6X6X1/2	0'-10"	a22	A36
		1	L4X4X5/16	1'-3"	a51	A36
		2	L4X4X1/4	1'-5 1/2"	a66	A36
		2	L4X4X5/16	1'-0"	a68	A36
		1	BAR3/4"x5 1/2"	0'-5 1/2"	p9	A36
		1	BAR1/2"x7"	2'-6"	p31	A36
		5	3/4"Ø A325N BOLT	0'-2"		
		12	3/4"Ø A325N BOLT	0'-2 1/4"		

0	For Fabrication & F&F			9/15/10	TMc	TAN	
REV.	DESCRIPTION			DATE	DWN	CHK	
GENERAL NOTES				JOB USE			
				SHOP			
MATERIAL: A992 / A36		ELECTRODES: E70XX LH		REF. DRG.			
HOLES: 13/16 DIA. U/N		CONN'S.: -					
SURFACE PREP. SSPC-SP-2 AND PAINT: GREY PRIMER DEVOE NA-195 (U.N.)				APPROVAL			
DESCRIPTION: BEAM							
PROJECT NAME		Hamilton High School Phase III					
LOCATION		Hamilton City School District - Hamilton					
CONTRACTOR		GC Contracting					
	Avenue Fabricating Inc. 1281 Clough Pike Batavia, OH 45103 (513) 752-1911			DRAWN BY TMc		DATE 09/15/2010	
				CHKD. BY TAN		DATE	
				JOB No. 10-16		DRG. No. 15B19 REV. 1	

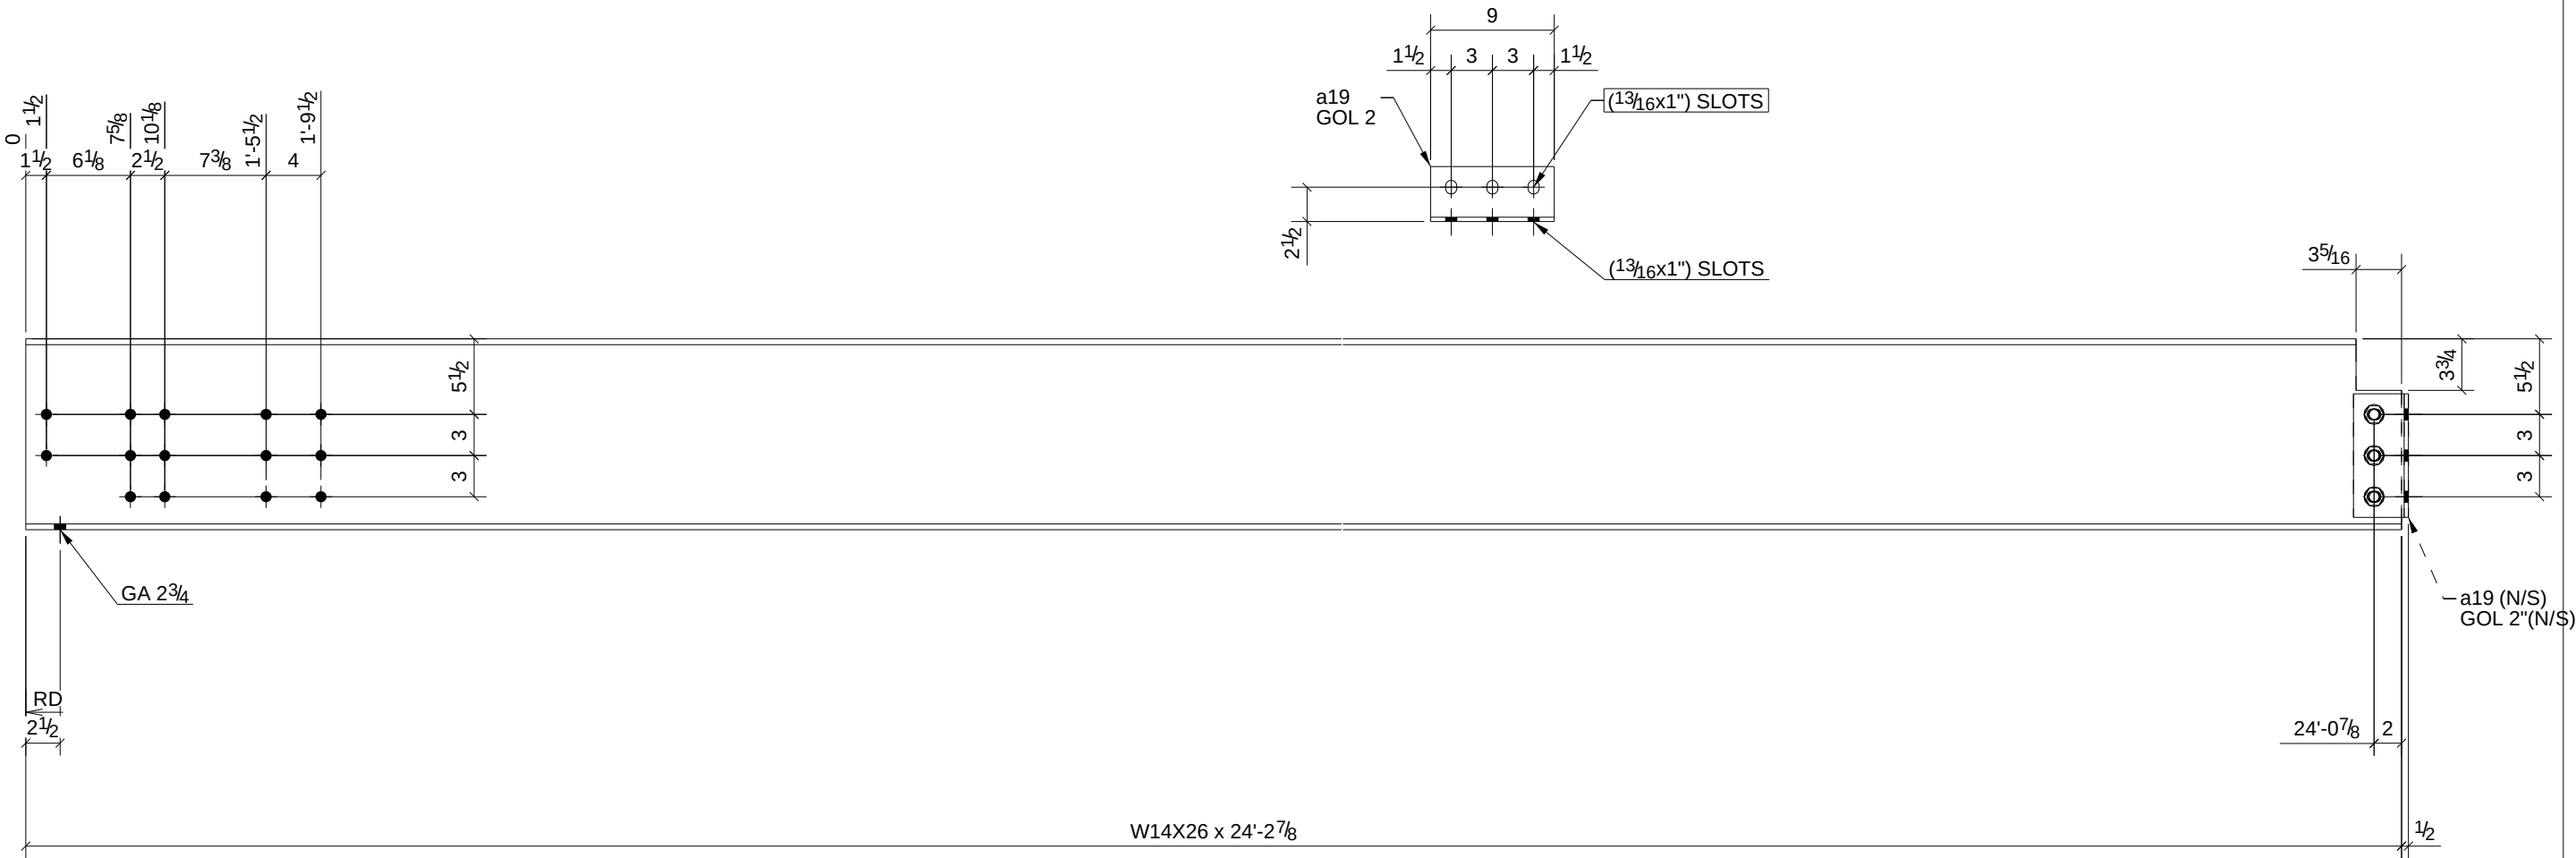

PHASE				
1	2	3	4	5
1	0	0	0	0


ONE - BEAM - 15B2

W	13 7/8"x1/4"
F	5"x7/16"

BILL OF MATERIAL

SHIP	MARK	NO PCS	DESCRIPTION	LENGTH	PIECE MARK	REMARKS
1	15B2	1	W14X26	24'-2 7/8"		SQ-2 A992
		1	L4X3-1/2X5/16	0'-9"	a19	A36
		3	3/4"Ø A325N BOLT	0'-1 3/4"		

A	For Approval & Field Survey		8/30/10	TMc	TAN
0	For Fabrication & F&F		9/15/10	TMc	TAN
REV.	DESCRIPTION		DATE	DWN	CHK
GENERAL NOTES			JOB USE		
MATERIAL: A992 / A36		ELECTRODES: E70XX LH	REF. DRG.	SHOP	
HOLES: 13/16 DIA. U/N		CONN'S.: -			
SURFACE PREP. SSPC-SP-2			APPROVAL		
AND PAINT: GREY PRIMER DEVOE NA-195 (U.N.)					
DESCRIPTION: BEAM					
PROJECT NAME		Hamilton High School Phase III			
LOCATION		Hamilton City School District - Hamilton			
CONTRACTOR GC Contracting					
	Avenue Fabricating Inc. 1281 Clough Pike Batavia, OH 45103 (513) 752-1911		DRAWN BY TMc		DATE 09/01/2010
			CHKD. BY TAN		DATE
			JOB No. 10-16		DRG. No. 15B2

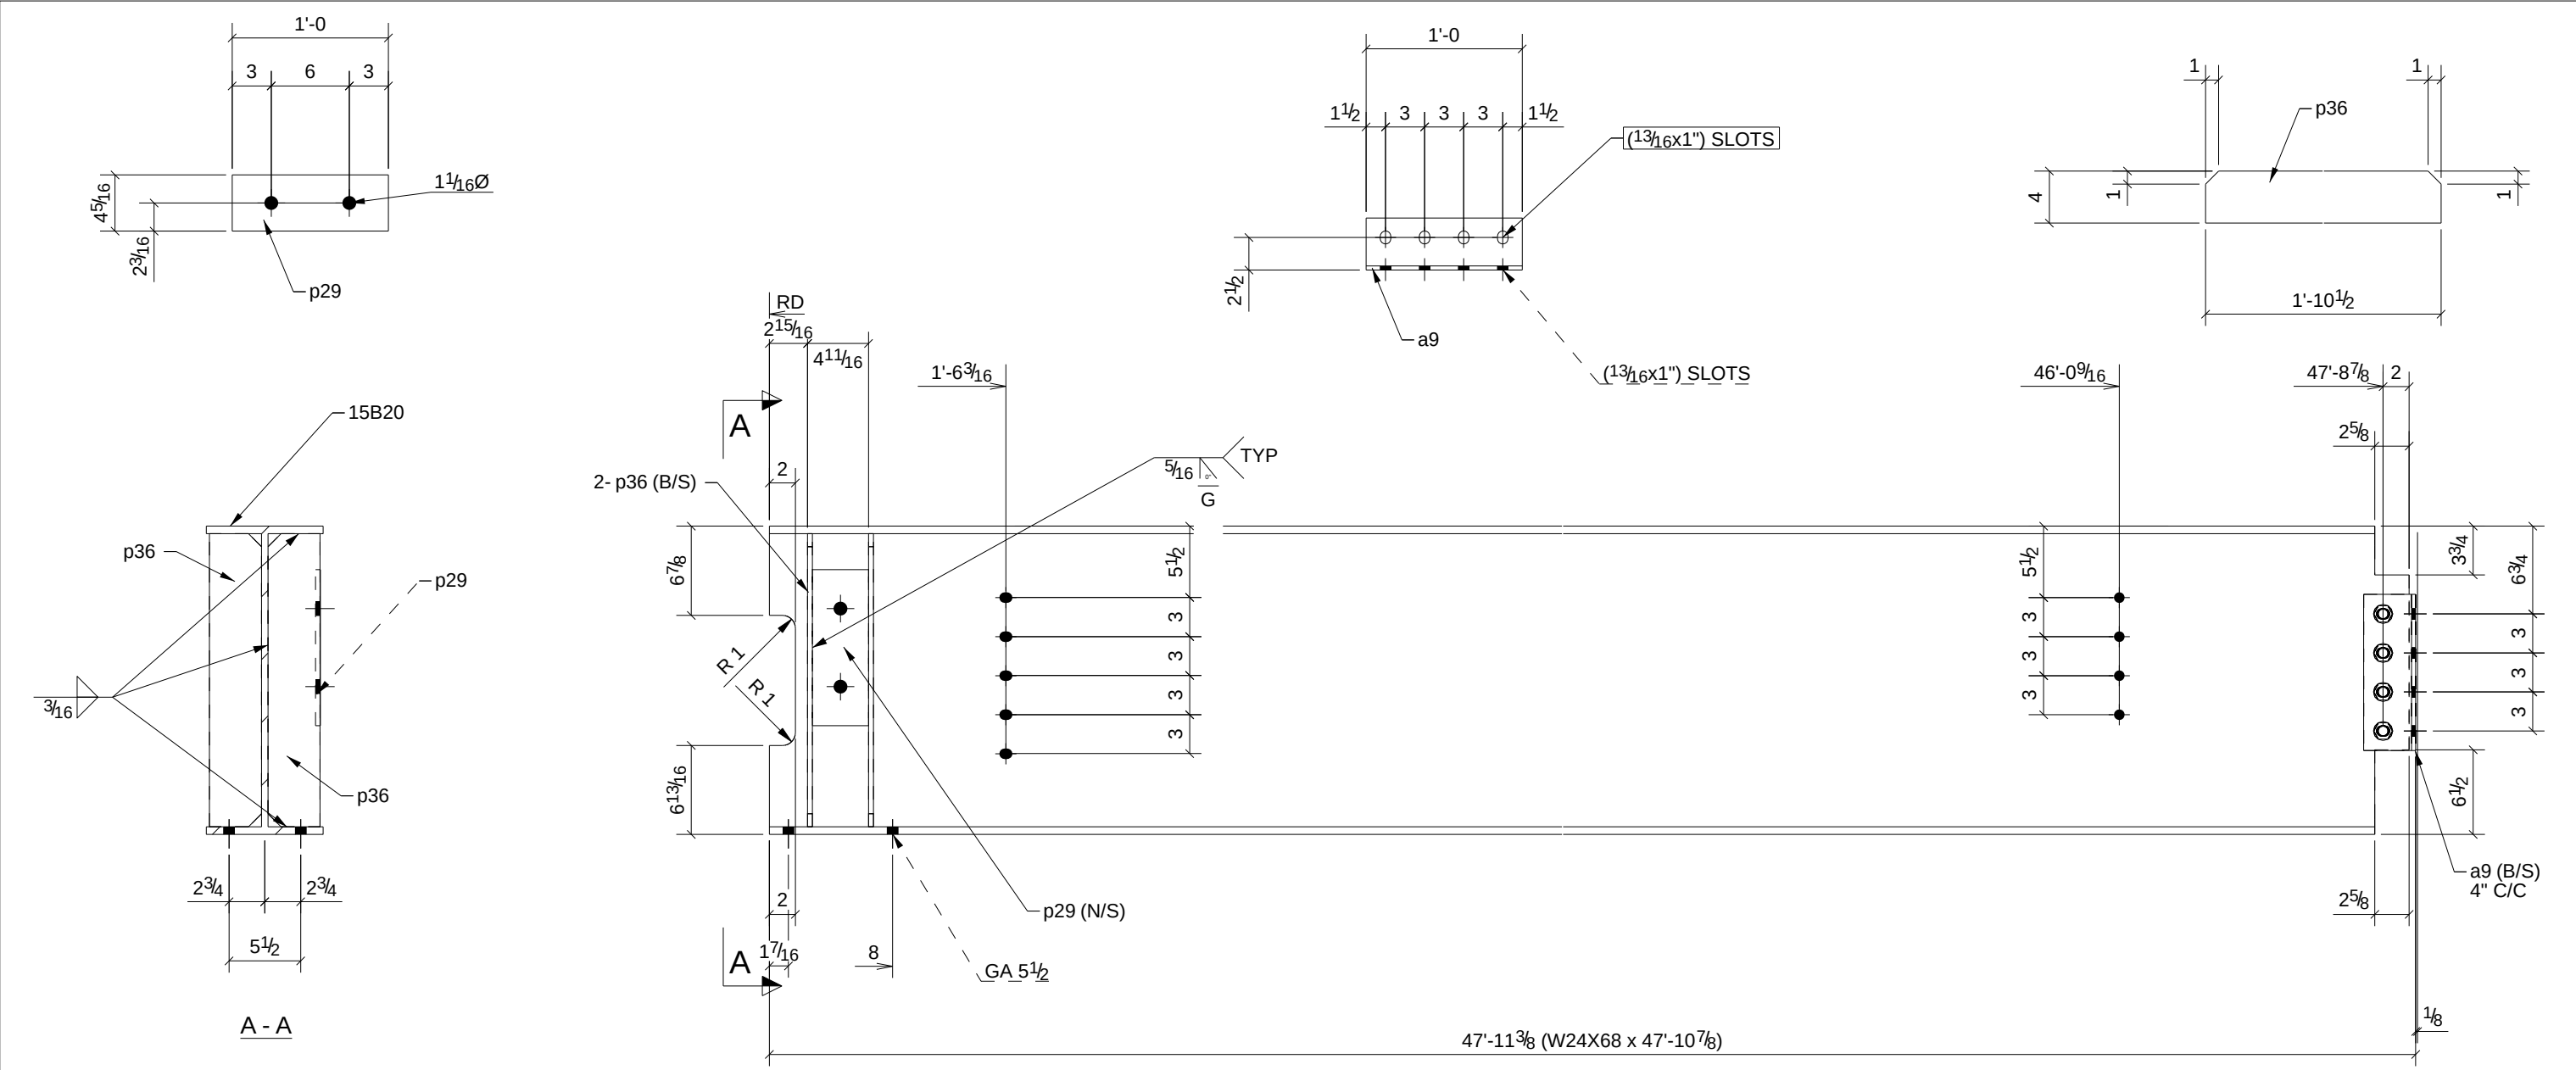

ONE - BEAM - 15B20

PHASE				
1	2	3	4	5
1	0	0	0	0

W	23 11/16"x 7/16"
F	9"x 9/16"



A	For Approval & Field Survey	8/30/10	TMc	TAN
0	For Fabrication & F&F	9/15/10	TMc	TAN
REV.	DESCRIPTION	DATE	DWN	CHK

GENERAL NOTES			JOB USE	
MATERIAL: A992 / A36	ELECTRODES: E70XX LH	REF. DRG.	SHOP	
HOLES: 13/16 DIA. U/N	CONN'S.: -		APPROVAL	
SURFACE PREP. SSPC-SP-2 AND PAINT: GREY PRIMER DEVOE NA-195 (U.N.)				

BILL OF MATERIAL

SHIP	MARK	NO PCS	DESCRIPTION	LENGTH	PIECE MARK	REMARKS
1	15B20	1	W24X68	47'-10 7/8"		SQ-2 A992
		2	L4X3-1/2X5/16	1'-0"	a9	A36
		1	PL3/8"x4 5/16"	1'-0"	p29	A36
		4	BAR3/8"x4"	1'-10 1/2"	p36	A36
		4	3/4"Ø A325N BOLT	0'-2 1/4"		

DESCRIPTION: BEAM			
PROJECT NAME Hamilton High School Phase III			
LOCATION Hamilton City School District - Hamilton			
CONTRACTOR GC Contracting			
Avenue Fabricating Inc. 1281 Clough Pike Batavia, OH 45103 (513) 752-1911		DRAWN BY TMc	DATE 08/30/2010
		CHKD. BY TAN	DATE
		JOB No. 10-16	DRG. No. 15B20 REV. 3

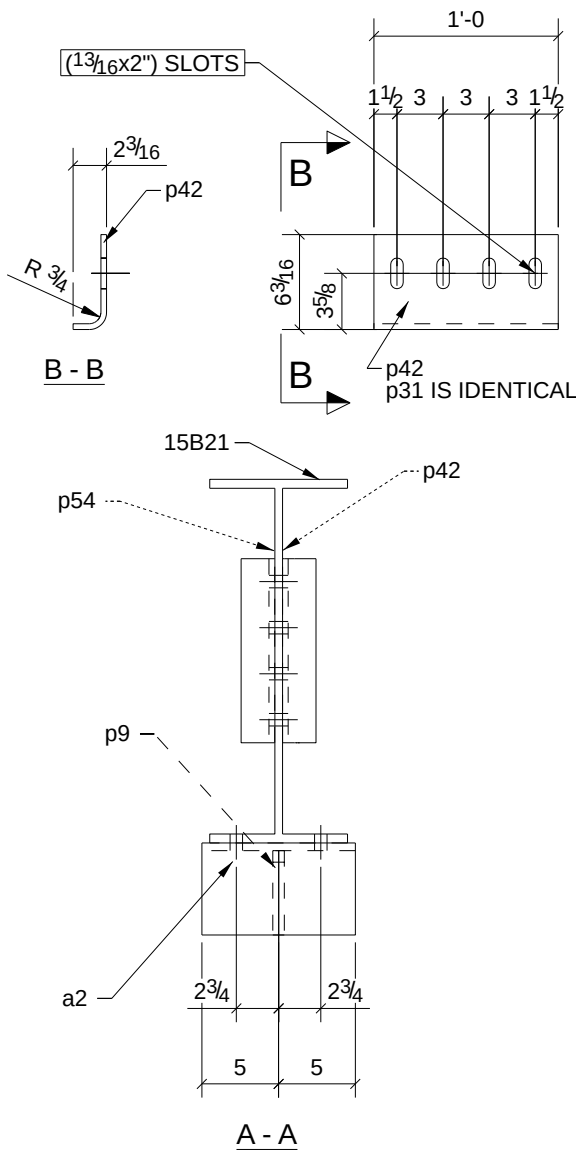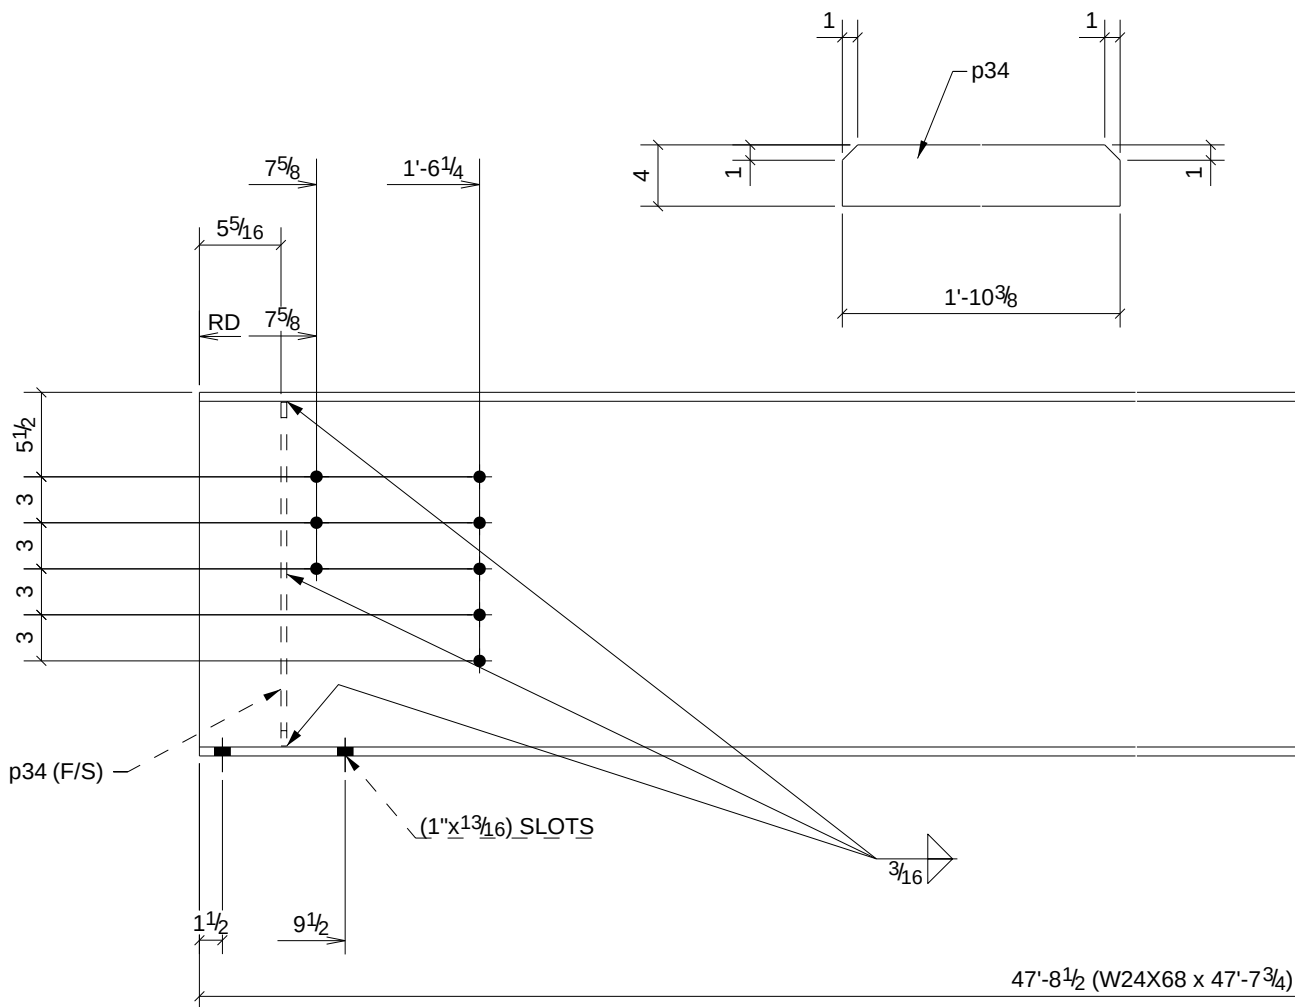

PHASE				
1	2	3	4	5
1	0	0	0	0







ONE - BEAM - 15B21

W	23 11/16"x7/16"
F	9"x9/16"

BILL OF MATERIAL

SHIP	MARK	NO PCS	DESCRIPTION	LENGTH	PIECE MARK	REMARKS
1	15B21	1	W24X68	47'-7 3/4"		SQ-2 A992
		1	L6X6X1/2	0'-10"	a2	A36
		1	BAR3/4"X5 1/2"	0'-5 1/2"	p9	A36
		1	BAR3/8"X4"	1'-10 3/8"	p34	A36
		1	PL3/8"X7 5/8"	1'-0"	p42	A36 BENT
		1	PL3/8"X7 5/8"	1'-0"	p54	A36 BENT
		2	3/4"Ø A325N BOLT	0'-2 1/4"		
		4	3/4"Ø A325N BOLT	0'-2 1/2"		

A	For Approval & Field Survey	8/30/10	TMc	TAN
0	For Fabrication & F&F	9/15/10	TMc	TAN
REV.	DESCRIPTION	DATE	DWN	CHK
GENERAL NOTES		JOB USE		
MATERIAL: A992 / A36	ELECTRODES: E70XX LH	REF. DRG.	SHOP	
HOLES: 13/16 DIA. U/N	CONN'S.: -		APPROVAL	
SURFACE PREP. SSPC-SP-2 AND PAINT: GREY PRIMER DEVOE NA-195 (U.N.)				
DESCRIPTION: BEAM				
PROJECT NAME Hamilton High School Phase III				
LOCATION Hamilton City School District - Hamilton				
CONTRACTOR GC Contracting				
	Avenue Fabricating Inc. 1281 Clough Pike Batavia, OH 45103 (513) 752-1911	DRAWN BY TMc	DATE 08/30/2010	
		CHKD. BY TAN	DATE	
		JOB No. 10-16	DRG. No. 15B21	REV. 3

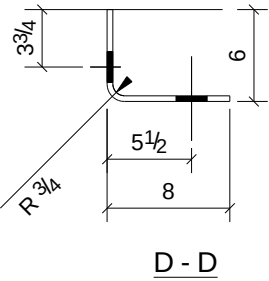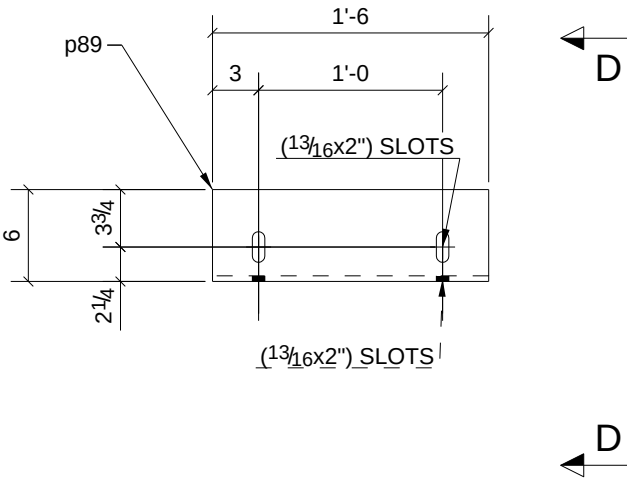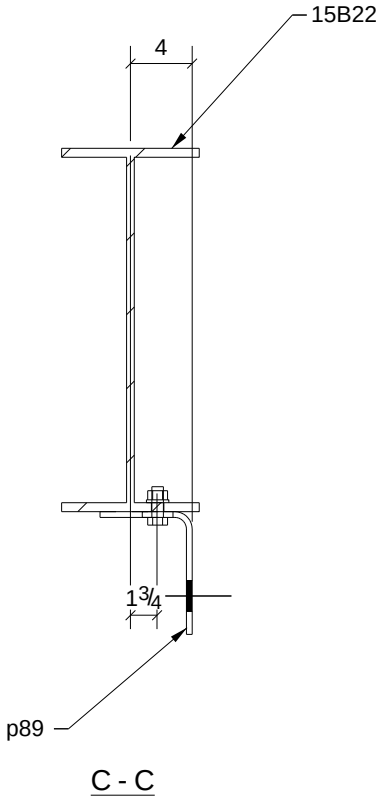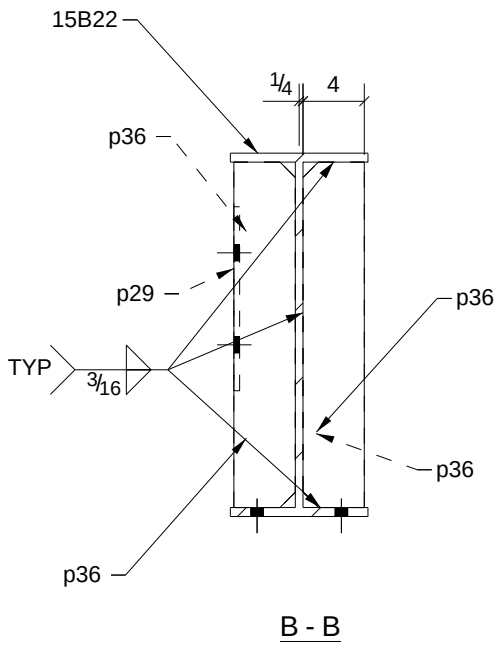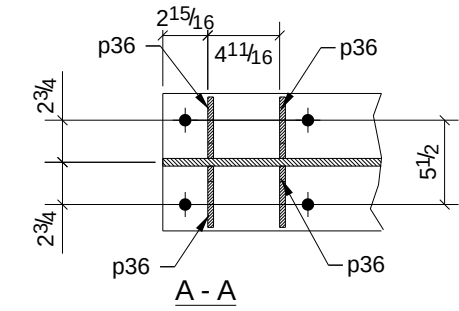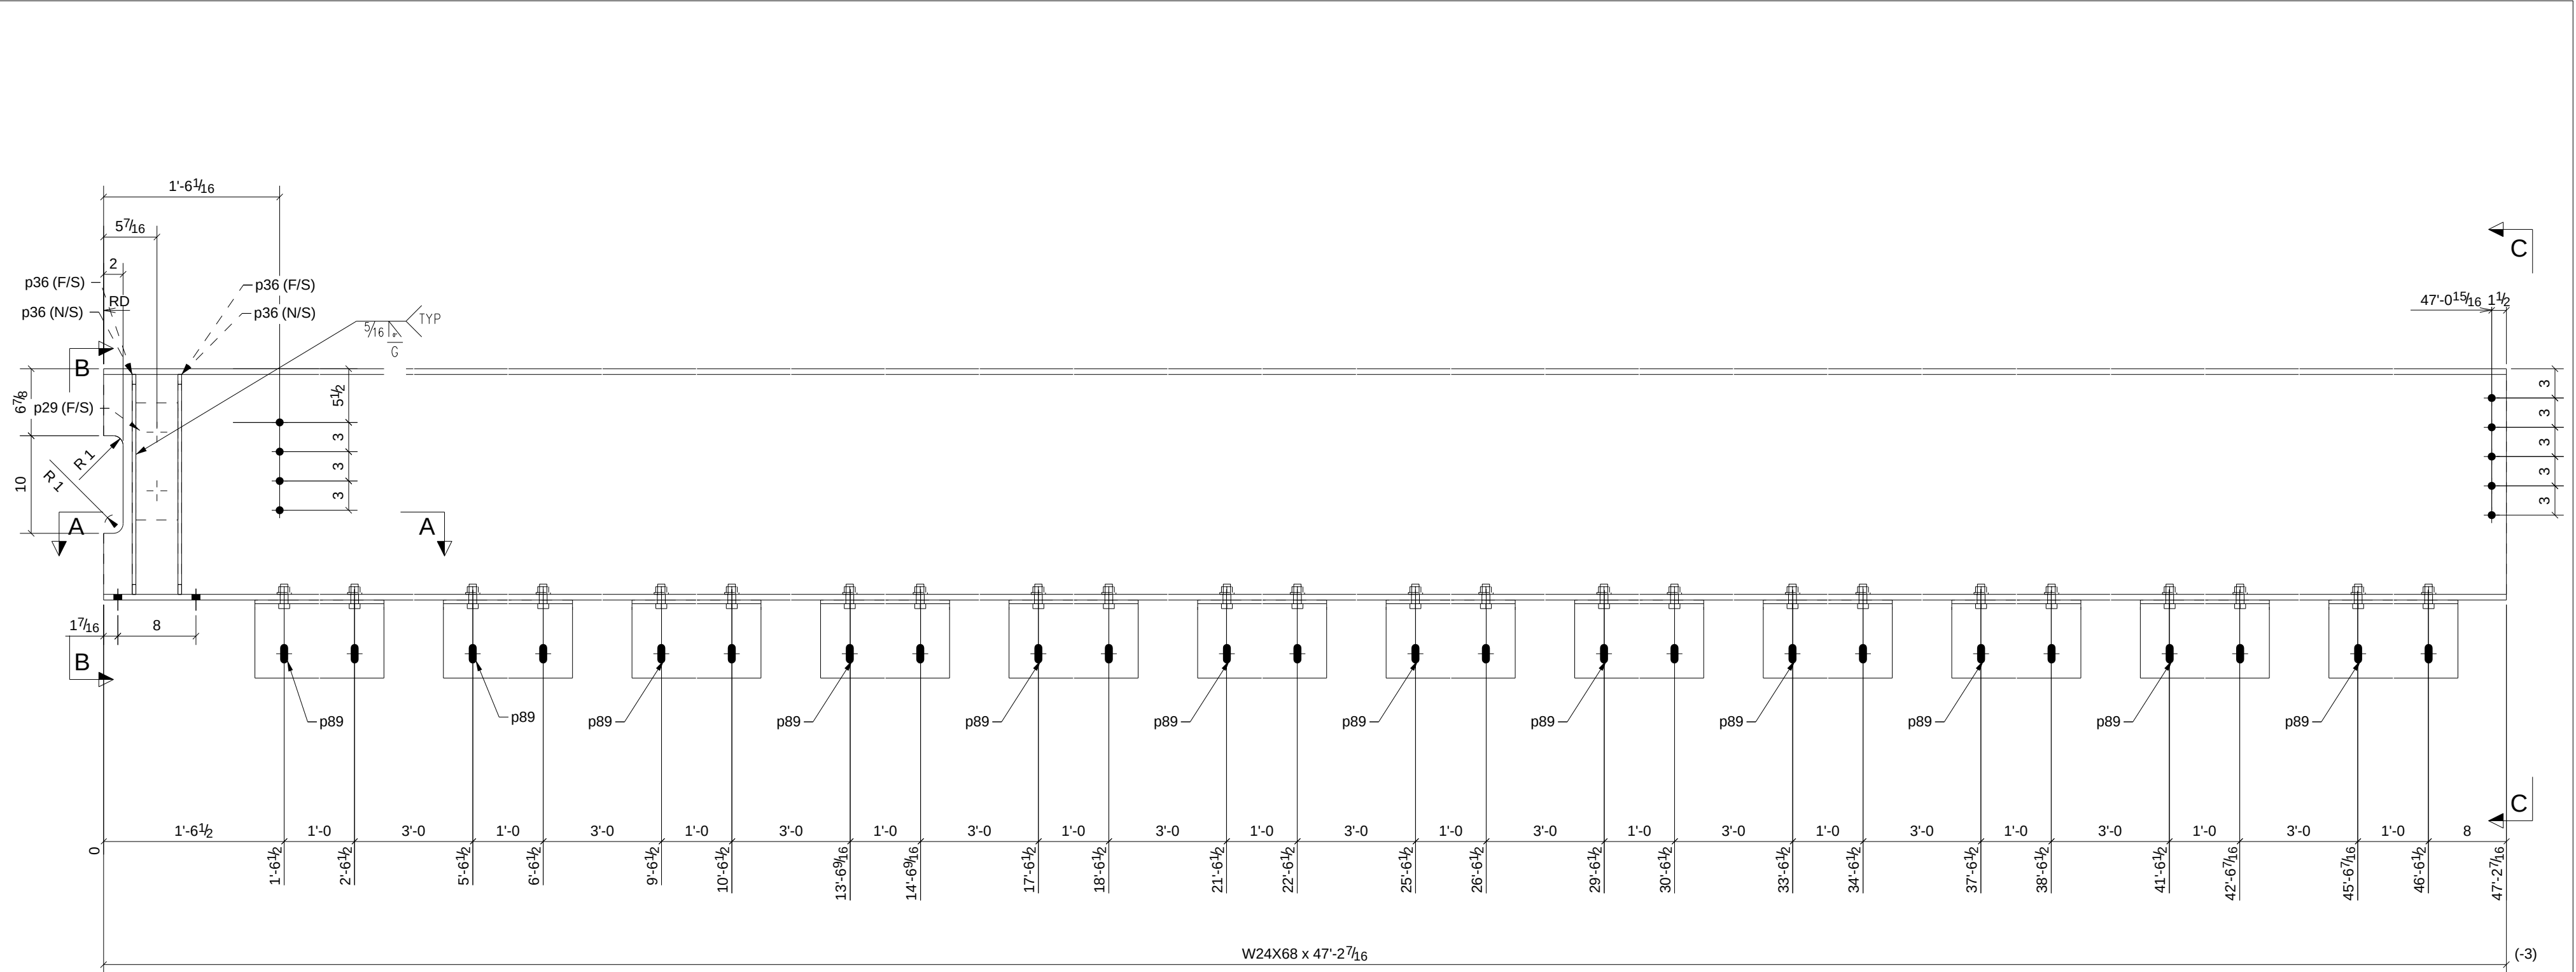






PHASE				
1	2	3	4	5
1	0	0	0	0

ONE - BEAM - 15B22

W 23 11/16"x7/16"
F 9"x9/16"

BILL OF MATERIAL					
SHIP	MARK	NO PCS	DESCRIPTION	LENGTH	PIECE MARK
1	15B22	1	W24X68	47'-2 7/16"	SQ-2 A992
		1	PL3/8"X4 5/16"	1'-0"	p29 A36
		4	BAR3/8"X4"	1'-10 1/2"	p36 A36
		12	PL3/8"X13 1/4"	1'-6"	p89 A36
		24	3/4"Ø A307 BOLT	0'-2"	

0	For Fabrication & F&F		9/15/10	TMc	TAN	
REV.	DESCRIPTION		DATE	DWN	CHK	
GENERAL NOTES			JOB USE			
			MATERIAL: A992 / A36	ELECTRODES: E70XX LH	REF. DRG.	
			HOLES: 13/16 DIA. U/N	CONN'S.: -		
SURFACE PREP: SSPC-SP-2			APPROVAL			
AND PAINT: GREY PRIMER DEVOE NA-195 (U.N.)						
DESCRIPTION: BEAM						
PROJECT NAME		Hamilton High School Phase III				
LOCATION		Hamilton City School District - Hamilton				
CONTRACTOR		GC Contracting				
	Avenue Fabricating Inc. 1281 Clough Pike Batavia, OH 45103 (513) 752-1911		DRAWN BY TMc	DATE 09/16/2010		
			CHKD. BY TAN	DATE		
			JOB No. 10-16	DRG. No. 15B22	REV. 1	

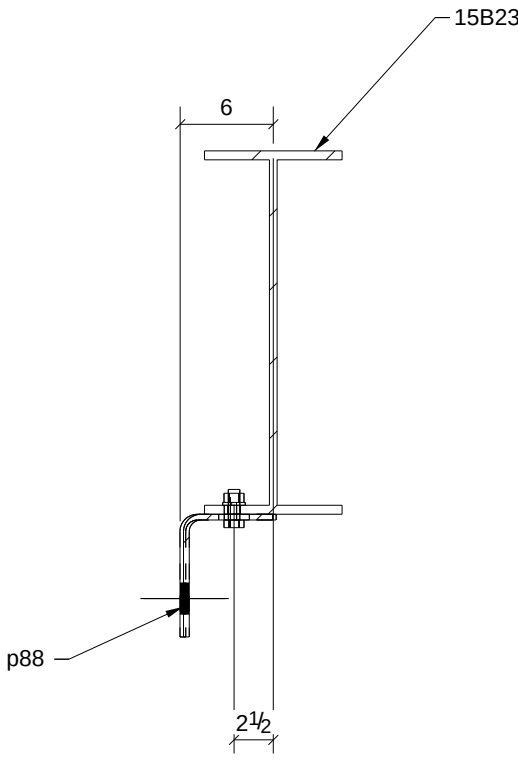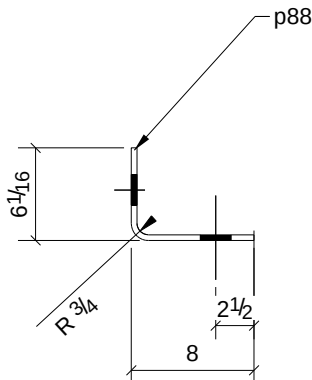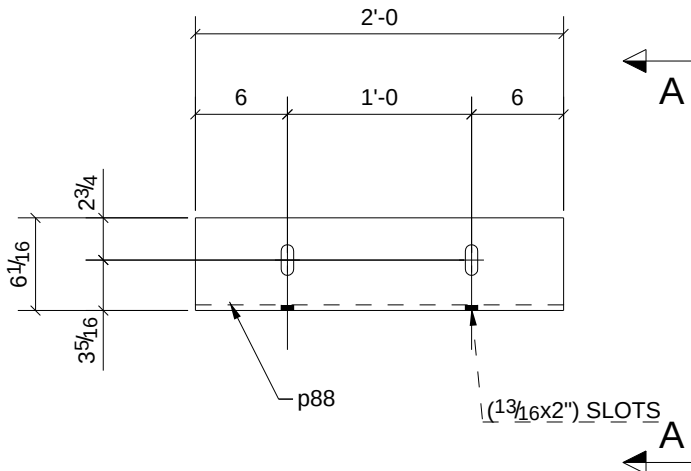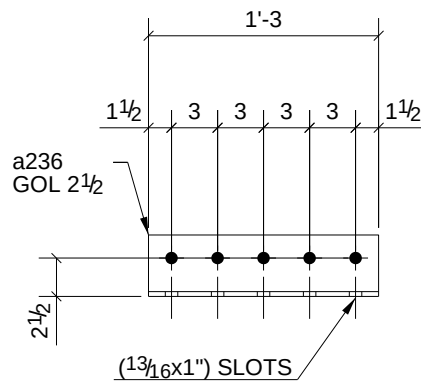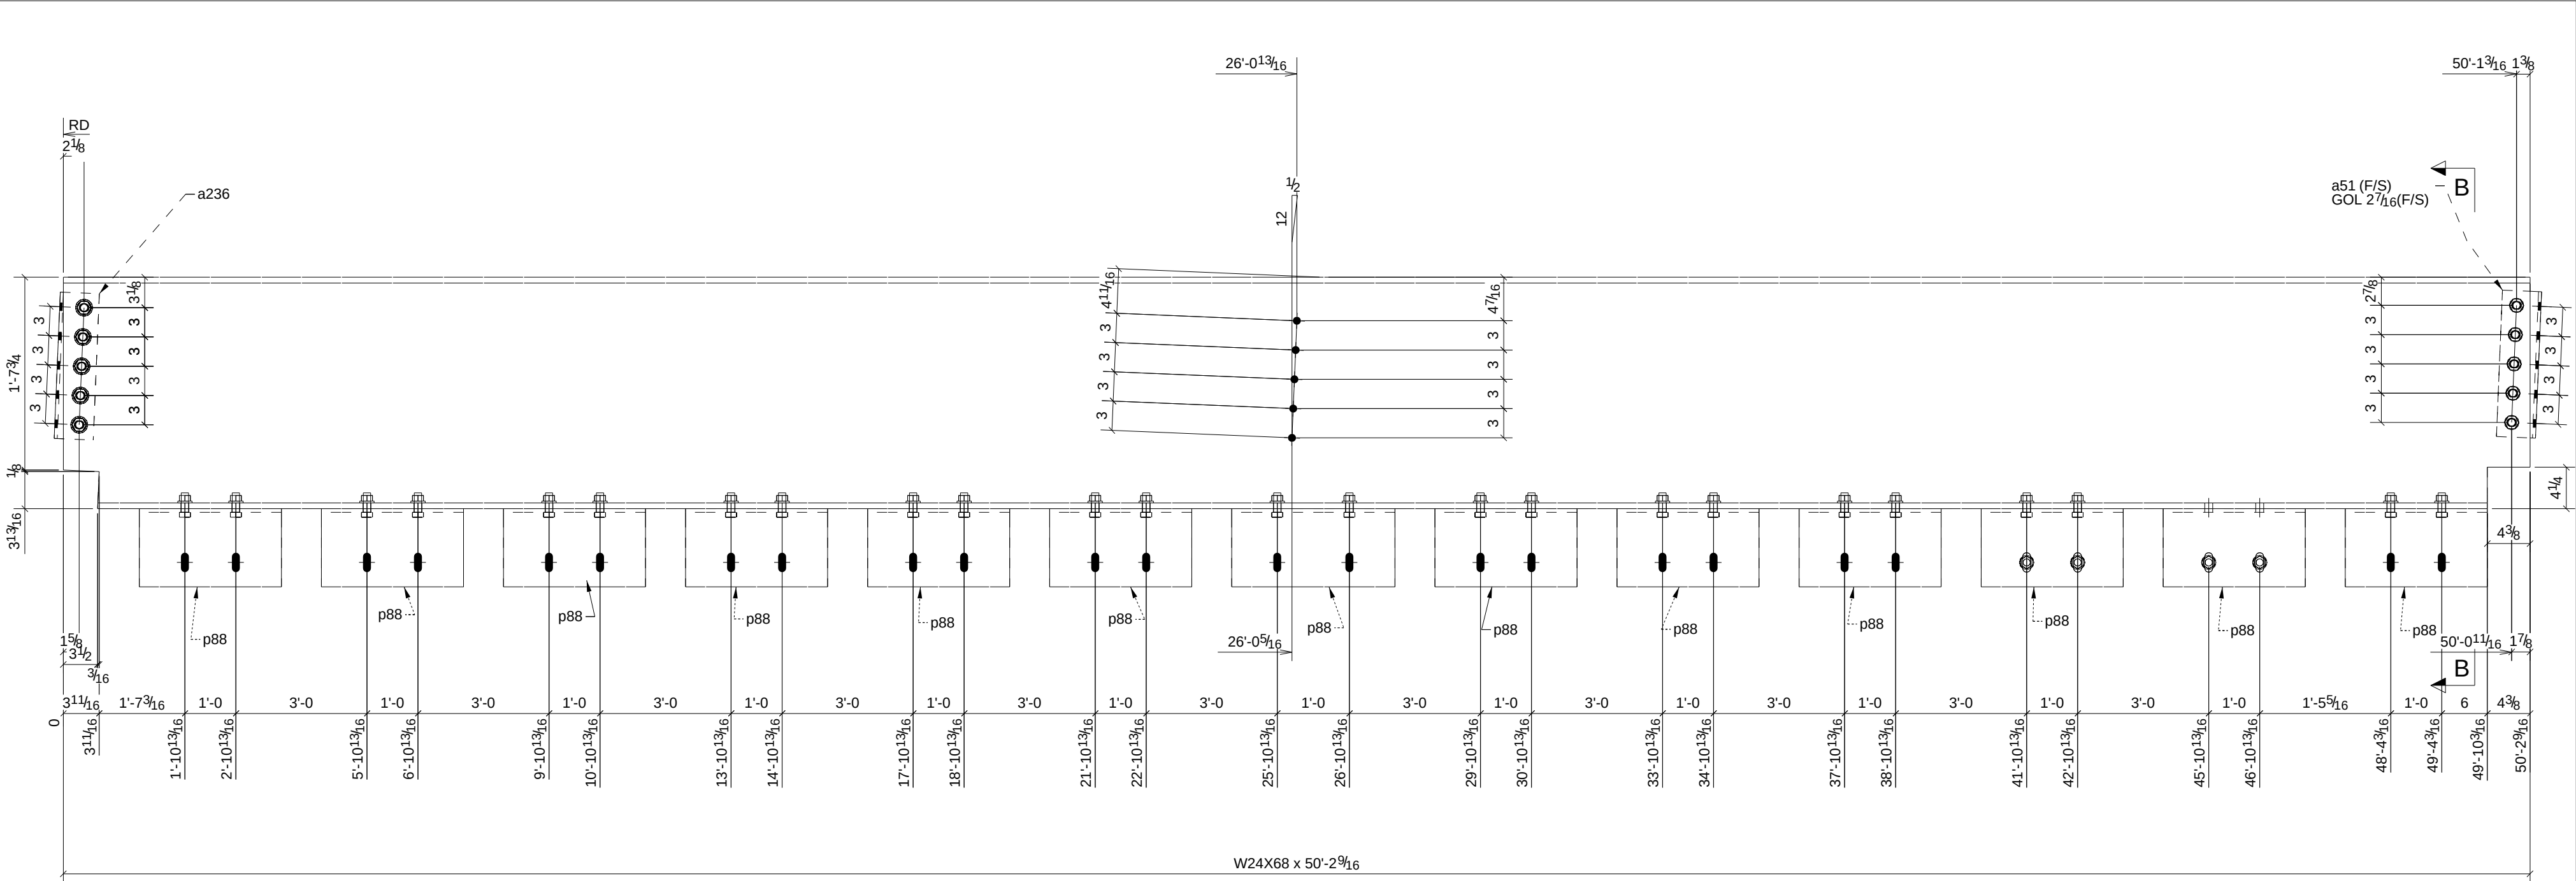


PHASE				
1	2	3	4	5
1	0	0	0	0

ONE - BEAM - 15B23

W 23 11/16"x7/16"
F 9"x9/16"

BILL OF MATERIAL						
SHIP	MARK	NO PCS	DESCRIPTION	LENGTH	PIECE MARK	REMARKS
1	15B23	1	W24X68	50'-2 9/16"		SQ-2 A992
		1	L4X4X5/16	1'-3"	a51	A36
		1	L4X4X5/16	1'-3"	a236	A36
		13	PL3/8"X13 1/4"	2'-0"	p88	A36
		26	3/4"Ø A307 BOLT	0'-2"		
		5	3/4"Ø A325N BOLT	0'-2"		
		5	3/4"Ø A325N BOLT	0'-2 3/4"		

0	For Fabrication & F&F		9/15/10	TMc	TAN
REV.	DESCRIPTION		DATE	DWN	CHK
GENERAL NOTES			JOB USE		
MATERIAL: A992 / A36		ELECTRODES: E70XX LH	REF. DRG.		
HOLES: 13/16 DIA. U/N		CONN'S.: -		SHOP	
SURFACE PREP. SSPC-SP-2			APPROVAL		
AND PAINT: GREY PRIMER DEVOE NA-195 (U.N.)					
DESCRIPTION: BEAM					
PROJECT NAME		Hamilton High School Phase III			
LOCATION		Hamilton City School District - Hamilton			
CONTRACTOR		GC Contracting			
	Avenue Fabricating Inc. 1281 Clough Pike Batavia, OH 45103 (513) 752-1911		DRAWN BY		DATE
			TMc		09/16/2010
			CHKD. BY		DATE
			TAN		
		JOB No.	DRG. No.	REV.	
		10-16	15B23	1	

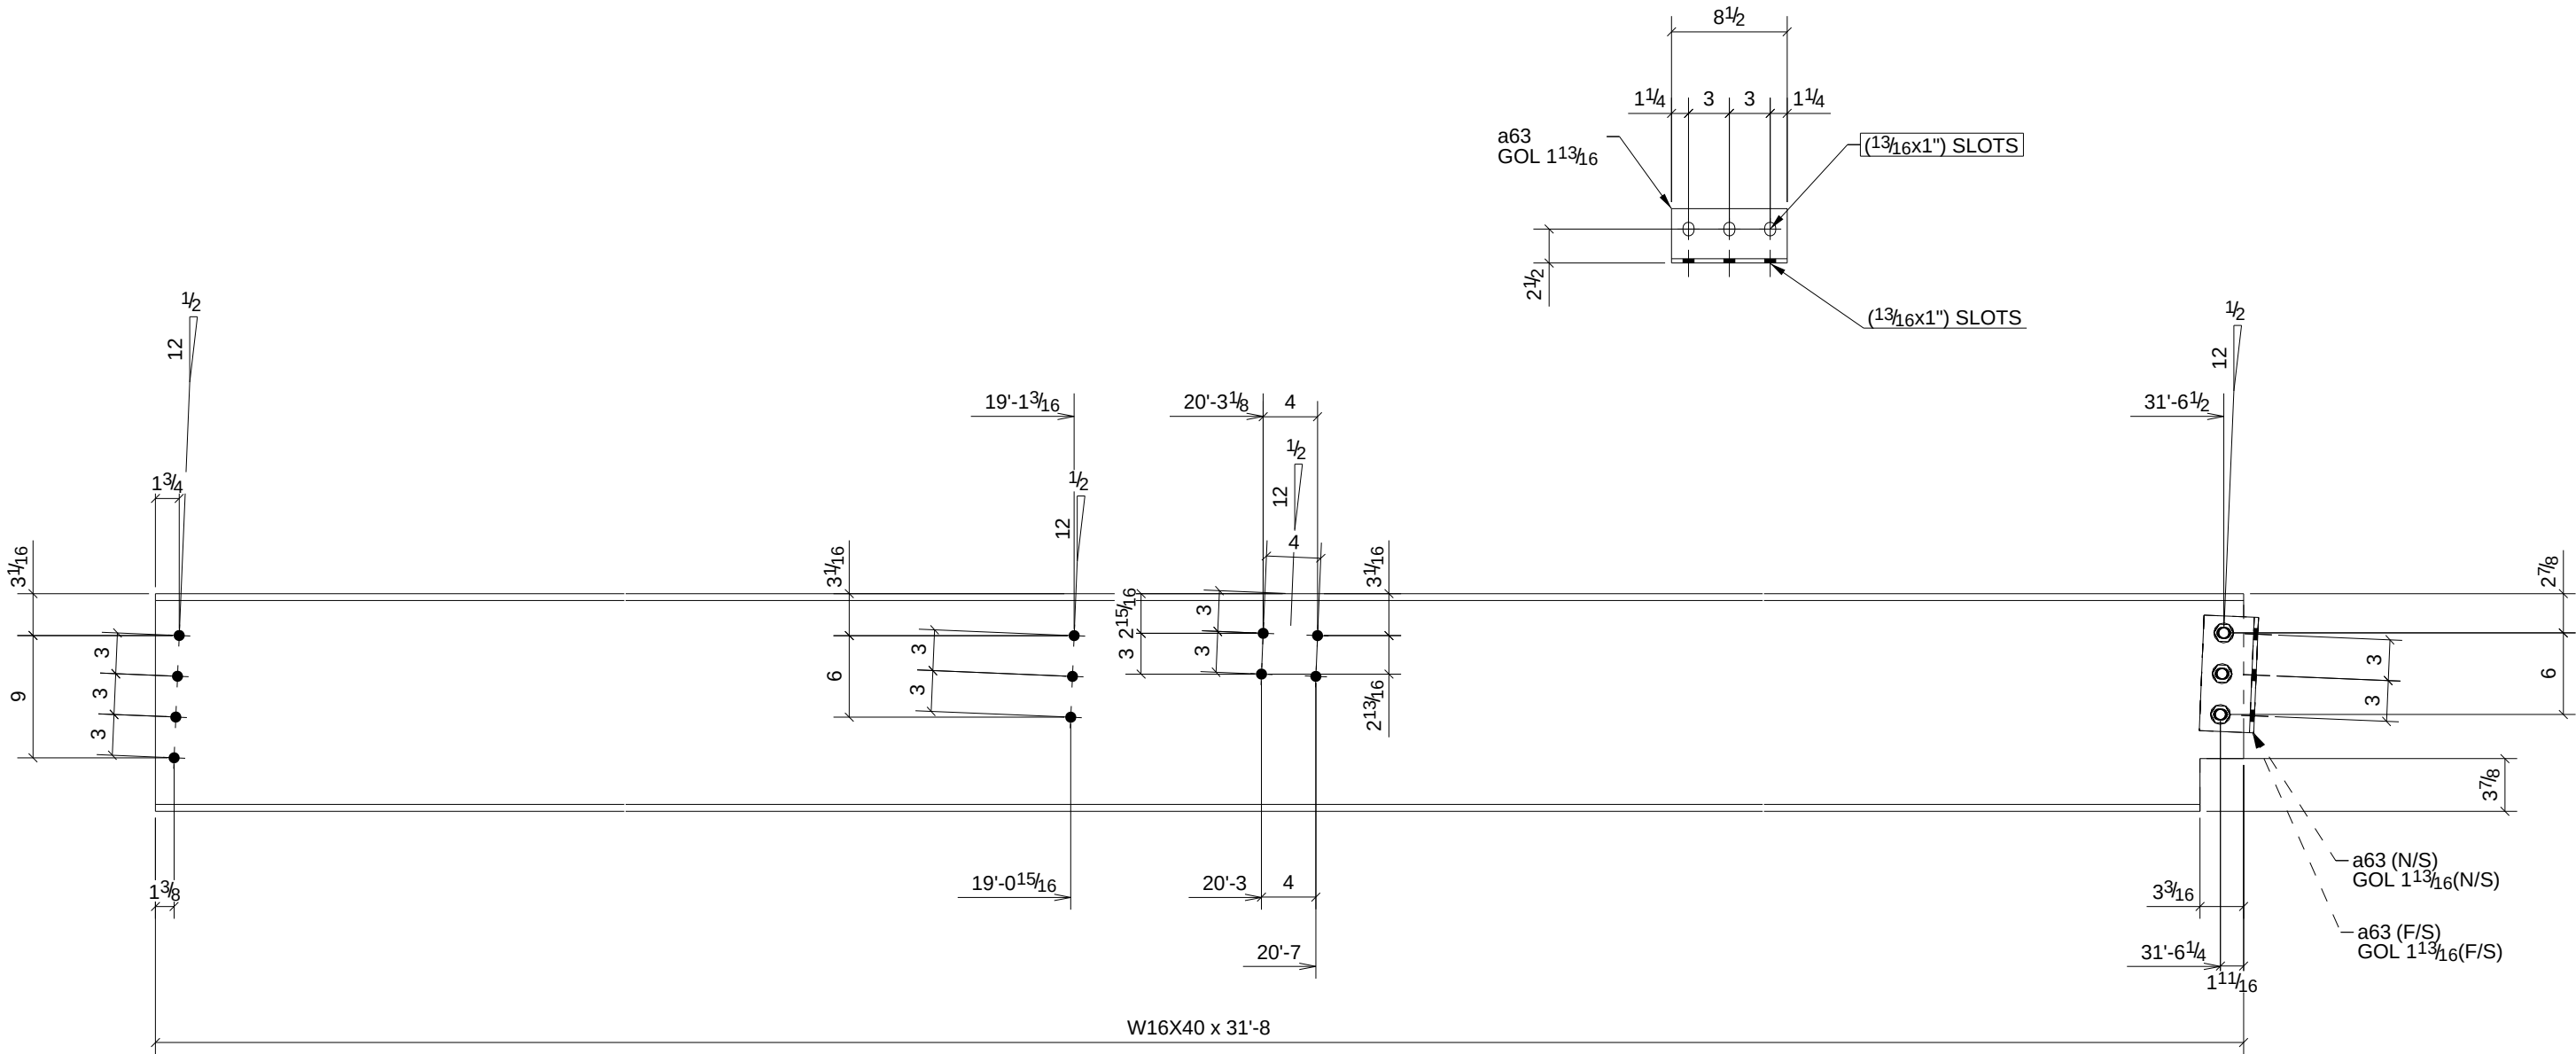

PHASE				
1	2	3	4	5
1	0	0	0	0


ONE - BEAM - 15B25

W	16"x 1/4"
F	7"x 1/2"

BILL OF MATERIAL

SHIP	MARK	NO PCS	DESCRIPTION	LENGTH	PIECE MARK	REMARKS
1	15B25	1	W16X40	31'-8"		SQ-2 A992
		2	L4X3-1/2X5/16	0'-8 1/2"	a63	A36
		3	3/4"Ø A325N BOLT	0'-2 1/4"		

A	For Approval & Field Survey		8/30/10	TMc	TAN
0	For Fabrication & F&F		9/15/10	TMc	TAN
REV.	DESCRIPTION		DATE	DWN	CHK
GENERAL NOTES			JOB USE		
MATERIAL: A992 / A36		ELECTRODES: E70XX LH	REF. DRG.	SHOP	
HOLES: 13/16 DIA. U/N		CONN'S.: -			
SURFACE PREP. SSPC-SP-2			APPROVAL		
AND PAINT: GREY PRIMER DEVOE NA-195 (U.N.)					
DESCRIPTION: BEAM					
PROJECT NAME		Hamilton High School Phase III			
LOCATION		Hamilton City School District - Hamilton			
CONTRACTOR		GC Contracting			
	Avenue Fabricating Inc. 1281 Clough Pike Batavia, OH 45103 (513) 752-1911		DRAWN BY TMc		DATE 08/30/2010
			CHKD. BY TAN		DATE
			JOB No. 10-16		DRG. No. 15B25

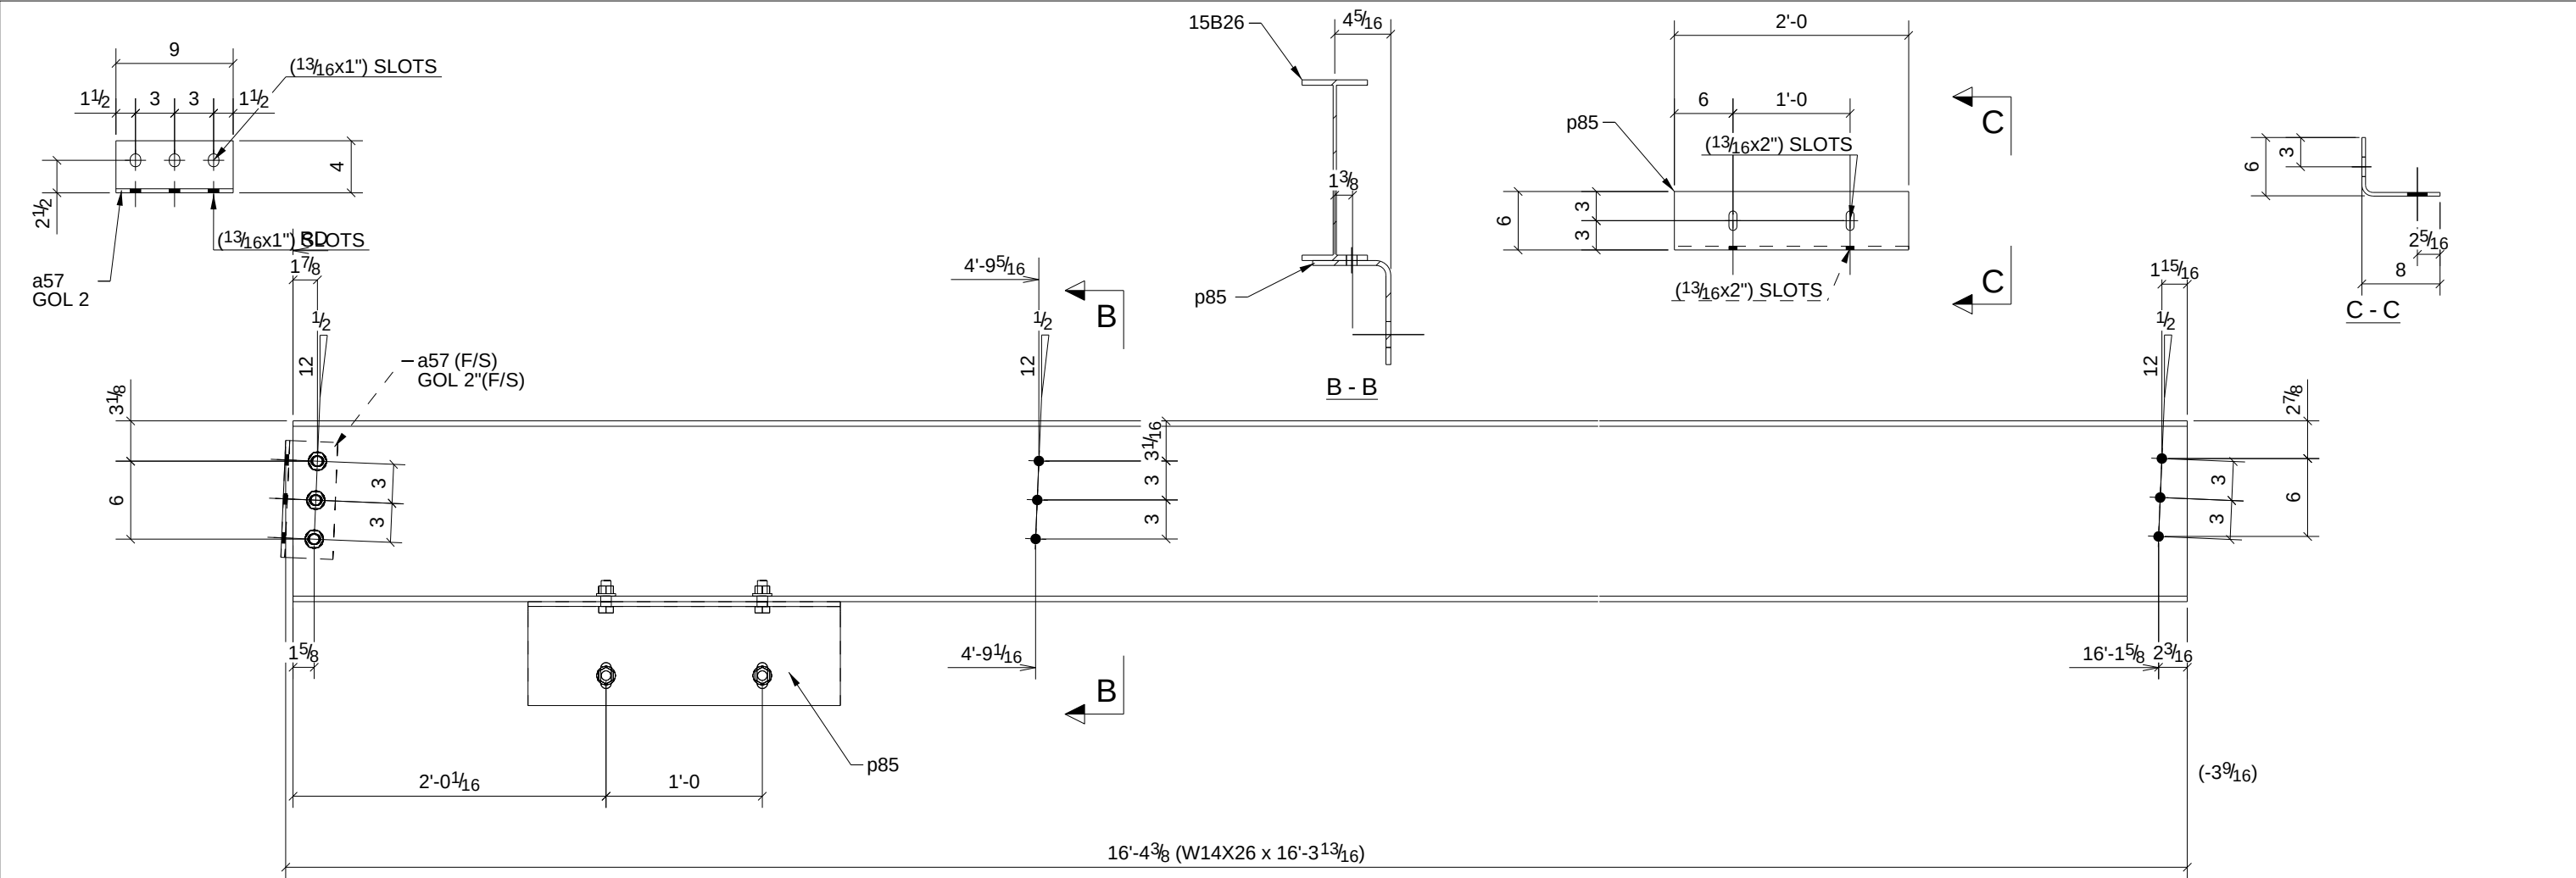

ONE - BEAM - 15B26


PHASE				
1	2	3	4	5
1	0	0	0	0


W	13 7/8"x 1/4"
F	5"x 7/16"

BILL OF MATERIAL

SHIP	MARK	NO PCS	DESCRIPTION	LENGTH	PIECE MARK	REMARKS
1	15B26	1	W14X26	16'-3 13/16"		SQ-2 A992
		1	L4X3-1/2X5/16	0'-9"	a57	A36
		1	PL3/8"X13 1/4"	2'-0"	p85	A36
		2	3/4"Ø A307 BOLT	0'-2"		
		3	3/4"Ø A325N BOLT	0'-1 3/4"		

0	For Fabrication & F&F				9/15/10	TMc	TAN	
REV.	DESCRIPTION				DATE	DWN	CHK	
GENERAL NOTES					JOB USE			
MATERIAL: A992 / A36		ELECTRODES: E70XX LH		REF. DRG.				
HOLES: 13/16 DIA. U/N		CONN'S.: -			SHOP			
SURFACE PREP. SSPC-SP-2					APPROVAL			
AND PAINT: GREY PRIMER DEVOE NA-195 (U.N.)								
DESCRIPTION: BEAM								
PROJECT NAME		Hamilton High School Phase III						
LOCATION		Hamilton City School District - Hamilton						
CONTRACTOR		GC Contracting						
		Avenue Fabricating Inc. 1281 Clough Pike Batavia, OH 45103 (513) 752-1911			DRAWN BY		DATE	
					TMc		09/16/2010	
					CHKD. BY		DATE	
					TAN			
		JOB No.			DRG. No.		REV.	
		10-16			15B26		1	

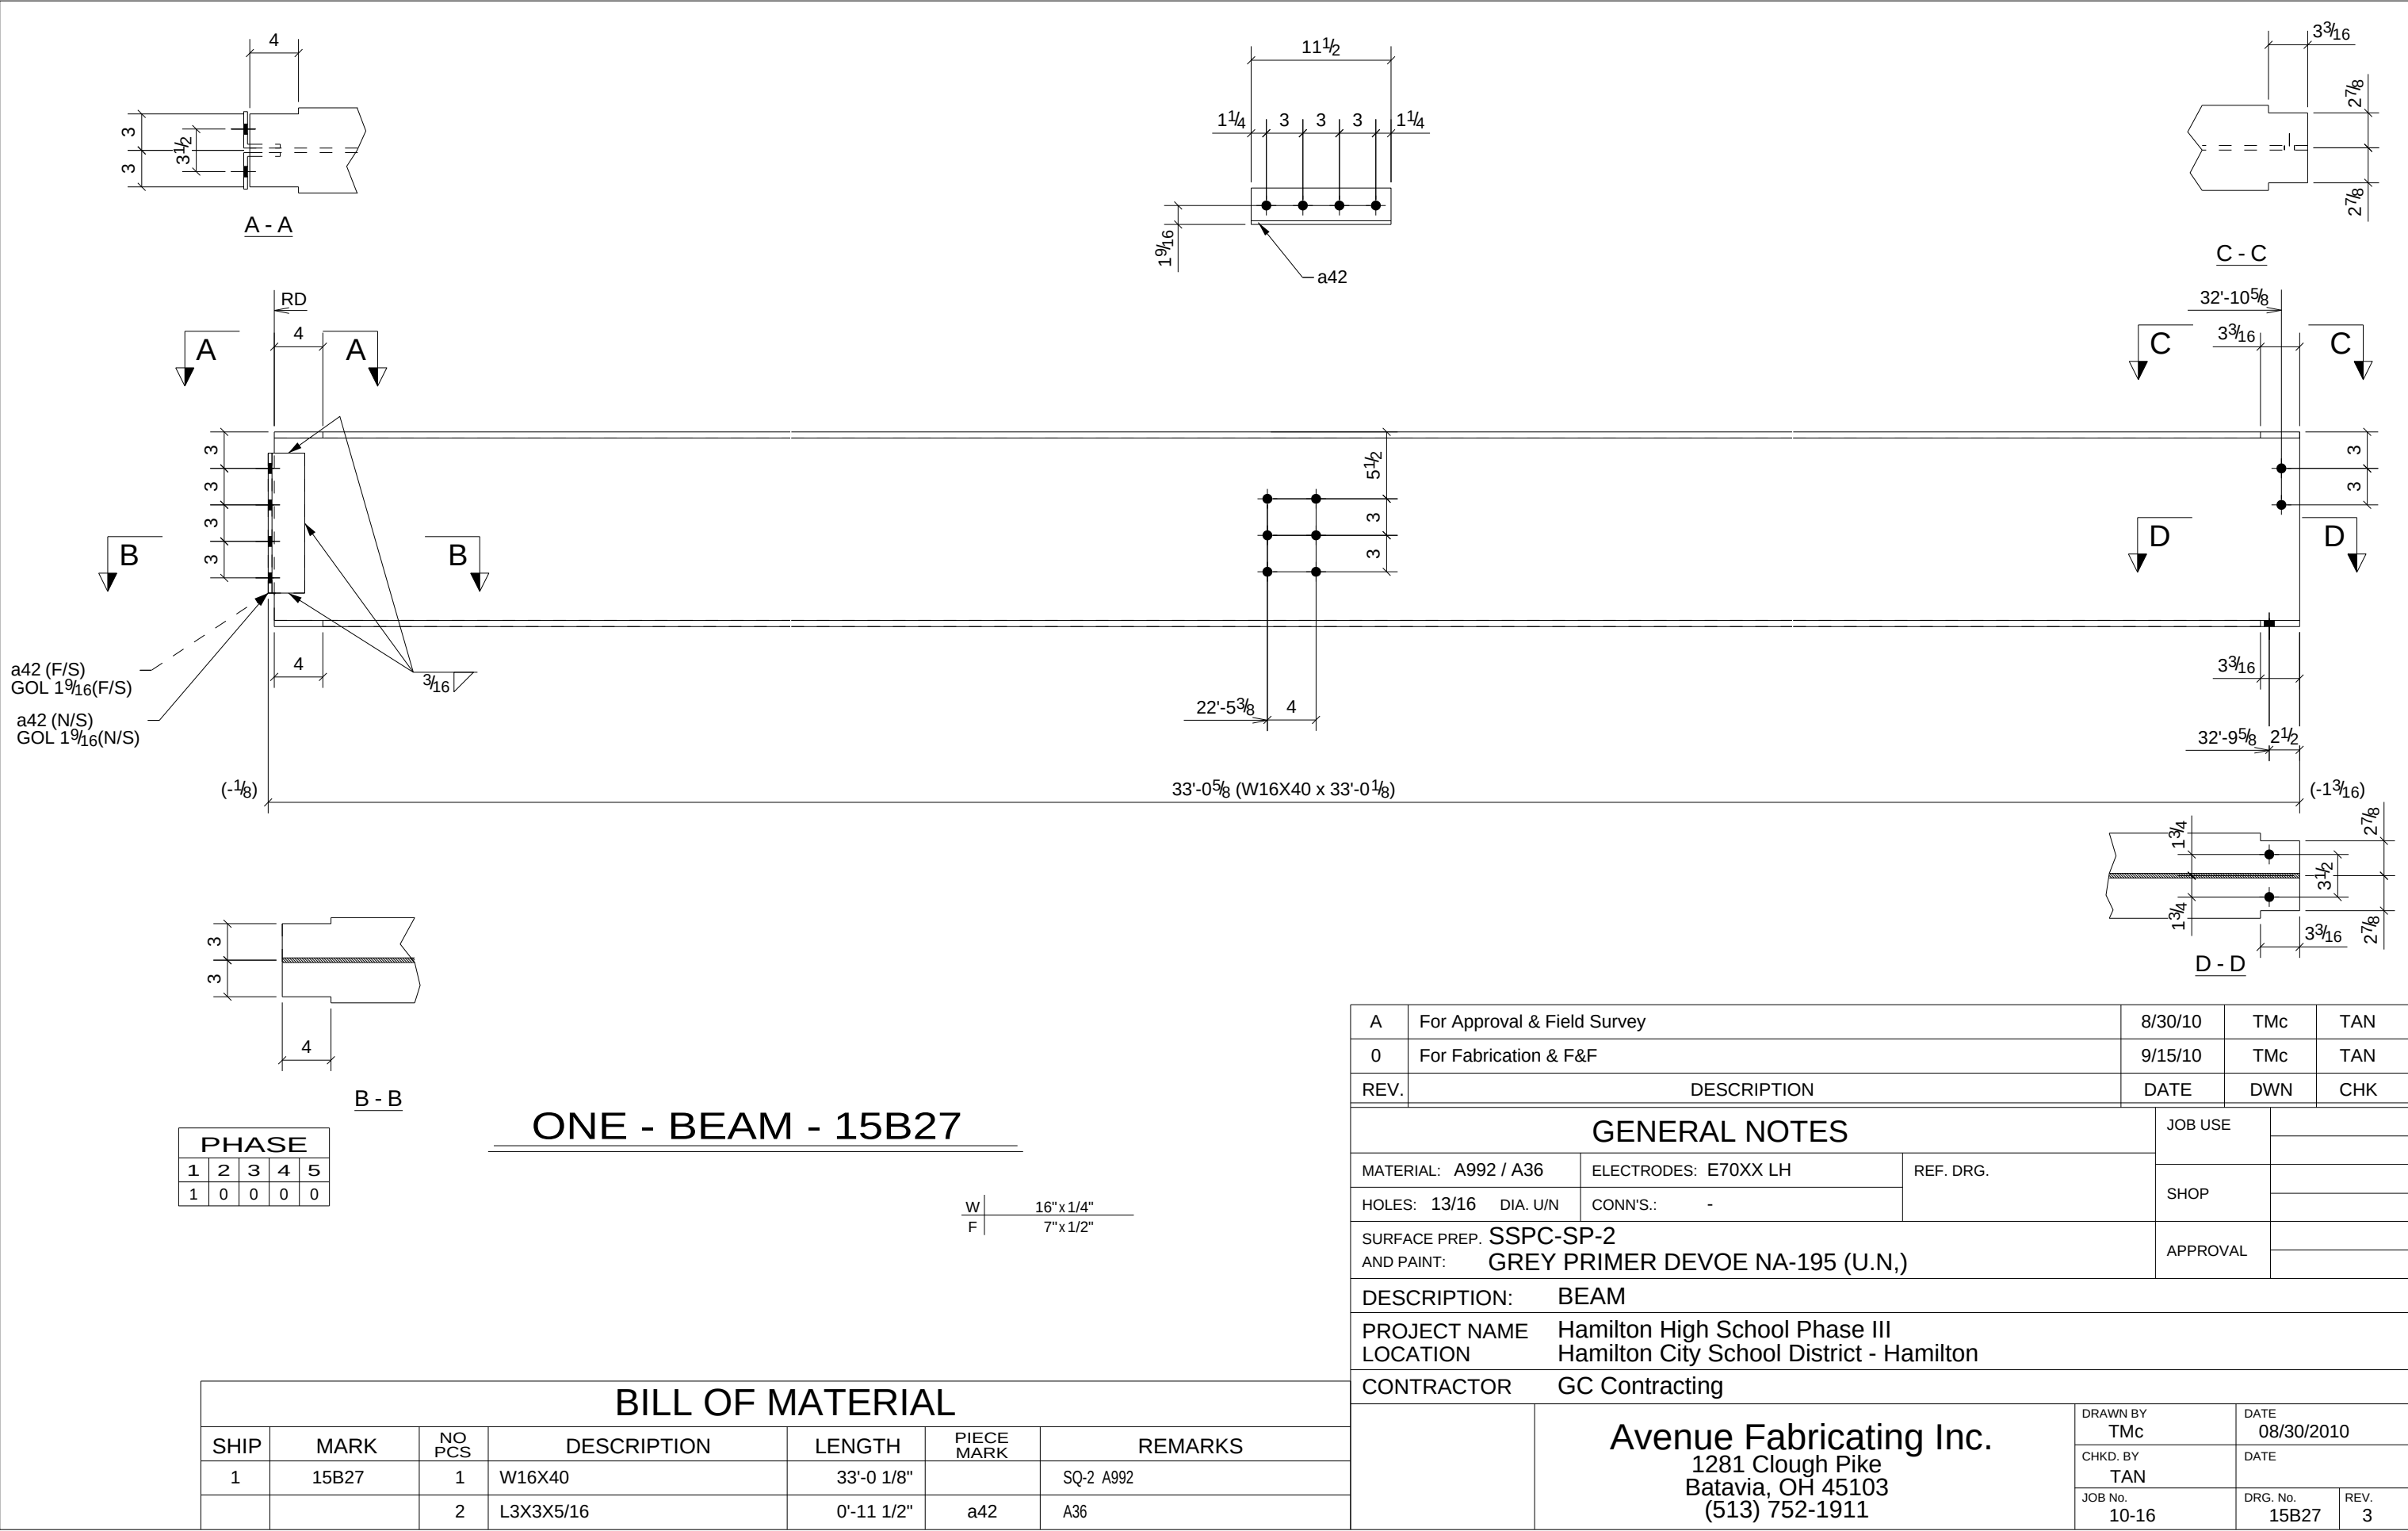

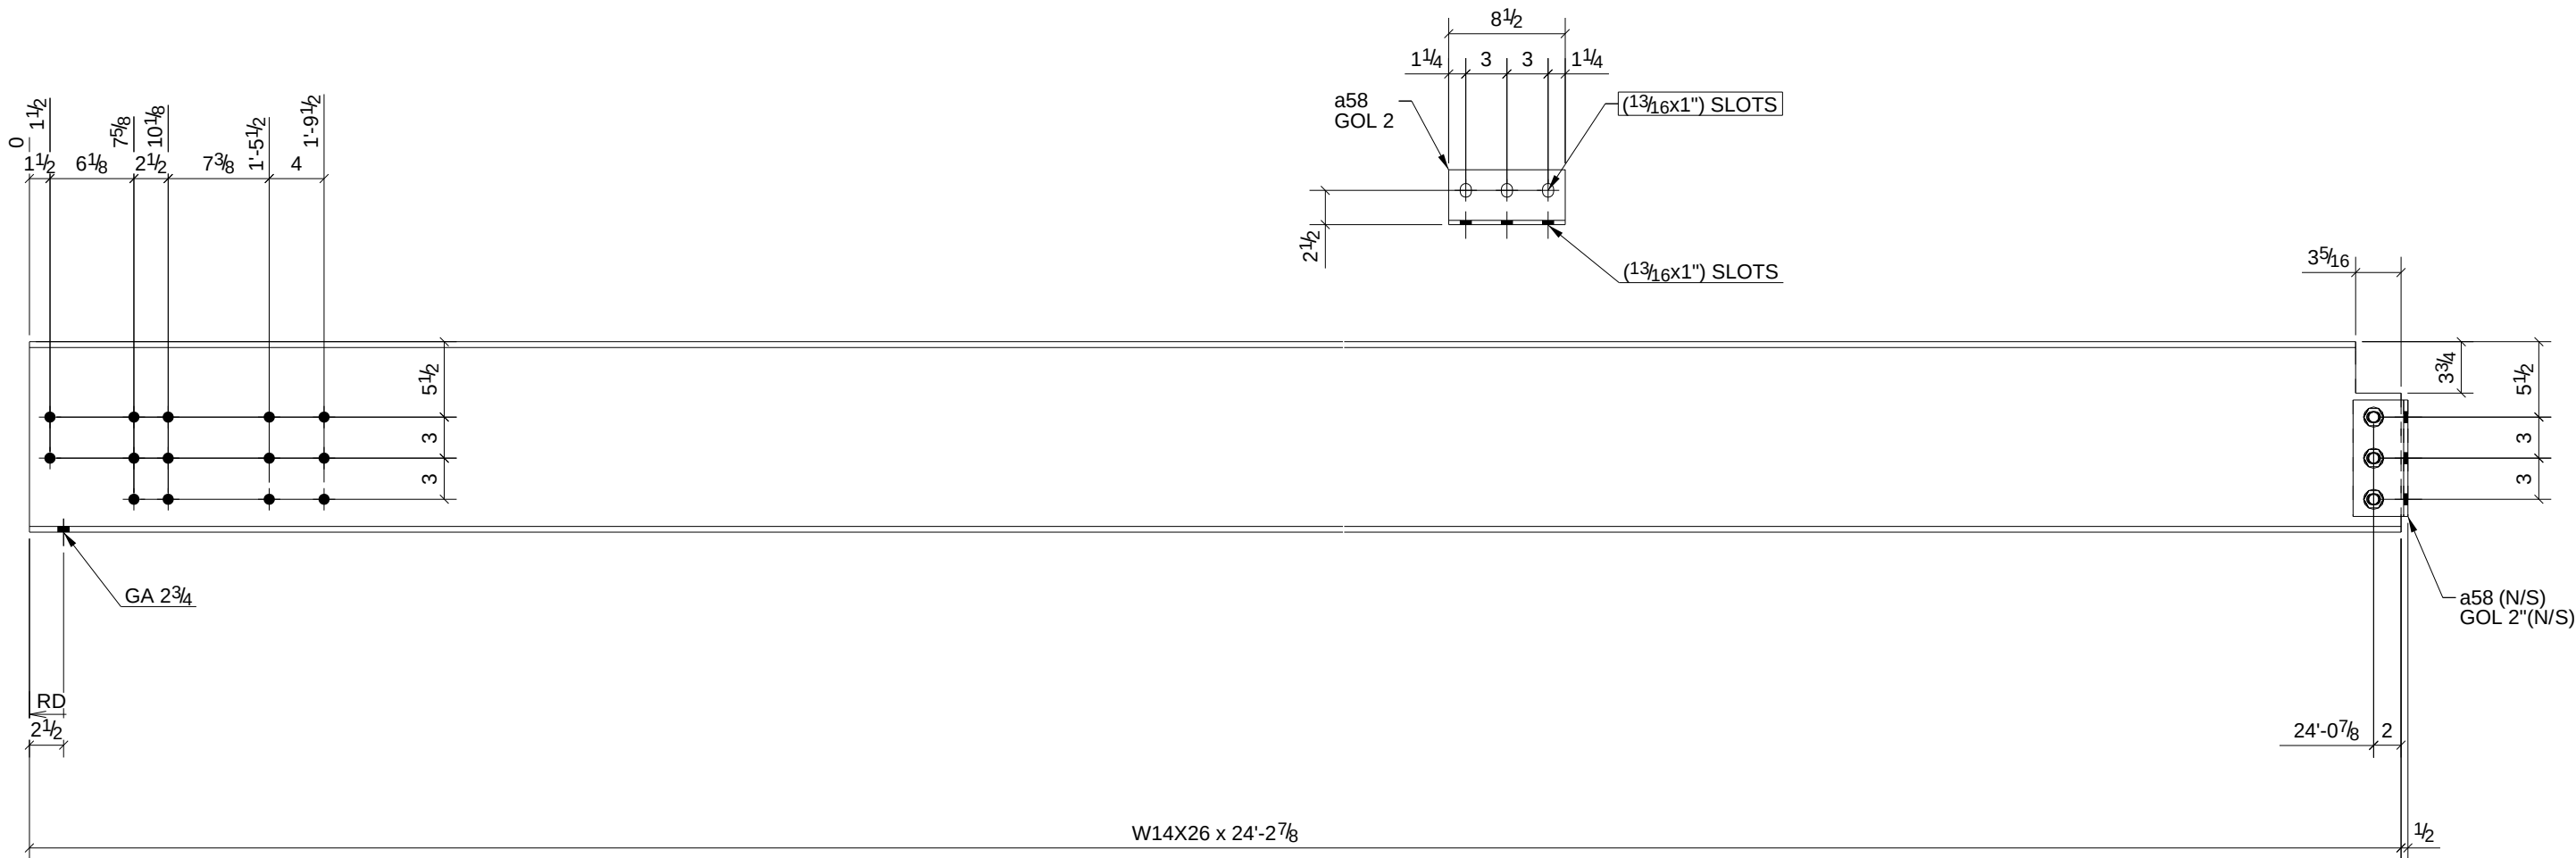

PHASE				
1	2	3	4	5
1	0	0	0	0




ONE - BEAM - 15B28

W	13 7/8"x1/4"
F	5"x7/16"


BILL OF MATERIAL

SHIP	MARK	NO PCS	DESCRIPTION	LENGTH	PIECE MARK	REMARKS
1	15B28	1	W14X26	24'-2 7/8"		SQ-2 A992
		1	L4X3-1/2X5/16	0'-8 1/2"	a58	A36
		3	3/4"Ø A325N BOLT	0'-1 3/4"		

A	For Approval & Field Survey		8/30/10	TMc	TAN
0	For Fabrication & F&F		9/15/10	TMc	TAN
REV.	DESCRIPTION		DATE	DWN	CHK
GENERAL NOTES			JOB USE		
MATERIAL: A992 / A36		ELECTRODES: E70XX LH	REF. DRG.	SHOP	
HOLES: 13/16 DIA. U/N		CONN'S.: -			
SURFACE PREP. SSPC-SP-2			APPROVAL		
AND PAINT: GREY PRIMER DEVOE NA-195 (U.N.)					
DESCRIPTION: BEAM					
PROJECT NAME		Hamilton High School Phase III			
LOCATION		Hamilton City School District - Hamilton			
CONTRACTOR		GC Contracting			
	Avenue Fabricating Inc. 1281 Clough Pike Batavia, OH 45103 (513) 752-1911		DRAWN BY TMc		DATE 08/30/2010
			CHKD. BY TAN		DATE
			JOB No. 10-16		DRG. No. 15B28

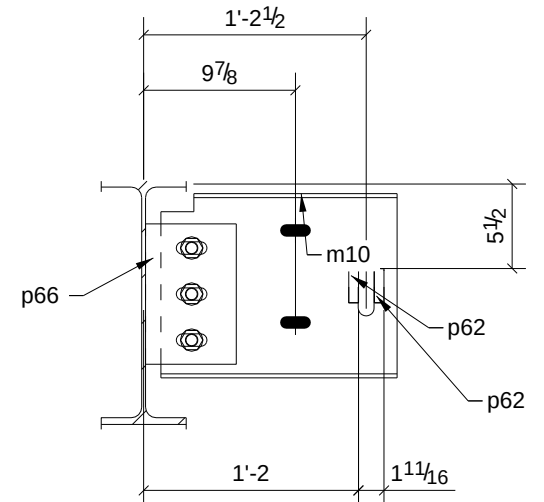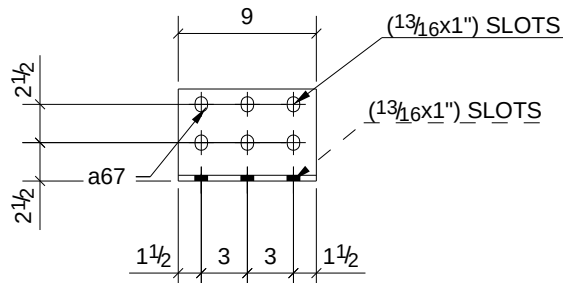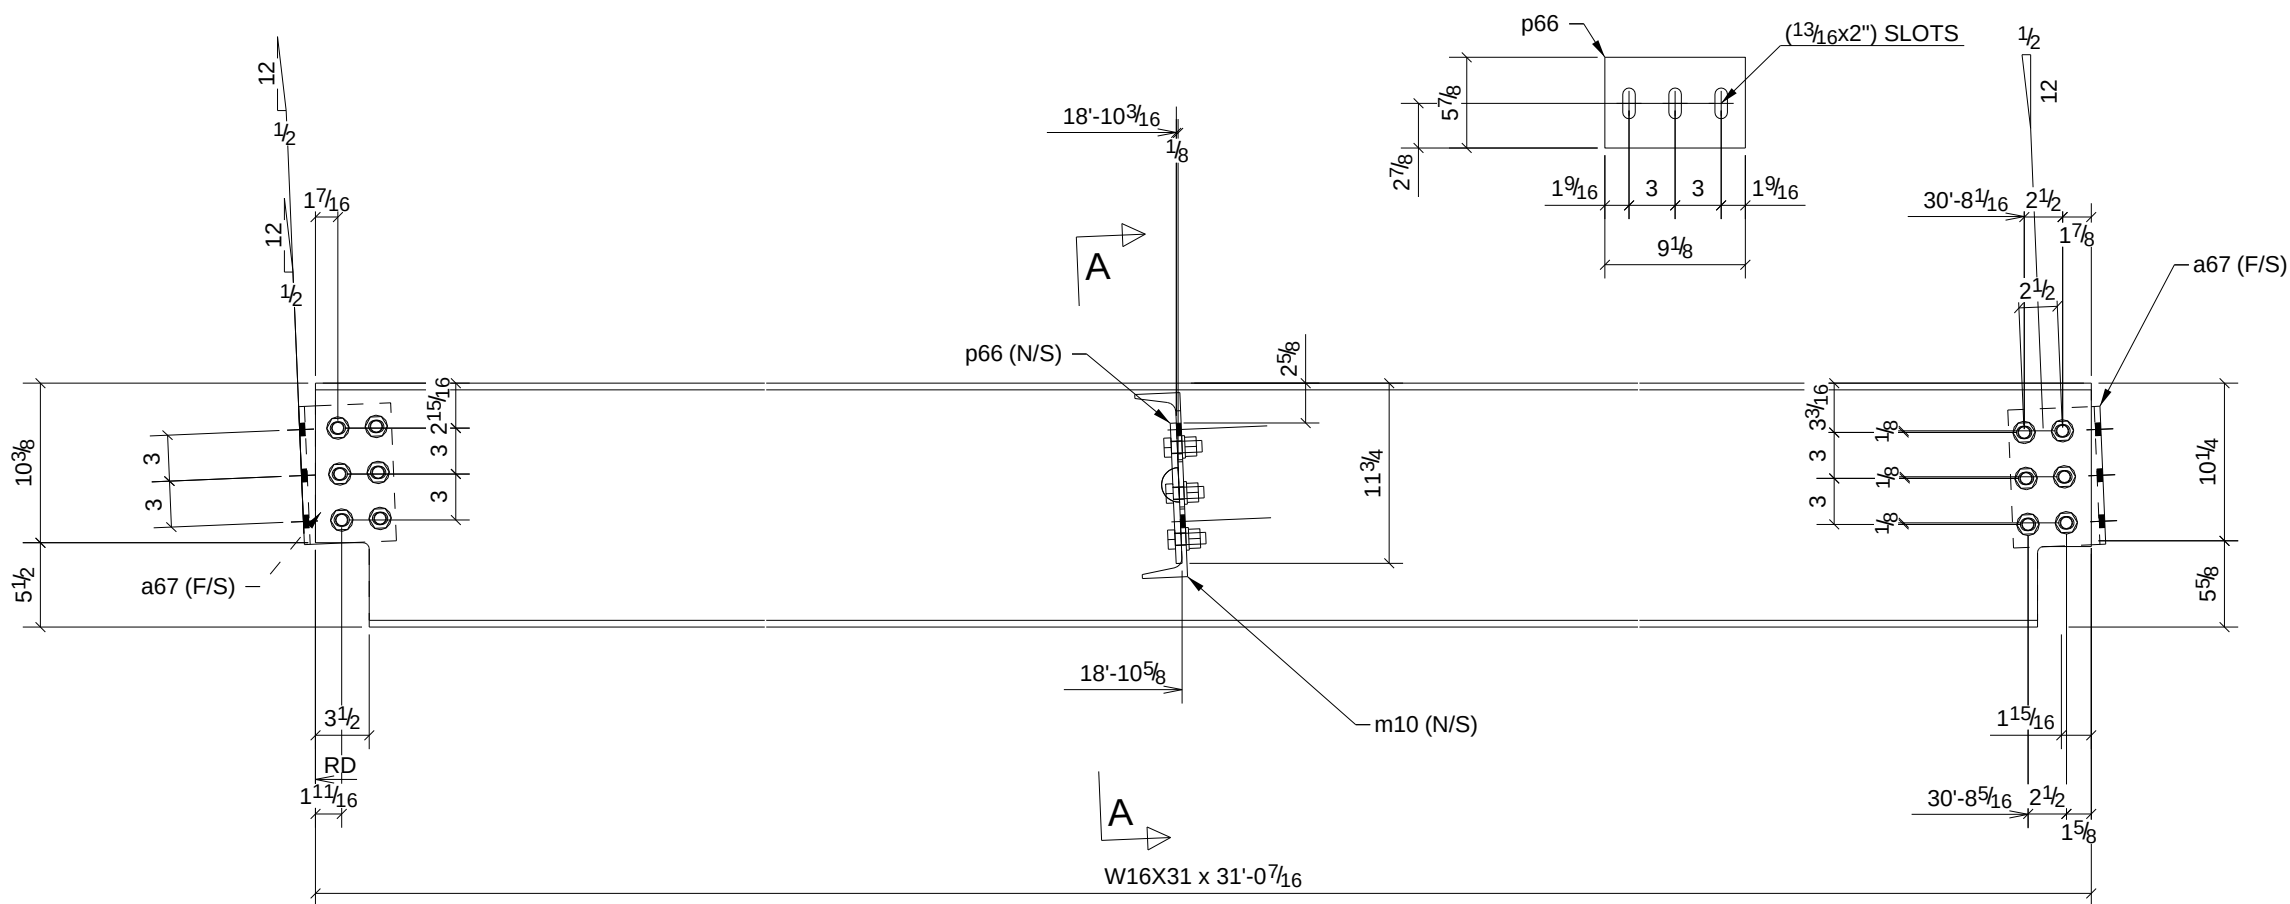

A - A

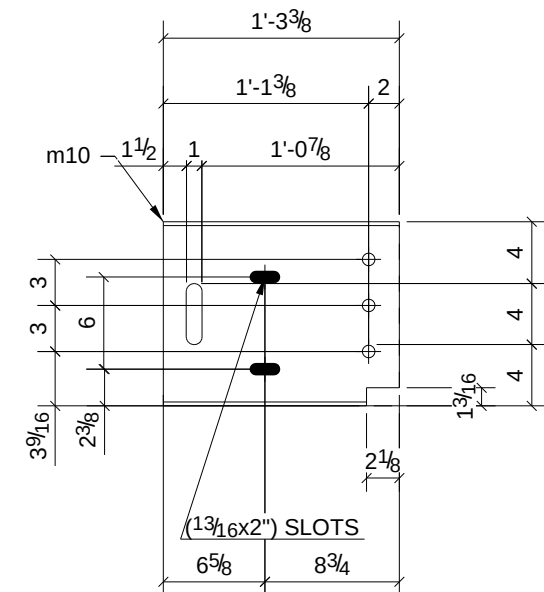

PHASE				
1	2	3	4	5
1	0	0	0	0


ONE - BEAM - 15B29

W	15 7/8" x 1/4"
F	5 1/2" x 7/16"

BILL OF MATERIAL

SHIP	MARK	NO PCS	DESCRIPTION	LENGTH	PIECE MARK	REMARKS
1	15B29	1	W16X31	31'-0 7/16"		SQ-2 A992
		2	L6X6X3/8	0'-9"	a67	A36
		1	C12X20.7	1'-3 3/8"	m10	A36
		2	PL5/8"X1 15/16"	0'-1 15/16"	p62	A36
		1	PL3/8"X5 7/8"	0'-9 1/8"	p66	A36
		3	3/4"Ø A325N BOLT	0'-2"		
		6	3/4"Ø A325N BOLT	0'-1 3/4"		

A	For Approval & Field Survey		8/30/10	TMc	TAN
0	For Fabrication & F&F		9/15/10	TMc	TAN
REV.	DESCRIPTION		DATE	DWN	CHK
GENERAL NOTES			JOB USE		
MATERIAL: A992 / A36		ELECTRODES: E70XX LH	REF. DRG.		
HOLES: 13/16 DIA. U/N		CONN'S.: -		SHOP	
SURFACE PREP. SSPC-SP-2			APPROVAL		
AND PAINT: GREY PRIMER DEVOE NA-195 (U.N,)					
DESCRIPTION: BEAM					
PROJECT NAME Hamilton High School Phase III					
LOCATION Hamilton City School District - Hamilton					
CONTRACTOR GC Contracting					
		Avenue Fabricating Inc. 1281 Clough Pike Batavia, OH 45103 (513) 752-1911	DRAWN BY TMc		DATE 09/01/2010
			CHKD. BY TAN		DATE
			JOB No. 10-16		DRG. No. 15B29

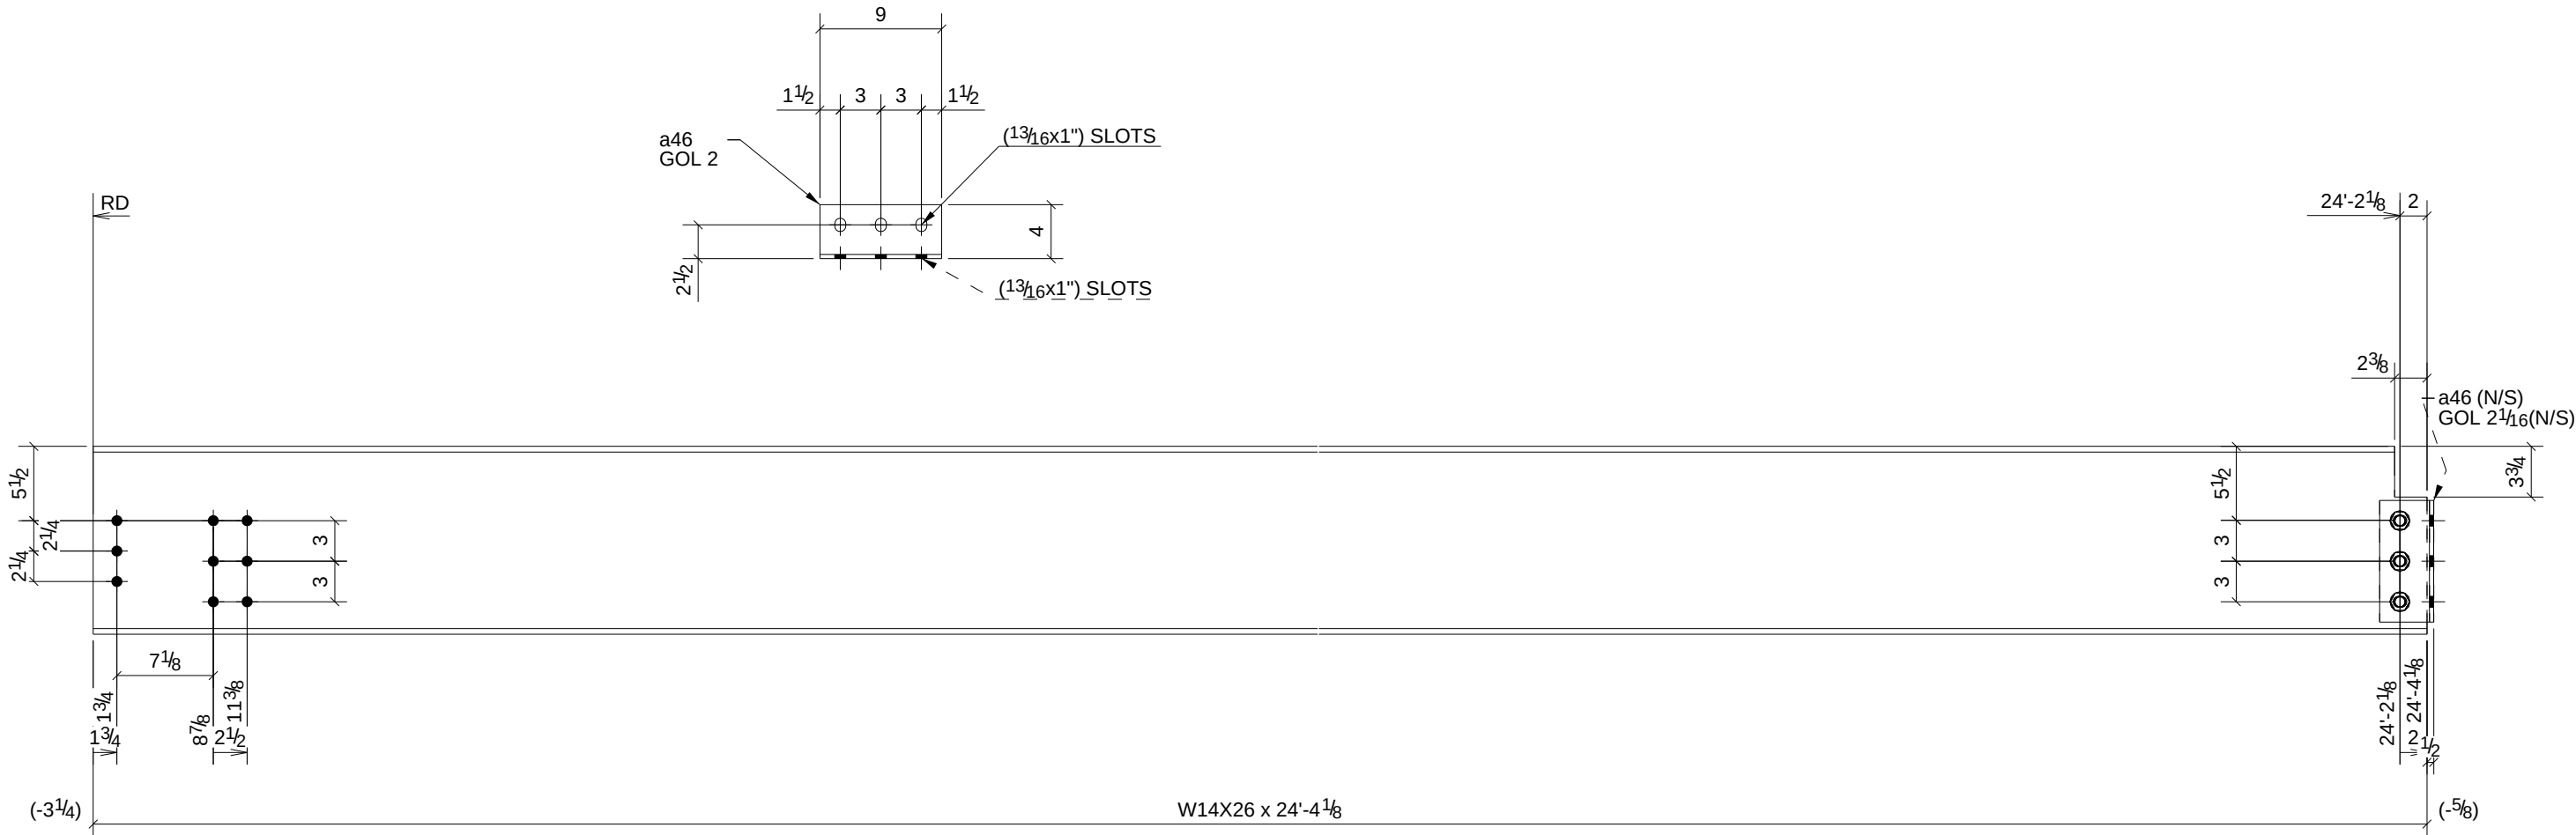

ONE - BEAM - 15B30


PHASE				
1	2	3	4	5
1	0	0	0	0

W	13 7/8"x1/4"
F	5"x7/16"

BILL OF MATERIAL

SHIP	MARK	NO PCS	DESCRIPTION	LENGTH	PIECE MARK	REMARKS
1	15B30	1	W14X26	24'-4 1/8"		SQ-2 A992
		1	L4X3-1/2X5/16	0'-9"	a46	A36
		3	3/4"Ø A325N BOLT	0'-1 3/4"		

A	For Approval & Field Survey		8/30/10	TMc	TAN	
0	For Fabrication & F&F		9/15/10	TMc	TAN	
REV.	DESCRIPTION		DATE	DWN	CHK	
GENERAL NOTES			JOB USE			
			SHOP			
MATERIAL: A992 / A36		ELECTRODES: E70XX LH	REF. DRG.			
HOLES: 13/16 DIA. U/N		CONN'S.: -				
SURFACE PREP. SSPC-SP-2			APPROVAL			
AND PAINT: GREY PRIMER DEVOE NA-195 (U.N.)						
DESCRIPTION: BEAM						
PROJECT NAME		Hamilton High School Phase III				
LOCATION		Hamilton City School District - Hamilton				
CONTRACTOR		GC Contracting				
	Avenue Fabricating Inc. 1281 Clough Pike Batavia, OH 45103 (513) 752-1911		DRAWN BY TMc		DATE 09/01/2010	
			CHKD. BY TAN		DATE	
			JOB No. 10-16		DRG. No. 15B30	

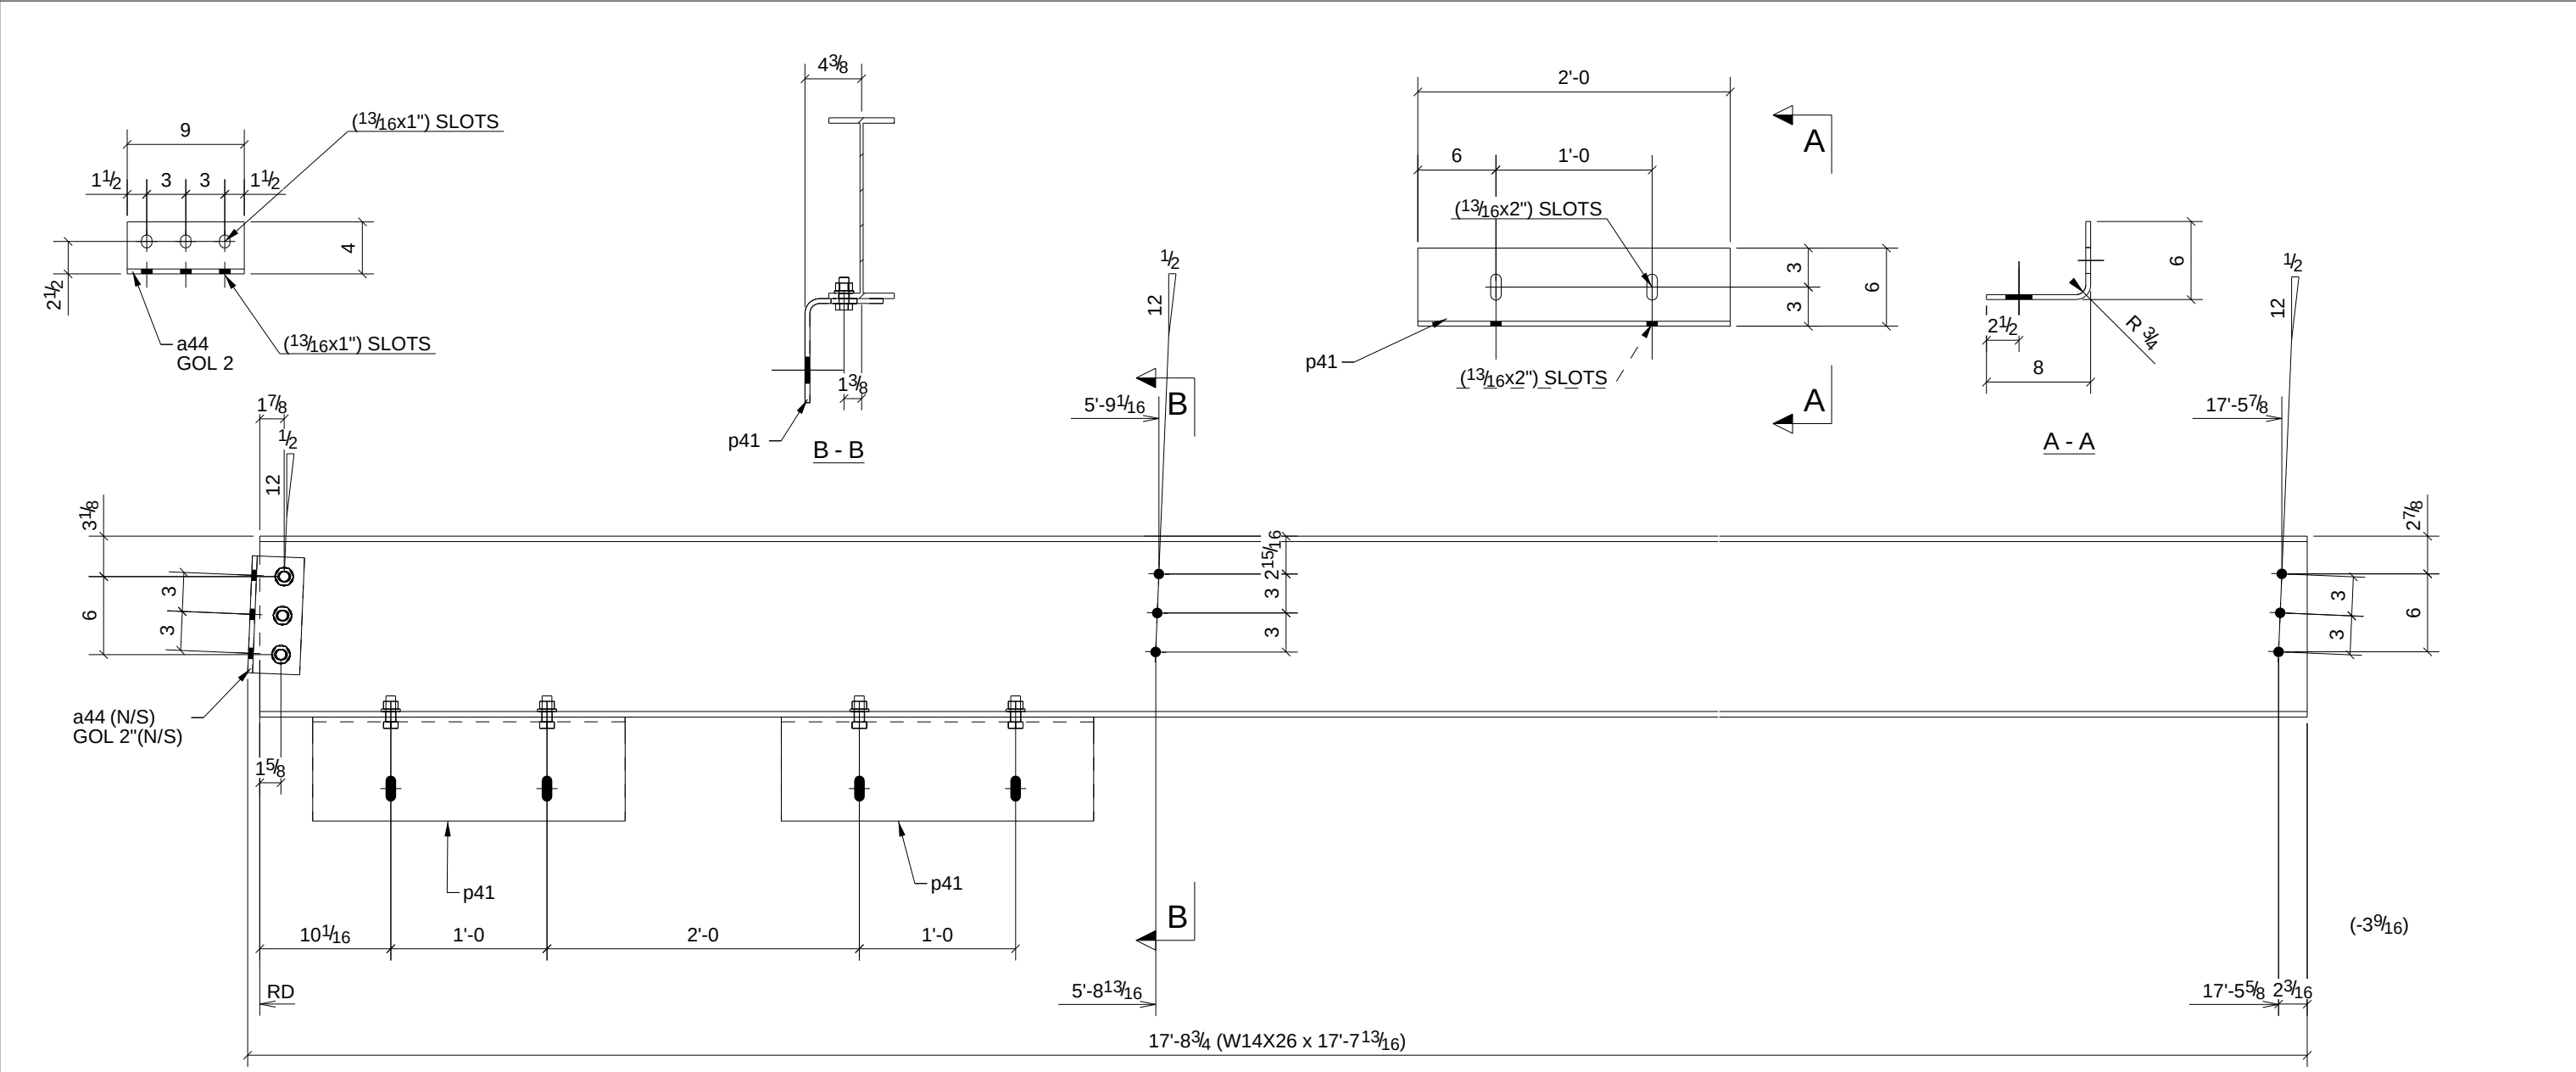

ONE - BEAM - 15B31


PHASE				
1	2	3	4	5
1	0	0	0	0

W	13 7/8"x 1/4"
F	5"x 7/16"

BILL OF MATERIAL

SHIP	MARK	NO PCS	DESCRIPTION	LENGTH	PIECE MARK	REMARKS
1	15B31	1	W14X26	17'-7 13/16"		SQ-2 A992
		1	L4X3-1/2X3/8	0'-9"	a44	A36
		2	PL3/8"X13 1/4"	2'-0"	p41	A36
		4	3/4"Ø A307 BOLT	0'-2"		
		3	3/4"Ø A325N BOLT	0'-2"		

A	For Approval & Field Survey		8/30/10	TMc	TAN
0	For Fabrication & F&F		9/15/10	TMc	TAN
REV.	DESCRIPTION		DATE	DWN	CHK
GENERAL NOTES			JOB USE		
MATERIAL: A992 / A36		ELECTRODES: E70XX LH	REF. DRG.		
HOLES: 13/16 DIA. U/N		CONN'S.: -		SHOP	
SURFACE PREP. SSPC-SP-2			APPROVAL		
AND PAINT: GREY PRIMER DEVOE NA-195 (U.N.)					
DESCRIPTION: BEAM					
PROJECT NAME		Hamilton High School Phase III			
LOCATION		Hamilton City School District - Hamilton			
CONTRACTOR		GC Contracting			
	Avenue Fabricating Inc. 1281 Clough Pike Batavia, OH 45103 (513) 752-1911		DRAWN BY TMc		DATE 09/01/2010
			CHKD. BY TAN		DATE
			JOB No. 10-16		DRG. No. 15B31

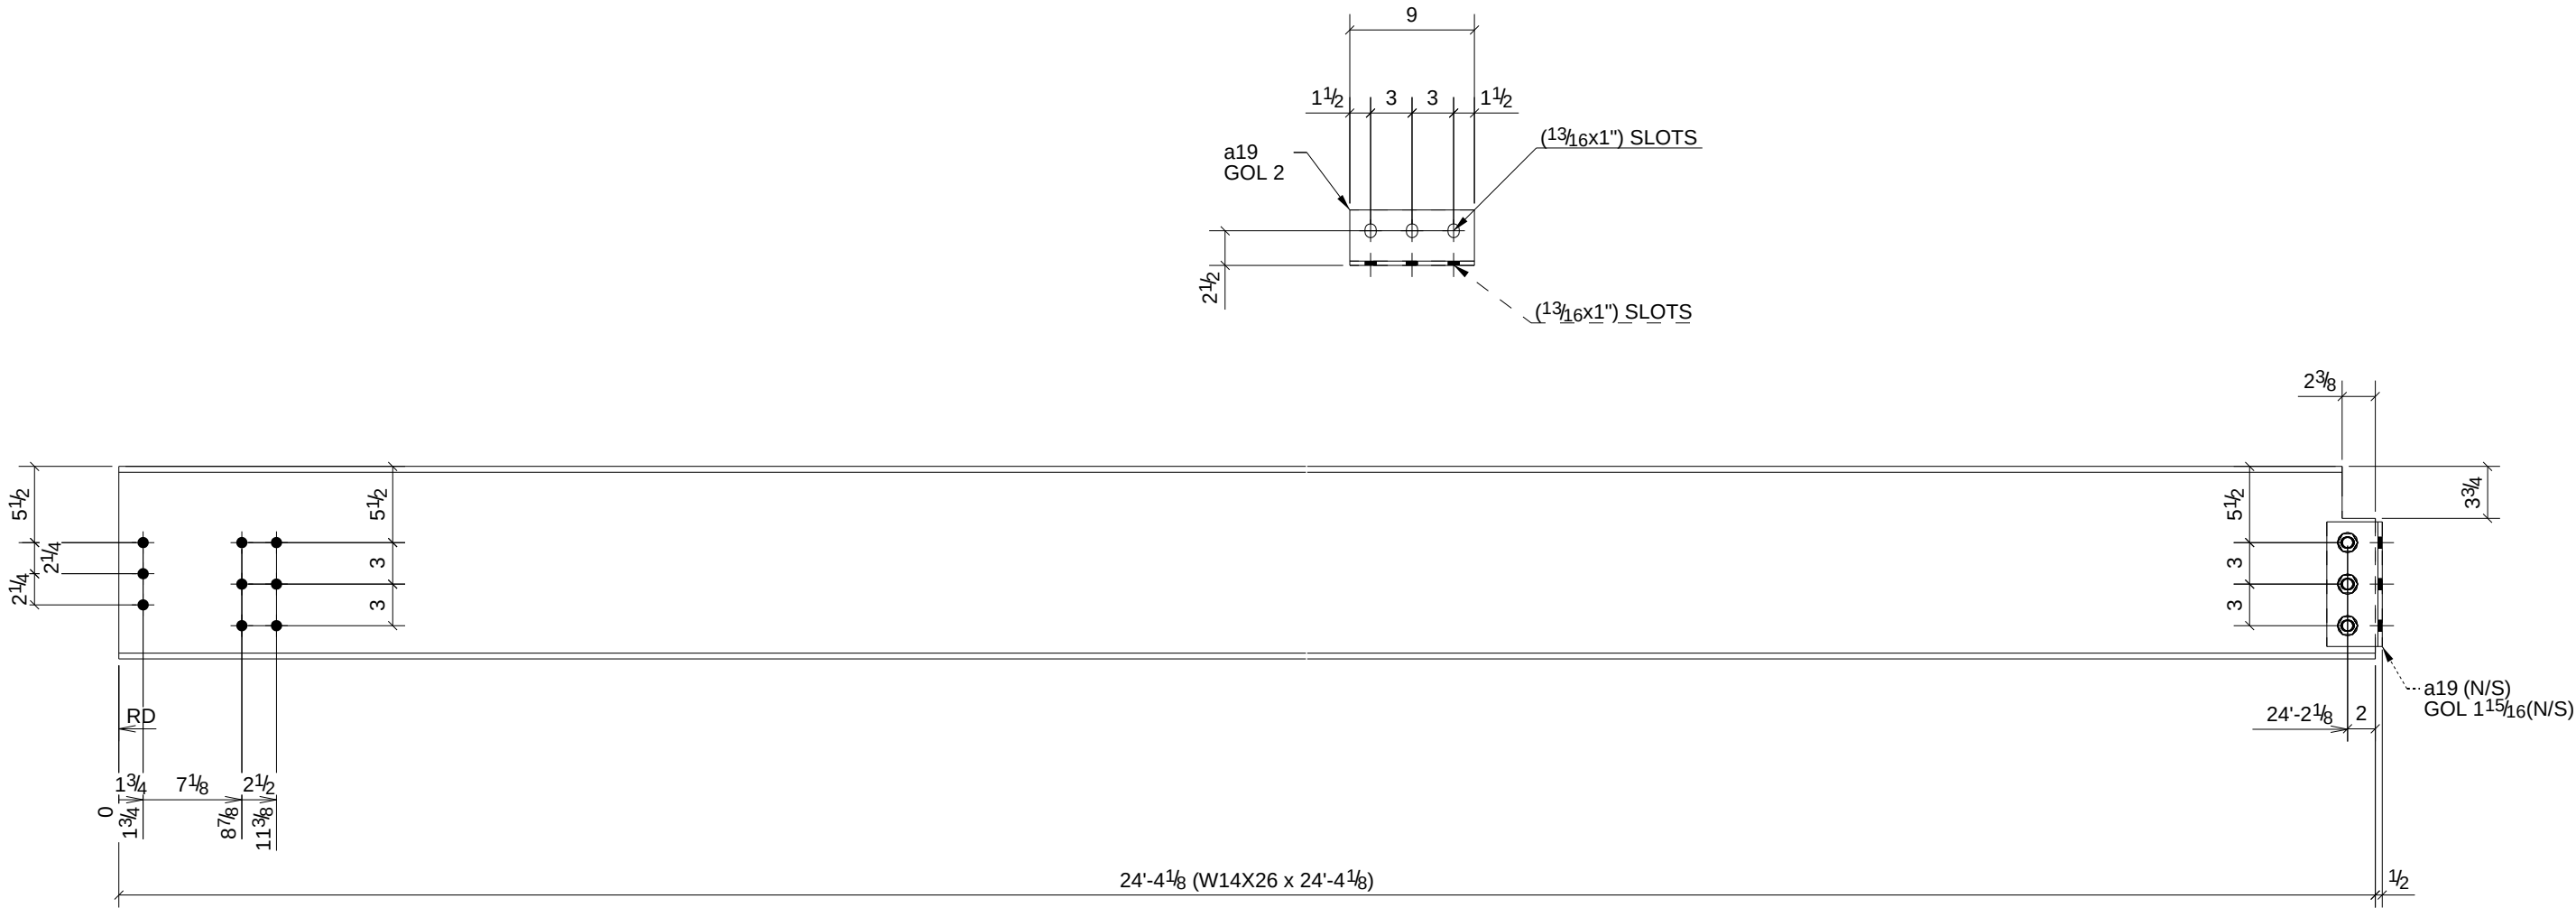

PHASE				
1	2	3	4	5
1	0	0	0	0




ONE - BEAM - 15B32

W	13 7/8"x1/4"
F	5"x7/16"



BILL OF MATERIAL

SHIP	MARK	NO PCS	DESCRIPTION	LENGTH	PIECE MARK	REMARKS
1	15B32	1	W14X26	24'-4 1/8"		SQ-2 A992
		1	L4X3-1/2X5/16	0'-9"	a19	A36
		3	3/4"Ø A325N BOLT	0'-1 3/4"		

A	For Approval & Field Survey		8/30/10	TMc	TAN
0	For Fabrication & F&F		9/15/10	TMc	TAN
REV.	DESCRIPTION		DATE	DWN	CHK
GENERAL NOTES			JOB USE		
MATERIAL: A992 / A36		ELECTRODES: E70XX LH	REF. DRG.	SHOP	
HOLES: 13/16 DIA. U/N		CONN'S.: -			
SURFACE PREP. SSPC-SP-2			APPROVAL		
AND PAINT: GREY PRIMER DEVOE NA-195 (U.N.)					
DESCRIPTION: BEAM					
PROJECT NAME		Hamilton High School Phase III			
LOCATION		Hamilton City School District - Hamilton			
CONTRACTOR GC Contracting					
	Avenue Fabricating Inc. 1281 Clough Pike Batavia, OH 45103 (513) 752-1911		DRAWN BY TMc		DATE 09/01/2010
			CHKD. BY TAN		DATE
			JOB No. 10-16		DRG. No. 15B32

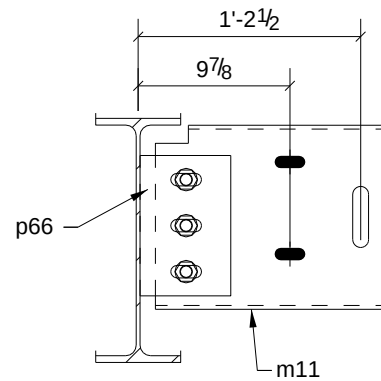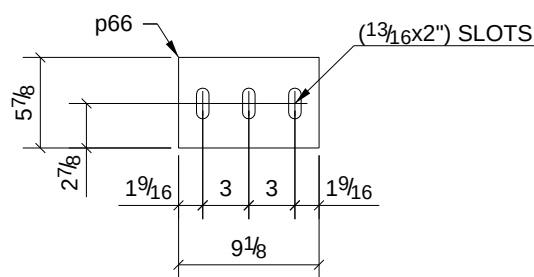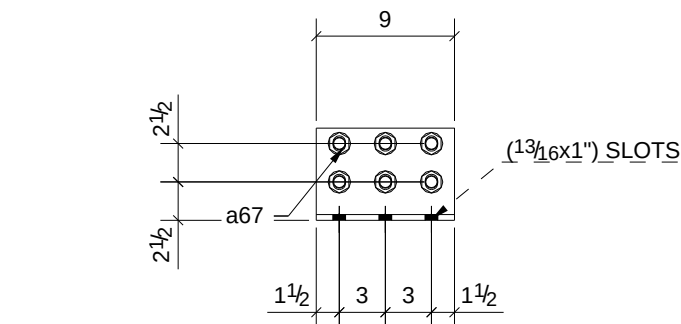

A - A

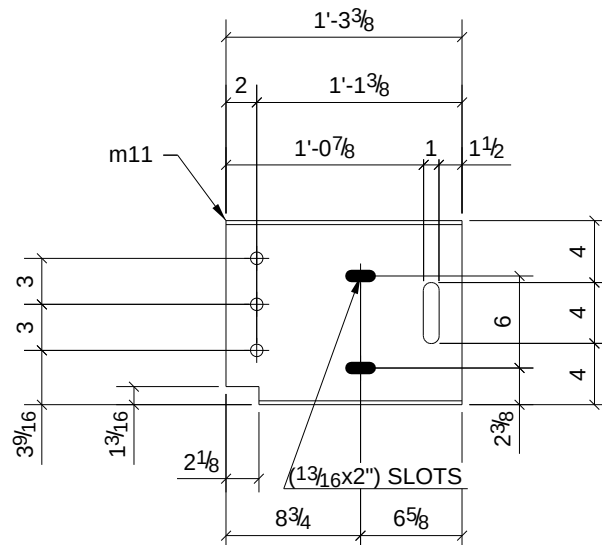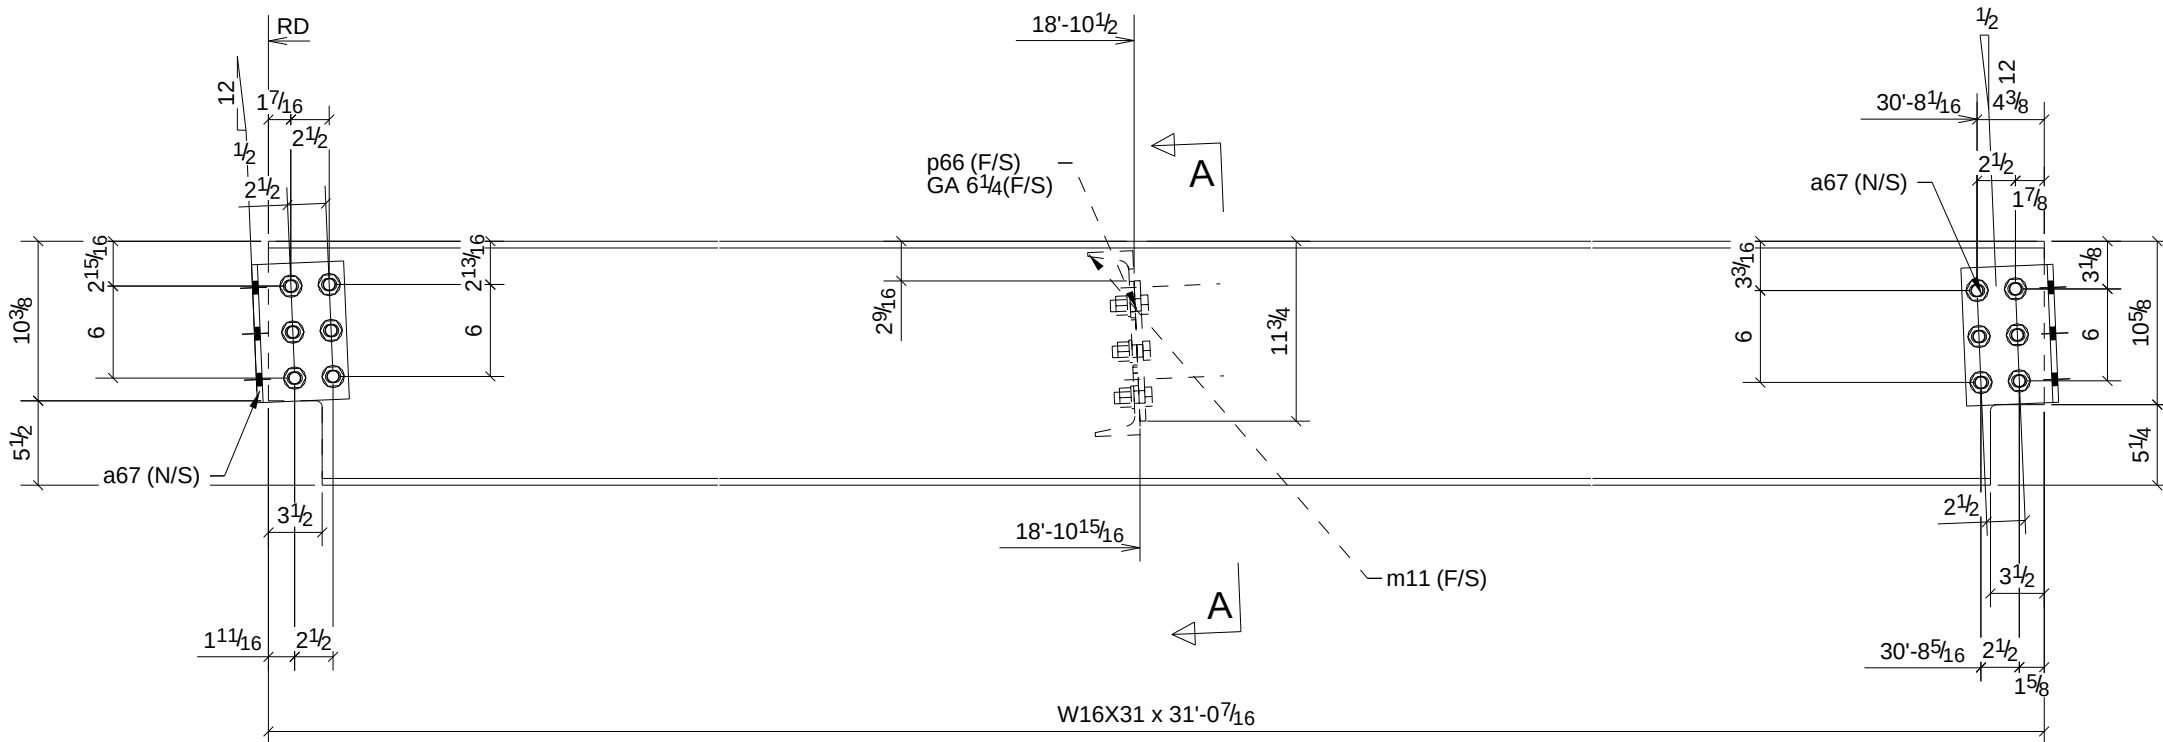

PHASE				
1	2	3	4	5
1	0	0	0	0


ONE - BEAM - 15B33

W	15 7/8" x 1/4"
F	5 1/2" x 7/16"

BILL OF MATERIAL

SHIP	MARK	NO PCS	DESCRIPTION	LENGTH	PIECE MARK	REMARKS
1	15B33	1	W16X31	31'-0 7/16"		SQ-2 A992
		2	L6X6X3/8	0'-9"	a67	A36
		1	C12X20.7	1'-3 3/8"	m11	A36
		1	PL3/8"X5 7/8"	0'-9 1/8"	p66	A36
		3	3/4"Ø A325N BOLT	0'-2"		
		12	3/4"Ø A325N BOLT	0'-1 3/4"		

A	For Approval & Field Survey	8/30/10	TMc	TAN
0	For Fabrication & F&F	9/15/10	TMc	TAN
REV.	DESCRIPTION	DATE	DWN	CHK
GENERAL NOTES		JOB USE		
MATERIAL: A992 / A36	ELECTRODES: E70XX LH	REF. DRG.		
HOLES: 13/16 DIA. U/N	CONN'S.: -		SHOP	
SURFACE PREP. SSPC-SP-2			APPROVAL	
AND PAINT: GREY PRIMER DEVOE NA-195 (U.N.)				
DESCRIPTION:	BEAM			
PROJECT NAME	Hamilton High School Phase III			
LOCATION	Hamilton City School District - Hamilton			
CONTRACTOR	GC Contracting			
	Avenue Fabricating Inc.		DRAWN BY	DATE
	1281 Clough Pike		TMc	09/01/2010
	Batavia, OH 45103		CHKD. BY	DATE
	(513) 752-1911		TAN	
			JOB No.	DRG. No.
			10-16	15B33
				REV.
				4

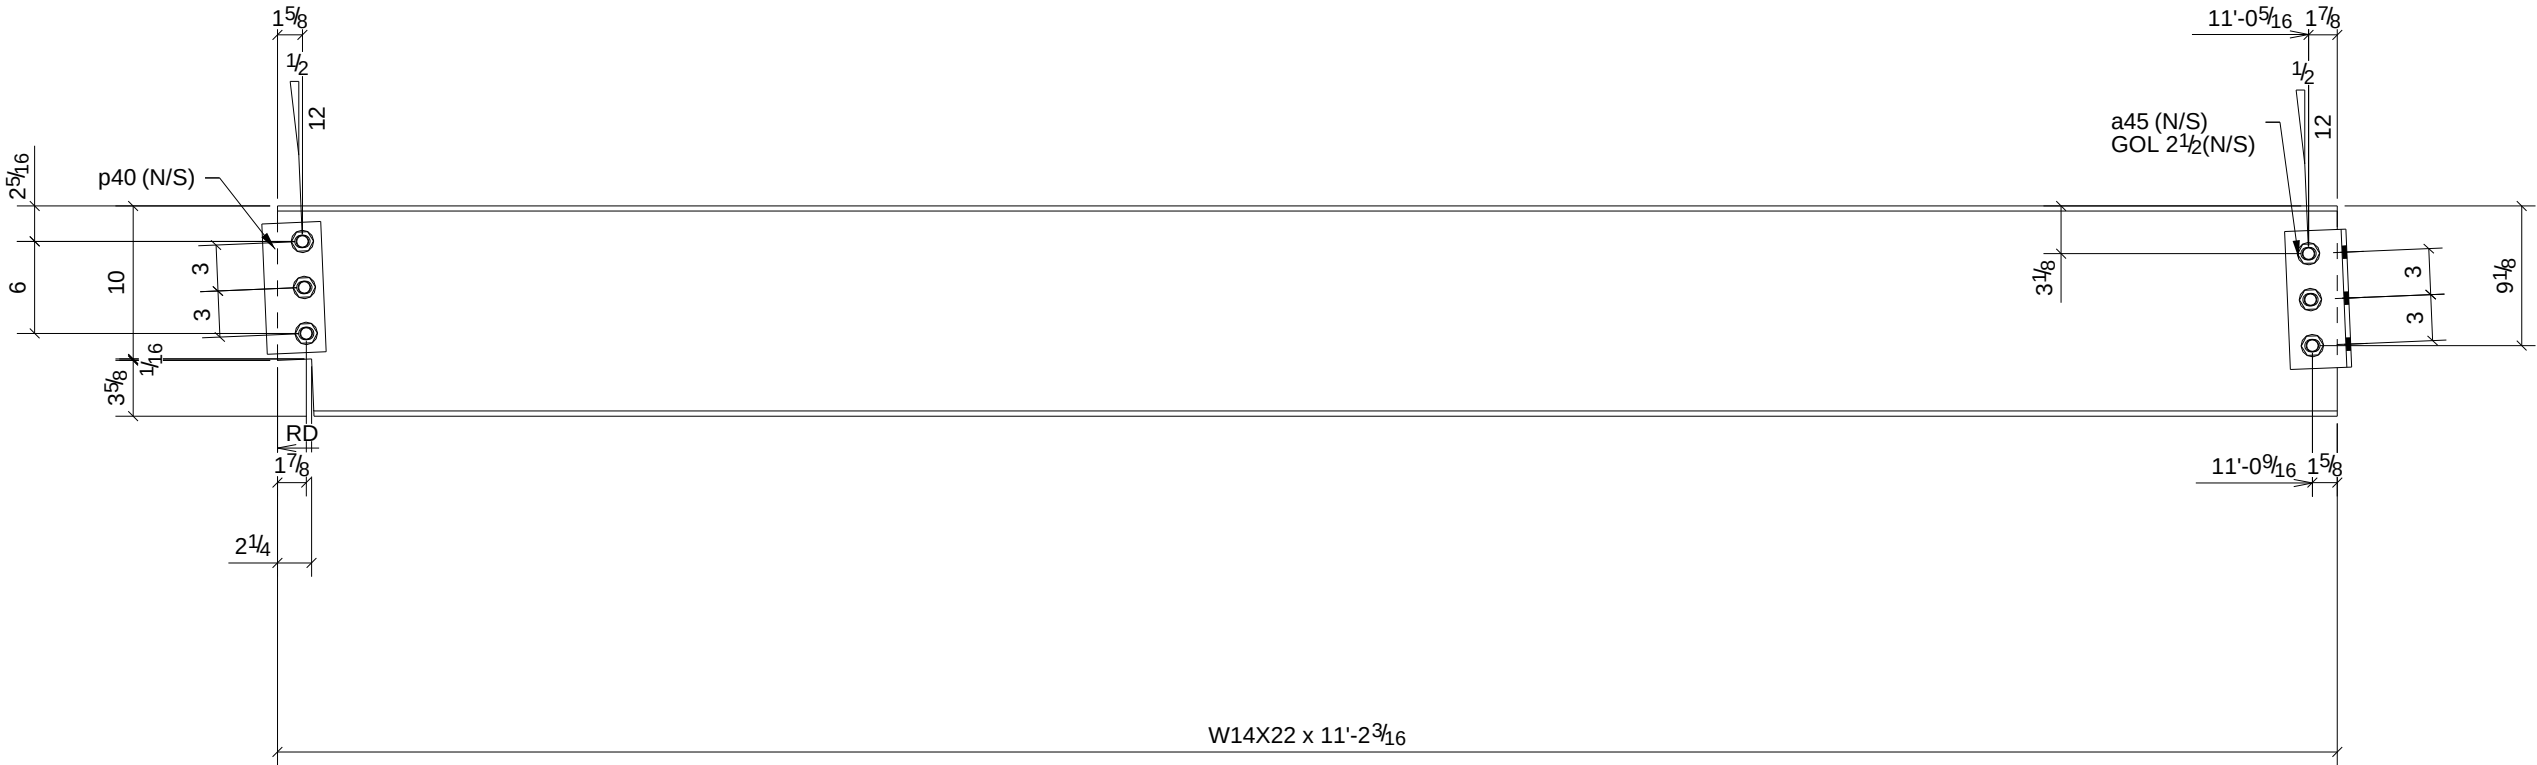

W14X22 x 11'-2 3/16

ONE - BEAM - 15B34


PHASE				
1	2	3	4	5
1	0	0	0	0

W	13 11/16"x1/4"
F	5"x5/16"

BILL OF MATERIAL

SHIP	MARK	NO PCS	DESCRIPTION	LENGTH	PIECE MARK	REMARKS
1	15B34	1	W14X22	11'-2 3/16"		SQ-2 A992
		1	L4X4X5/16	0'-9"	a45	A36
		1	PL3/8"X3 7/8"	0'-8 1/2"	p40	A36
		6	3/4"Ø A325N BOLT	0'-1 3/4"		

A	For Approval & Field Survey		8/30/10	TMc	TAN
0	For Fabrication & F&F		9/15/10	TMc	TAN
REV.	DESCRIPTION		DATE	DWN	CHK
GENERAL NOTES			JOB USE		
MATERIAL: A992 / A36		ELECTRODES: E70XX LH	REF. DRG.	SHOP	
HOLES: 13/16 DIA. U/N		CONN'S.: -			
SURFACE PREP. SSPC-SP-2			APPROVAL		
AND PAINT: GREY PRIMER DEVOE NA-195 (U.N.)					
DESCRIPTION: BEAM					
PROJECT NAME		Hamilton High School Phase III			
LOCATION		Hamilton City School District - Hamilton			
CONTRACTOR		GC Contracting			
	Avenue Fabricating Inc. 1281 Clough Pike Batavia, OH 45103 (513) 752-1911		DRAWN BY TMc		DATE 09/01/2010
			CHKD. BY TAN		DATE
			JOB No. 10-16		DRG. No. 15B34

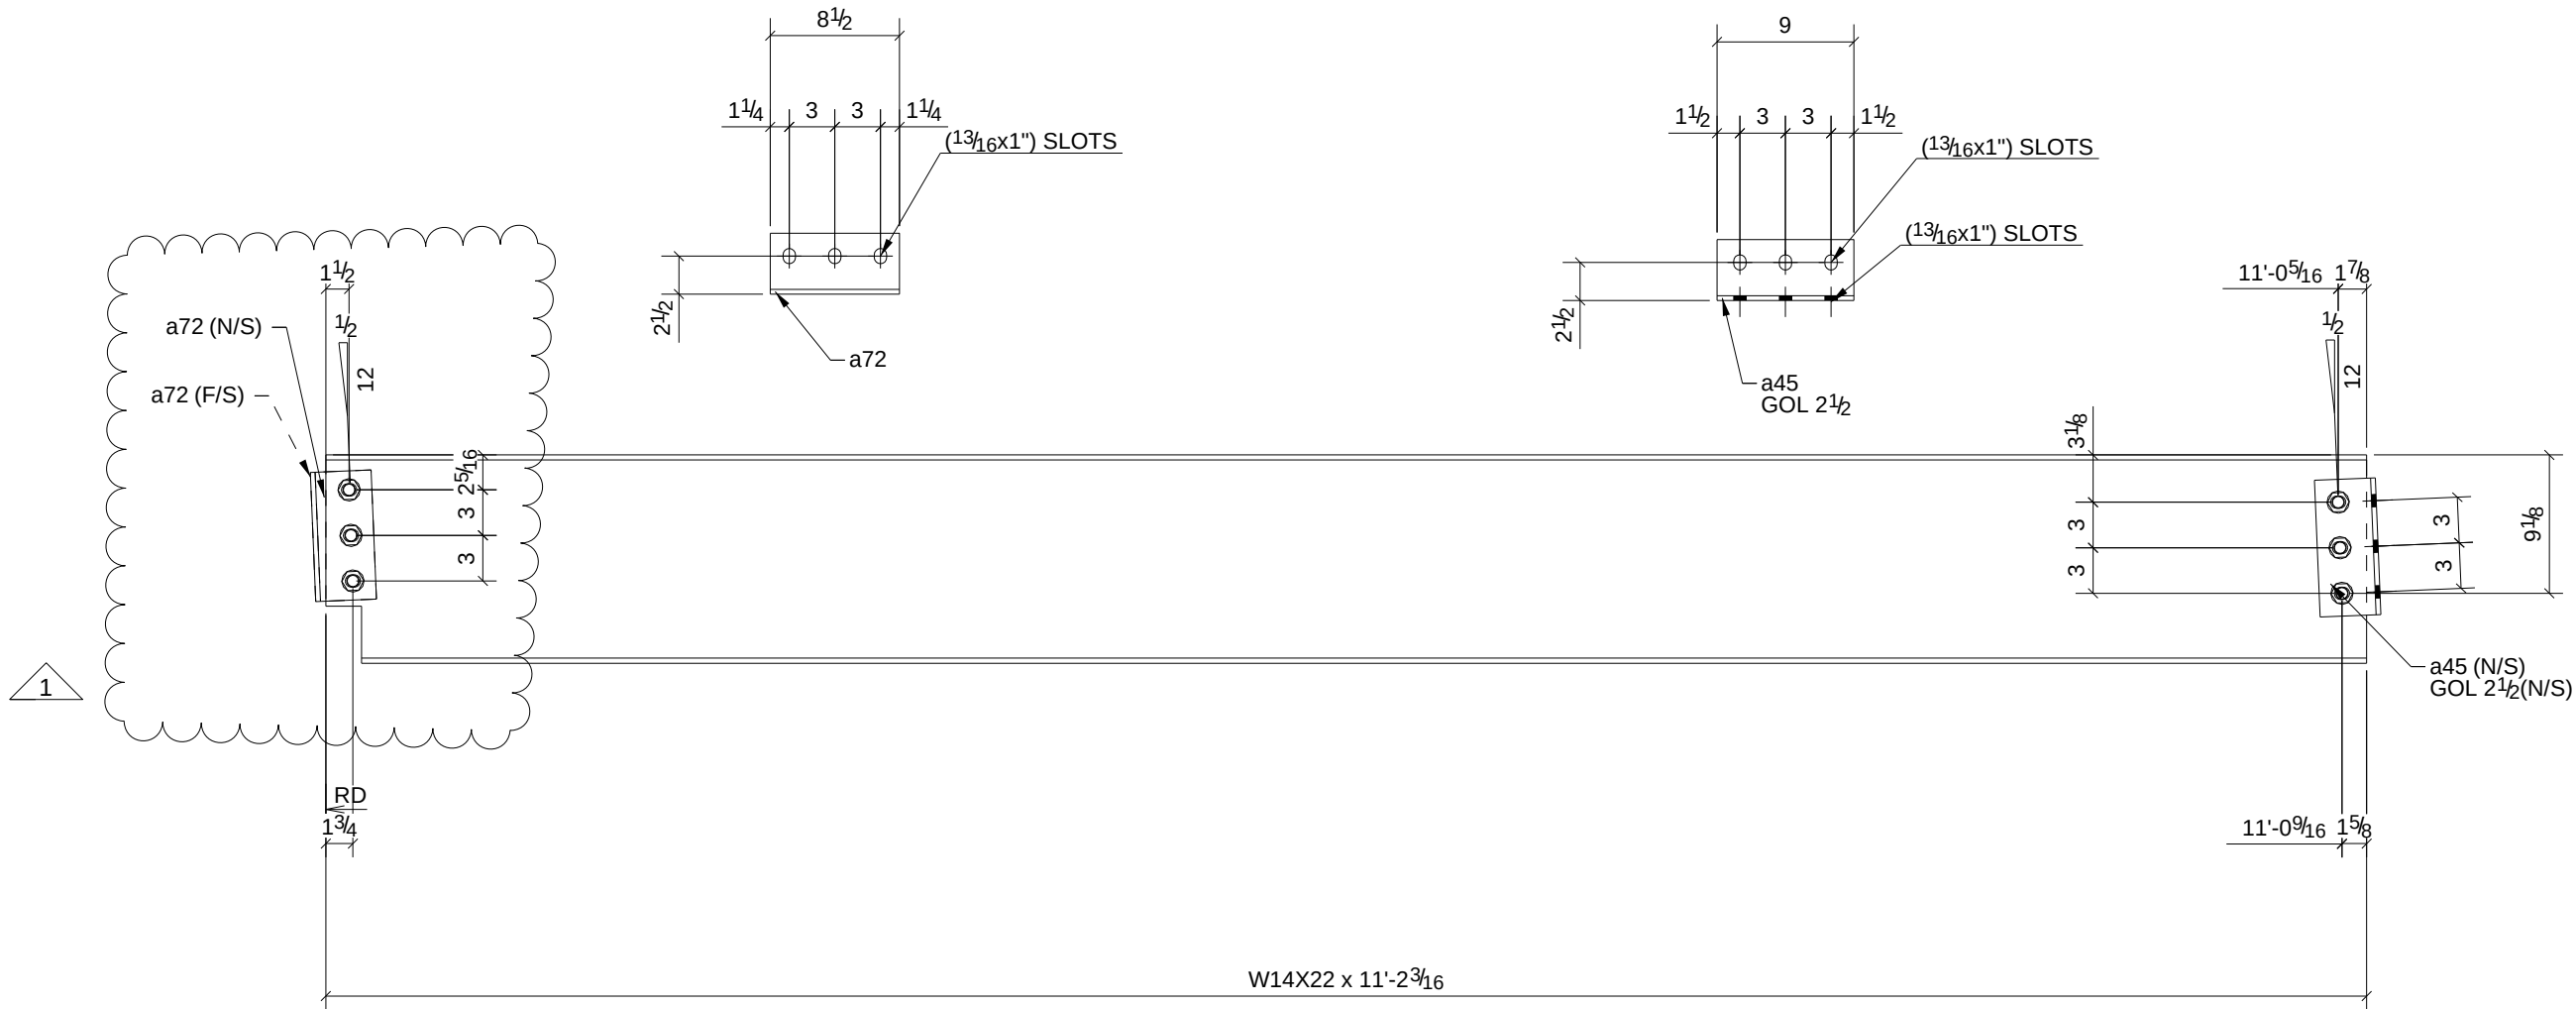

ONE - BEAM - 15B34


PHASE				
1	2	3	4	5
1	0	0	0	0


W	13 11/16"x 1/4"
F	5"x 5/16"

BILL OF MATERIAL

SHIP	MARK	NO PCS	DESCRIPTION	LENGTH	PIECE MARK	REMARKS
1	15B34	1	W14X22	11'-2 3/16"		SQ-2 A992
		1	L4X4X5/16	0'-9"	a45	A36
		2	L4X4X5/16	0'-8 1/2"	a72	A36
		3	3/4"Ø A325N BOLT	0'-2"		
		3	3/4"Ø A325N BOLT	0'-1 3/4"		

A	For Approval & Field Survey		8/30/10	TMc	TAN
1	revised shear bar to angle		9-17-10		
0	For Fabrication & F&F		9/15/10	TMc	TAN
REV.	DESCRIPTION		DATE	DWN	CHK
GENERAL NOTES			JOB USE		
MATERIAL: A992 / A36		ELECTRODES: E70XX LH	REF. DRG.		
HOLES: 13/16 DIA. U/N		CONN'S.: -		SHOP	
SURFACE PREP. SSPC-SP-2			APPROVAL		
AND PAINT: GREY PRIMER DEVOE NA-195 (U.N.)					
DESCRIPTION: BEAM					
PROJECT NAME Hamilton High School Phase III					
LOCATION Hamilton City School District - Hamilton					
CONTRACTOR GC Contracting					
	Avenue Fabricating Inc. 1281 Clough Pike Batavia, OH 45103 (513) 752-1911		DRAWN BY		DATE
			TMc		09/01/2010
			CHKD. BY		DATE
			TAN		
		JOB No.	DRG. No.	REV.	
		10-16	15B34	5	

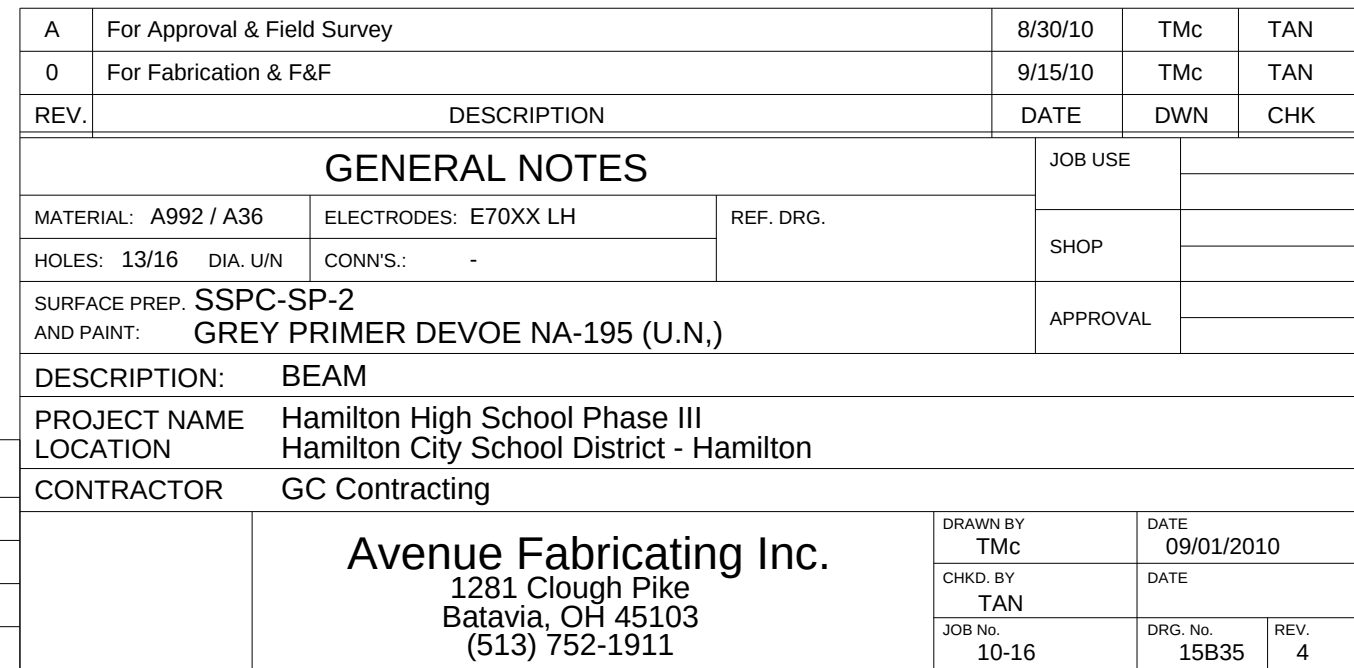

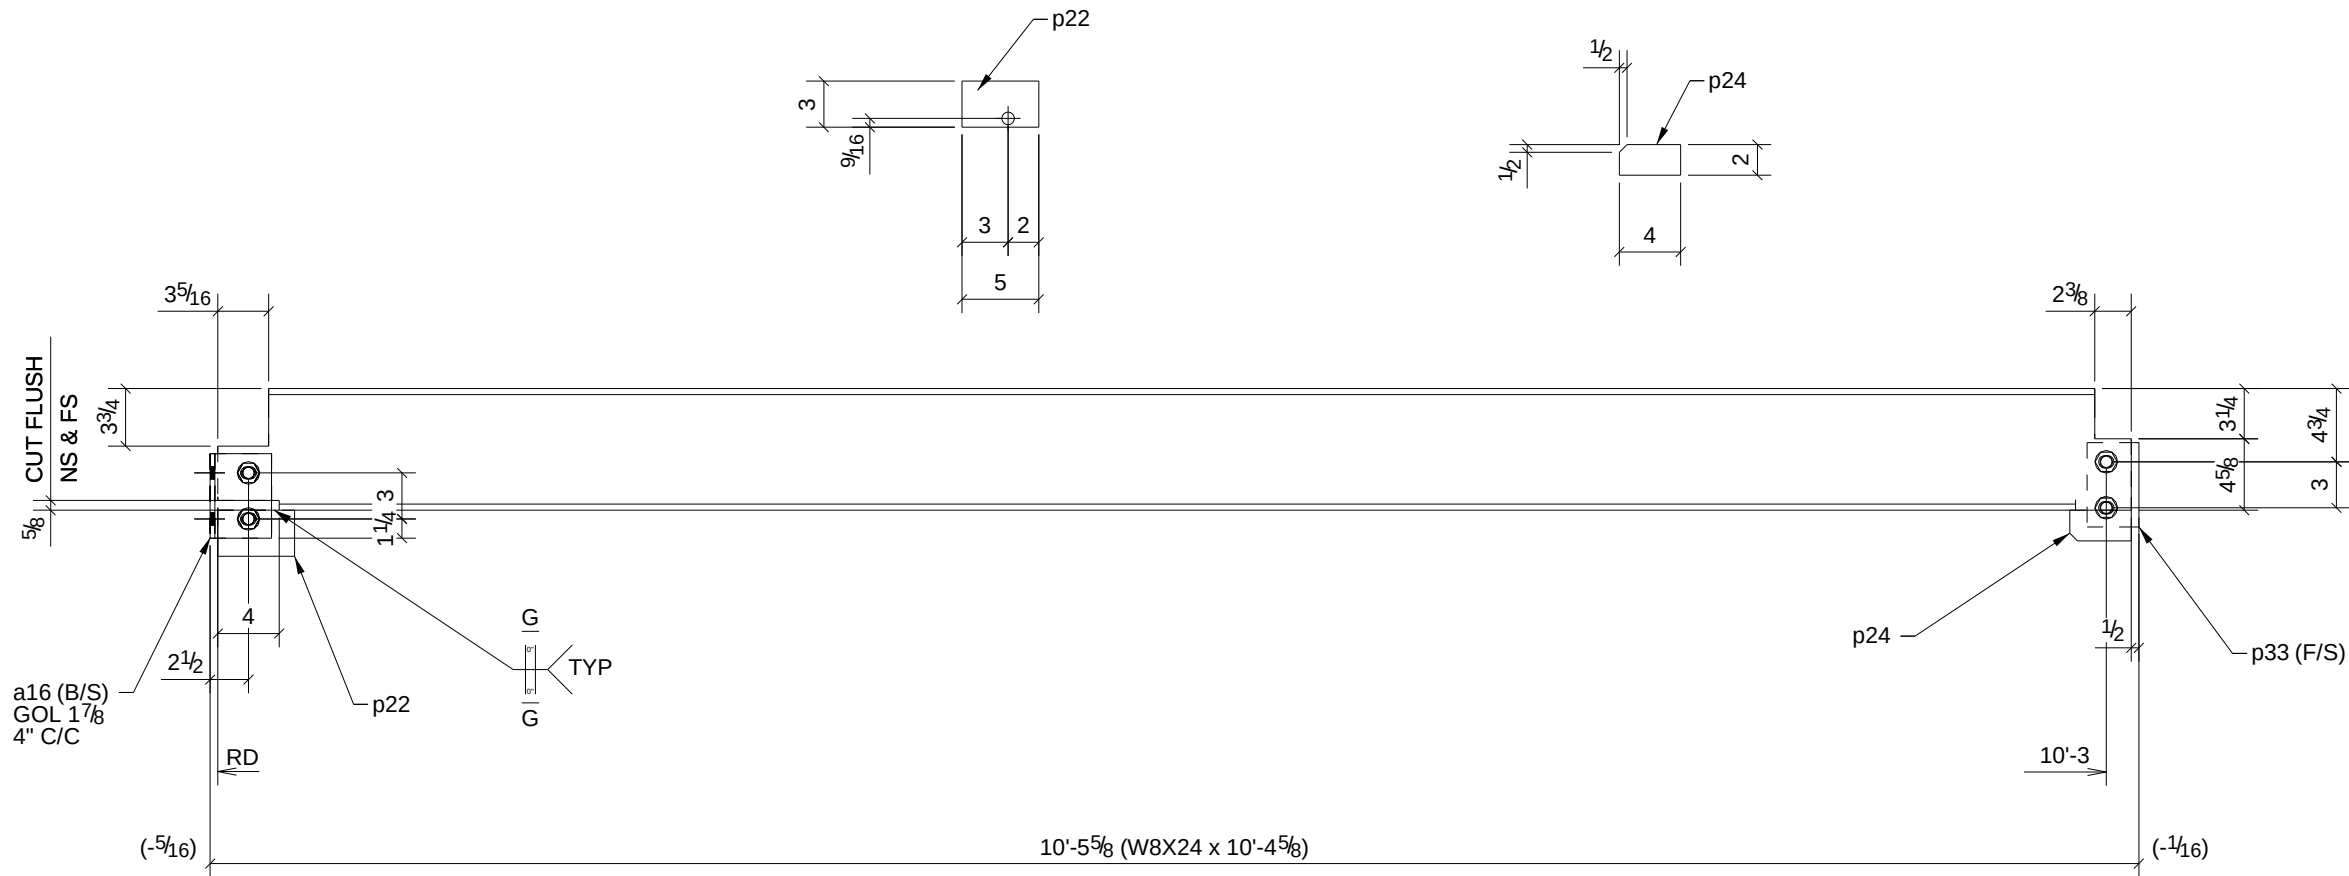

ONE - BEAM - 15B37


PHASE				
1	2	3	4	5
1	0	0	0	0

W	7 15/16" x 1/4"
F	6 1/2" x 3/8"

BILL OF MATERIAL

SHIP	MARK	NO PCS	DESCRIPTION	LENGTH	PIECE MARK	REMARKS
1	15B37	1	W8X24	10'-4 5/8"		SQ-2 A992
		2	L4X3-1/2X5/16	0'-5 1/2"	a16	A36
		1	BAR1/4"X3"	0'-5"	p22	A36
		1	BAR1/4"X2"	0'-4"	p24	A36
		1	PL3/8"X3 3/8"	0'-5 1/2"	p33	A36
		2	3/4"Ø A325N BOLT	0'-2"		
		2	3/4"Ø A325N BOLT	0'-1 3/4"		

A	For Approval & Field Survey	8/30/10	TMc	TAN
0	For Fabrication & F&F	9/15/10	TMc	TAN
REV.	DESCRIPTION	DATE	DWN	CHK
GENERAL NOTES		JOB USE		
MATERIAL: A992 / A36	ELECTRODES: E70XX LH	REF. DRG.	SHOP	
HOLES: 13/16 DIA. U/N	CONN'S.: -		APPROVAL	
SURFACE PREP. SSPC-SP-2				
AND PAINT: GREY PRIMER DEVOE NA-195 (U.N.)				
DESCRIPTION: BEAM				
PROJECT NAME Hamilton High School Phase III				
LOCATION Hamilton City School District - Hamilton				
CONTRACTOR GC Contracting				
	Avenue Fabricating Inc. 1281 Clough Pike Batavia, OH 45103 (513) 752-1911	DRAWN BY TMc	DATE 09/01/2010	
		CHKD. BY TAN	DATE	
		JOB No. 10-16	DRG. No. 15B37	REV. 3

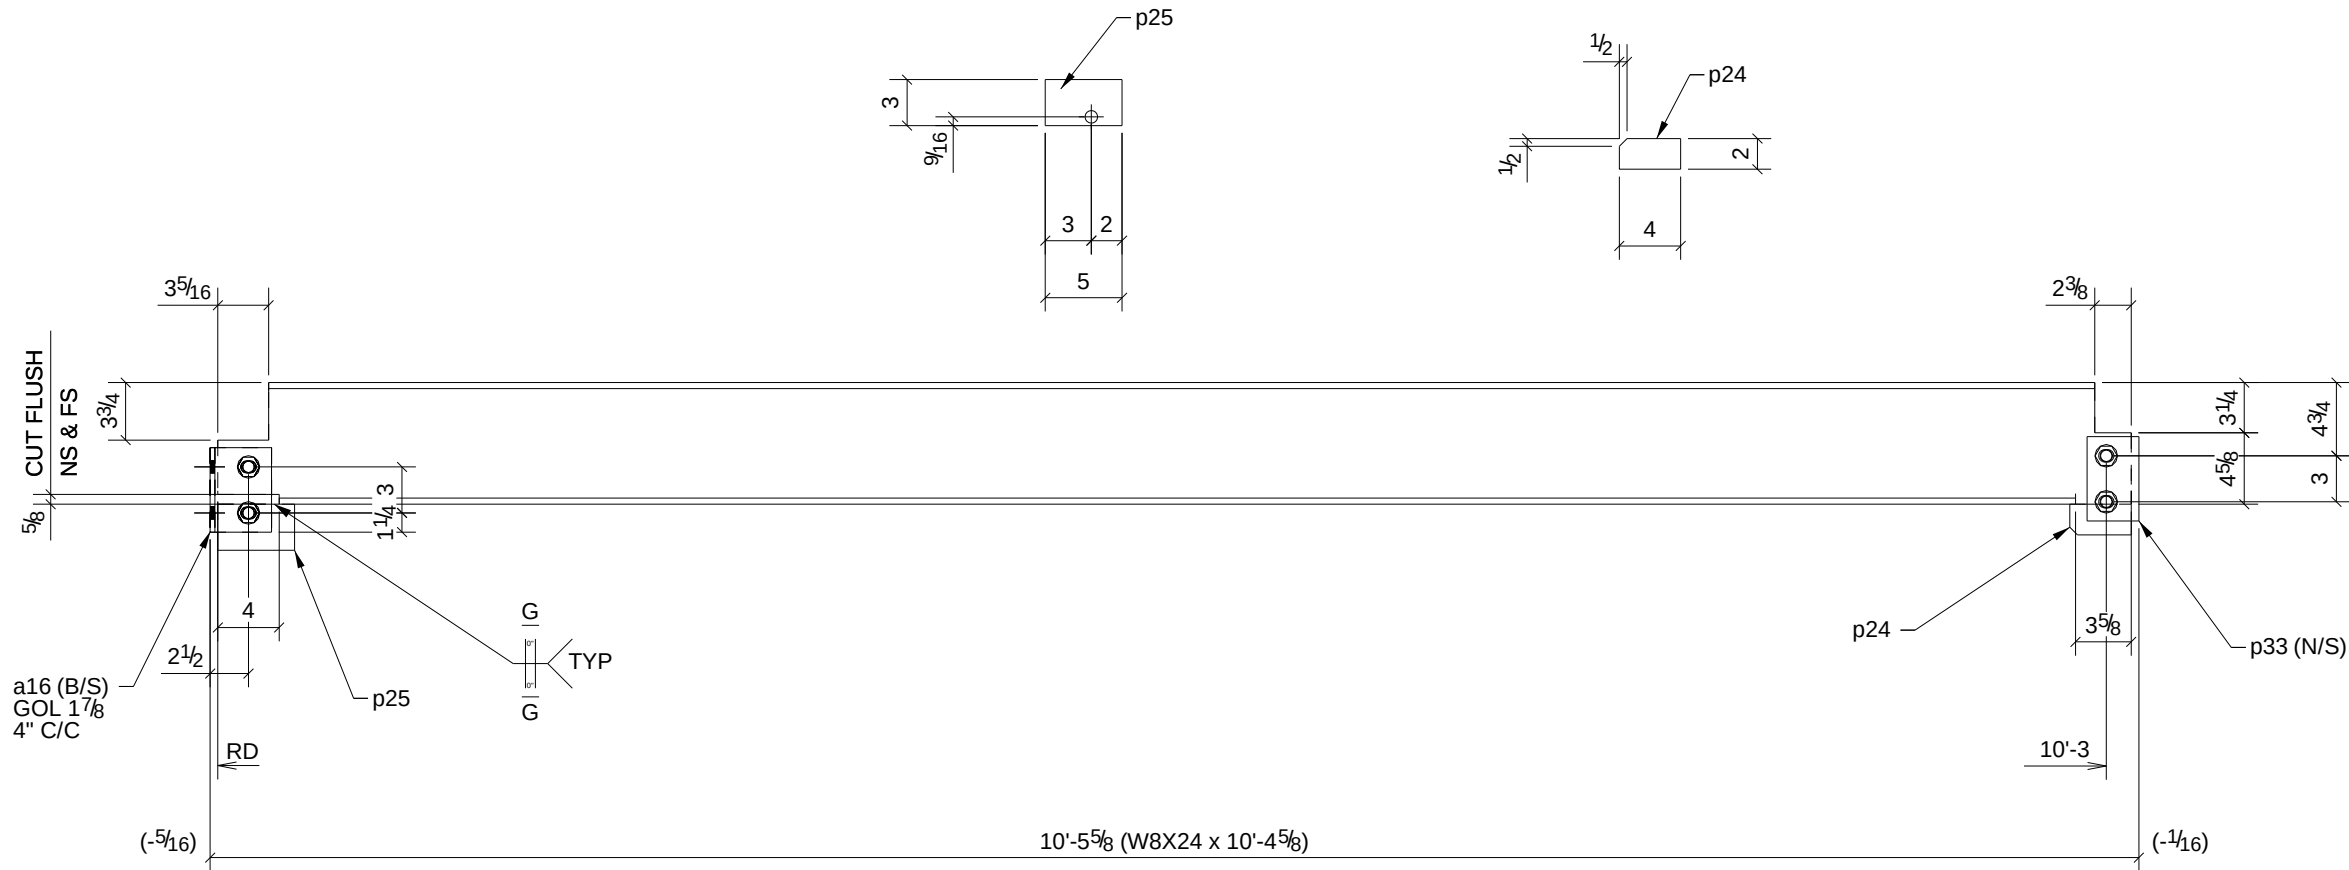

ONE - BEAM - 15B38


PHASE				
1	2	3	4	5
1	0	0	0	0

W	7 15/16" x 1/4"
F	6 1/2" x 3/8"

BILL OF MATERIAL

SHIP	MARK	NO PCS	DESCRIPTION	LENGTH	PIECE MARK	REMARKS
1	15B38	1	W8X24	10'-4 5/8"		SQ-2 A992
		2	L4X3-1/2X5/16	0'-5 1/2"	a16	A36
		1	BAR1/4"X2"	0'-4"	p24	A36
		1	BAR1/4"X3"	0'-5"	p25	A36
		1	PL3/8"X3 3/8"	0'-5 1/2"	p33	A36
		2	3/4"Ø A325N BOLT	0'-2"		
		2	3/4"Ø A325N BOLT	0'-1 3/4"		


A	For Approval & Field Survey		8/30/10	TMc	TAN
0	For Fabrication & F&F		9/15/10	TMc	TAN
REV.	DESCRIPTION		DATE	DWN	CHK
GENERAL NOTES			JOB USE		
MATERIAL: A992 / A36		ELECTRODES: E70XX LH	REF. DRG.		
HOLES: 13/16 DIA. U/N		CONN'S.: -		SHOP	
SURFACE PREP. SSPC-SP-2			APPROVAL		
AND PAINT: GREY PRIMER DEVOE NA-195 (U.N.)					
DESCRIPTION: BEAM					
PROJECT NAME Hamilton High School Phase III					
LOCATION Hamilton City School District - Hamilton					
CONTRACTOR GC Contracting					
	Avenue Fabricating Inc. 1281 Clough Pike Batavia, OH 45103 (513) 752-1911		DRAWN BY TMc	DATE 09/01/2010	
			CHKD. BY TAN	DATE	
			JOB No. 10-16	DRG. No. 15B38	REV. 4

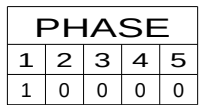

W	16" x 1/4"
F	7" x 1/2"

A	For Approval & Field Survey	8/30/10	TMc	TAN
0	For Fabrication & F&F	9/15/10	TMc	TAN
REV.	DESCRIPTION	DATE	DWN	CHK
GENERAL NOTES		JOB USE		
MATERIAL: A992 / A36	ELECTRODES: E70XX LH	REF. DRG.		
HOLES: 13/16 DIA. U/N	CONN'S.: -			
SURFACE PREP. SSPC-SP-2		APPROVAL		
AND PAINT: GREY PRIMER DEVOE NA-195 (U.N,)				
DESCRIPTION: BEAM				
PROJECT NAME		Hamilton High School Phase III		
LOCATION		Hamilton City School District - Hamilton		
CONTRACTOR		GC Contracting		
	Avenue Fabricating Inc. 1281 Clough Pike Batavia, OH 45103 (513) 752-1911	DRAWN BY TMC	DATE 08/30/2010	
		CHKD. BY TAN	DATE	
		JOB No. 10-16	DRG. No. 15B4	REV. 2

A	For Approval & Field Survey		8/30/10	TMc	TAN
0	For Fabrication & F&F		9/15/10	TMc	TAN
REV.	DESCRIPTION		DATE	DWN	CHK
GENERAL NOTES			JOB USE		
MATERIAL: A992 / A36		ELECTRODES: E70XX LH	REF. DRG.		
HOLES: 13/16 DIA. U/N		CONN'S.: -		SHOP	
SURFACE PREP. SSPC-SP-2			APPROVAL		
AND PAINT: GREY PRIMER DEVOE NA-195 (U.N.)					
DESCRIPTION: BEAM					
PROJECT NAME Hamilton High School Phase III					
LOCATION Hamilton City School District - Hamilton					
CONTRACTOR GC Contracting					
	Avenue Fabricating Inc. 1281 Clough Pike Batavia, OH 45103 (513) 752-1911		DRAWN BY TMc		DATE 08/30/2010
			CHKD. BY TAN		DATE
			JOB No. 10-16		DRG. No. 15B6

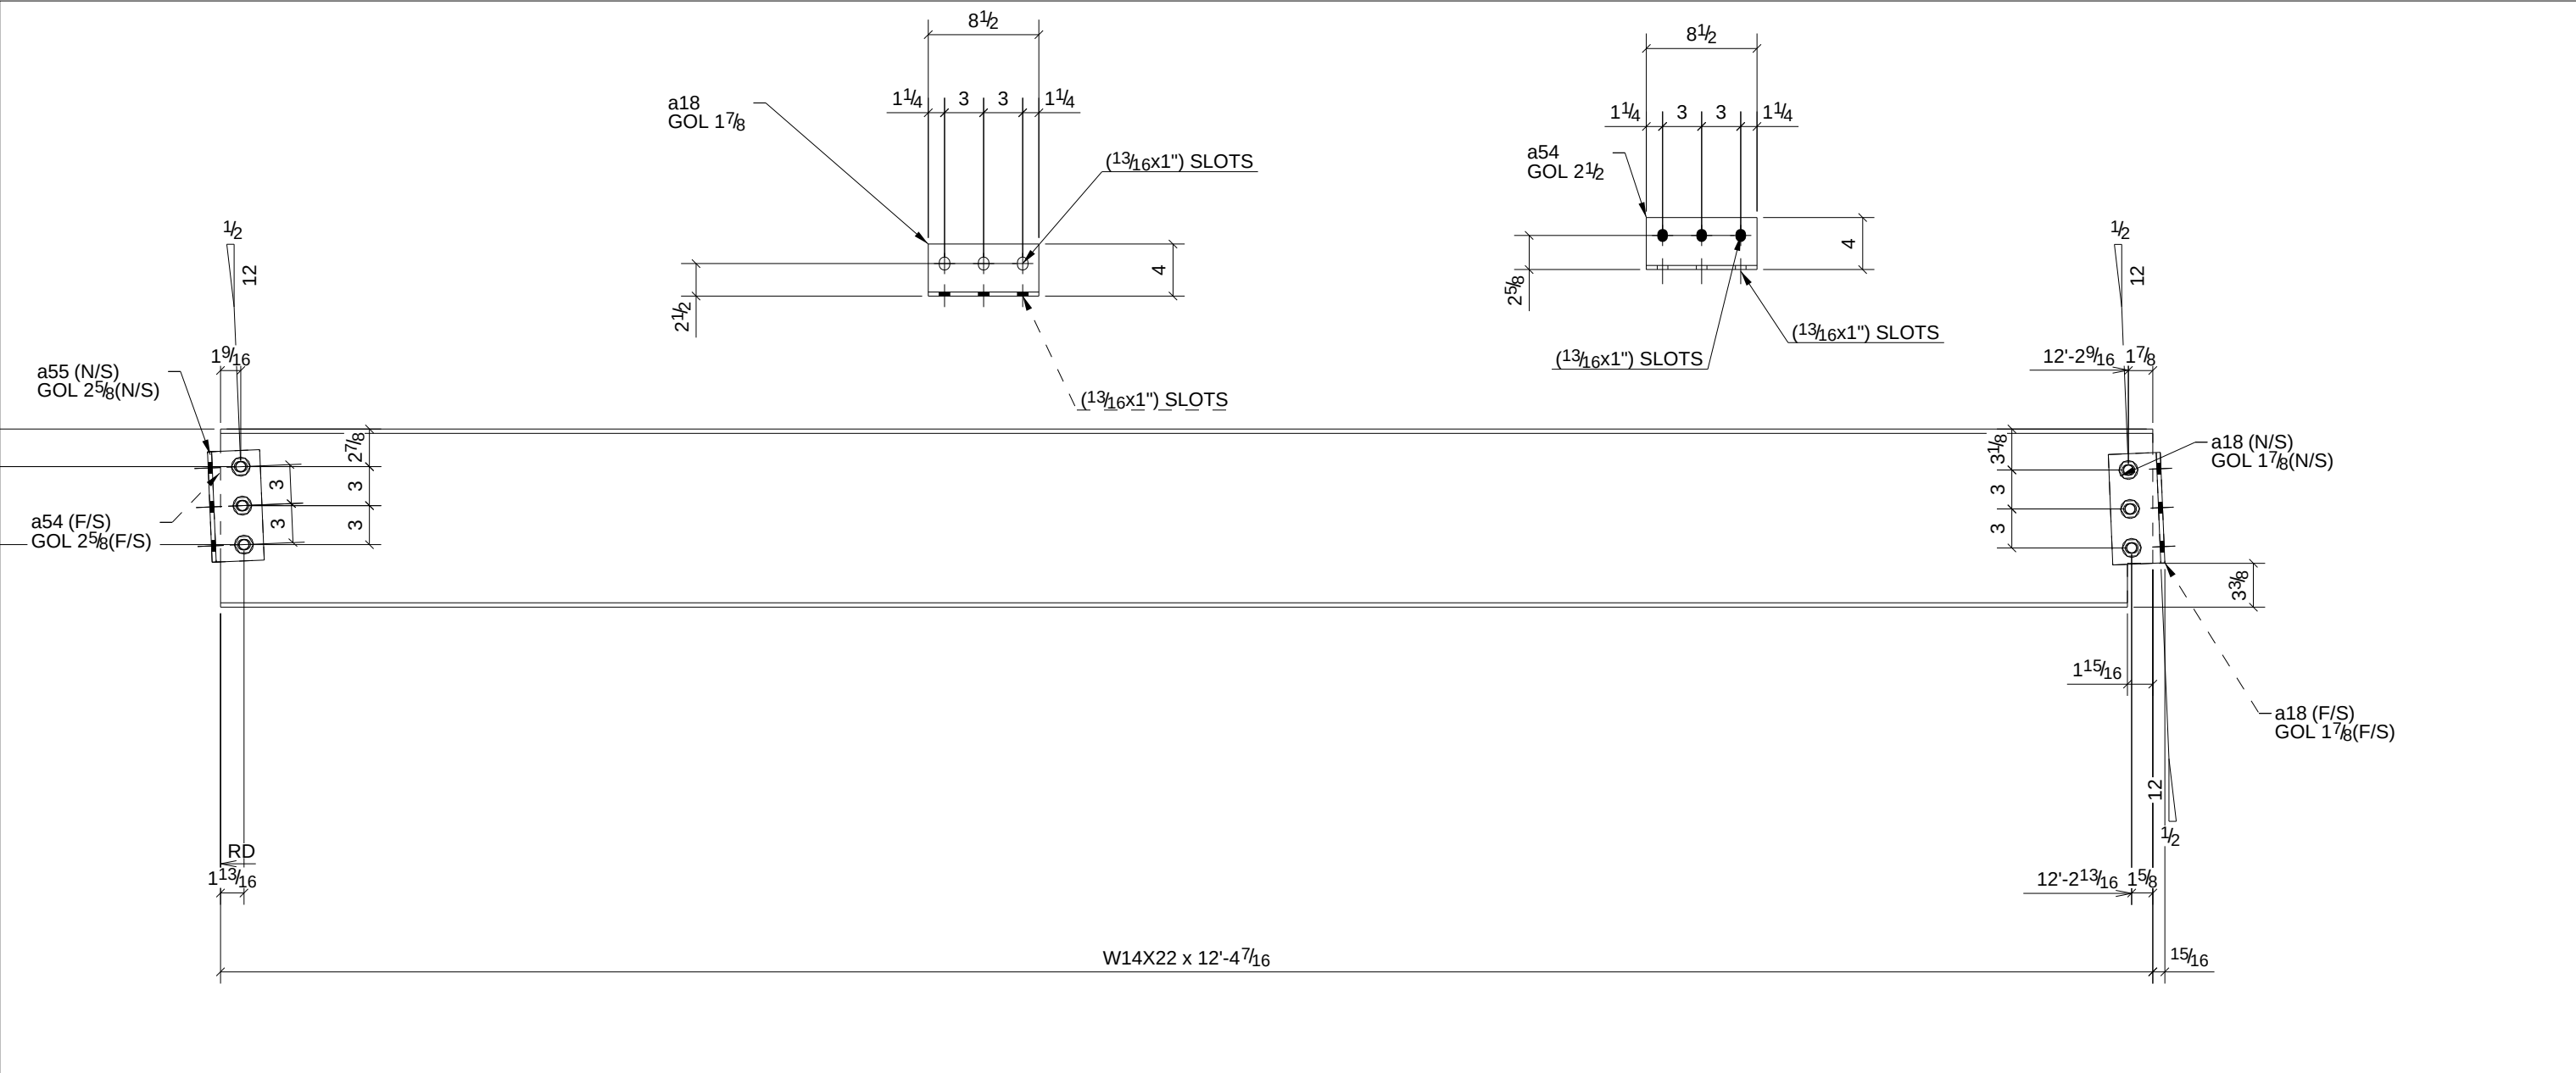

2 - BEAMS - 15B7


PHASE				
1	2	3	4	5
2	0	0	0	0

W	13 11/16"x 1/4"
F	5"x 5/16"

A	For Approval & Field Survey		8/30/10	TMc	TAN
0	For Fabrication & F&F		9/15/10	TMc	TAN
REV.	DESCRIPTION		DATE	DWN	CHK
GENERAL NOTES			JOB USE		
MATERIAL: A992 / A36		ELECTRODES: E70XX LH	REF. DRG.		
HOLES: 13/16 DIA. U/N		CONN'S.: -		SHOP	
SURFACE PREP. SSPC-SP-2			APPROVAL		
AND PAINT: GREY PRIMER DEVOE NA-195 (U.N.)					
DESCRIPTION: BEAM					
PROJECT NAME		Hamilton High School Phase III			
LOCATION		Hamilton City School District - Hamilton			
CONTRACTOR		GC Contracting			
	Avenue Fabricating Inc. 1281 Clough Pike Batavia, OH 45103 (513) 752-1911		DRAWN BY TMc	DATE 09/01/2010	
			CHKD. BY TAN	DATE	
			JOB No. 10-16	DRG. No. 15B7	REV. 2

BILL OF MATERIAL

SHIP	MARK	NO PCS	DESCRIPTION	LENGTH	PIECE MARK	REMARKS
2	15B7	2	W14X22	12'-4 7/16"		SQ-2 A992
		4	L4X3-1/2X5/16	0'-8 1/2"	a18	A36
		2	L4X4X5/16	0'-8 1/2"	a54	A36
		2	L4X4X5/16	0'-8 1/2"	a55	A36
		6	3/4"Ø A325N BOLT	0'-2"		

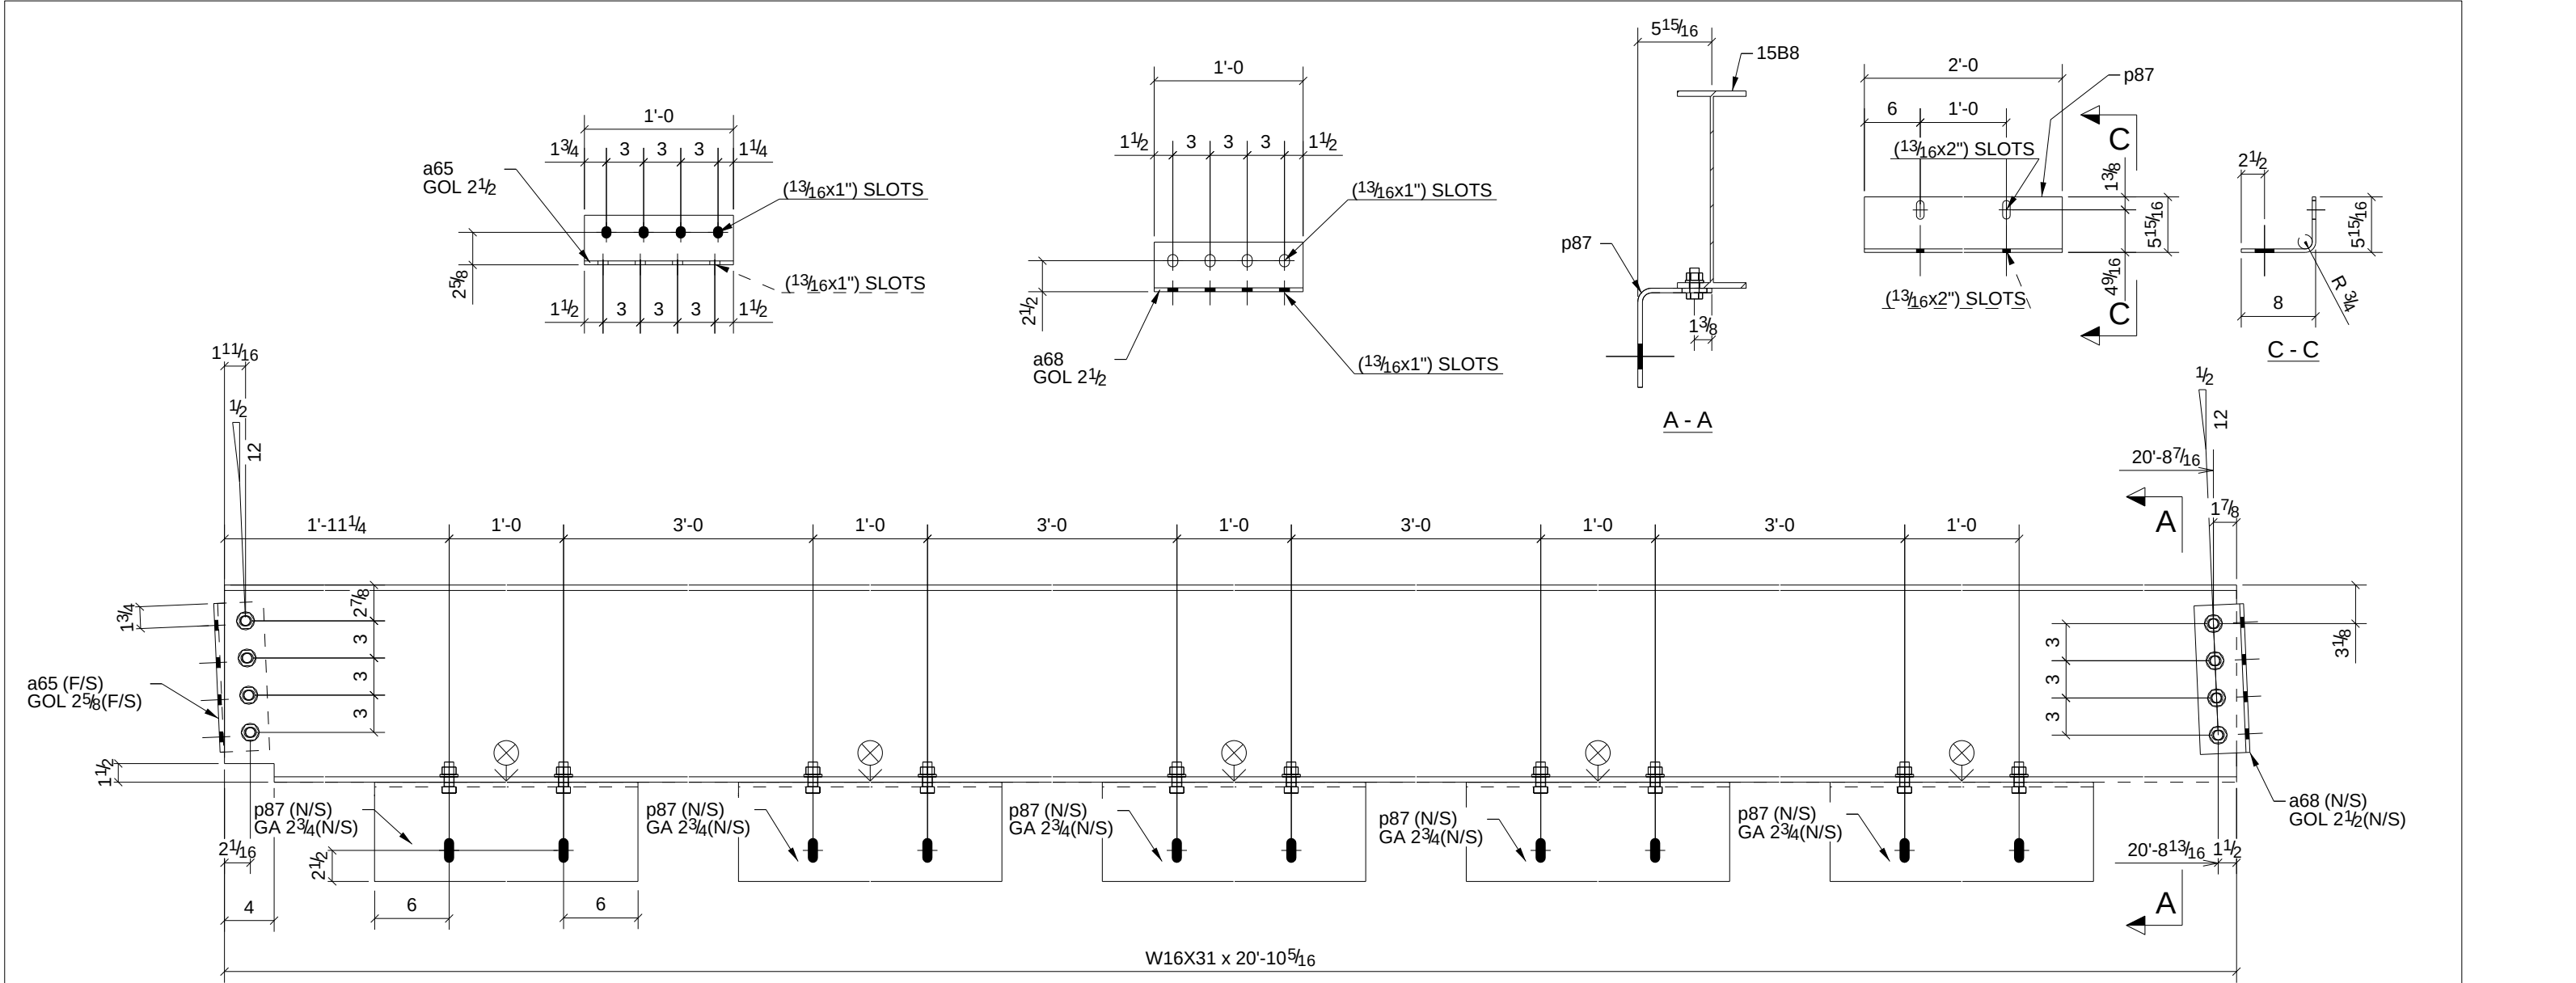


ONE - BEAM - 15B8

PHASE				
1	2	3	4	5
1	0	0	0	0

W	15 7/8" x 1/4"
F	5 1/2" x 7/16"

BILL OF MATERIAL						
SHIP	MARK	NO PCS	DESCRIPTION	LENGTH	PIECE MARK	REMARKS
1	15B8	1	W16X31	20'-10 5/16"		SQ-2 A992
		1	L4X4X5/16	1'-0"	a65	A36
		1	L4X4X5/16	1'-0"	a68	A36
		5	PL3/8"X13 3/16"	2'-0"	p87	A36
		10	3/4"Ø A307 BOLT	0'-2"		
		8	3/4"Ø A325N BOLT	0'-1 3/4"		

A	For Approval & Field Survey		8/30/10	TMc	TAN
0	For Fabrication & F&F		9/15/10	TMc	TAN
REV.	DESCRIPTION		DATE	DWN	CHK
GENERAL NOTES			JOB USE		
MATERIAL: A992 / A36		ELECTRODES: E70XX LH	REF. DRG.	SHOP	
HOLES: 13/16 DIA. U/N		CONN'S.: -			
SURFACE PREP. SSPC-SP-2			APPROVAL		
AND PAINT: GREY PRIMER DEVOE NA-195 (U.N.)					
DESCRIPTION: BEAM					
PROJECT NAME Hamilton High School Phase III					
LOCATION Hamilton City School District - Hamilton					
CONTRACTOR GC Contracting					
	Avenue Fabricating Inc. 1281 Clough Pike Batavia, OH 45103 (513) 752-1911		DRAWN BY TMc	DATE 08/30/2010	
			CHKD. BY TAN	DATE	
			JOB No. 10-16	DRG. No. 15B8	REV. 2

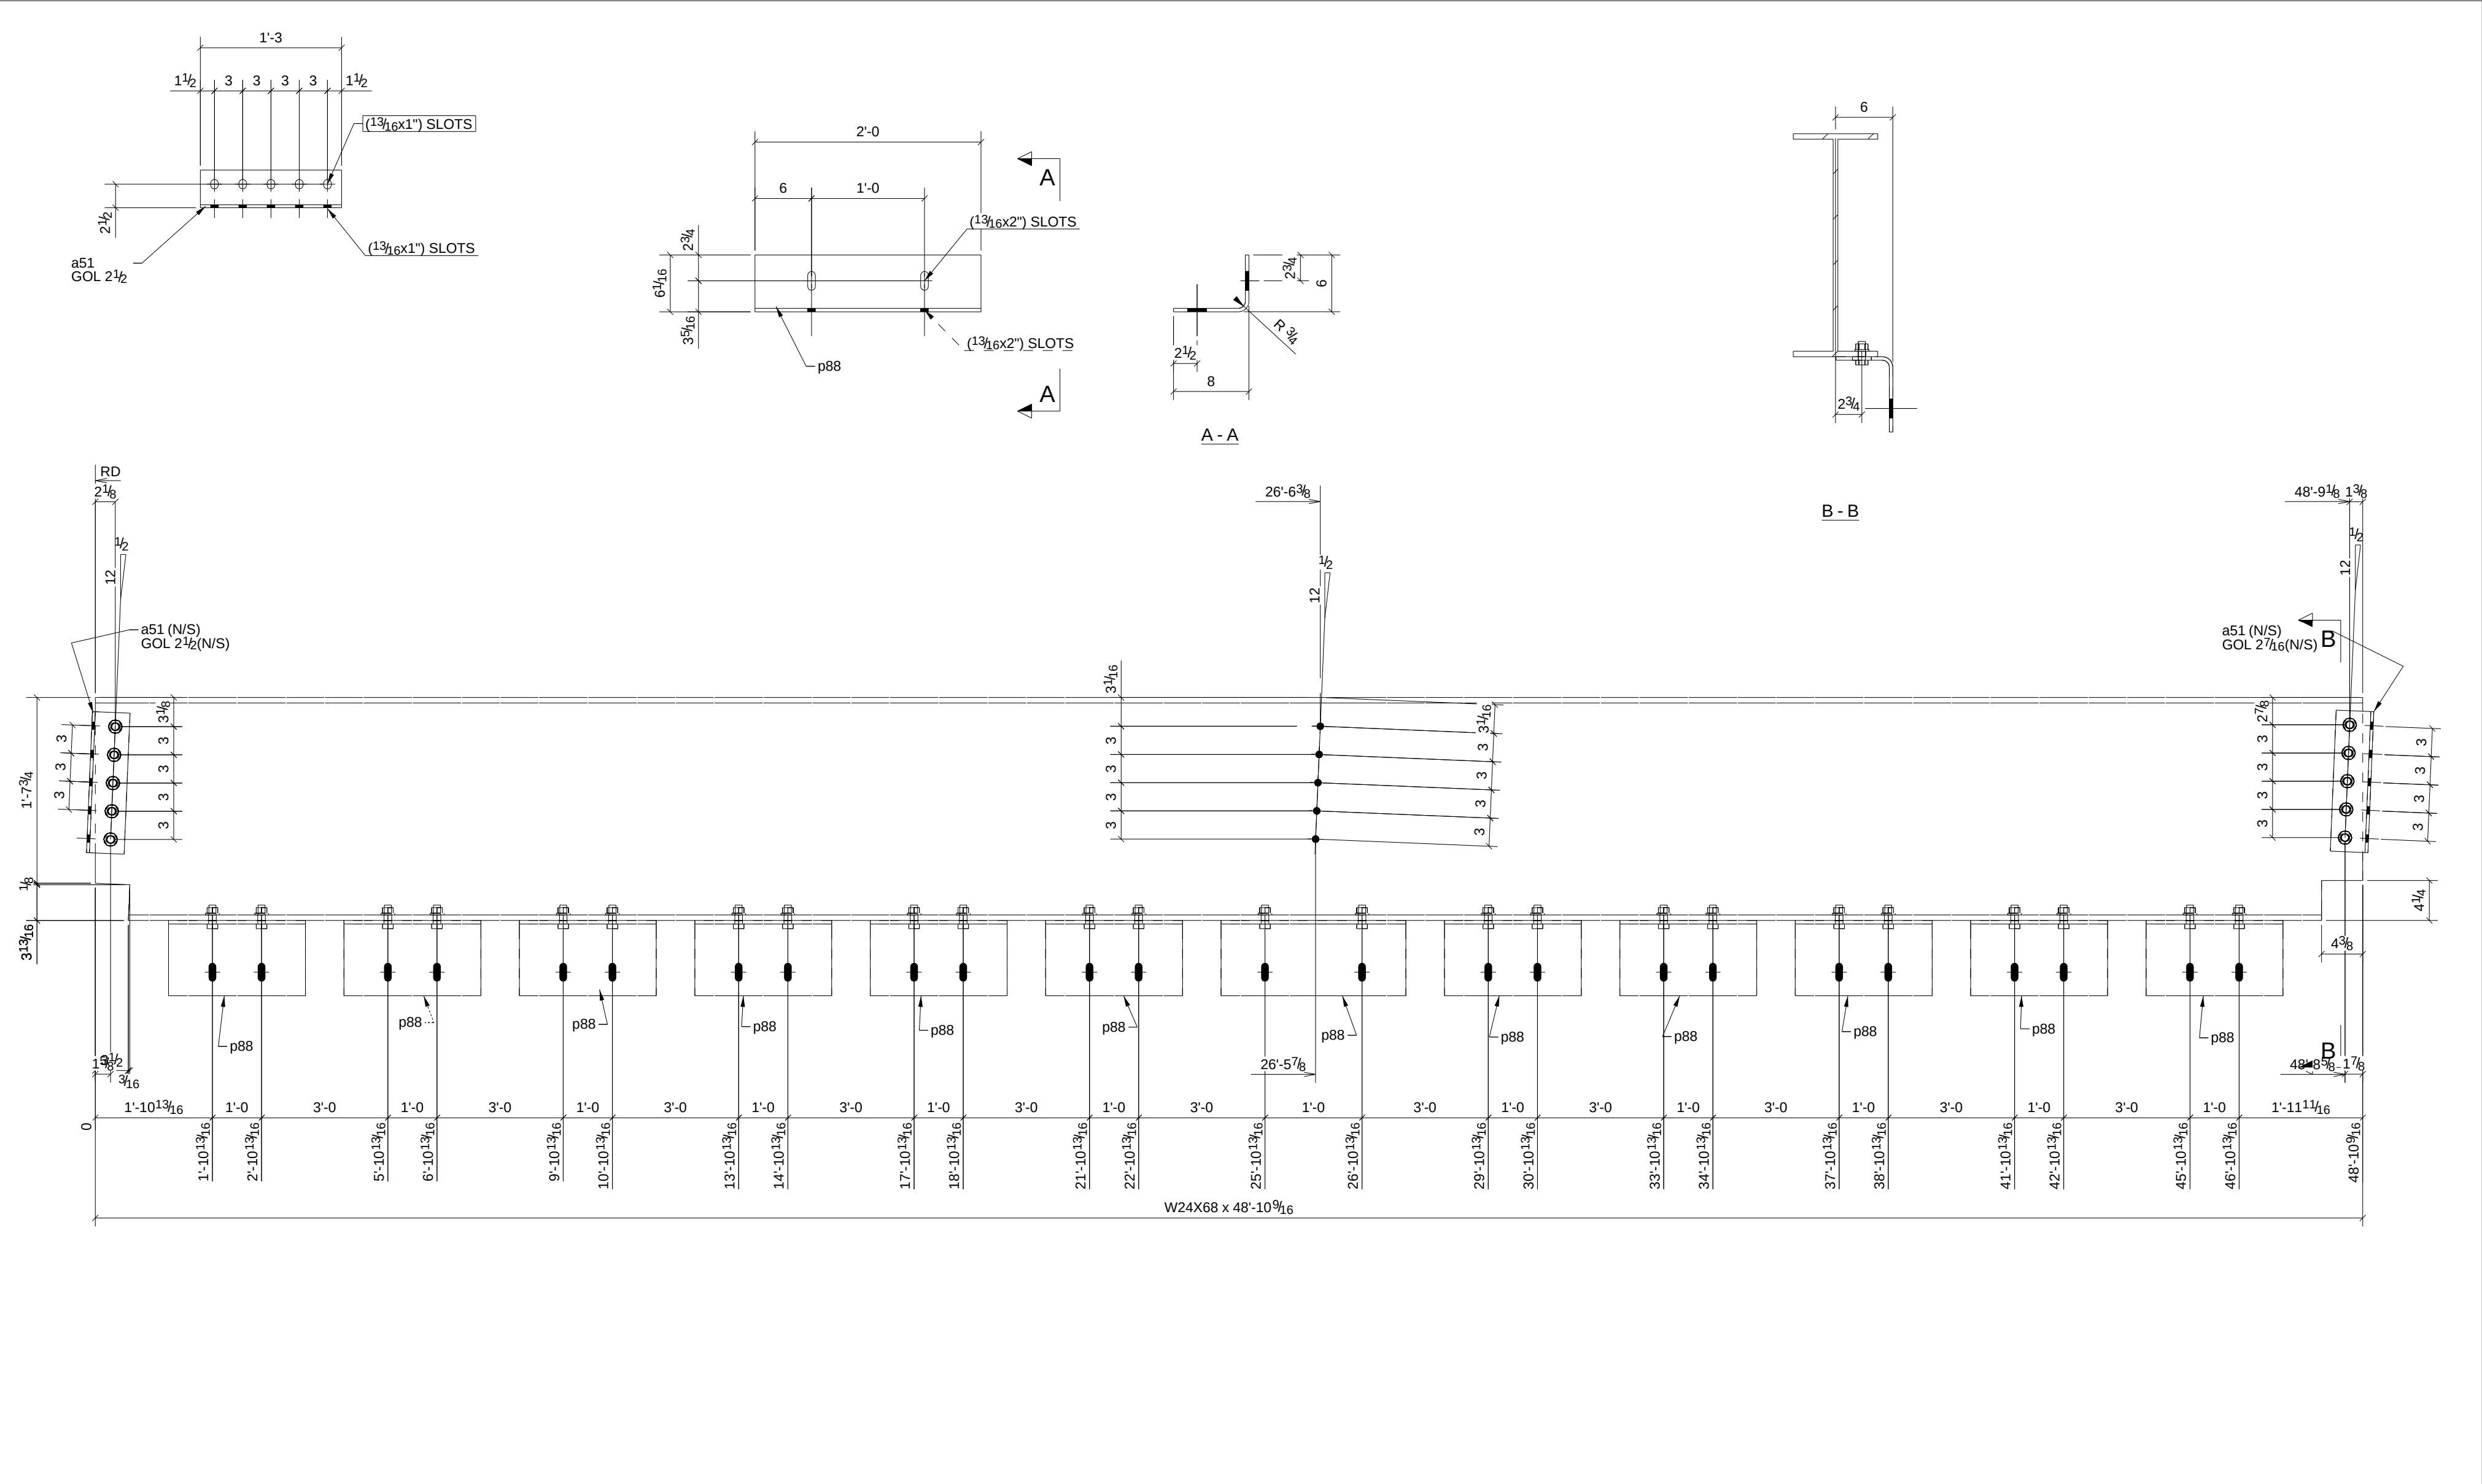


PHASE				
1	2	3	4	5
1	0	0	0	0

ONE - BEAM - 15B9

W 23 11/16"x7/16"
F 9"x9/16"

BILL OF MATERIAL						
SHIP	MARK	NO PCS	DESCRIPTION	LENGTH	PIECE MARK	REMARKS
1	15B9	1	W24X68	48'-10 9/16"		SQ-2 A992
		2	L4X4X5/16	1'-3"	a51	A36
		12	PL3/8"X13 1/4"	2'-0"	p88	A36
		24	3/4"Ø A307 BOLT	0'-2"		
		10	3/4"Ø A325N BOLT	0'-2"		

A	For Approval & Field Survey		8/30/10	TMc	TAN
0	For Fabrication & F&F		9/15/10	TMc	TAN
REV.	DESCRIPTION		DATE	DWN	CHK
GENERAL NOTES			JOB USE		
MATERIAL: A992 / A36		ELECTRODES: E70XX LH	REF. DRG.		
HOLES: 13/16 DIA. U/N		CONN'S.: -		SHOP	
SURFACE PREP: SSPC-SP-2			APPROVAL		
AND PAINT: GREY PRIMER DEVOE NA-195 (U.N.)					
DESCRIPTION: BEAM					
PROJECT NAME		Hamilton High School Phase III			
LOCATION		Hamilton City School District - Hamilton			
CONTRACTOR		GC Contracting			
		DRAWN BY		DATE	
		TMc		08/30/2010	
		CHKD. BY		DATE	
		TAN			
		JOB No.	DRG. No.	REV.	
		10-16	15B9	2	

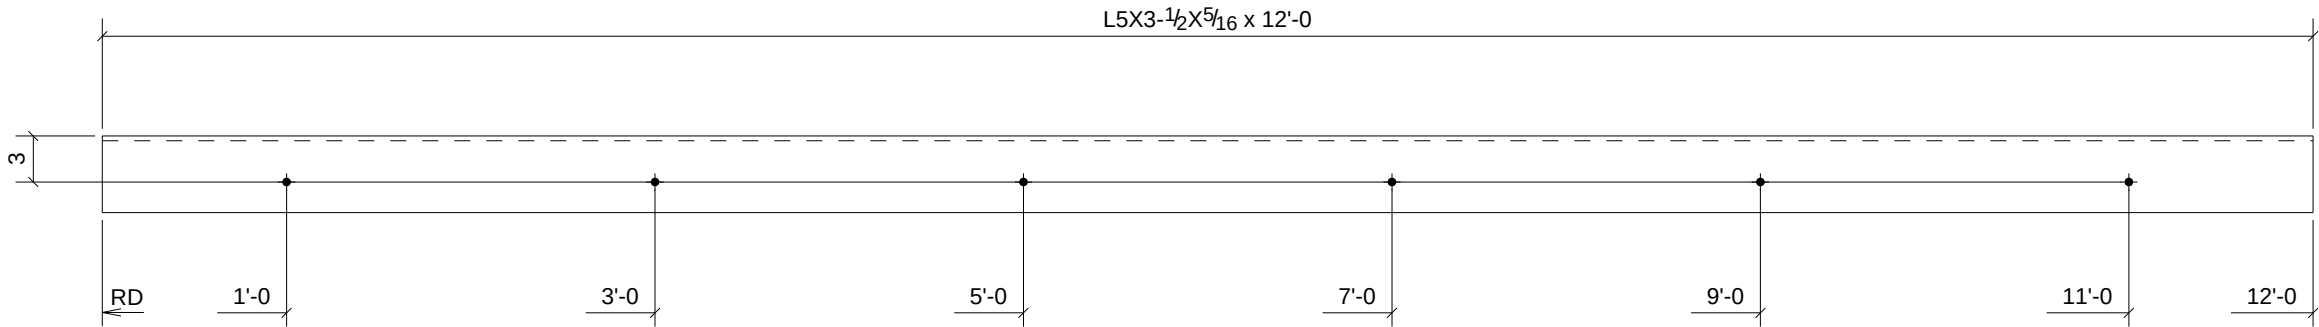

PHASE					
1	2	3	4	5	
6	0	0	0	0	

6 - ANGLES - 17A1

BILL OF MATERIAL						
SHIP	MARK	NO PCS	DESCRIPTION	LENGTH	PIECE MARK	REMARKS
6	17A1	6	L5X3-1/2X5/16	12'-0"		SQ-2 A36


A	For Approval & Field Survey		8/30/10	TMc	TAN
0	For Fabrication & F&F		9/15/10	TMc	TAN
REV.	DESCRIPTION		DATE	DWN	CHK
GENERAL NOTES			JOB USE		
MATERIAL: A992 / A36		ELECTRODES: E70XX LH	REF. DRG.		
HOLES: 13/16 DIA. U/N		CONN'S.: -		SHOP	
SURFACE PREP. SSPC-SP-2			APPROVAL		
AND PAINT: GREY PRIMER DEVOE NA-195 (U.N.)					
DESCRIPTION: ANGLE					
PROJECT NAME		Hamilton High School Phase III			
LOCATION		Hamilton City School District - Hamilton			
CONTRACTOR		GC Contracting			
	Avenue Fabricating Inc. 1281 Clough Pike Batavia, OH 45103 (513) 752-1911		DRAWN BY TMc		DATE 08/20/2010
			CHKD. BY TAN		DATE
			JOB No. 10-16		DRG. No. 17A1

PHASE				
1	2	3	4	5
2	0	0	0	0

2 - ANGLES - 17A11

A	For Approval & Field Survey			8/30/10	TMc	TAN
0	For Fabrication & F&F			9/15/10	TMc	TAN
REV.	DESCRIPTION			DATE	DWN	CHK
GENERAL NOTES				JOB USE		
MATERIAL: A992 / A36		ELECTRODES: E70XX LH	REF. DRG.	SHOP		
HOLES: 13/16 DIA. U/N		CONN'S.: -				
SURFACE PREP. SSPC-SP-2				APPROVAL		
AND PAINT: GREY PRIMER DEVOE NA-195 (U.N,)						
DESCRIPTION: ANGLE						
PROJECT NAME		Hamilton High School Phase III				
LOCATION		Hamilton City School District - Hamilton				
CONTRACTOR		GC Contracting				
		Avenue Fabricating Inc. 1281 Clough Pike Batavia, OH 45103 (513) 752-1911		DRAWN BY TMc		DATE 09/02/2010
				CHKD. BY TAN		DATE
				JOB No. 10-16		DRG. No. 17A11

BILL OF MATERIAL						
SHIP	MARK	NO PCS	DESCRIPTION	LENGTH	PIECE MARK	REMARKS
2	17A11	2	L3X3X3/8	3'-9"		SQ-2 A36

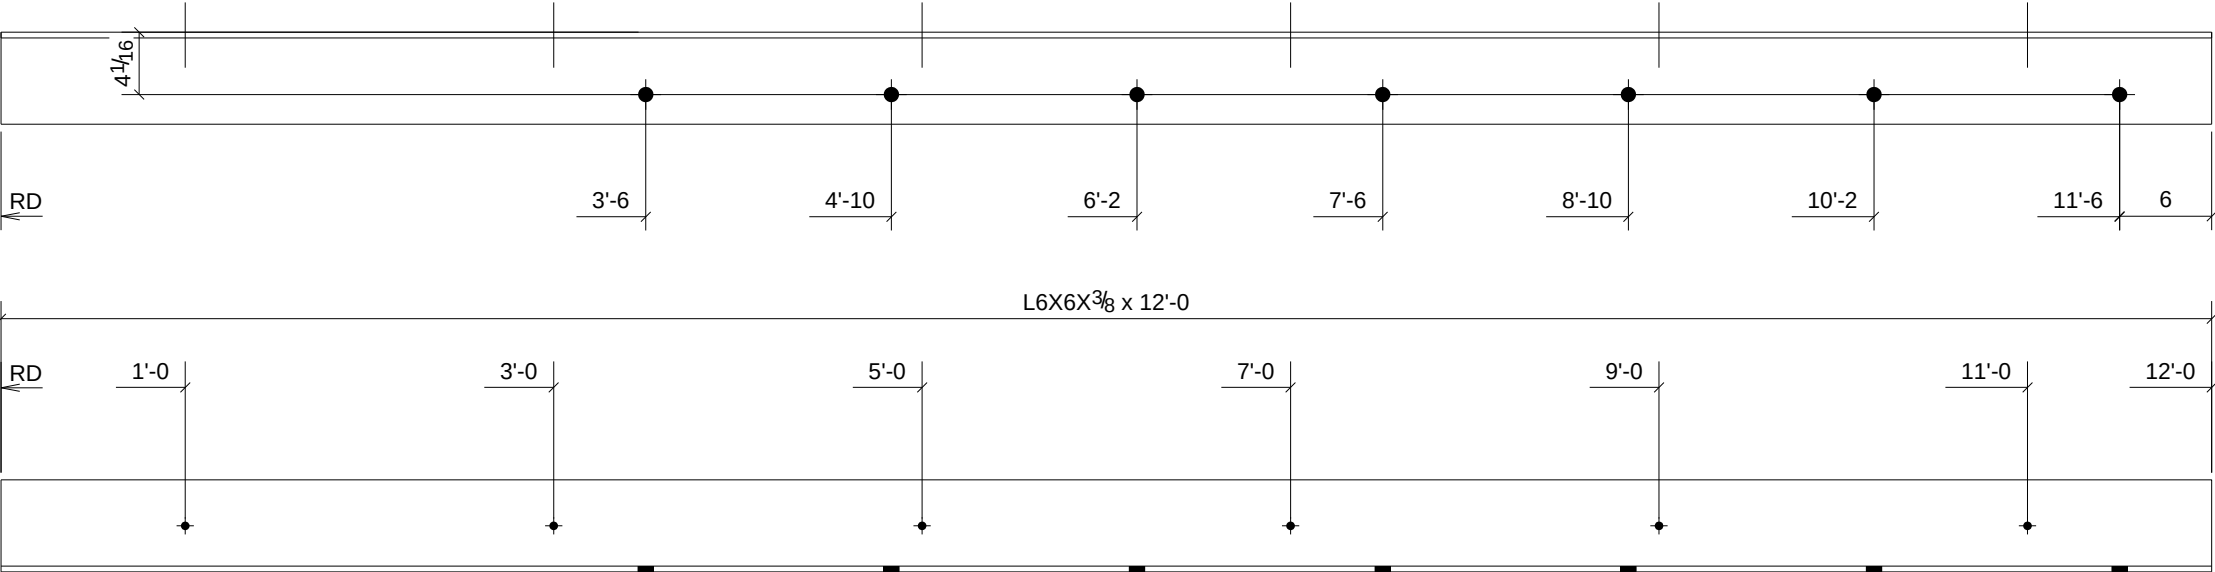


PHASE				
1	2	3	4	5
3	0	0	0	0

3 - ANGLES - 17A2

BILL OF MATERIAL						
SHIP	MARK	NO PCS	DESCRIPTION	LENGTH	PIECE MARK	REMARKS
3	17A2	3	L6X6X3/8	12'-0"		SQ-2 A36

A	For Approval & Field Survey		8/30/10	TMc	TAN
0	For Fabrication & F&F		9/15/10	TMc	TAN
REV.	DESCRIPTION		DATE	DWN	CHK
GENERAL NOTES			JOB USE		
MATERIAL: A992 / A36		ELECTRODES: E70XX LH	REF. DRG.		
HOLES: 13/16 DIA. U/N		CONN'S.: -		SHOP	
SURFACE PREP. SSPC-SP-2			APPROVAL		
AND PAINT: GREY PRIMER DEVOE NA-195 (U.N.)					
DESCRIPTION: ANGLE					
PROJECT NAME		Hamilton High School Phase III			
LOCATION		Hamilton City School District - Hamilton			
CONTRACTOR		GC Contracting			
	Avenue Fabricating Inc. 1281 Clough Pike Batavia, OH 45103 (513) 752-1911		DRAWN BY		DATE
			TMc		09/02/2010
			CHKD. BY		DATE
			TAN		
		JOB No.		DRG. No.	REV.
		10-16		17A2	2


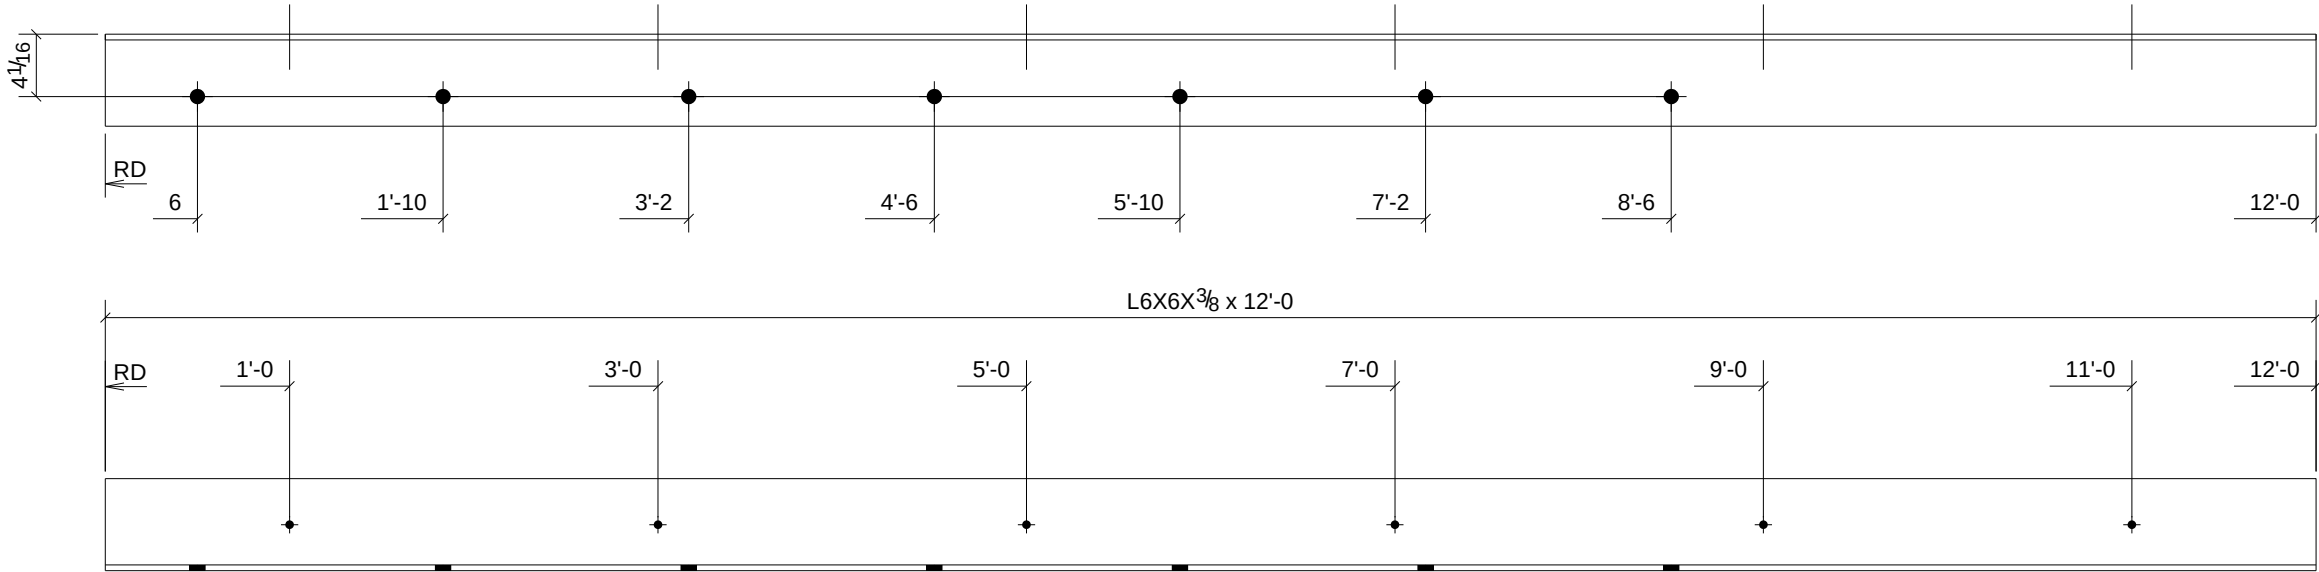


PHASE					
1	2	3	4	5	
3	0	0	0	0	

3 - ANGLES - 17A3

BILL OF MATERIAL						
SHIP	MARK	NO PCS	DESCRIPTION	LENGTH	PIECE MARK	REMARKS
3	17A3	3	L6X6X3/8	12'-0"		SQ-2 A36

A	For Approval & Field Survey		8/30/10	TMc	TAN
0	For Fabrication & F&F		9/15/10	TMc	TAN
REV.	DESCRIPTION		DATE	DWN	CHK
GENERAL NOTES			JOB USE		
			MATERIAL: A992 / A36	ELECTRODES: E70XX LH	REF. DRG.
HOLES: 13/16 DIA. U/N	CONN'S.: -				
SURFACE PREP. SSPC-SP-2			APPROVAL		
AND PAINT: GREY PRIMER DEVOE NA-195 (U.N.)					
DESCRIPTION: ANGLE					
PROJECT NAME		Hamilton High School Phase III			
LOCATION		Hamilton City School District - Hamilton			
CONTRACTOR		GC Contracting			
	Avenue Fabricating Inc. 1281 Clough Pike Batavia, OH 45103 (513) 752-1911		DRAWN BY TMc		DATE 09/02/2010
			CHKD. BY TAN		DATE
			JOB No. 10-16		DRG. No. 17A3

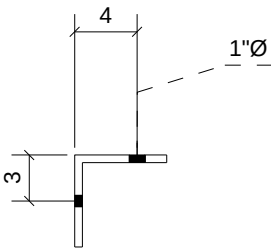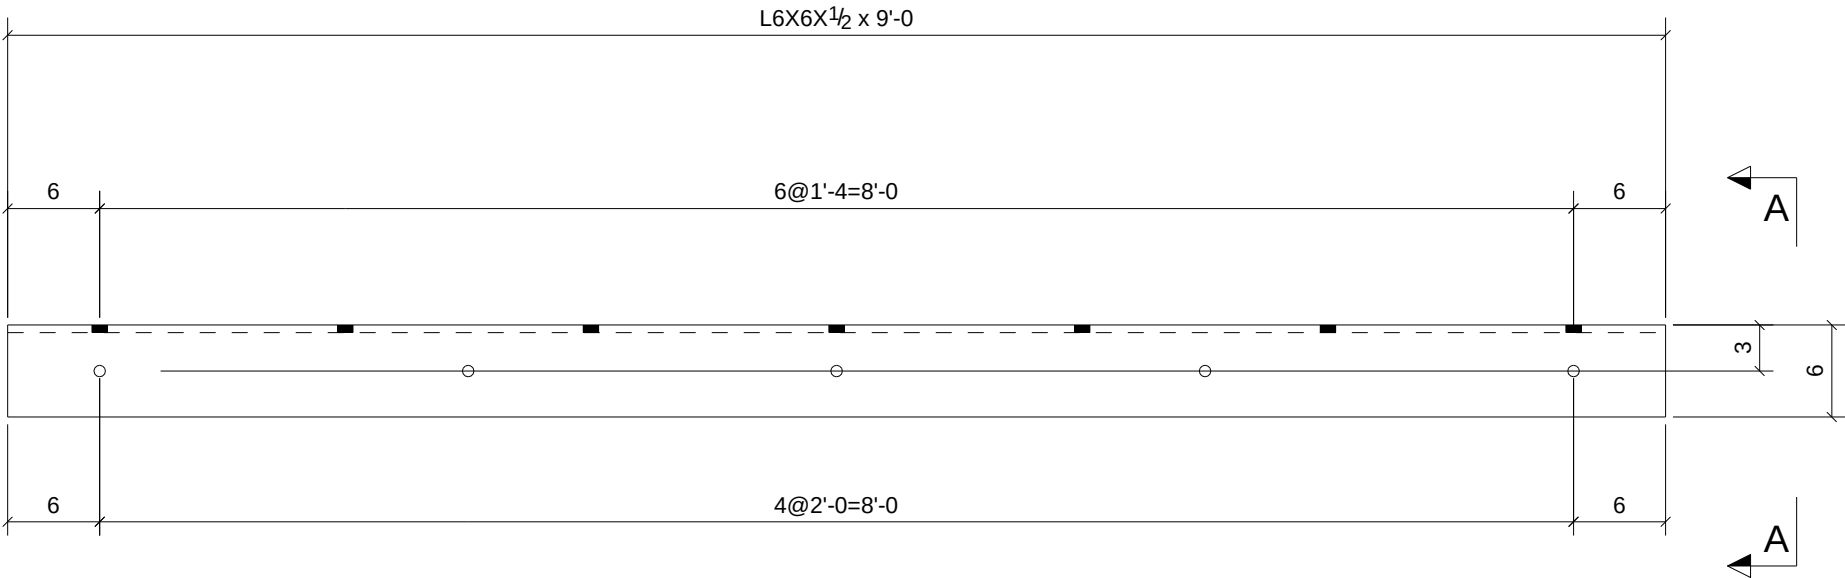


A - A

PHASE				
1	2	3	4	5
2	0	0	0	0

2 - ANGLES - 17A4

A	For Approval & Field Survey		8/30/10	TMc	TAN
0	For Fabrication & F&F		9/15/10	TMc	TAN
REV.	DESCRIPTION		DATE	DWN	CHK
GENERAL NOTES			JOB USE		
MATERIAL: A992 / A36		ELECTRODES: E70XX LH	REF. DRG.		
HOLES: 13/16 DIA. U/N		CONN'S.: -		SHOP	
SURFACE PREP. SSPC-SP-2			APPROVAL		
AND PAINT: GREY PRIMER DEVOE NA-195 (U.N.)					
DESCRIPTION: ANGLE					
PROJECT NAME		Hamilton High School Phase III			
LOCATION		Hamilton City School District - Hamilton			
CONTRACTOR		GC Contracting			
	Avenue Fabricating Inc. 1281 Clough Pike Batavia, OH 45103 (513) 752-1911		DRAWN BY TMc		DATE 08/30/2010
			CHKD. BY TAN		DATE
			JOB No. 10-16		DRG. No. 17A4

BILL OF MATERIAL						
SHIP	MARK	NO PCS	DESCRIPTION	LENGTH	PIECE MARK	REMARKS
2	17A4	2	L6X6X1/2	9'-0"		SQ-2 A36

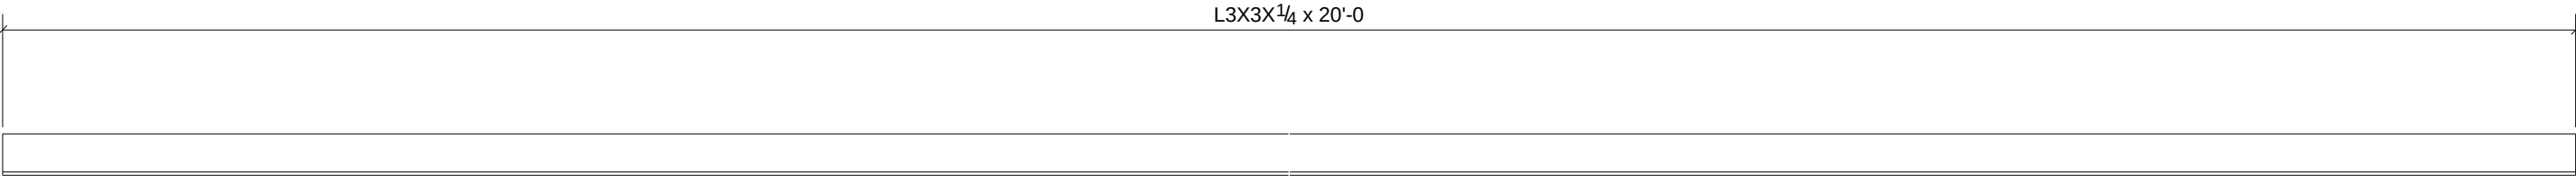


PHASE				
1	2	3	4	5
14	0	0	0	0

14 - ANGLES - 17A7

BILL OF MATERIAL						
SHIP	MARK	NO PCS	DESCRIPTION	LENGTH	PIECE MARK	REMARKS
14	17A7	14	L3X3X1/4	20'-0"		SQ-2 A36

A	For Approval & Field Survey		8/30/10	TMc	TAN
0	For Fabrication & F&F		9/15/10	TMc	TAN
REV.	DESCRIPTION		DATE	DWN	CHK
GENERAL NOTES			JOB USE		
MATERIAL: A992 / A36		ELECTRODES: E70XX LH	REF. DRG.		
HOLES: 13/16 DIA. U/N		CONN'S.: -		SHOP	
SURFACE PREP. SS-PC-SP-2			APPROVAL		
AND PAINT: GREY PRIMER DEVOE NA-195 (U.N,)					
DESCRIPTION: ANGLE					
PROJECT NAME		Hamilton High School Phase III			
LOCATION		Hamilton City School District - Hamilton			
CONTRACTOR		GC Contracting			
	Avenue Fabricating Inc. 1281 Clough Pike Batavia, OH 45103 (513) 752-1911		DRAWN BY TMc		DATE 09/02/2010
			CHKD. BY TAN		DATE
			JOB No. 10-16		DRG. No. 17A7 REV. 2

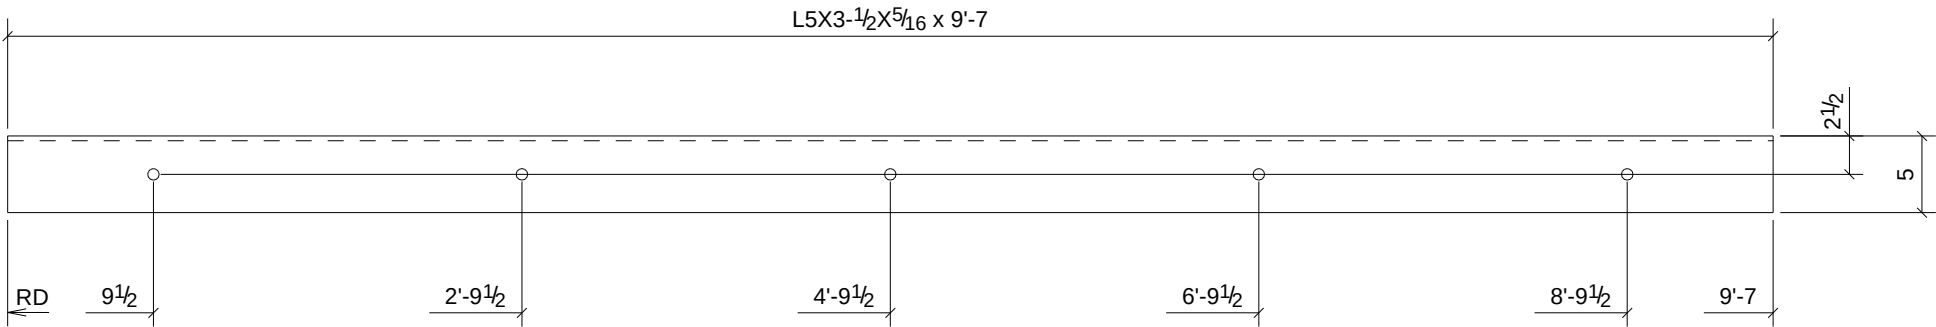


PHASE				
1	2	3	4	5
2	0	0	0	0

2 - ANGLES - 17A5

A	For Approval & Field Survey		8/30/10	TMc	TAN
0	For Fabrication & F&F		9/15/10	TMc	TAN
REV.	DESCRIPTION		DATE	DWN	CHK
GENERAL NOTES			JOB USE		
MATERIAL: A992 / A36		ELECTRODES: E70XX LH	REF. DRG.	SHOP	
HOLES: 13/16 DIA. U/N		CONN'S.: -			
SURFACE PREP. SSPC-SP-2			APPROVAL		
AND PAINT: GREY PRIMER DEVOE NA-195 (U.N.)					
DESCRIPTION: ANGLE					
PROJECT NAME		Hamilton High School Phase III			
LOCATION		Hamilton City School District - Hamilton			
CONTRACTOR		GC Contracting			
	Avenue Fabricating Inc. 1281 Clough Pike Batavia, OH 45103 (513) 752-1911		DRAWN BY		DATE
			TMc		08/20/2010
			CHKD. BY		DATE
			TAN		
		JOB No.		DRG. No.	REV.
		10-16		17A5	3

BILL OF MATERIAL						
SHIP	MARK	NO PCS	DESCRIPTION	LENGTH	PIECE MARK	REMARKS
2	17A5	2	L5X3-1/2X5/16	9'-7"		SQ-2 A36

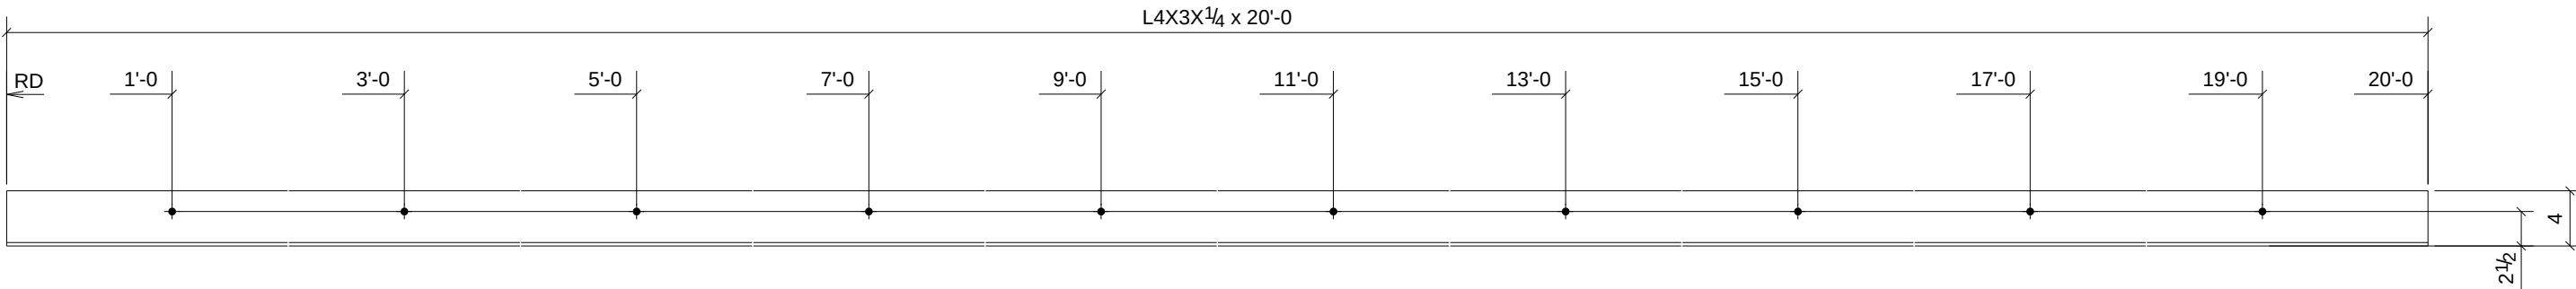


PHASE				
1	2	3	4	5
2	0	0	0	0

2 - ANGLES - 17A8

A	For Approval & Field Survey		8/30/10	TMc	TAN
0	For Fabrication & F&F		9/15/10	TMc	TAN
REV.	DESCRIPTION		DATE	DWN	CHK
GENERAL NOTES			JOB USE		
MATERIAL: A992 / A36		ELECTRODES: E70XX LH	REF. DRG.		
HOLES: 13/16 DIA. U/N		CONN'S.: -		SHOP	
SURFACE PREP. SSPC-SP-2			APPROVAL		
AND PAINT: GREY PRIMER DEVOE NA-195 (U.N.)					
DESCRIPTION: ANGLE					
PROJECT NAME		Hamilton High School Phase III			
LOCATION		Hamilton City School District - Hamilton			
CONTRACTOR		GC Contracting			
	Avenue Fabricating Inc. 1281 Clough Pike Batavia, OH 45103 (513) 752-1911		DRAWN BY TMc		DATE 09/02/2010
			CHKD. BY TAN		DATE
			JOB No. 10-16		DRG. No. 17A8

BILL OF MATERIAL						
SHIP	MARK	NO PCS	DESCRIPTION	LENGTH	PIECE MARK	REMARKS
2	17A8	2	L4X3X1/4	20'-0"		SQ-2 A36

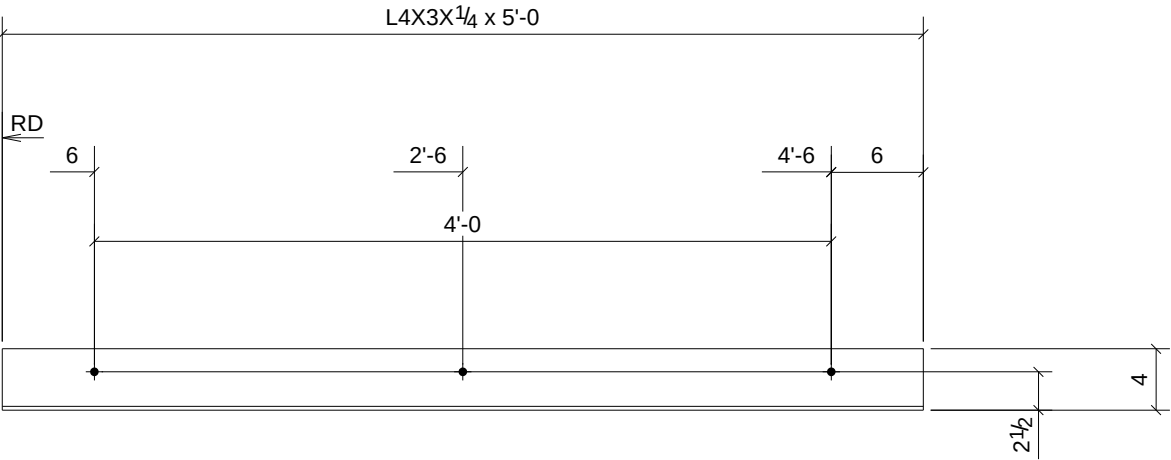


PHASE				
1	2	3	4	5
2	0	0	0	0

2 - ANGLES - 17A9

A	For Approval & Field Survey		8/30/10	TMc	TAN
0	For Fabrication & F&F		9/15/10	TMc	TAN
REV.	DESCRIPTION		DATE	DWN	CHK
GENERAL NOTES			JOB USE		
MATERIAL: A992 / A36		ELECTRODES: E70XX LH	REF. DRG.	SHOP	
HOLES: 13/16 DIA. U/N		CONN'S.: -			
SURFACE PREP. SSPC-SP-2			APPROVAL		
AND PAINT: GREY PRIMER DEVOE NA-195 (U.N.)					
DESCRIPTION: ANGLE					
PROJECT NAME		Hamilton High School Phase III			
LOCATION		Hamilton City School District - Hamilton			
CONTRACTOR		GC Contracting			
	Avenue Fabricating Inc. 1281 Clough Pike Batavia, OH 45103 (513) 752-1911		DRAWN BY TMc		DATE 09/02/2010
			CHKD. BY TAN		DATE
			JOB No. 10-16		DRG. No. 17A9

BILL OF MATERIAL						
SHIP	MARK	NO PCS	DESCRIPTION	LENGTH	PIECE MARK	REMARKS
2	17A9	2	L4X3X1/4	5'-0"		SQ-2 A36

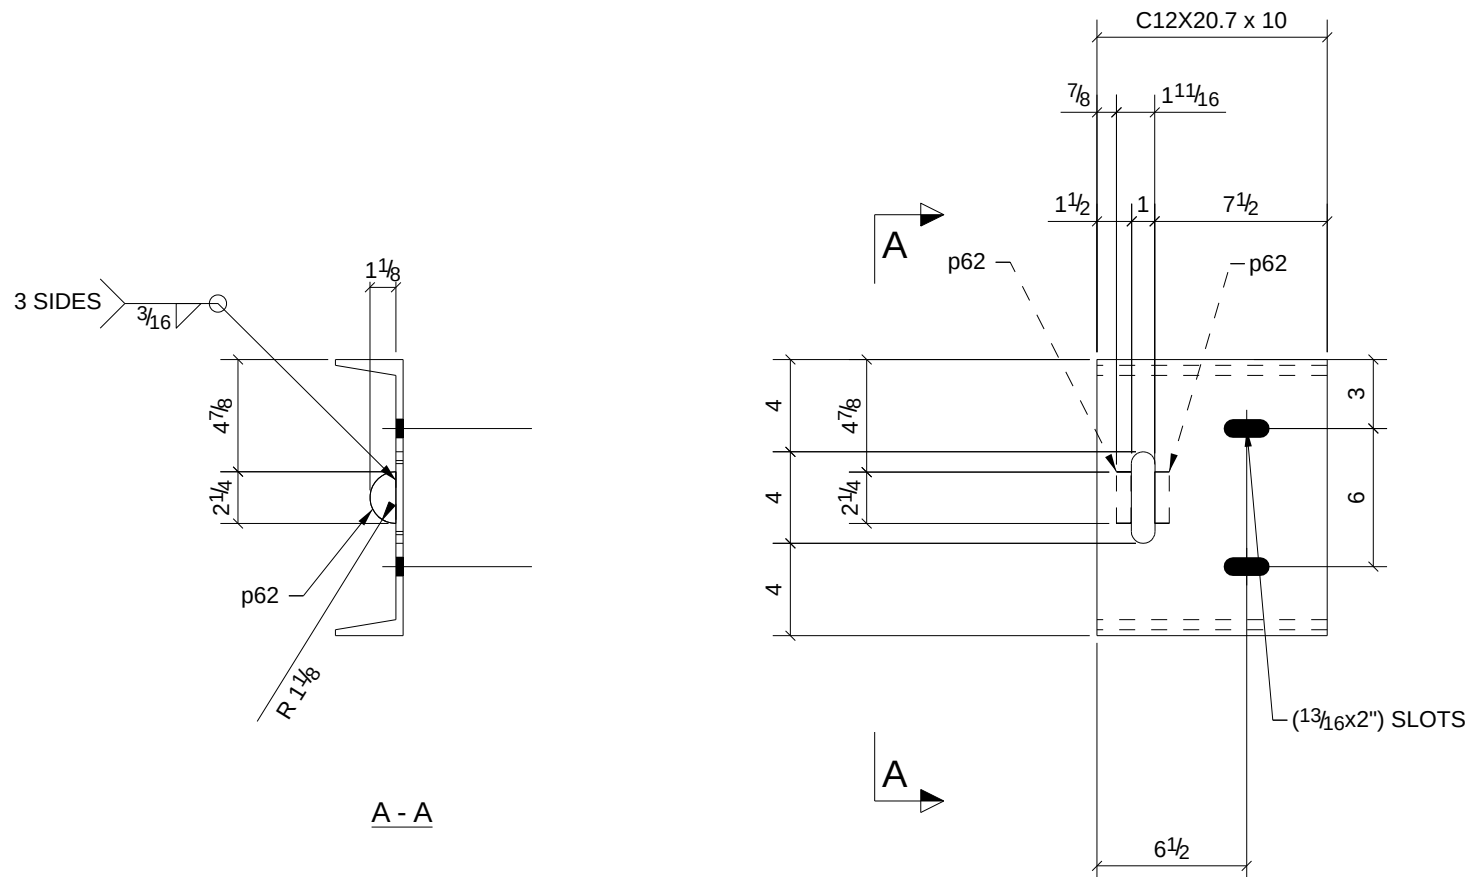


4 - CHANNELS - 17M1

PHASE				
1	2	3	4	5
4	0	0	0	0

BILL OF MATERIAL

SHIP	MARK	NO PCS	DESCRIPTION	LENGTH	PIECE MARK	REMARKS
4	17M1	4	C12X20.7	0'-10"		SQ-2 A36
		8	PL5/8"X1 15/16"	0'-1 15/16"	p62	A36

A	For Approval & Field Survey		8/30/10	TMc	TAN
0	For Fabrication & F&F		9/15/10	TMc	TAN
REV.	DESCRIPTION		DATE	DWN	CHK
GENERAL NOTES			JOB USE		
MATERIAL: A992 / A36		ELECTRODES: E70XX LH	REF. DRG.		
HOLES: 13/16 DIA. U/N		CONN'S.: -		SHOP	
SURFACE PREP. SSPC-SP-2			APPROVAL		
AND PAINT: GREY PRIMER DEVOE NA-195 (U.N.)					
DESCRIPTION: CHANNEL					
PROJECT NAME Hamilton High School Phase III					
LOCATION Hamilton City School District - Hamilton					
CONTRACTOR GC Contracting					
	Avenue Fabricating Inc. 1281 Clough Pike Batavia, OH 45103 (513) 752-1911		DRAWN BY TMc		DATE 08/24/2010
			CHKD. BY TAN		DATE
			JOB No. 10-16		DRG. No. 17M1

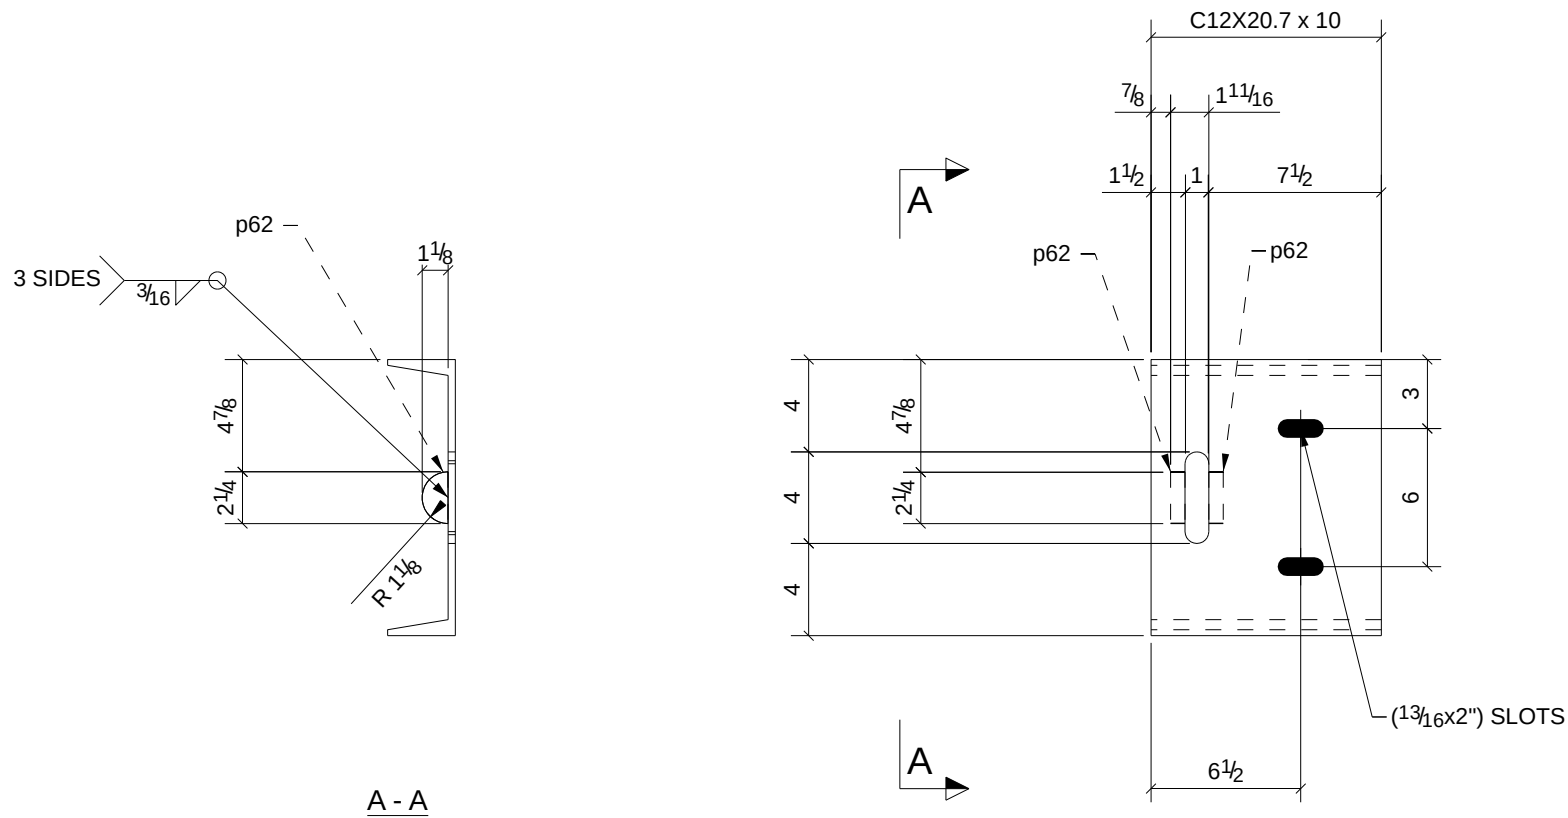


2 - CHANNELS - 17M2

PHASE				
1	2	3	4	5
2	0	0	0	0

BILL OF MATERIAL

SHIP	MARK	NO PCS	DESCRIPTION	LENGTH	PIECE MARK	REMARKS
2	17M2	2	C12X20.7	0'-10"		SQ-2 A36
		4	PL5/8"X1 15/16"	0'-1 15/16"	p62	A36

A	For Approval & Field Survey		8/30/10	TMc	TAN
0	For Fabrication & F&F		9/15/10	TMc	TAN
REV.	DESCRIPTION		DATE	DWN	CHK
GENERAL NOTES			JOB USE		
MATERIAL: A992 / A36		ELECTRODES: E70XX LH	REF. DRG.		
HOLES: 13/16 DIA. U/N		CONN'S.: -		SHOP	
SURFACE PREP. SSPC-SP-2			APPROVAL		
AND PAINT: GREY PRIMER DEVOE NA-195 (U.N,)					
DESCRIPTION: CHANNEL					
PROJECT NAME Hamilton High School Phase III					
LOCATION Hamilton City School District - Hamilton					
CONTRACTOR GC Contracting					
	Avenue Fabricating Inc. 1281 Clough Pike Batavia, OH 45103 (513) 752-1911		DRAWN BY TMc		DATE 08/24/2010
			CHKD. BY TAN		DATE
			JOB No. 10-16		DRG. No. 17M2

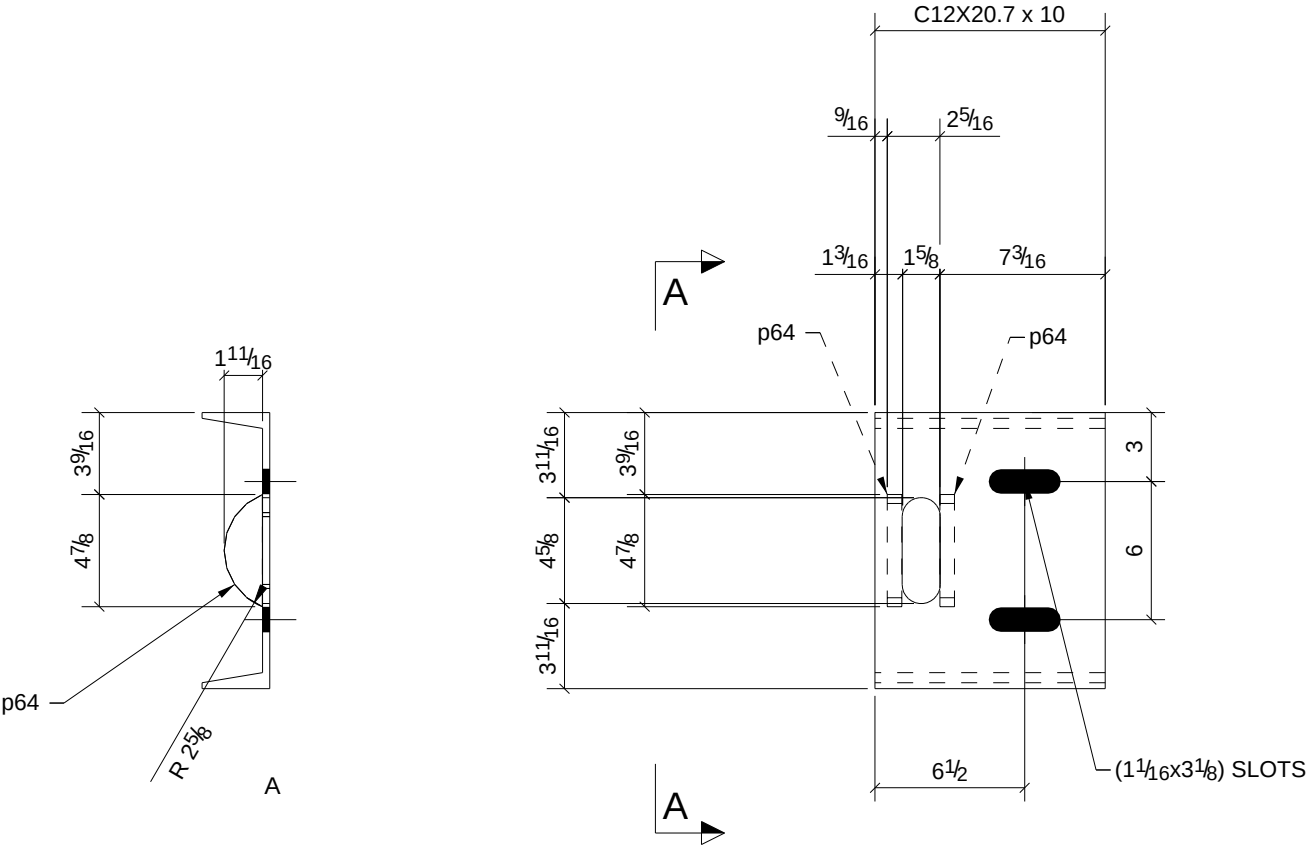


4 - CHANNELS - 17M3

PHASE				
1	2	3	4	5
4	0	0	0	0

BILL OF MATERIAL

SHIP	MARK	NO PCS	DESCRIPTION	LENGTH	PIECE MARK	REMARKS
4	17M3	4	C12X20.7	0'-10"		SQ-2 A36
		8	PL5/8"X1 11/16"	0'-4 7/8"	p64	A36

A	For Approval & Field Survey	8/30/10	TMc	TAN
0	For Fabrication & F&F	9/15/10	TMc	TAN
REV.	DESCRIPTION	DATE	DWN	CHK
GENERAL NOTES			JOB USE	
MATERIAL: A992 / A36	ELECTRODES: E70XX LH	REF. DRG.	SHOP	
HOLES: 13/16 DIA. U/N	CONN'S.: -		APPROVAL	
SURFACE PREP. SSPC-SP-2				
AND PAINT: GREY PRIMER DEVOE NA-195 (U.N.)				
DESCRIPTION: CHANNEL				
PROJECT NAME Hamilton High School Phase III				
LOCATION Hamilton City School District - Hamilton				
CONTRACTOR GC Contracting				
Avenue Fabricating Inc. 1281 Clough Pike Batavia, OH 45103 (513) 752-1911		DRAWN BY TMc	DATE 08/24/2010	
		CHKD. BY TAN	DATE	
		JOB No. 10-16	DRG. No. 17M3	REV. 2

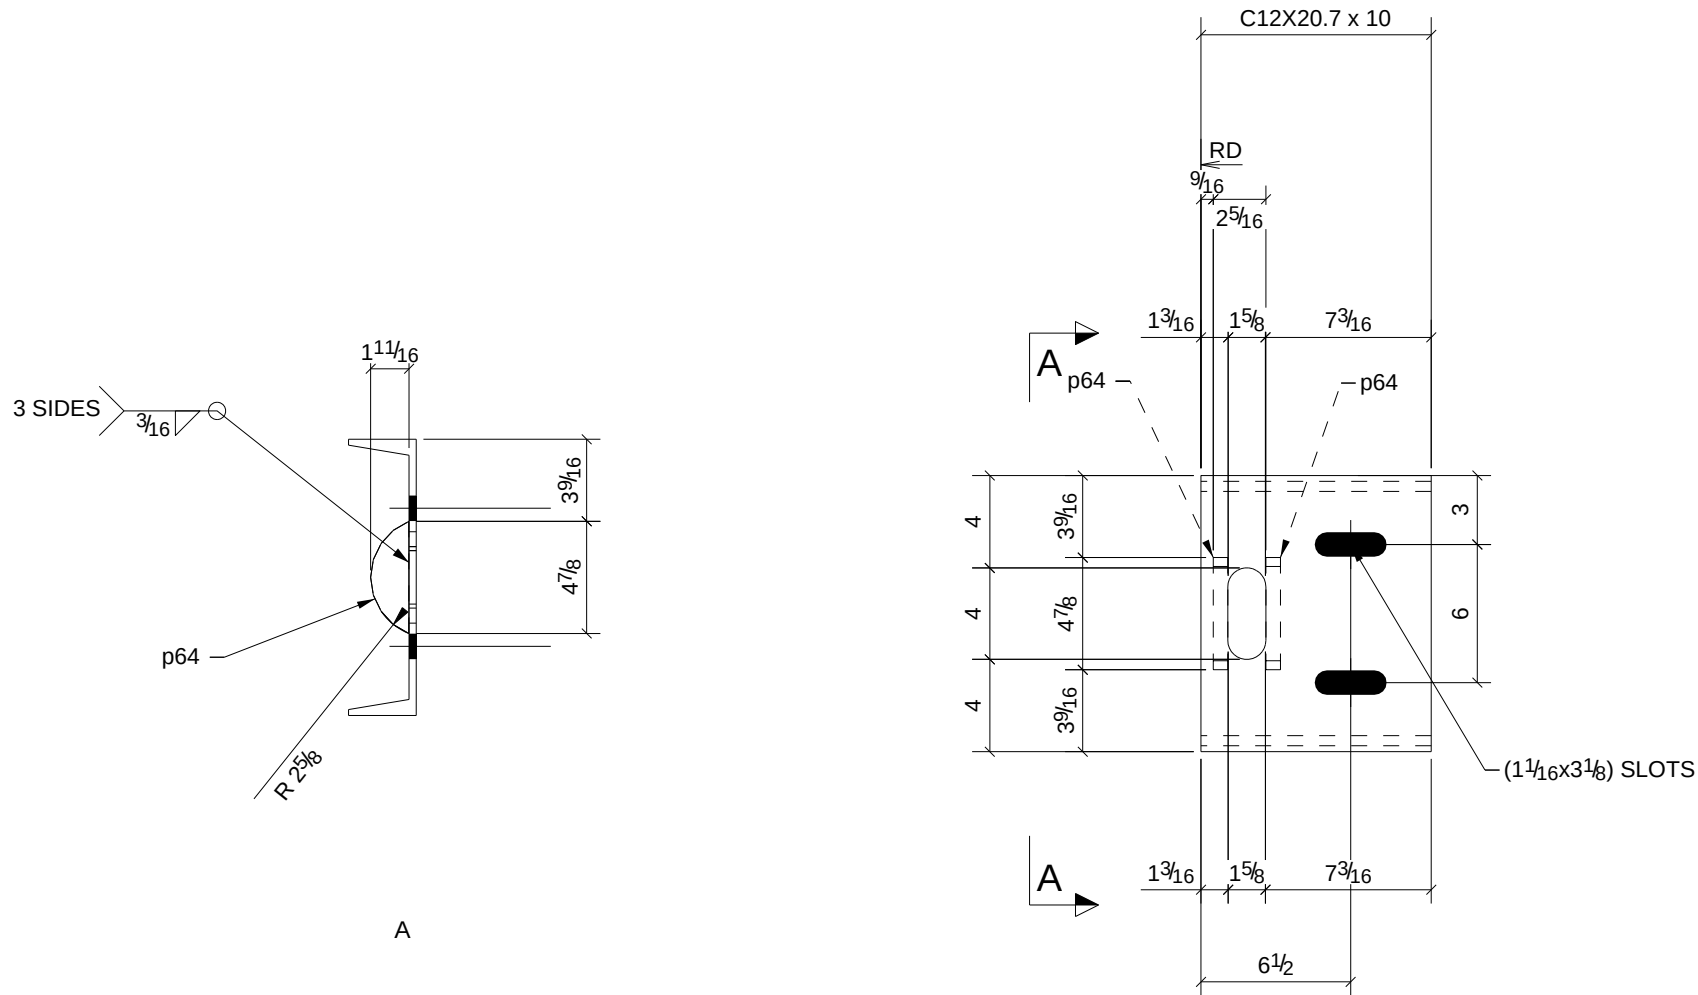


4 - CHANNELS - 17M4

PHASE				
1	2	3	4	5
4	0	0	0	0

BILL OF MATERIAL

SHIP	MARK	NO PCS	DESCRIPTION	LENGTH	PIECE MARK	REMARKS
4	17M4	4	C12X20.7	0'-10"		SQ-2 A36
		8	PL5/8"X1 11/16"	0'-4 7/8"	p64	A36

A	For Approval & Field Survey		8/30/10	TMc	TAN
0	For Fabrication & F&F		9/15/10	TMc	TAN
REV.	DESCRIPTION		DATE	DWN	CHK
GENERAL NOTES			JOB USE		
MATERIAL: A992 / A36		ELECTRODES: E70XX LH	REF. DRG.		
HOLES: 13/16 DIA. U/N		CONN'S.: -		SHOP	
SURFACE PREP. SSPC-SP-2			APPROVAL		
AND PAINT: GREY PRIMER DEVOE NA-195 (U.N.)					
DESCRIPTION: CHANNEL					
PROJECT NAME Hamilton High School Phase III					
LOCATION Hamilton City School District - Hamilton					
CONTRACTOR GC Contracting					
	Avenue Fabricating Inc. 1281 Clough Pike Batavia, OH 45103 (513) 752-1911		DRAWN BY TMc		DATE 08/24/2010
			CHKD. BY TAN		DATE
			JOB No. 10-16		DRG. No. 17M4

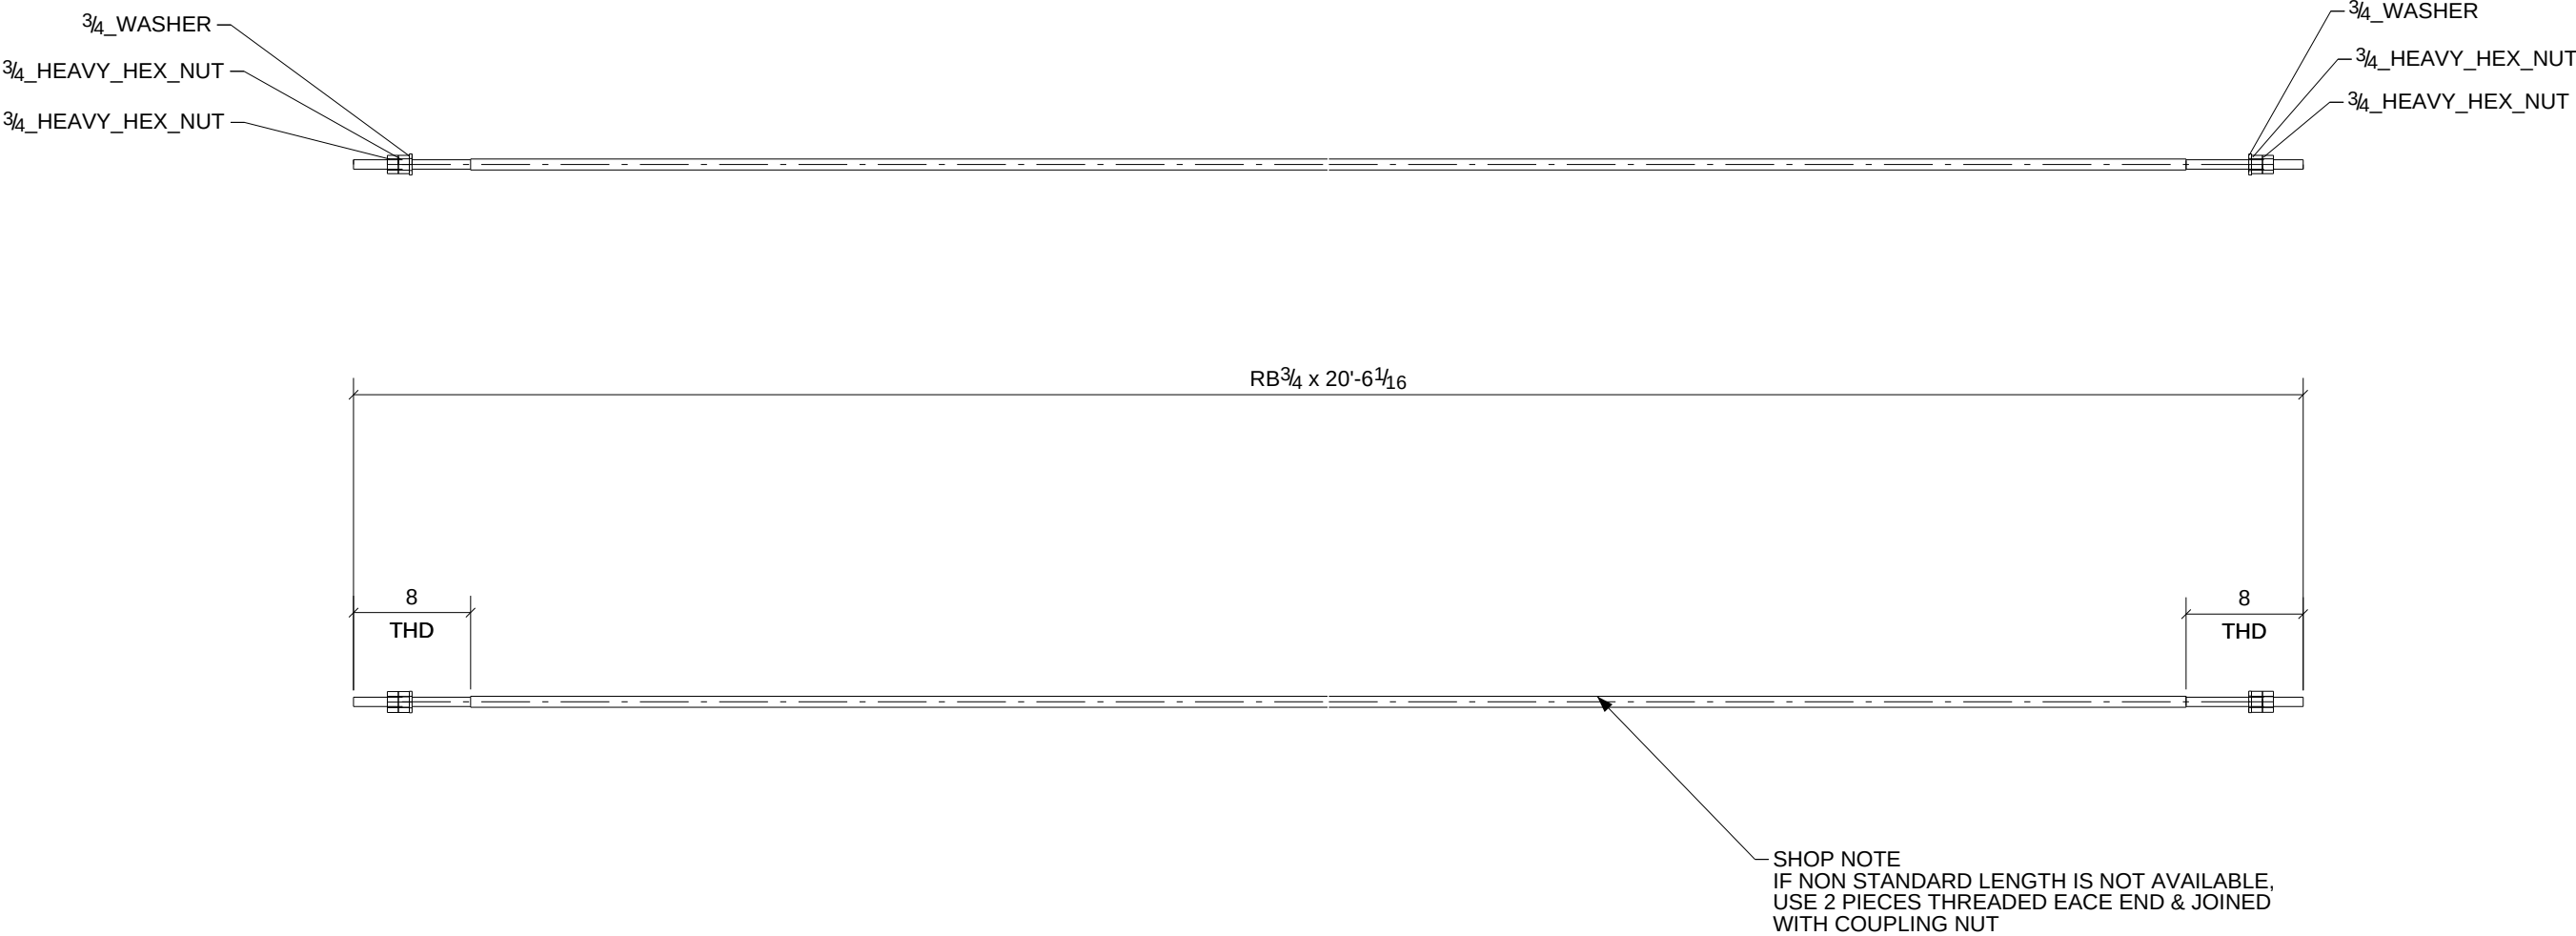

2 - ROD BRACES - 17R1

PHASE				
1	2	3	4	5
2	0	0	0	0


BILL OF MATERIAL

SHIP	MARK	NO PCS	DESCRIPTION	LENGTH	PIECE MARK	REMARKS
2	17R1	2	RB3/4"	20'-6 1/16"		SQ-2 A36
		8	3/4_HEAVY_HEX_NUT			
		4	3/4_WASHER			

A	For Approval & Field Survey		8/30/10	TMc	TAN	
0	For Fabrication & F&F		9/15/10	TMc	TAN	
REV.	DESCRIPTION		DATE	DWN	CHK	
GENERAL NOTES			JOB USE			
MATERIAL: A992 / A36		ELECTRODES: E70XX LH	REF. DRG.			
HOLES: 13/16 DIA. U/N		CONN'S.: -	SHOP			
SURFACE PREP. SSPC-SP-2			APPROVAL			
AND PAINT: GREY PRIMER DEVOE NA-195 (U.N,)						
DESCRIPTION: BRACE						
PROJECT NAME		Hamilton High School Phase III				
LOCATION		Hamilton City School District - Hamilton				
CONTRACTOR		GC Contracting				
	Avenue Fabricating Inc. 1281 Clough Pike Batavia, OH 45103 (513) 752-1911		DRAWN BY TMc		DATE 08/24/2010	
			CHKD. BY TAN		DATE	
			JOB No. 10-16		DRG. No. 17R1	
					REV. 2	




A	For Approval & Field Survey	8/30/10	TMc	TAN
0	For Fabrication & F&F	9/15/10	TMc	TAN
REV.	DESCRIPTION	DATE	DWN	CHK
GENERAL NOTES		JOB USE		
MATERIAL: A992 / A36	ELECTRODES: E70XX LH	REF. DRG.		
HOLES: 13/16 DIA. U/N	CONN'S.: -		SHOP	
SURFACE PREP. SSPC-SP-2		APPROVAL		
AND PAINT: GREY PRIMER DEVOE NA-195 (U.N.)				
DESCRIPTION: BRACE				
PROJECT NAME Hamilton High School Phase III				
LOCATION Hamilton City School District - Hamilton				
CONTRACTOR GC Contracting				
	Avenue Fabricating Inc. 1281 Clough Pike Batavia, OH 45103 (513) 752-1911	DRAWN BY TMC		DATE 08/24/2010
		CHKD. BY TAN		DATE
		JOB No. 10-16		DRG. No. 17R2

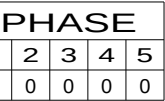

BILL OF MATERIAL						
SHIP	MARK	NO PCS	DESCRIPTION	LENGTH	PIECE MARK	REMARKS
2	17R3	2	RB1 3/8"	25'-6 7/8"		SQ-2 A36
		4	1-3/8_WASHER			
		8	1-3/8_HEAVY_HEX_NUT			

A	For Approval & Field Survey	8/30/10	TMc	TAN	
0	For Fabrication & F&F	9/15/10	TMc	TAN	
REV.	DESCRIPTION	DATE	DWN	CHK	
GENERAL NOTES			JOB USE		
MATERIAL: A992 / A36		ELECTRODES: E70XX LH	REF. DRG.		
HOLES: 13/16 DIA. U/N		CONN'S.: -			
SURFACE PREP. SSPC-SP-2			APPROVAL		
AND PAINT: GREY PRIMER DEVOE NA-195 (U.N.)					
DESCRIPTION: BRACE					
PROJECT NAME Hamilton High School Phase III					
LOCATION Hamilton City School District - Hamilton					
CONTRACTOR GC Contracting					
	Avenue Fabricating Inc. 1281 Clough Pike Batavia, OH 45103 (513) 752-1911		DRAWN BY TMc		DATE 08/24/2010
			CHKD. BY TAN		DATE
			JOB No. 10-16		DRG. No. 17R3

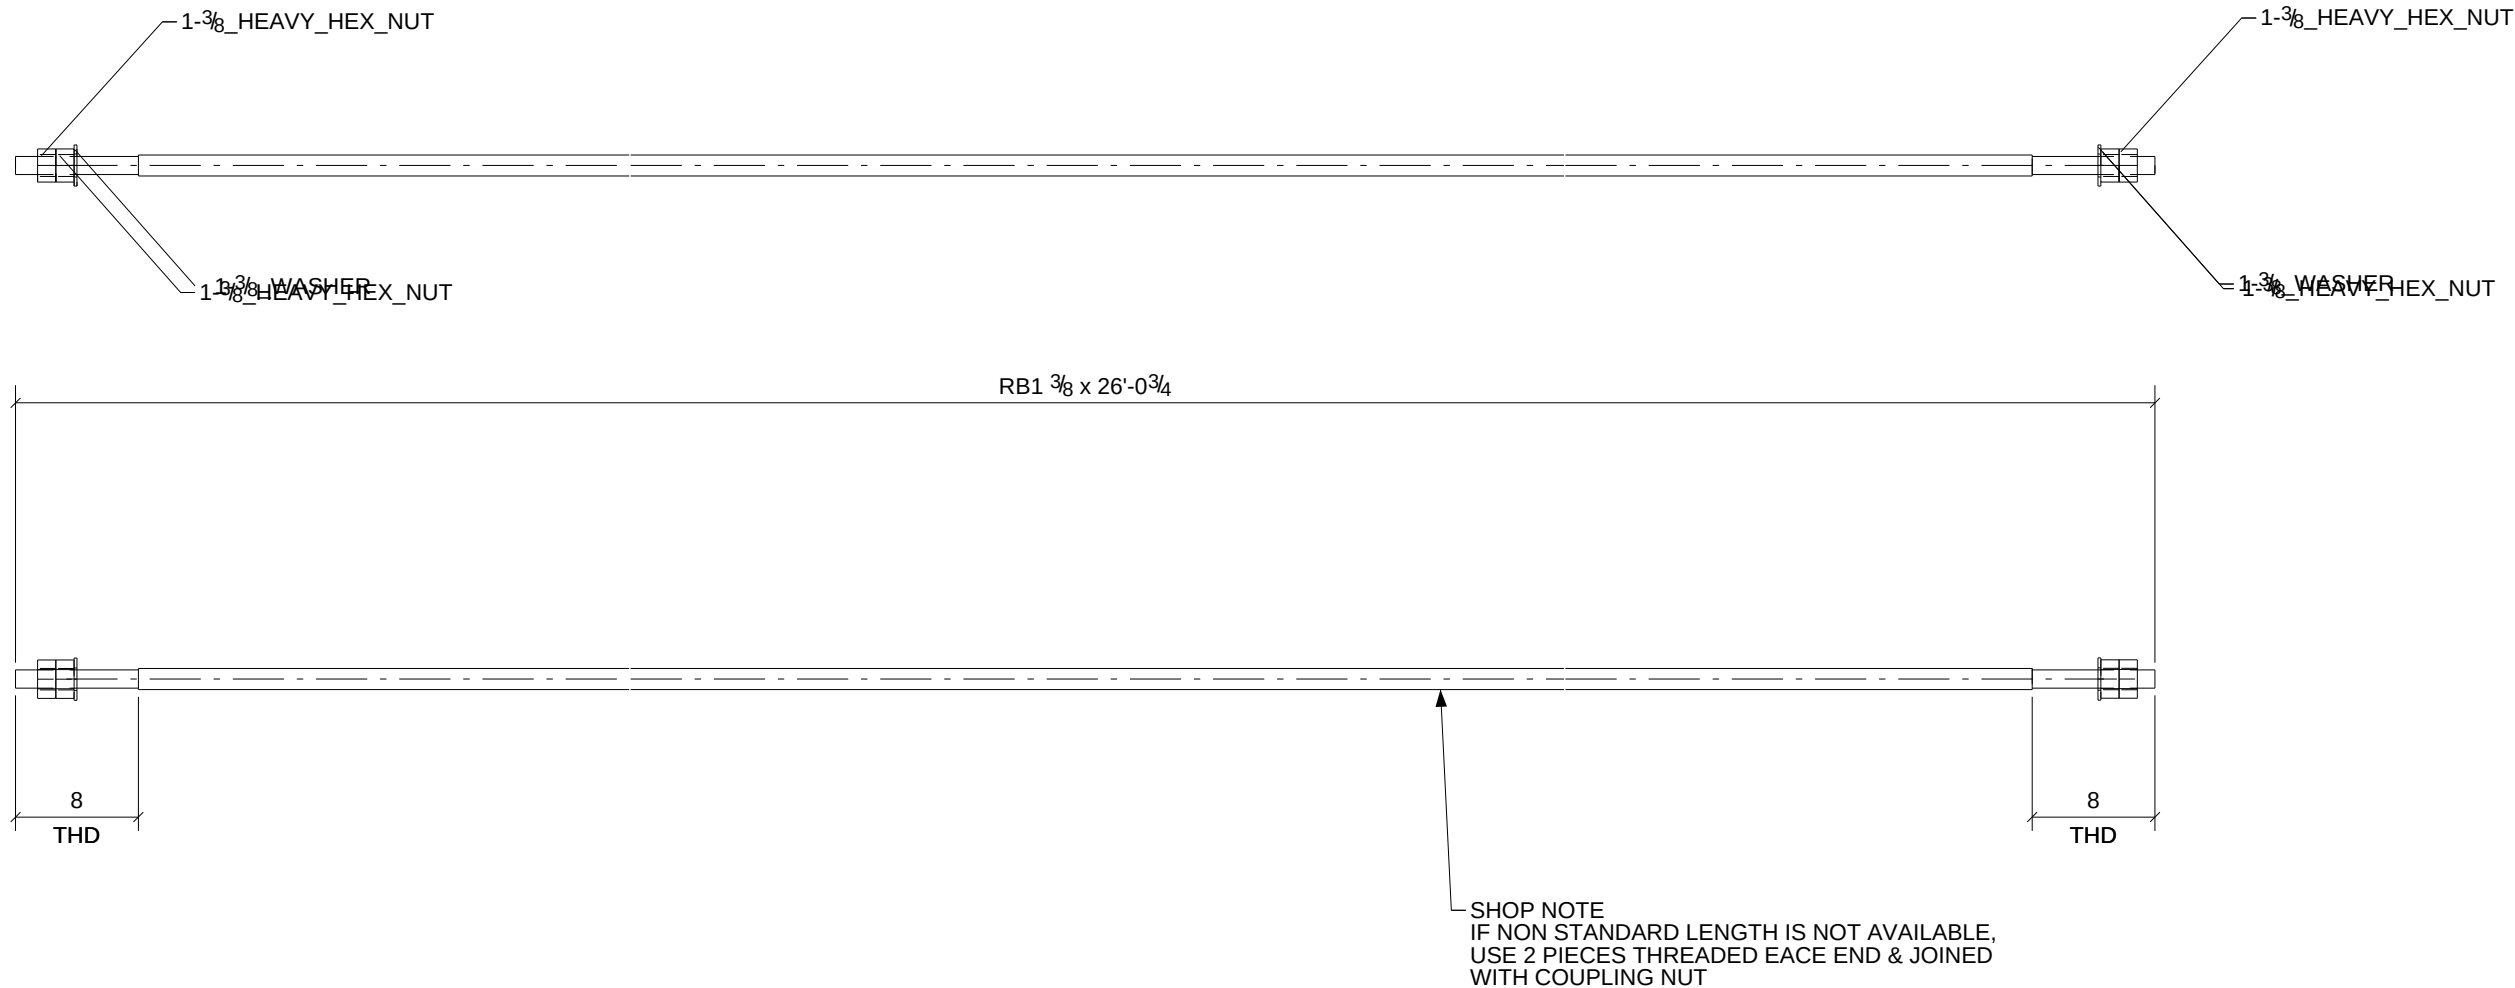


2 - ROD BRACES - 17R4

PHASE				
1	2	3	4	5
2	0	0	0	0

BILL OF MATERIAL

SHIP	MARK	NO PCS	DESCRIPTION	LENGTH	PIECE MARK	REMARKS
2	17R4	2	RB1 3/8"	26'-0 3/4"		SQ-2 A36
		4	1-3/8_WASHER			
		8	1-3/8_HEAVY_HEX_NUT			

A	For Approval & Field Survey		8/30/10	TMc	TAN	
0	For Fabrication & F&F		9/15/10	TMc	TAN	
REV.	DESCRIPTION		DATE	DWN	CHK	
GENERAL NOTES			JOB USE			
			SHOP			
MATERIAL: A992 / A36		ELECTRODES: E70XX LH	REF. DRG.			
HOLES: 13/16 DIA. U/N		CONN'S.: -				
SURFACE PREP. SSPC-SP-2			APPROVAL			
AND PAINT: GREY PRIMER DEVOE NA-195 (U.N,)						
DESCRIPTION: BRACE						
PROJECT NAME		Hamilton High School Phase III				
LOCATION		Hamilton City School District - Hamilton				
CONTRACTOR		GC Contracting				
	Avenue Fabricating Inc. 1281 Clough Pike Batavia, OH 45103 (513) 752-1911		DRAWN BY TMc		DATE 08/24/2010	
			CHKD. BY TAN		DATE	
			JOB No. 10-16		DRG. No. 17R4	REV. 2

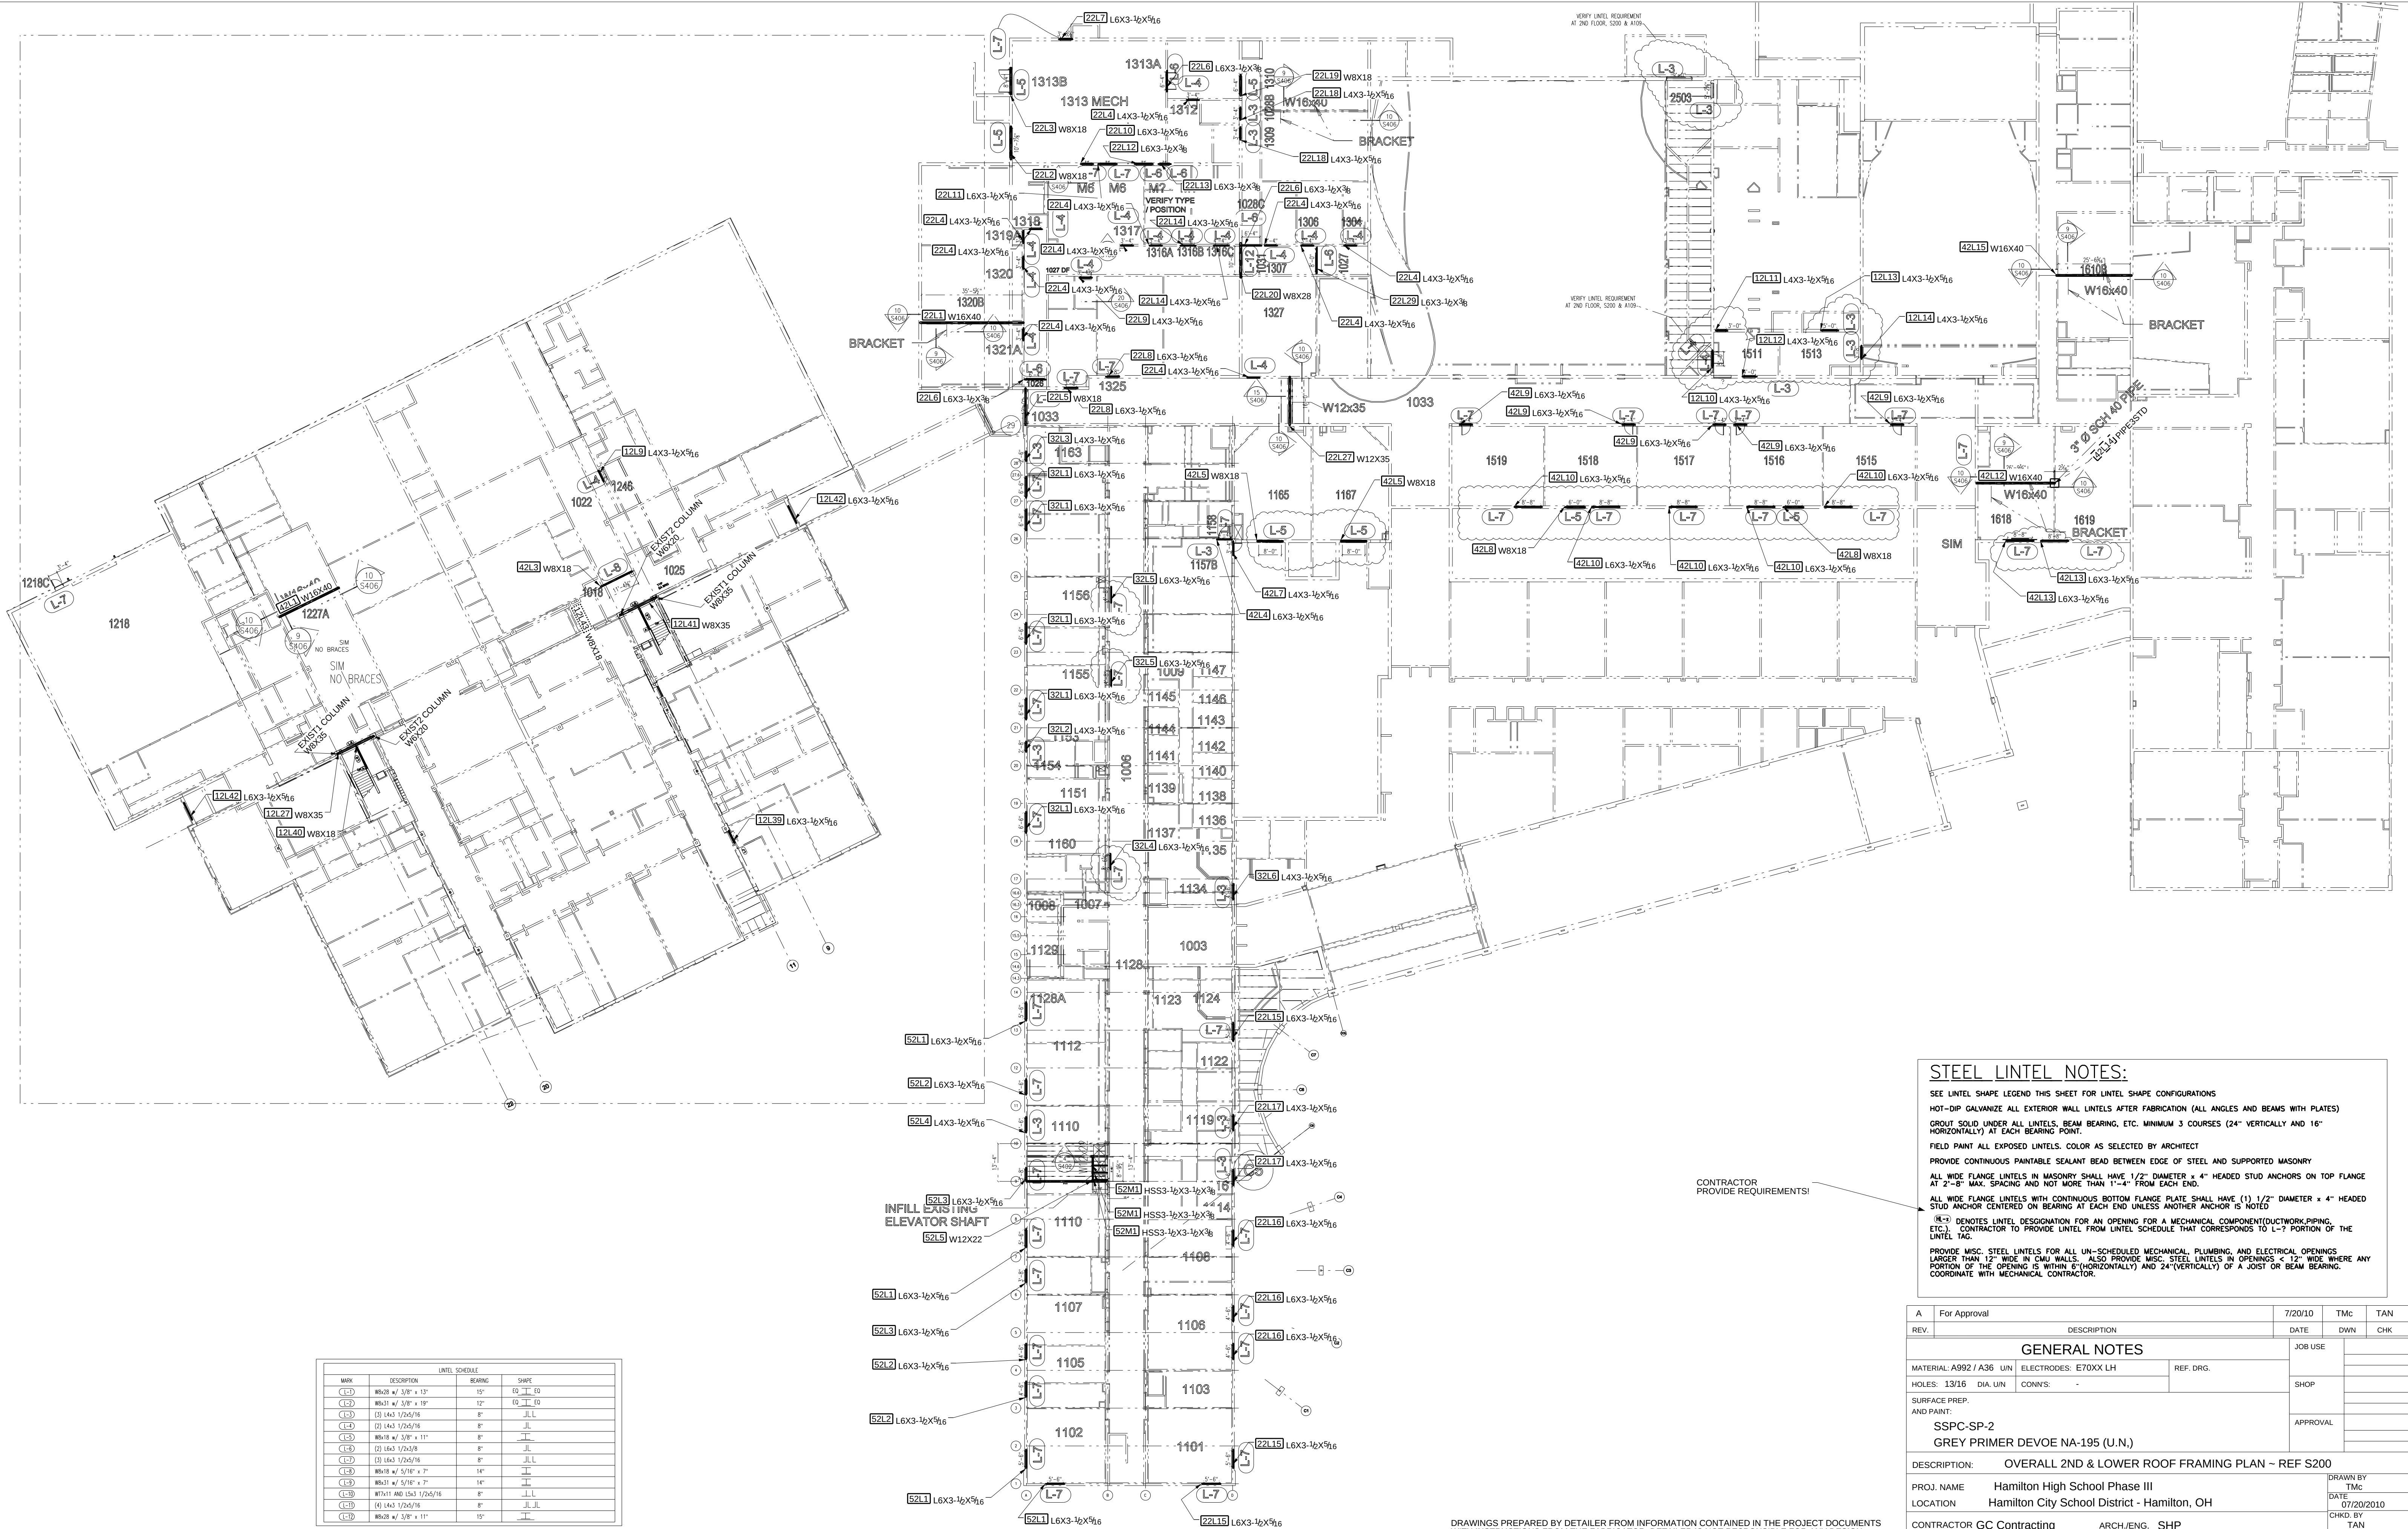

LINTEL SCHEDULE			
MARK	DESCRIPTION	BEARING	SHAPE
(L-1)	W8X18 w/ 3/8" x 13"	15"	EQ. T. CO.
(L-2)	W8X11 w/ 3/8" x 19"	12"	EQ. T. CO.
(L-3)	(3) L43 1/2x5/16	8"	J.L.L.
(L-4)	(2) L43 1/2x5/16	8"	J.L.L.
(L-5)	W8X18 w/ 3/8" x 11"	8"	J.L.L.
(L-6)	(2) L43 1/2x5/16	8"	J.L.L.
(L-7)	(3) L43 1/2x5/16	8"	J.L.L.
(L-8)	W8X18 w/ 5/16" x 7"	14"	J.L.L.
(L-9)	W8X11 w/ 5/16" x 7"	14"	J.L.L.
(L-10)	W10X18 w/ 1/2x5/16	8"	J.L.L.
(L-11)	(4) L43 1/2x5/16	8"	J.L.L.
(L-12)	W8X18 w/ 3/8" x 11"	12"	J.L.L.

STEEL LINTEL NOTES:

SEE LINTEL SHAPE LEGEND THIS SHEET FOR LINTEL SHAPE CONFIGURATIONS

HOT-DIP GALVANIZE ALL EXTERIOR WALL LINTELS AFTER FABRICATION (ALL ANGLES AND BEAMS WITH PLATES)

GROUT SOLID UNDER ALL LINTELS, BEAM BEARING, ETC. MINIMUM 3 COURSES (24" VERTICALLY AND 16" HORIZONTALLY) AT EACH BEARING POINT.

FIELD PAINT ALL EXPOSED LINTELS, COLOR AS SELECTED BY ARCHITECT

PROVIDE CONTINUOUS PAINTABLE SEALANT BEAD BETWEEN EDGE OF STEEL AND SUPPORTED MASONRY

ALL WIDE FLANGE LINTELS IN MASONRY SHALL HAVE 1/2" DIAMETER x 4" HEADED STUD ANCHORS ON TOP FLANGE AT 2'-8" MAX. SPACING AND NOT MORE THAN 1'-4" FROM EACH END.

ALL WIDE FLANGE LINTELS WITH CONTINUOUS BOTTOM FLANGE PLATE SHALL HAVE (1) 1/2" DIAMETER x 4" HEADED STUD ANCHOR CENTERED ON BEARING AT EACH END UNLESS ANOTHER ANCHOR IS NOTED.


(L-?) DENOTES LINTEL DESIGNATION FOR AN OPENING FOR A MECHANICAL COMPONENT (DUCTWORK, PIPING, ETC.). CONTRACTOR TO PROVIDE LINTEL FROM LINTEL SCHEDULE THAT CORRESPONDS TO L-? PORTION OF THE LINTEL TAG.

PROVIDE MISC. STEEL LINTELS FOR ALL UN-SCHEDULED MECHANICAL, PLUMBING, AND ELECTRICAL OPENINGS LARGER THAN 12" WIDE IN CMU WALLS. ALSO PROVIDE MISC. STEEL LINTELS IN OPENINGS < 12" WIDE WHERE ANY PORTION OF THE OPENING IS WITHIN 6" (HORIZONTALLY) AND 24" (VERTICALLY) OF A JOIST OR BEAM BEARING. COORDINATE WITH MECHANICAL CONTRACTOR.


A	For Approval	7/20/10	TMc	TAN
REV.	DESCRIPTION	DATE	DWN	CHK
GENERAL NOTES				
MATERIAL: A992 / A36 UN		ELECTRODES: E70XX LH		REF. DRG.
HOLES: 13/16 DIA. UN		CONVS: -		
SURFACE PREP. AND PAINT		JOB USE		
SSPC-SP-2		SHOP		
GREY PRIMER DEVCOE NA-195 (U.N.)		APPROVAL		
DESCRIPTION: OVERALL 2ND & LOWER ROOF FRAMING PLAN ~ REF S200				
PROJ. NAME		Hamilton High School Phase III		DRAWN BY TMc
LOCATION		Hamilton City School District - Hamilton, OH		DATE 07/20/2010
CONTRACTOR GC Contracting		ARCH./ENG. SHP		CHKD. BY TAN
Avenue Fabricating Inc.		1281 Clough Pike Batavia, OH 45103 (513) 752-1911		DATE
				JOB No. 10-16
				DRG. No. E200
				REV. A


DRAWINGS PREPARED BY DETAILER FROM INFORMATION CONTAINED IN THE PROJECT DOCUMENTS WITH INSTRUCTIONS FROM THE FABRICATOR. DETAILER IS NOT RESPONSIBLE FOR ANY DESIGN, ENGINEERING OR CODE ISSUES WHICH MAY ARISE FROM THE USE OF THESE DRAWINGS. APPROVALS SHOULD BE OBTAINED FROM THE OWNER, ARCHITECT, ENGINEER, CONTRACTOR, WHICH EVER IS APPLICABLE. THE FABRICATOR SHOULD CHECK THE DETAIL DOCUMENTS FOR CORRECTNESS BEFORE RELEASING FOR FABRICATION. THE USE OF THE DETAILED DRAWINGS FOR FABRICATION CONSTITUTES ACCEPTANCE AND APPROVAL OF THE DRAWINGS, MATERIAL LIST OR CUT LIST, WHICH EVER APPLIES.

OVERALL 2ND & LOWER ROOF FRAMING PLAN ~ REF S200

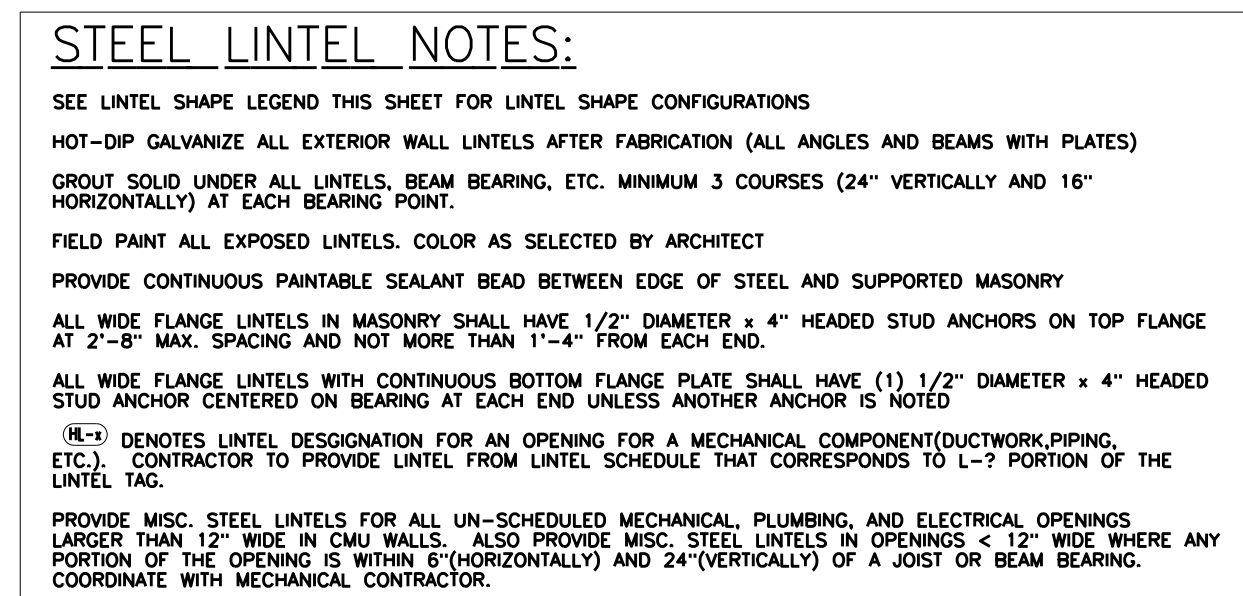

A		For Approval				7/23/2016		TMC		TAN	
REV.		DESCRIPTION				DATE		DWN		CHK	
GENERAL NOTES								JOB USE			
								SHOP			
								APPROVAL			
MATERIAL: A992 / A36 UN		ELECTRODES: E70XX LH		REF. DRG.							
HOLEX: 13/16 DIA. UN		CONNS:									
SURFACE PREP: AND PAINT:											
SSPC-SP-2											
GREY PRIMER DEVCOE NA-195 (U.N.)											
DESCRIPTION: OVERALL UPPER LEVEL & ROOF FRAMING PLAN - REF S300											
PROJ. NAME		Hamilton High School Phase III									
LOCATION		Hamilton City School District - Hamilton, OH									
CONTRACTOR		GC Contracting		ARCH./ENG.		SHP		DRAWN BY TMC		DATE 07/23/2010	
								CHKD. BY TAN		DATE	
								JOB NO.		10-16	
								DRG. NO.		REV. A	
								E300			

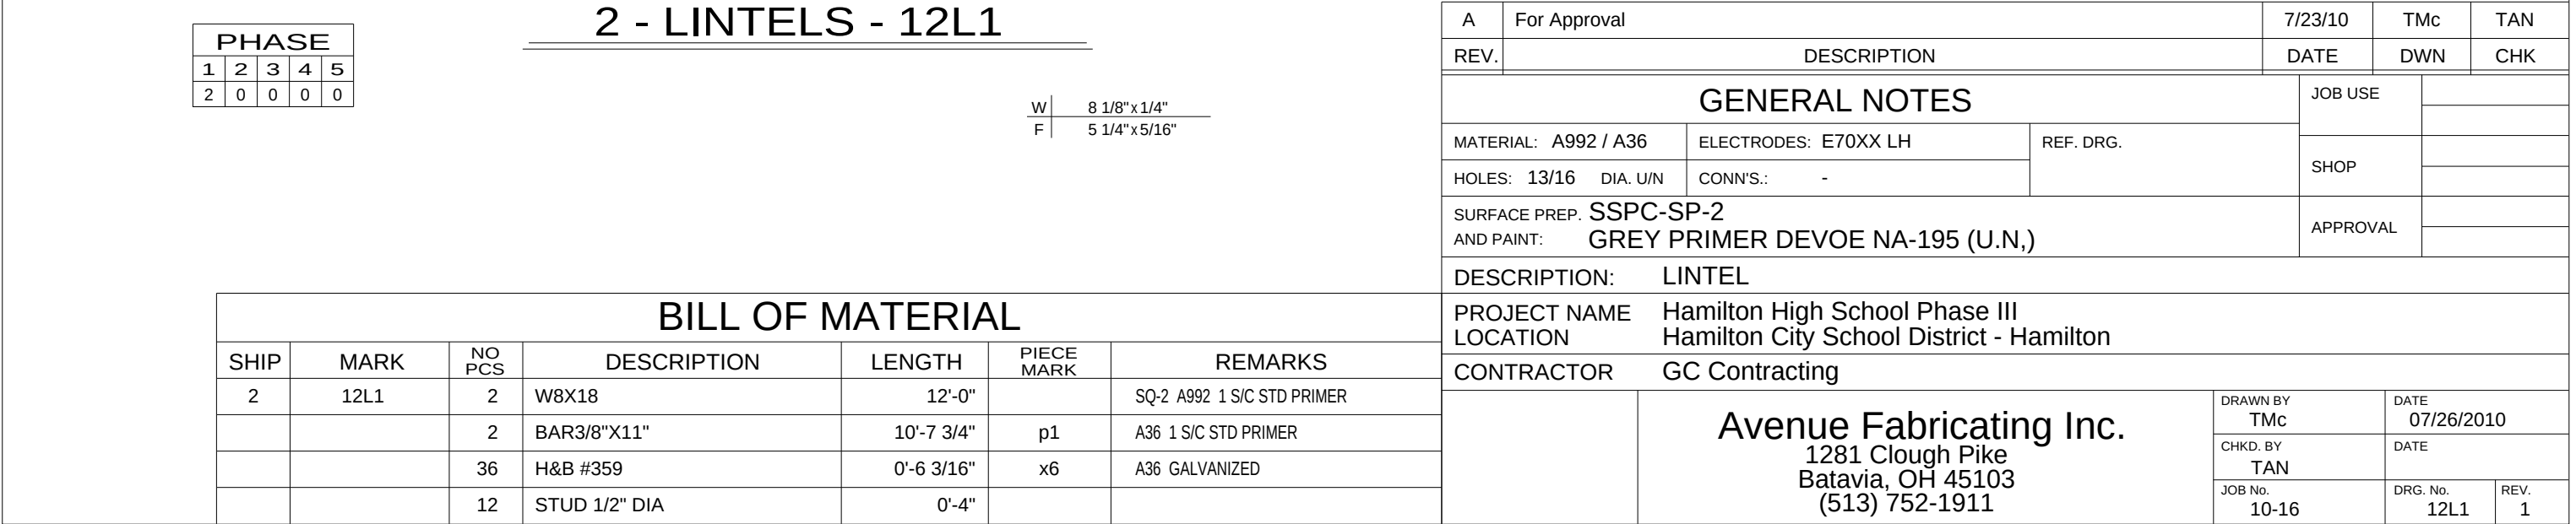

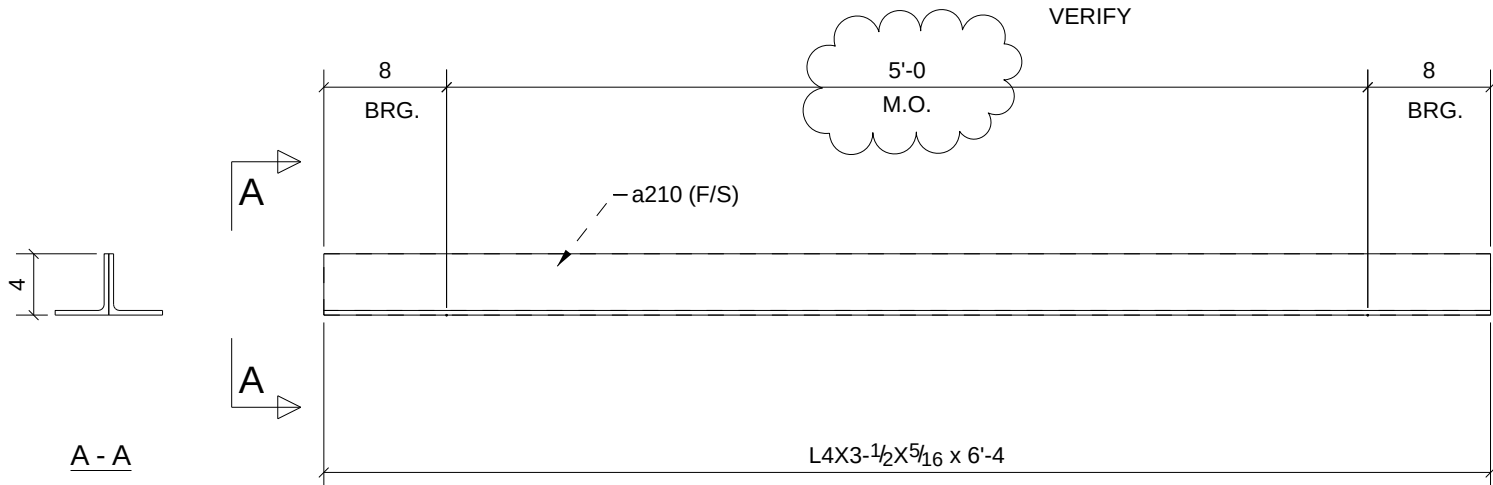

L-4 LOCATION (1511)

ARCH./ENG/OWNER
PLEASE VERIFY / PROVIDE
TYPE & LOCATIONS
ERECTOR / GC ~ PLEASE
VERIFY / PROVIDE
M.O. @ EACH LOCATION

PHASE				
1	2	3	4	5
0	1	0	0	0

ONE - LINTEL - 12L10


(2 ANGLES EACH LINTEL)

BILL OF MATERIAL


SHIP	MARK	NO PCS	DESCRIPTION	LENGTH	PIECE MARK	REMARKS
1	12L10	1	L4X3-1/2X5/16	6'-4"		SQ-2 A36 1 S/C STD PRIMER
		1	L4X3-1/2X5/16	6'-4"	a210	A36 1 S/C STD PRIMER

A	For Approval		7/20/10	TMc	TAN
REV.	DESCRIPTION		DATE	DWN	CHK
GENERAL NOTES			JOB USE		
MATERIAL: A992 / A36		ELECTRODES: E70XX LH	REF. DRG.		
HOLES: 13/16 DIA. U/N		CONN'S.: -		SHOP	
SURFACE PREP. SSPC-SP-2 AND PAINT: GREY PRIMER DEVOE NA-195 (U.N,)			APPROVAL		
DESCRIPTION: LINTEL					
PROJECT NAME		Hamilton High School Phase III			
LOCATION		Hamilton City School District - Hamilton			
CONTRACTOR		GC Contracting			
	Avenue Fabricating Inc. 1281 Clough Pike Batavia, OH 45103 (513) 752-1911		DRAWN BY		DATE
			TMc		07/20/2010
			CHKD. BY		DATE
			TAN		
		JOB No.	DRG. No.	REV.	
		10-16	12L10	1	

Avenue Fabricating Inc.
1281 Clough Pike
Batavia, OH 45103
(513) 752-1911

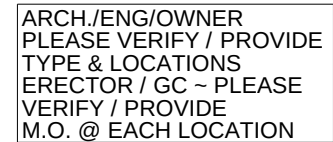

A	For Approval	7/20/10	TMc	TAN
REV.	DESCRIPTION	DATE	DWN	CHK
GENERAL NOTES		JOB USE		
MATERIAL: A992 / A36	ELECTRODES: E70XX LH	SHOP		
HOLES: 13/16 DIA. U/N	CONN'S.: -			
SURFACE PREP. SSPC-SP-2 AND PAINT: GREY PRIMER DEVOE NA-195 (U.N.)		APPROVAL		
DESCRIPTION: LINTEL				
PROJECT NAME Hamilton High School Phase III LOCATION Hamilton City School District - Hamilton				
CONTRACTOR GC Contracting				
Avenue Fabricating Inc. 1281 Clough Pike Batavia, OH 45103 (513) 752-1911		DRAWN BY TMc	DATE 07/20/2010	
		CHKD. BY TAN	DATE	
		JOB No. 10-16	DRG. No. 12L11	REV. 1

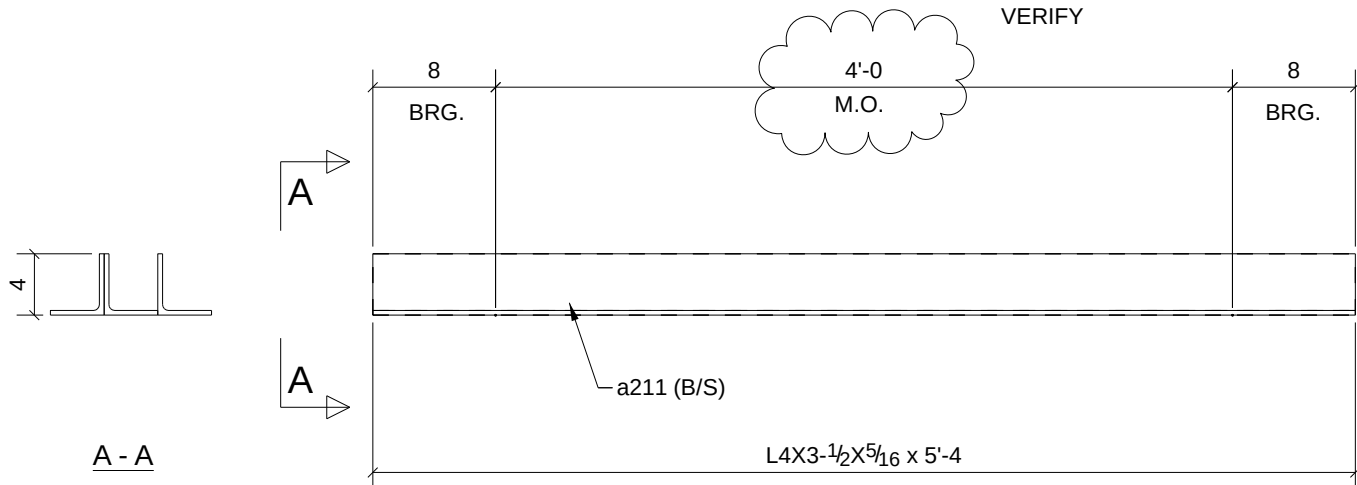

L-3 (M.O.=5'-0") LOCATION (1511)

ARCH./ENG/OWNER
PLEASE VERIFY / PROVIDE
TYPE & LOCATIONS
ERECTOR / GC ~ PLEASE
VERIFY / PROVIDE
M.O. @ EACH LOCATION

PHASE				
1	2	3	4	5
0	0	1	0	0


ONE - LINTEL - 12L12

(3 ANGLES EACH LINTEL)

BILL OF MATERIAL

SHIP	MARK	NO PCS	DESCRIPTION	LENGTH	PIECE MARK	REMARKS
1	12L12	1	L4X3-1/2X5/16	5'-4"		SQ-2 A36 1 S/C STD PRIMER
		2	L4X3-1/2X5/16	5'-4"	a211	A36 1 S/C STD PRIMER

A	For Approval			7/20/10	TMc	TAN
REV.	DESCRIPTION			DATE	DWN	CHK
GENERAL NOTES				JOB USE		
				SHOP		
MATERIAL: A992 / A36		ELECTRODES: E70XX LH	REF. DRG.			
HOLES: 13/16 DIA. U/N		CONN'S.: -				
SURFACE PREP. SS-PC-SP-2				APPROVAL		
AND PAINT: GREY PRIMER DEVOE NA-195 (U.N,)						
DESCRIPTION: LINTEL						
PROJECT NAME		Hamilton High School Phase III				
LOCATION		Hamilton City School District - Hamilton				
CONTRACTOR		GC Contracting				
	Avenue Fabricating Inc. 1281 Clough Pike Batavia, OH 45103 (513) 752-1911			DRAWN BY TMc		DATE 07/20/2010
				CHKD. BY TAN		DATE
				JOB No. 10-16		DRG. No. 12L12

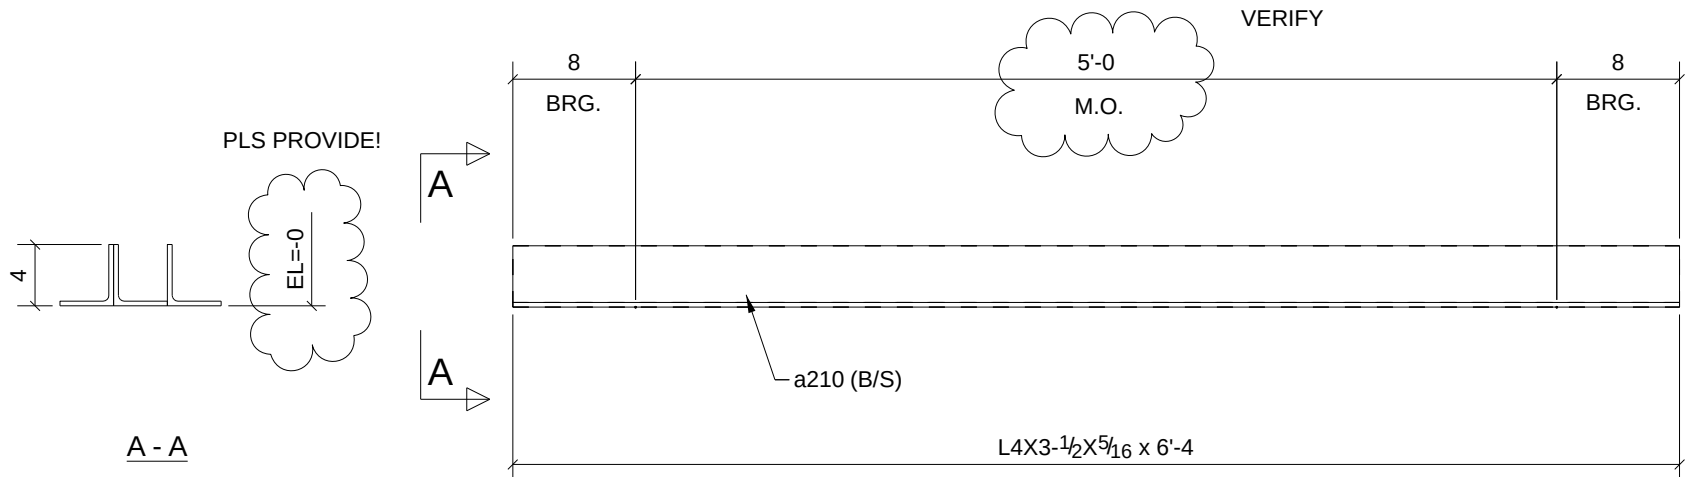

L-3 (M.O.=5'-0") LOCATION (1513)

ARCH./ENG/OWNER
PLEASE VERIFY / PROVIDE
TYPE & LOCATIONS
ERECTOR / GC ~ PLEASE
VERIFY / PROVIDE
M.O. @ EACH LOCATION

PHASE				
1	2	3	4	5
1	0	1	0	0


2 - LINTELS - 12L13

(3 ANGLES EACH LINTEL)

BILL OF MATERIAL

SHIP	MARK	NO PCS	DESCRIPTION	LENGTH	PIECE MARK	REMARKS
2	12L13	2	L4X3-1/2X5/16	6'-4"		SQ-2 A36 1 S/C STD PRIMER
		4	L4X3-1/2X5/16	6'-4"	a210	A36 1 S/C STD PRIMER

A	For Approval		7/20/10	TMc	TAN
REV.	DESCRIPTION		DATE	DWN	CHK
GENERAL NOTES			JOB USE		
MATERIAL: A992 / A36		ELECTRODES: E70XX LH	REF. DRG.		
HOLES: 13/16 DIA. U/N		CONN'S.: -		SHOP	
SURFACE PREP. SSPC-SP-2 AND PAINT: GREY PRIMER DEVOE NA-195 (U.N,)			APPROVAL		
DESCRIPTION: LINTEL					
PROJECT NAME		Hamilton High School Phase III			
LOCATION		Hamilton City School District - Hamilton			
CONTRACTOR		GC Contracting			
	Avenue Fabricating Inc. 1281 Clough Pike Batavia, OH 45103 (513) 752-1911		DRAWN BY TMc		DATE 07/20/2010
			CHKD. BY TAN		DATE
			JOB No. 10-16		DRG. No. 12L13

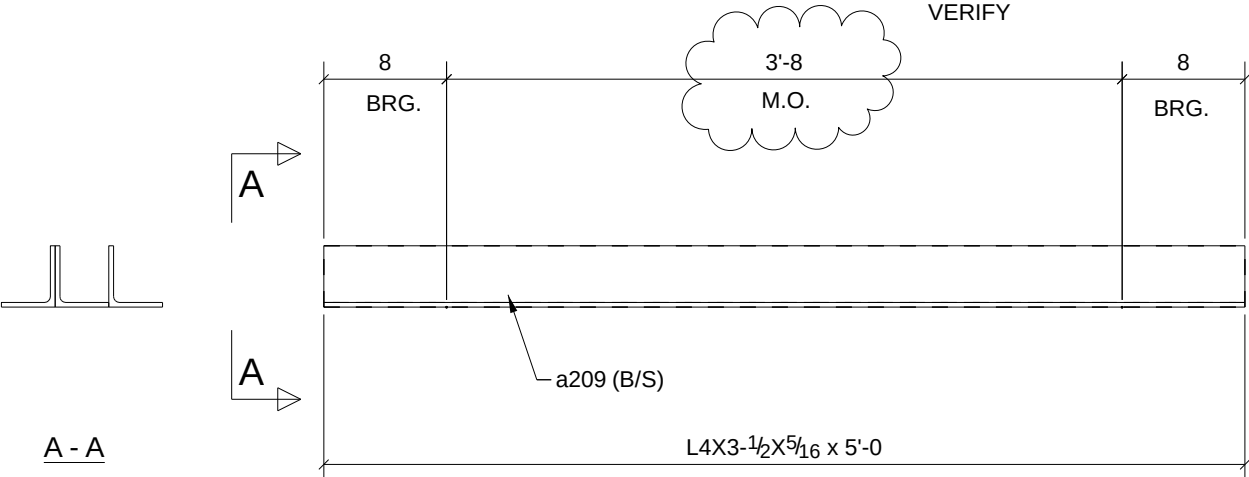

L-3 (M.O.=3'-8") LOCATION (1513)

ARCH./ENG/OWNER
PLEASE VERIFY / PROVIDE
TYPE & LOCATIONS
ERECTOR / GC ~ PLEASE
VERIFY / PROVIDE
M.O. @ EACH LOCATION

PHASE				
1	2	3	4	5
0	0	1	0	0


ONE - LINTEL - 12L14

(3 ANGLES EACH LINTEL)

BILL OF MATERIAL

SHIP	MARK	NO PCS	DESCRIPTION	LENGTH	PIECE MARK	REMARKS
1	12L14	1	L4X3-1/2X5/16	5'-0"		SQ-2 A36 1 S/C STD PRIMER
		2	L4X3-1/2X5/16	5'-0"	a209	A36 1 S/C STD PRIMER

A	For Approval	7/20/10	TMc	TAN
REV.	DESCRIPTION	DATE	DWN	CHK
GENERAL NOTES		JOB USE		
MATERIAL: A992 / A36	ELECTRODES: E70XX LH	REF. DRG.	SHOP	
HOLES: 13/16 DIA. U/N	CONN'S.: -			
SURFACE PREP. SSPC-SP-2	AND PAINT: GREY PRIMER DEVOE NA-195 (U.N,)		APPROVAL	
DESCRIPTION:	LINTEL			
PROJECT NAME	Hamilton High School Phase III			
LOCATION	Hamilton City School District - Hamilton			
CONTRACTOR	GC Contracting			
	Avenue Fabricating Inc. 1281 Clough Pike Batavia, OH 45103 (513) 752-1911	DRAWN BY TMc	DATE 07/20/2010	
		CHKD. BY TAN	DATE	
		JOB No. 10-16	DRG. No. 12L14	REV. 1

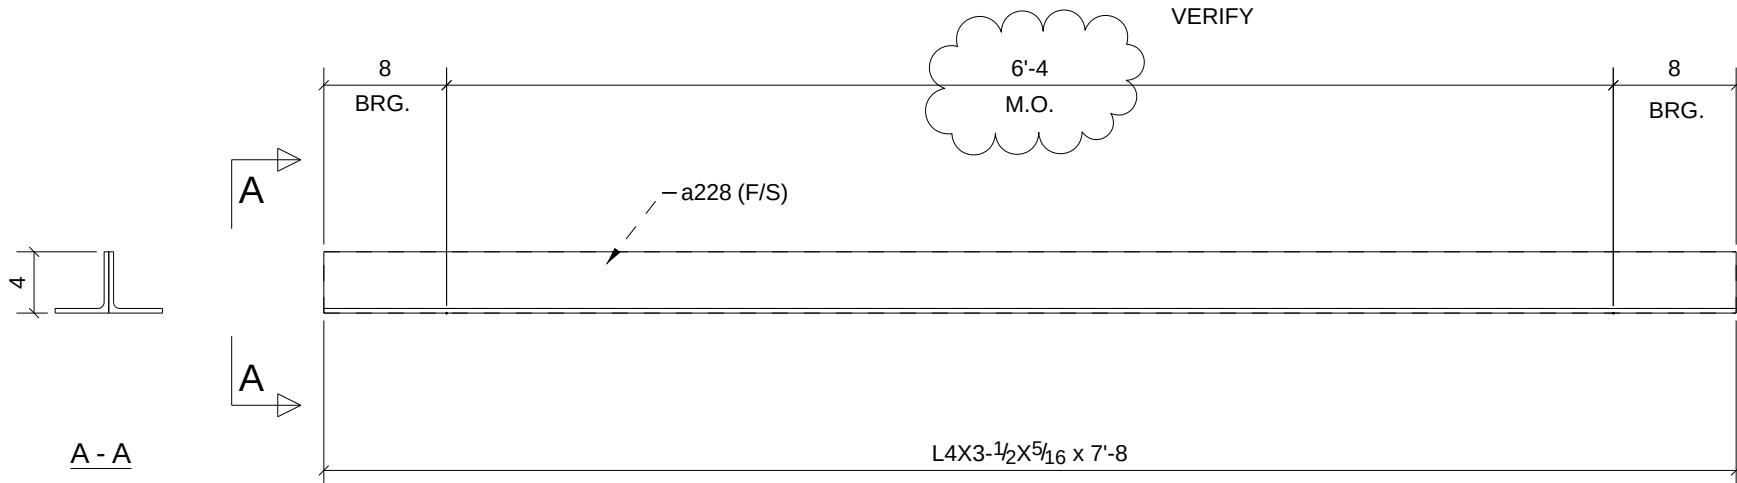

L-4 (M.O.=6'-4") LOCATION (2242)
(2202)

ARCH./ENG/OWNER
PLEASE VERIFY / PROVIDE
TYPE & LOCATIONS
ERECTOR / GC ~ PLEASE
VERIFY / PROVIDE
M.O. @ EACH LOCATION

PHASE				
1	2	3	4	5
4	0	0	0	0


4 - LINTELS - 12L15

(2 ANGLES EACH LINTEL)

BILL OF MATERIAL

SHIP	MARK	NO PCS	DESCRIPTION	LENGTH	PIECE MARK	REMARKS
4	12L15	4	L4X3-1/2X5/16	7'-8"		SQ-2 A36 1 S/C STD PRIMER
		4	L4X3-1/2X5/16	7'-8"	a228	A36 1 S/C STD PRIMER

A	For Approval	7/23/10	TMc	TAN
REV.	DESCRIPTION	DATE	DWN	CHK
GENERAL NOTES		JOB USE		
MATERIAL: A992 / A36	ELECTRODES: E70XX LH	REF. DRG.	SHOP	
HOLES: 13/16 DIA. U/N	CONN'S.: -		APPROVAL	
SURFACE PREP. SSPC-SP-2 AND PAINT: GREY PRIMER DEVOE NA-195 (U.N,)				
DESCRIPTION: LINTEL				
PROJECT NAME Hamilton High School Phase III LOCATION Hamilton City School District - Hamilton				
CONTRACTOR GC Contracting				
	Avenue Fabricating Inc. 1281 Clough Pike Batavia, OH 45103 (513) 752-1911	DRAWN BY TMc	DATE 07/23/2010	
		CHKD. BY TAN	DATE	
		JOB No. 10-16	DRG. No. 12L15	REV. 1

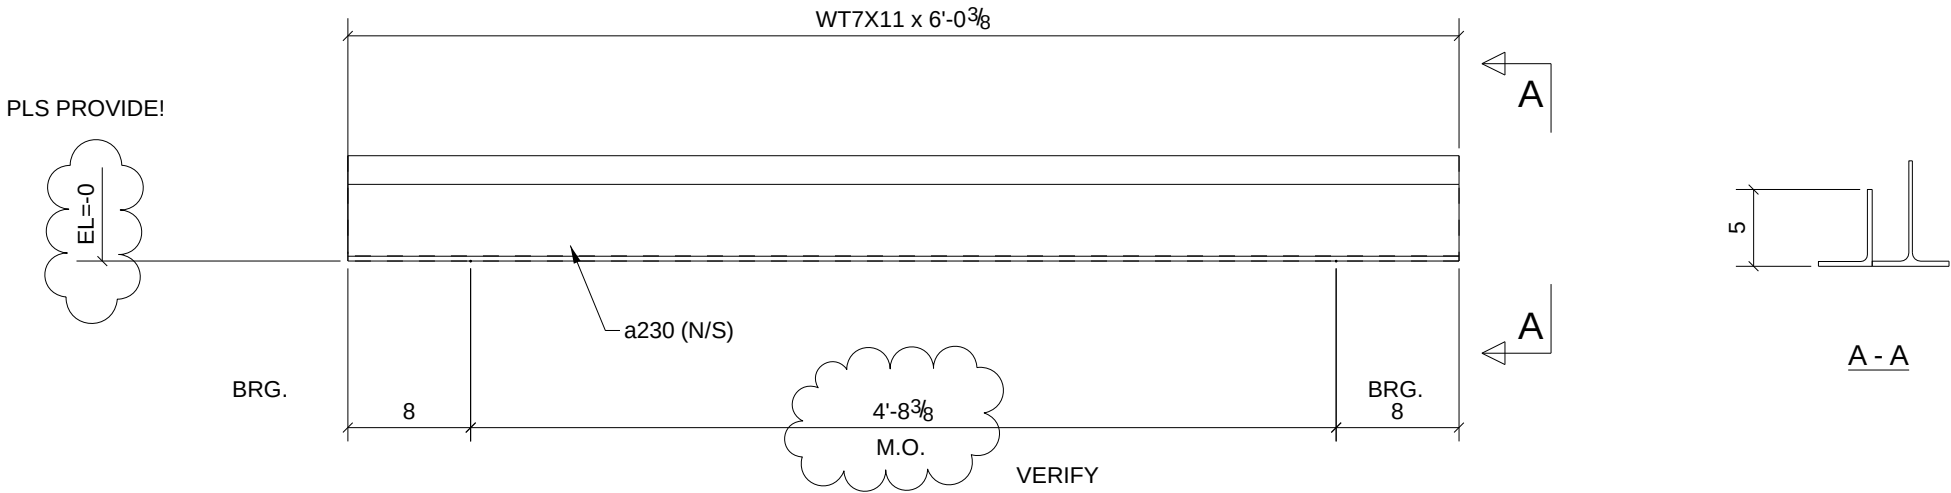

(2212)
(2214)
(2216)
(2217)
(2232)
(2233)
(2235)
(2238)

L-10 (M.O.=4'-8-3/8") LOCATION

ARCH./ENG/OWNER
PLEASE VERIFY / PROVIDE
TYPE & LOCATIONS
ERECTOR / GC ~ PLEASE
VERIFY / PROVIDE
M.O. @ EACH LOCATION

PHASE				
1	2	3	4	5
16	0	0	0	0


16 - LINTELS - 12L16

(1 ANGLE/1 TEE EACH LINTEL)

BILL OF MATERIAL

SHIP	MARK	NO PCS	DESCRIPTION	LENGTH	PIECE MARK	REMARKS
16	12L16	16	WT7X11	6'-0 3/8"		SQ-2 A36 GALVANIZED
		16	L5X3-1/2X5/16	6'-0 3/8"	a230	A36 GALVANIZED

A	For Approval		7/23/10	TMc	TAN
REV.	DESCRIPTION		DATE	DWN	CHK
GENERAL NOTES			JOB USE		
			SHOP		
MATERIAL: A992 / A36		ELECTRODES: E70XX LH	REF. DRG.		
HOLES: 13/16 DIA. U/N		CONN'S.: -			
SURFACE PREP. SS-SP-2			APPROVAL		
AND PAINT: GREY PRIMER DEVOE NA-195 (U.N.)					
DESCRIPTION: LINTEL					
PROJECT NAME		Hamilton High School Phase III			
LOCATION		Hamilton City School District - Hamilton			
CONTRACTOR		GC Contracting			
	Avenue Fabricating Inc. 1281 Clough Pike Batavia, OH 45103 (513) 752-1911		DRAWN BY TMc		DATE 07/23/2010
			CHKD. BY TAN		DATE
			JOB No. 10-16		DRG. No. 12L16

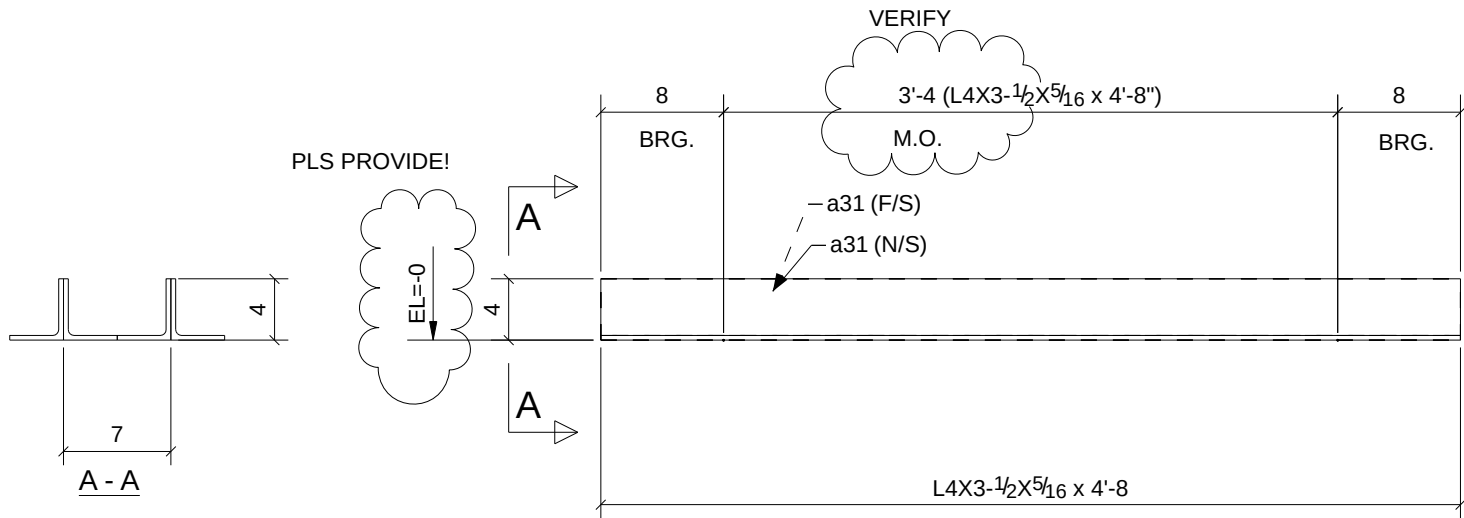

L-11 (M.O.=3'-4") LOCATION (2242A)
(2202)

ARCH./ENG/OWNER
PLEASE VERIFY / PROVIDE
TYPE & LOCATIONS
ERECTOR / GC ~ PLEASE
VERIFY / PROVIDE
M.O. @ EACH LOCATION

PHASE				
1	2	3	4	5
2	0	0	0	0


2 - LINTELS - 12L17

(4 ANGLES EACH LINTEL)

BILL OF MATERIAL

SHIP	MARK	NO PCS	DESCRIPTION	LENGTH	PIECE MARK	REMARKS
2	12L17	2	L4X3-1/2X5/16	4'-8"		SQ-2 A36 1 S/C STD PRIMER
		6	L4X3-1/2X5/16	4'-8"	a31	A36 1 S/C STD PRIMER

A	For Approval	7/23/10	TMc	TAN
REV.	DESCRIPTION	DATE	DWN	CHK
GENERAL NOTES		JOB USE		
MATERIAL: A992 / A36	ELECTRODES: E70XX LH	REF. DRG.	SHOP	
HOLES: 13/16 DIA. U/N	CONN'S.: -			
SURFACE PREP. SS-SP-2	AND PAINT: GREY PRIMER DEVOE NA-195 (U.N,)		APPROVAL	
DESCRIPTION:	LINTEL			
PROJECT NAME	Hamilton High School Phase III			
LOCATION	Hamilton City School District - Hamilton			
CONTRACTOR	GC Contracting			
	Avenue Fabricating Inc. 1281 Clough Pike Batavia, OH 45103 (513) 752-1911	DRAWN BY TMc	DATE 07/23/2010	
		CHKD. BY TAN	DATE	
		JOB No. 10-16	DRG. No. 12L17	REV. 1

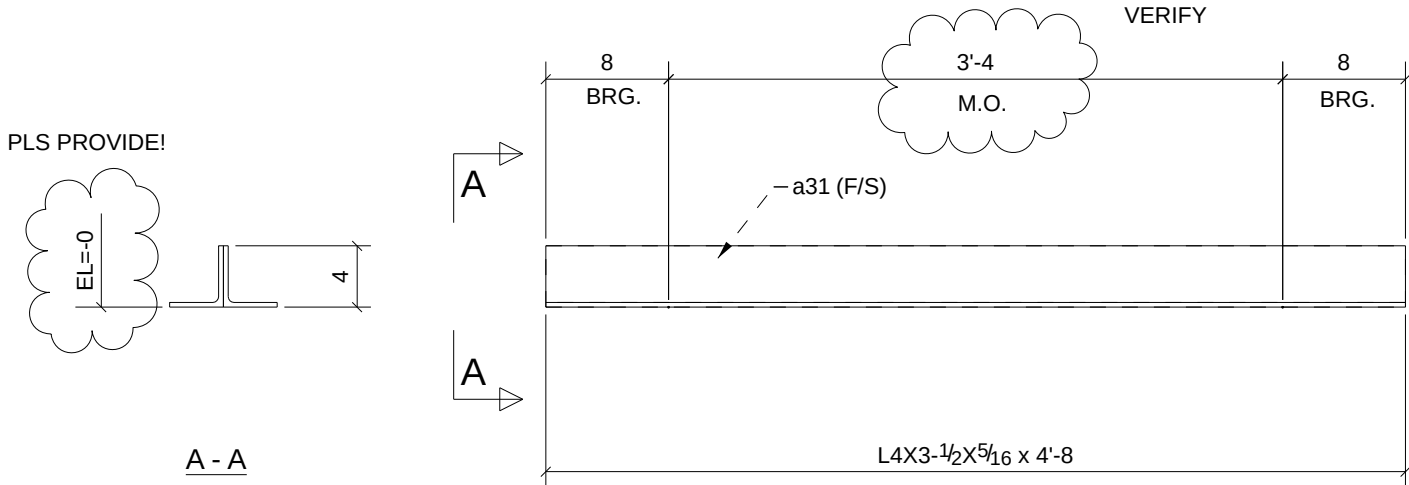

(2213A)
(2214)
(2215A)
(2216)
(2233)
(2234)
(2235)
(2236)

L-4 (M.O.=3'-4") LOCATION (

ARCH./ENG/OWNER
PLEASE VERIFY / PROVIDE
TYPE & LOCATIONS
ERECTOR / GC ~ PLEASE
VERIFY / PROVIDE
M.O. @ EACH LOCATION

PHASE				
1	2	3	4	5
8	0	0	0	0

8 - LINTELS - 12L21



(2 ANGLES EACH LINTEL)

BILL OF MATERIAL

SHIP	MARK	NO PCS	DESCRIPTION	LENGTH	PIECE MARK	REMARKS
8	12L21	8	L4X3-1/2X5/16	4'-8"		SQ-2 A36 1 S/C STD PRIMER
		8	L4X3-1/2X5/16	4'-8"	a31	A36 1 S/C STD PRIMER

A	For Approval	7/23/10	TMc	TAN
REV.	DESCRIPTION	DATE	DWN	CHK
GENERAL NOTES		JOB USE		
MATERIAL: A992 / A36	ELECTRODES: E70XX LH	REF. DRG.	SHOP	
HOLES: 13/16 DIA. U/N	CONN'S.: -		APPROVAL	
SURFACE PREP. SS-PC-SP-2				
AND PAINT: GREY PRIMER DEVOE NA-195 (U.N.)				
DESCRIPTION: LINTEL				
PROJECT NAME		Hamilton High School Phase III		
LOCATION		Hamilton City School District - Hamilton		
CONTRACTOR		GC Contracting		
		DRAWN BY TMc	DATE 07/23/2010	
		CHKD. BY TAN	DATE	
		JOB No. 10-16	DRG. No. 12L21	REV. 1

Avenue Fabricating Inc.
1281 Clough Pike
Batavia, OH 45103
(513) 752-1911

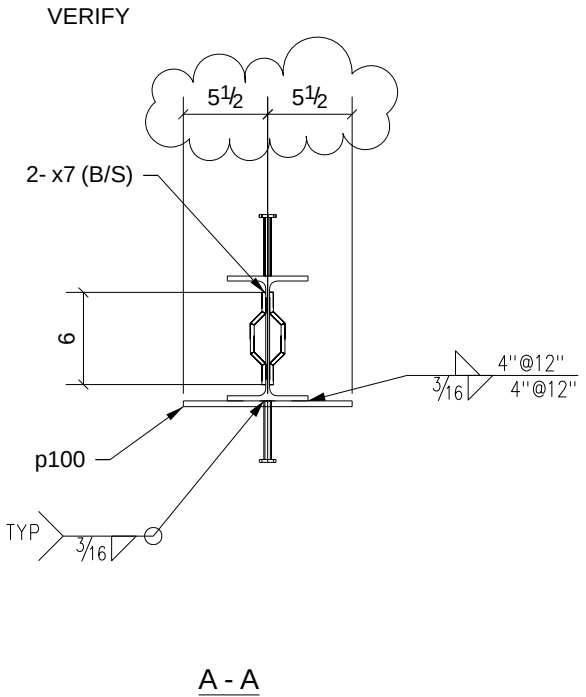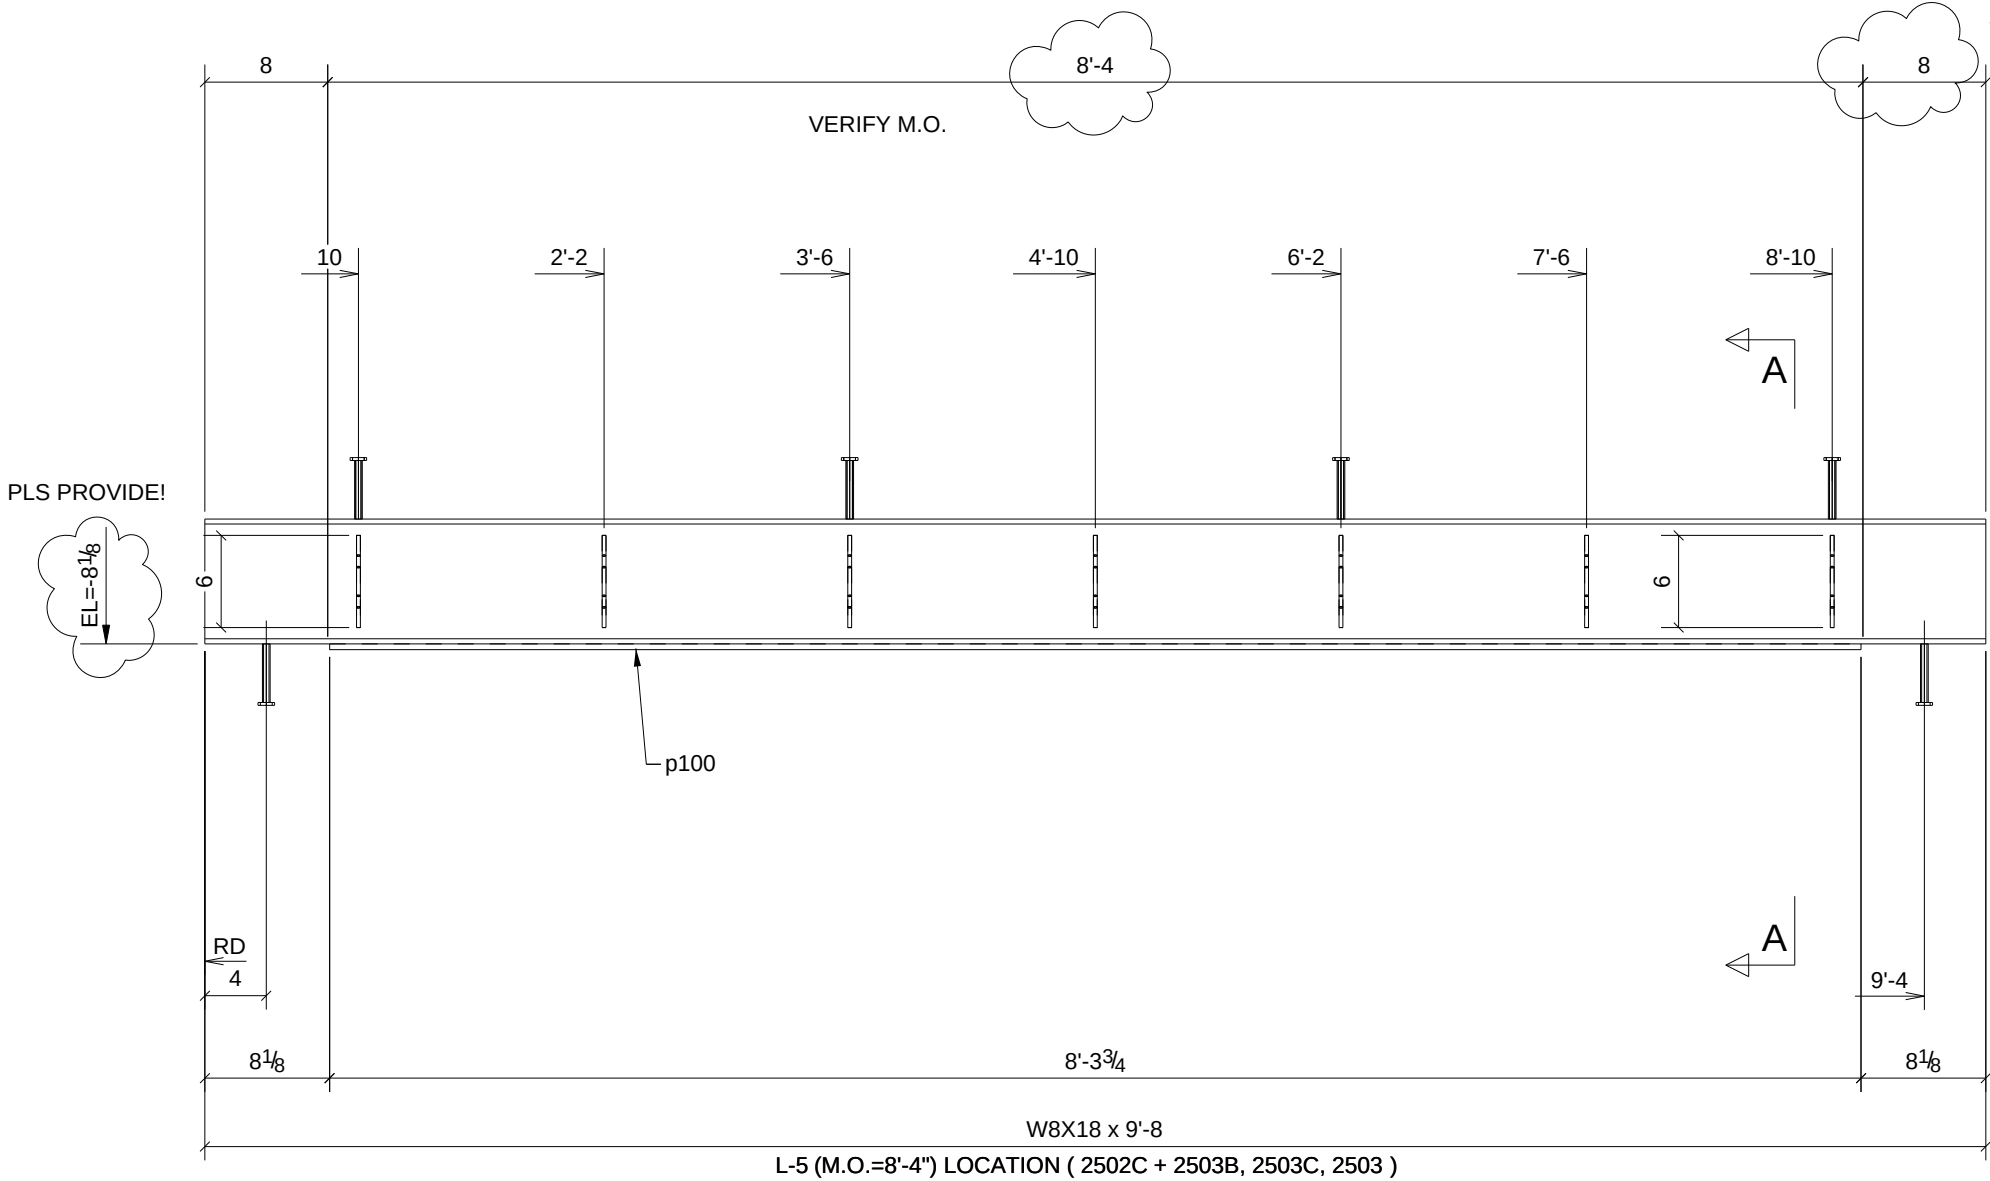

PHASE				
1	2	3	4	5
4	0	0	0	0


4 - LINTELS - 12L25

W	8 1/8"x1/4"
F	5 1/4"x5/16"

BILL OF MATERIAL

SHIP	MARK	NO PCS	DESCRIPTION	LENGTH	PIECE MARK	REMARKS
4	12L25	4	W8X18	9'-8"		SQ-2 A992 1 S/C STD PRIMER
		4	BAR3/8"X11"	8'-3 3/4"	p100	A36 1 S/C STD PRIMER
		56	H&B #359	0'-6 3/16"	x7	A36 1 S/C STD PRIMER
		24	STUD 1/2" DIA	0'-4"		

A	For Approval		7/23/10	TMc	TAN
REV.	DESCRIPTION		DATE	DWN	CHK
GENERAL NOTES			JOB USE		
MATERIAL: A992 / A36	ELECTRODES: E70XX LH	REF. DRG.	SHOP		
HOLES: 13/16 DIA. U/N	CONN'S.: -				
SURFACE PREP. SSPC-SP-2 AND PAINT: GREY PRIMER DEVOE NA-195 (U.N.)			APPROVAL		
DESCRIPTION: LINTEL					
PROJECT NAME	Hamilton High School Phase III				
LOCATION	Hamilton City School District - Hamilton				
CONTRACTOR	GC Contracting				
	Avenue Fabricating Inc. 1281 Clough Pike Batavia, OH 45103 (513) 752-1911		DRAWN BY TMc	DATE 07/23/2010	
			CHKD. BY TAN	DATE	
			JOB No. 10-16	DRG. No. 12L25	REV. 1

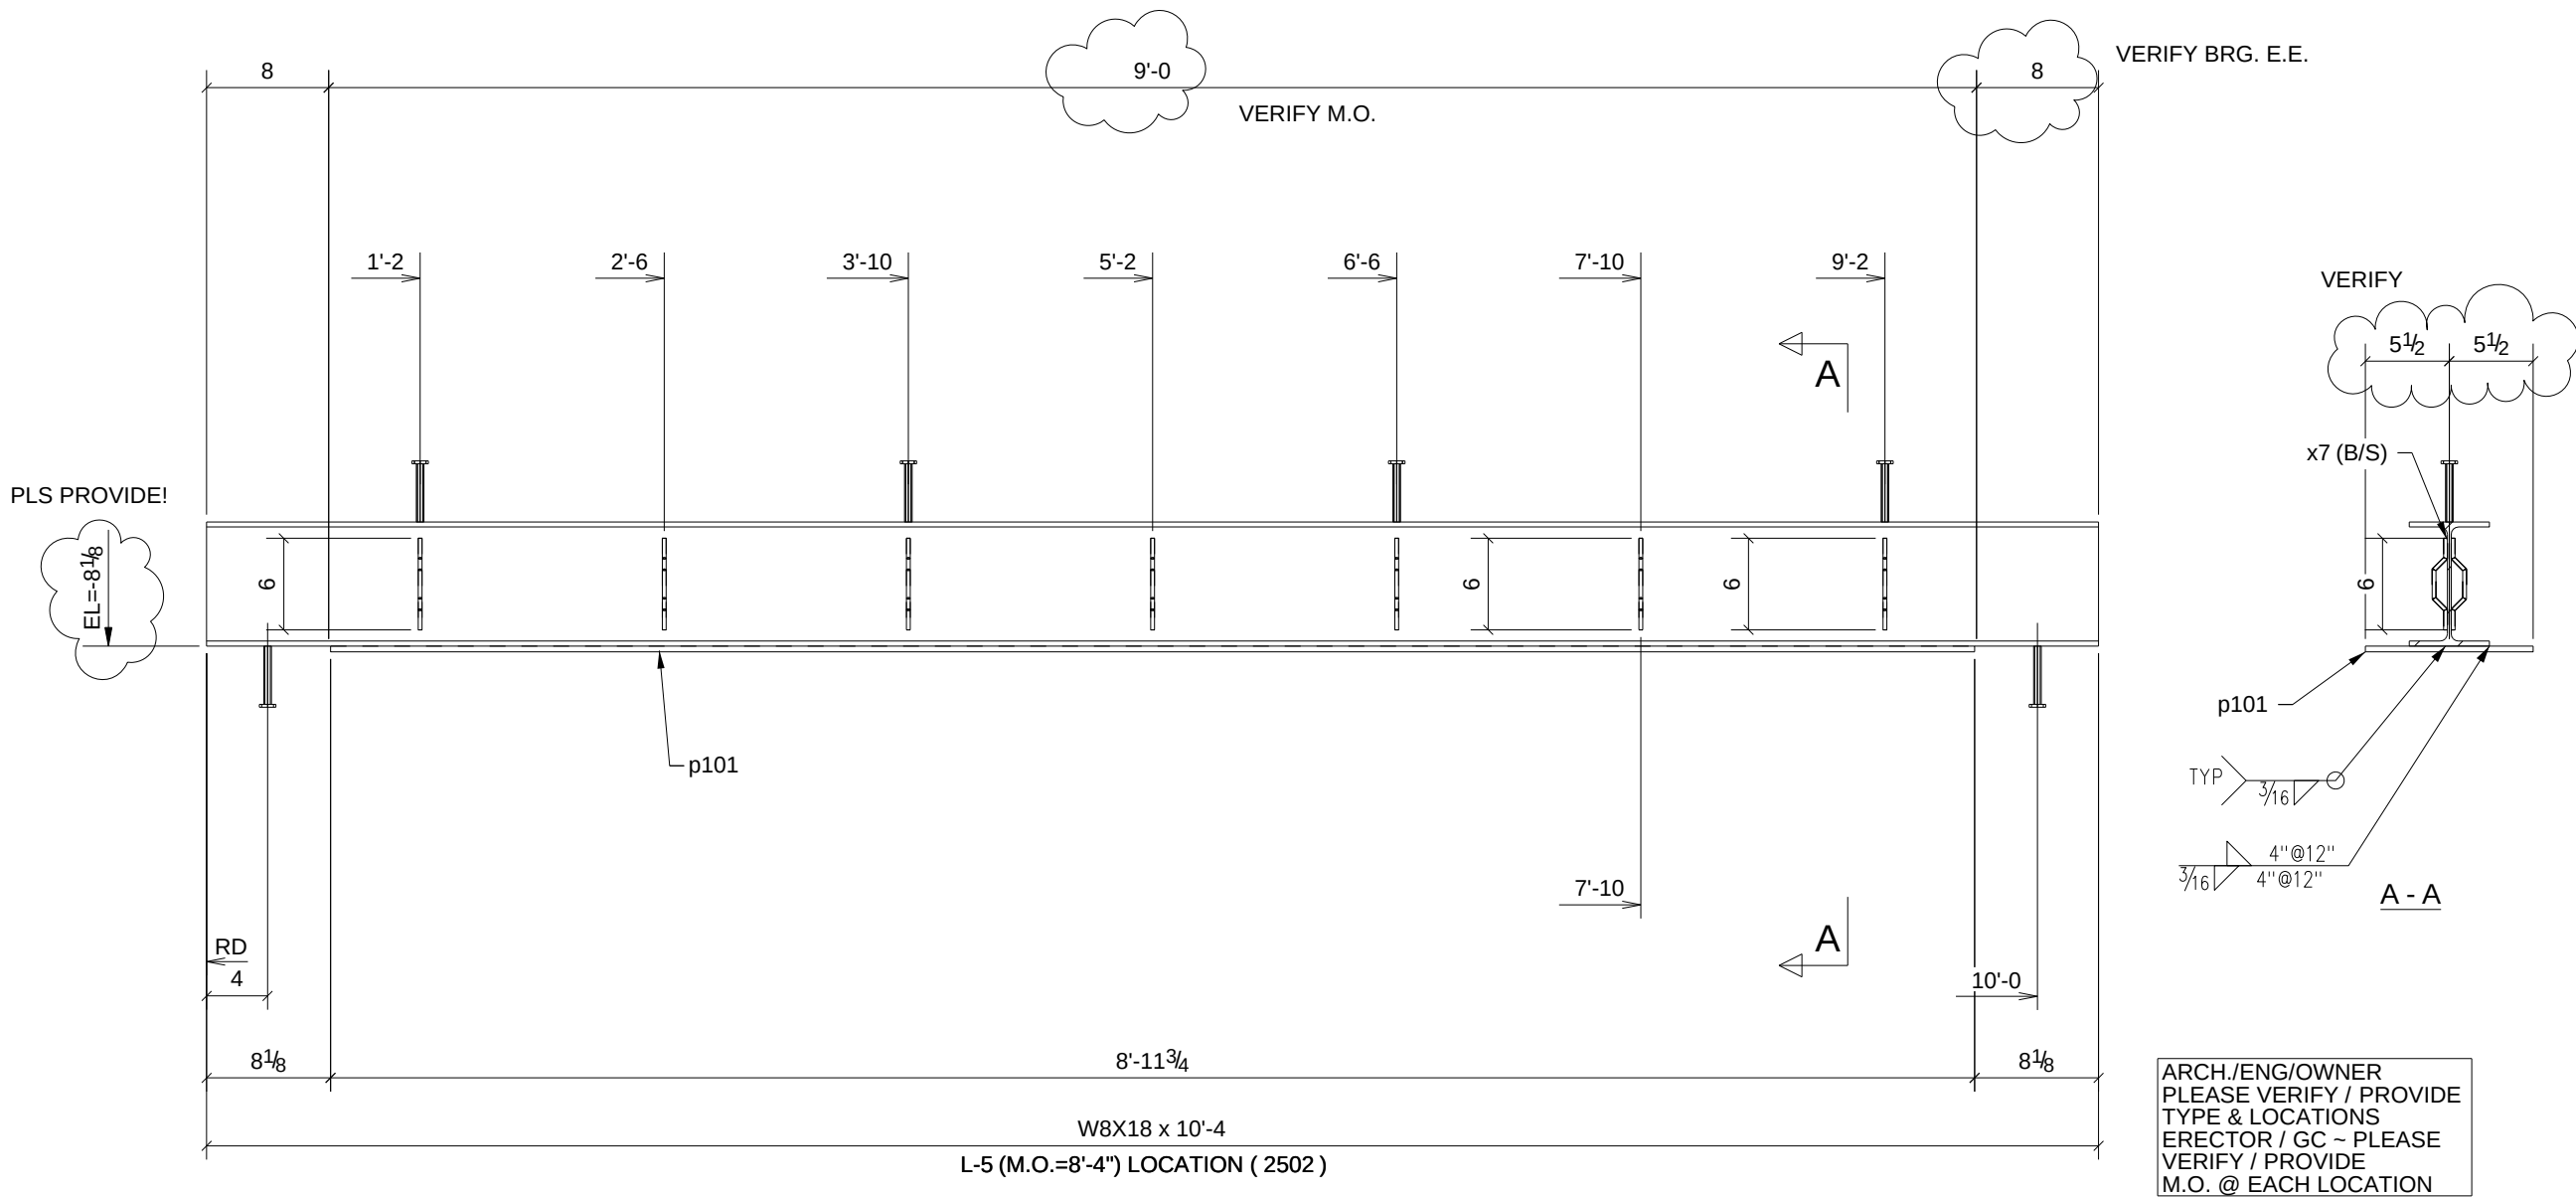

ARCH./ENG/OWNER
PLEASE VERIFY / PROVIDE
TYPE & LOCATIONS
ERECTOR / GC ~ PLEASE
VERIFY / PROVIDE
M.O. @ EACH LOCATION

PHASE				
1	2	3	4	5
1	0	0	0	0


ONE - LINTEL - 12L26

W	8 1/8" x 1/4"
F	5 1/4" x 5/16"

BILL OF MATERIAL

SHIP	MARK	NO PCS	DESCRIPTION	LENGTH	PIECE MARK	REMARKS
1	12L26	1	W8X18	10'-4"		SQ-2 A992 1 S/C STD PRIMER
		1	BAR3/8"X11"	8'-11 3/4"	p101	A36 1 S/C STD PRIMER
		14	H&B #359	0'-6 3/16"	x7	A36 1 S/C STD PRIMER
		6	STUD 1/2" DIA	0'-4"		


A	For Approval		7/23/10	TMc	TAN
REV.	DESCRIPTION		DATE	DWN	CHK
GENERAL NOTES			JOB USE		
MATERIAL: A992 / A36		ELECTRODES: E70XX LH	REF. DRG.		
HOLES: 13/16 DIA. U/N		CONN'S.: -		SHOP	
SURFACE PREP. SSPC-SP-2 AND PAINT: GREY PRIMER DEVOE NA-195 (U.N.)			APPROVAL		
DESCRIPTION: LINTEL					
PROJECT NAME		Hamilton High School Phase III			
LOCATION		Hamilton City School District - Hamilton			
CONTRACTOR		GC Contracting			
	Avenue Fabricating Inc. 1281 Clough Pike Batavia, OH 45103 (513) 752-1911		DRAWN BY TMc		DATE 07/23/2010
			CHKD. BY TAN		DATE
			JOB No. 10-16		DRG. No. 12L26

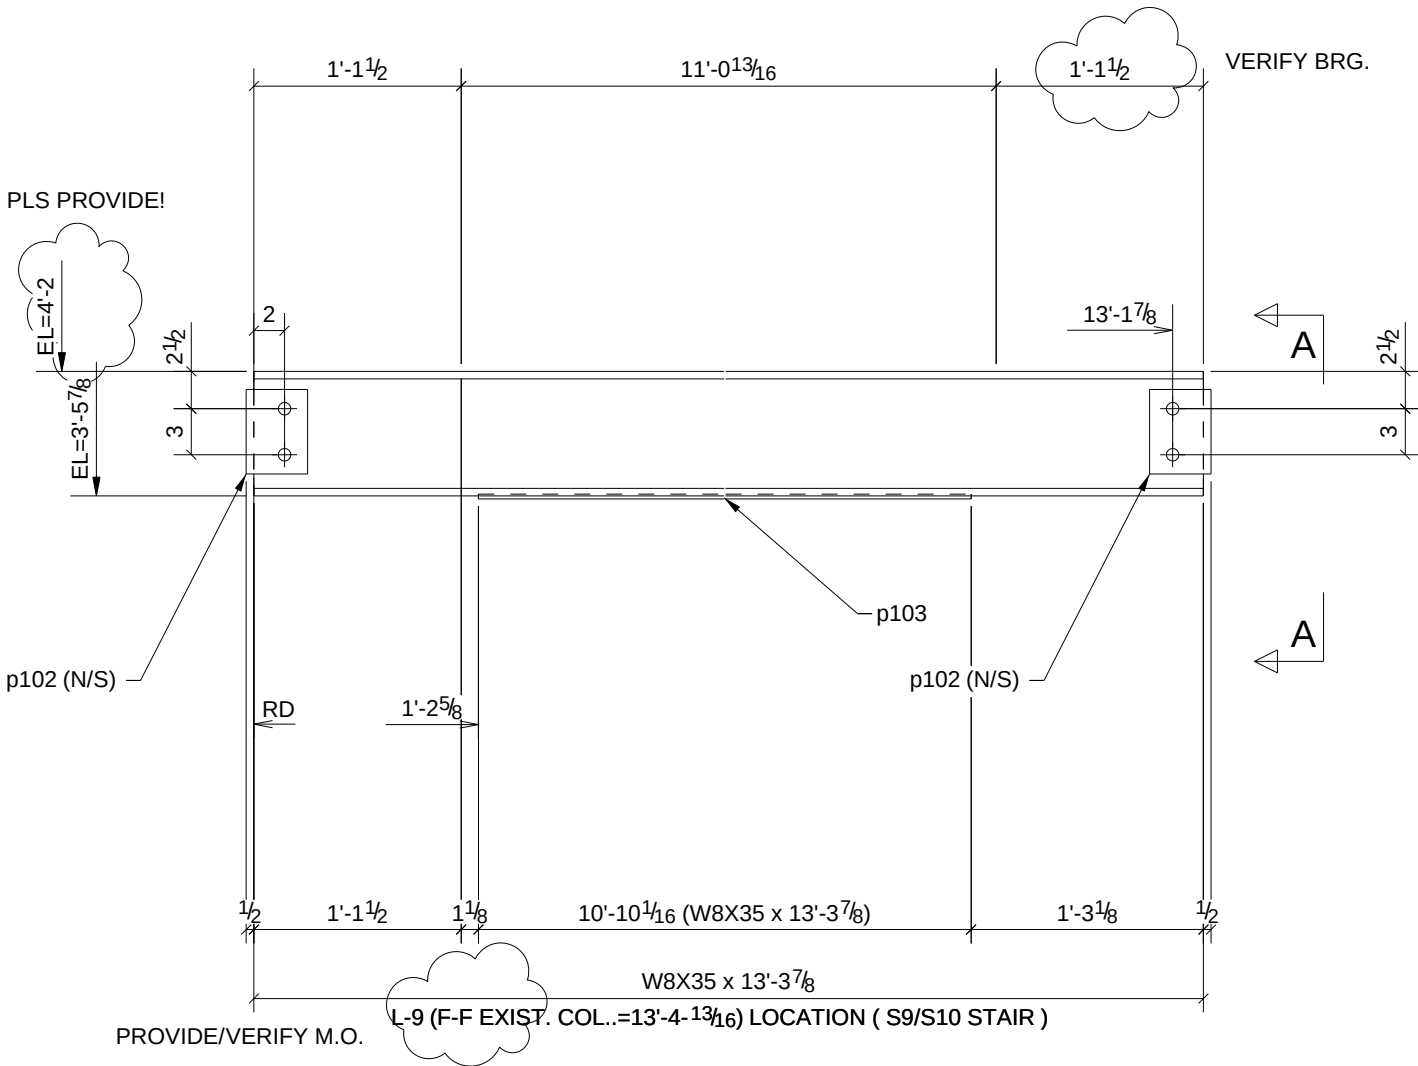

PLS PROVIDE!

VERIFY BRG.

VERIFY
PLATE SIZE
& POSITION
PER LINTEL SCHEDULE?

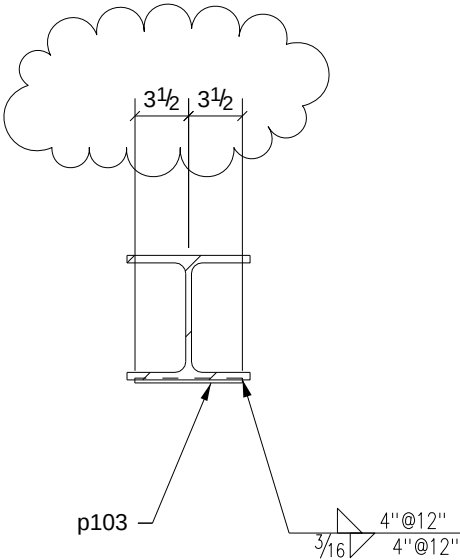

A - A

ONE - LINTEL - 12L27



PHASE				
1	2	3	4	5
1	0	0	0	0

W	8 1/8"x1/4"
F	8"x1/2"

BILL OF MATERIAL

SHIP	MARK	NO PCS	DESCRIPTION	LENGTH	PIECE MARK	REMARKS
1	12L27	1	W8X35	13'-3 7/8"		SQ-2 A992
		2	BAR3/8"X4"	0'-5 1/2"	p102	A36
		1	BAR5/16"X7"	10'-10 1/16"	p103	A36 GALVANIZED
		4	3/4"Ø A325N BOLT	0'-2"		

A	For Approval		7/23/10	TMc	TAN
REV.	DESCRIPTION		DATE	DWN	CHK
GENERAL NOTES			JOB USE		
MATERIAL: A992 / A36		ELECTRODES: E70XX LH	REF. DRG.		
HOLES: 13/16 DIA. U/N		CONN'S.: -		SHOP	
SURFACE PREP. SSPC-SP-2 AND PAINT: GREY PRIMER DEVOE NA-195 (U.N.)			APPROVAL		
DESCRIPTION: LINTEL					
PROJECT NAME		Hamilton High School Phase III			
LOCATION		Hamilton City School District - Hamilton			
CONTRACTOR		GC Contracting			
	Avenue Fabricating Inc. 1281 Clough Pike Batavia, OH 45103 (513) 752-1911		DRAWN BY TMc		DATE 07/25/2010
			CHKD. BY TAN		DATE
			JOB No. 10-16		DRG. No. 12L27

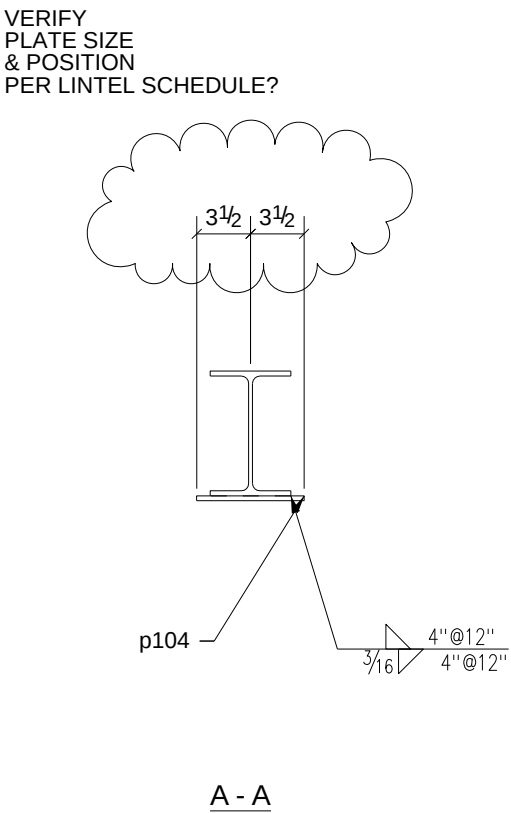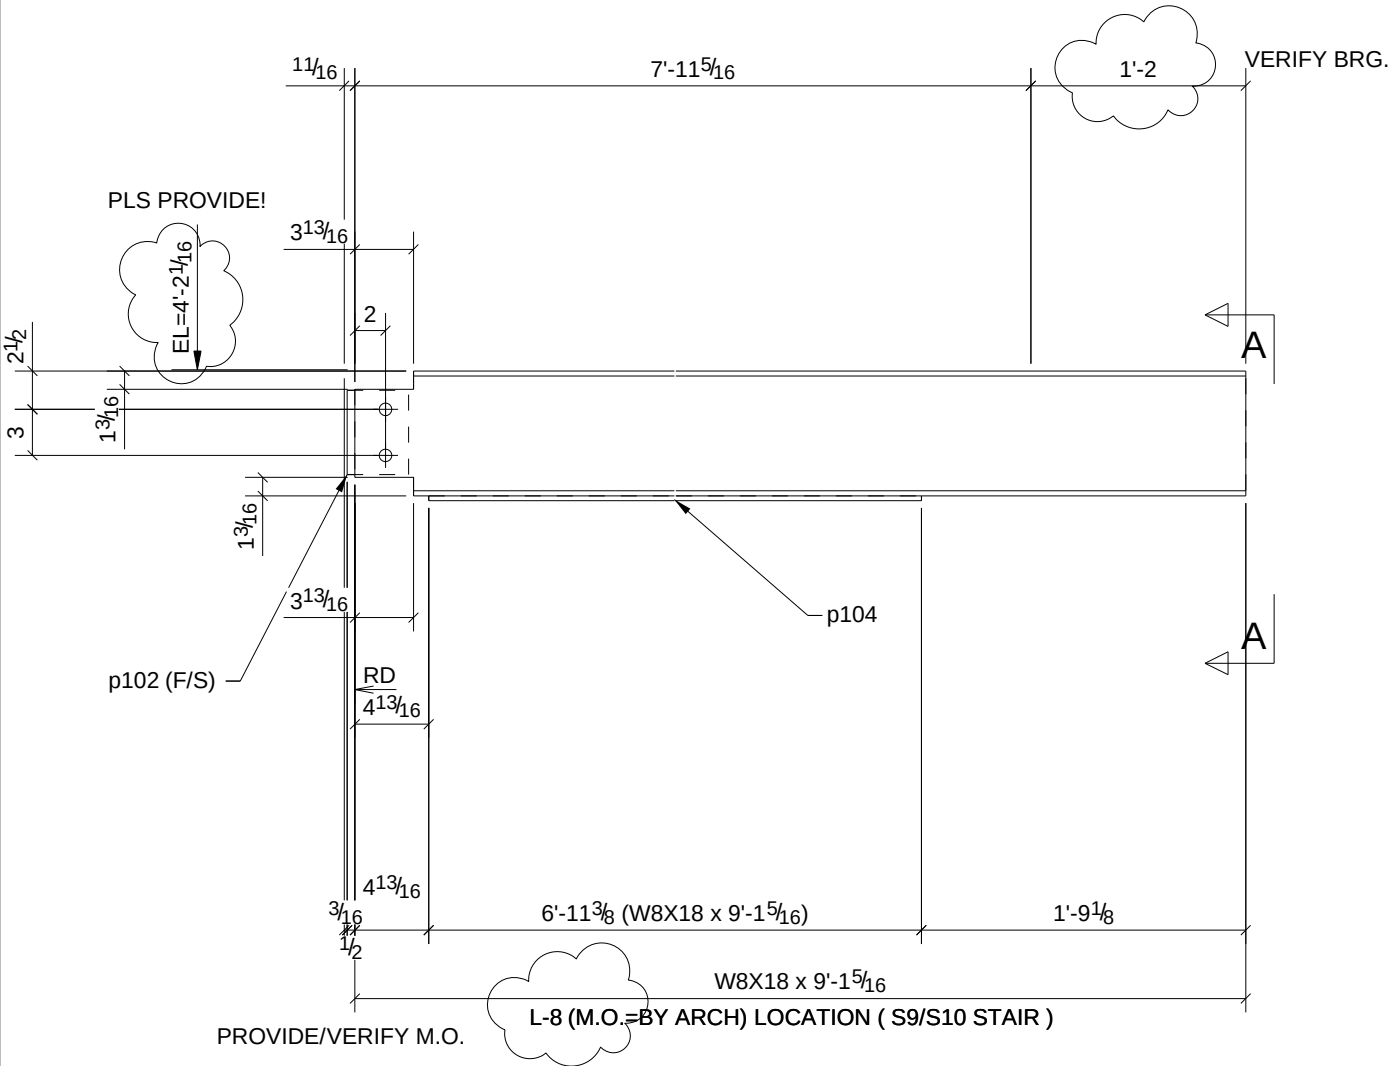


PHASE				
1	2	3	4	5
1	0	0	0	0

ONE - LINTEL - 12L40

W	8 1/8" x 1/4"
F	5 1/4" x 5/16"

BILL OF MATERIAL						
SHIP	MARK	NO PCS	DESCRIPTION	LENGTH	PIECE MARK	REMARKS
1	12L40	1	W8X18	9'-1 5/16"		SQ-2 A992
		1	BAR3/8"X4"	0'-5 1/2"	p102	A36
		1	BAR5/16"X7"	6'-11 3/8"	p104	A36 GALVANIZED
		2	3/4"Ø A325N BOLT	0'-1 3/4"		


A	For Approval			7/23/10	TMc	TAN
REV.	DESCRIPTION			DATE	DWN	CHK
GENERAL NOTES				JOB USE		
MATERIAL: A992 / A36		ELECTRODES: E70XX LH	REF. DRG.	SHOP		
HOLES: 13/16 DIA. U/N		CONN'S.: -				
SURFACE PREP. SSPC-SP-2 AND PAINT: GREY PRIMER DEVOE NA-195 (U.N.)				APPROVAL		
DESCRIPTION: LINTEL						
PROJECT NAME		Hamilton High School Phase III				
LOCATION		Hamilton City School District - Hamilton				
CONTRACTOR		GC Contracting				
	Avenue Fabricating Inc. 1281 Clough Pike Batavia, OH 45103 (513) 752-1911			DRAWN BY TMc		DATE 07/25/2010
				CHKD. BY TAN		DATE
				JOB No. 10-16		DRG. No. 12L40

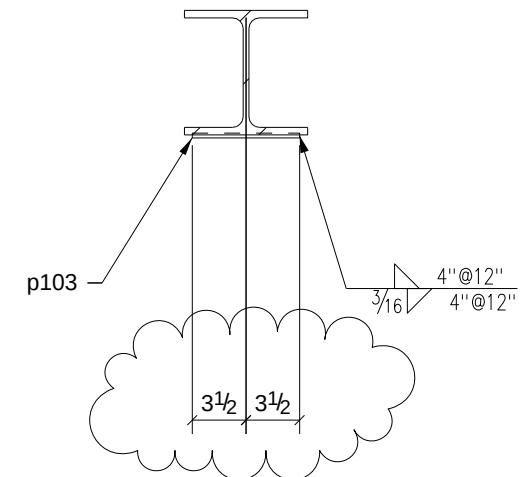


A - A

W	8 1/8" x 1/4"
F	8" x 1/2"

A	For Approval	7/23/10	TMc	TAN
REV.	DESCRIPTION	DATE	DWN	CHK
GENERAL NOTES		JOB USE		
MATERIAL: A992 / A36	ELECTRODES: E70XX LH	SHOP		
HOLES: 13/16 DIA. U/N	CONN'S.: -			
SURFACE PREP. SSPC-SP-2 AND PAINT: GREY PRIMER DEVOE NA-195 (U.N.)		APPROVAL		
DESCRIPTION: LINTEL				
PROJECT NAME	Hamilton High School Phase III			
LOCATION	Hamilton City School District - Hamilton			
CONTRACTOR	GC Contracting			
	Avenue Fabricating Inc. 1281 Clough Pike Batavia, OH 45103 (513) 752-1911	DRAWN BY TMc	DATE 07/25/2010	
		CHKD. BY TAN	DATE	
		JOB No. 10-16	DRG. No. 12L41	REV. 1

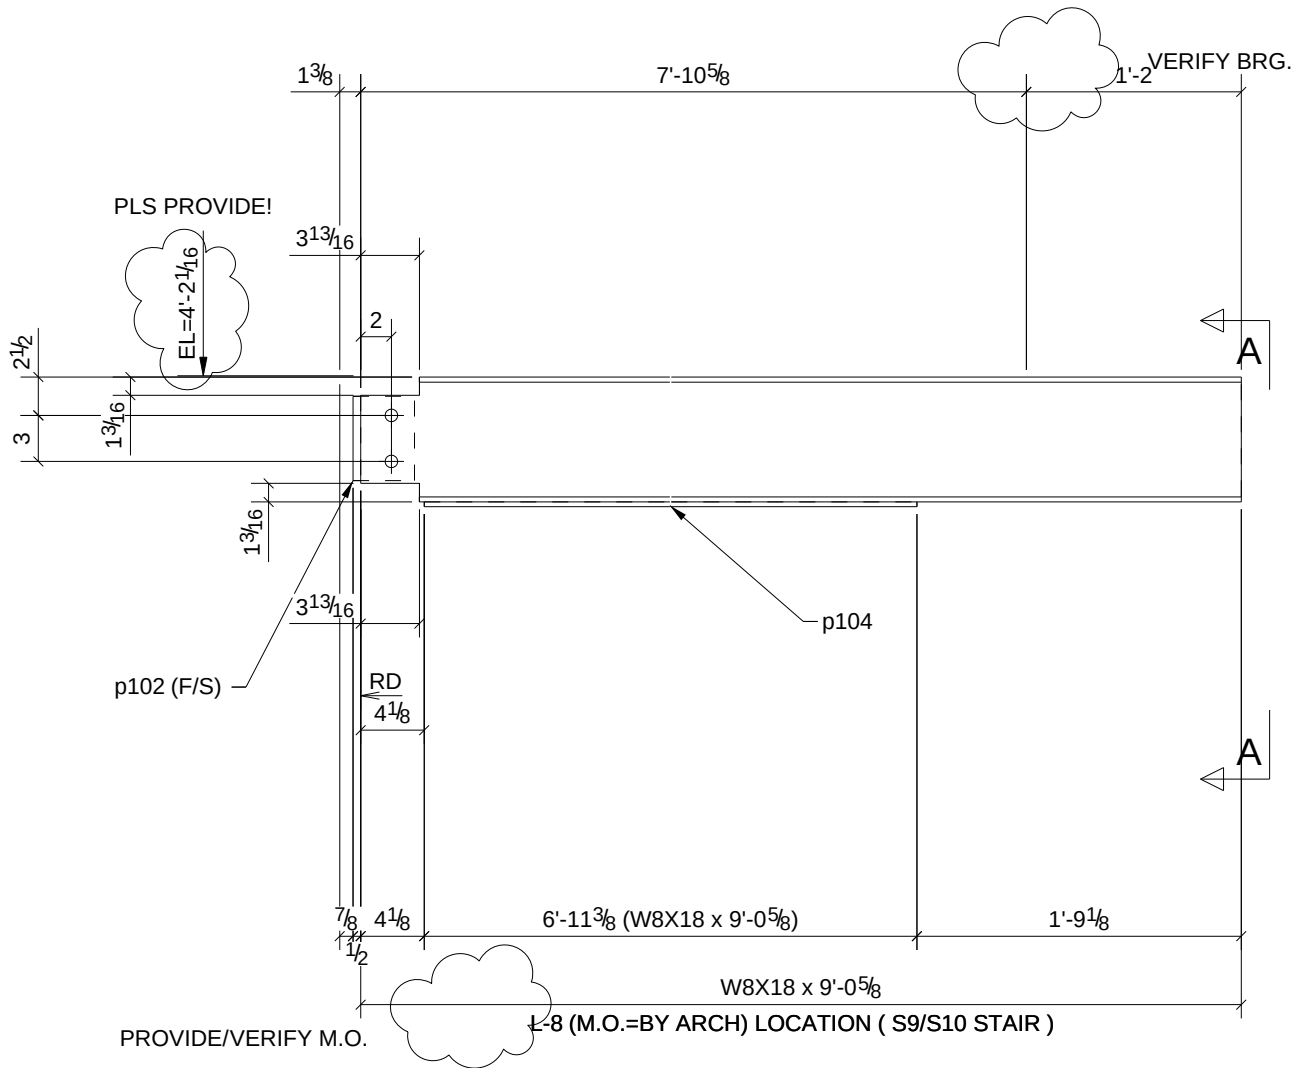

VERIFY
PLATE SIZE
& POSITION
PER LINTEL SCHEDULE?

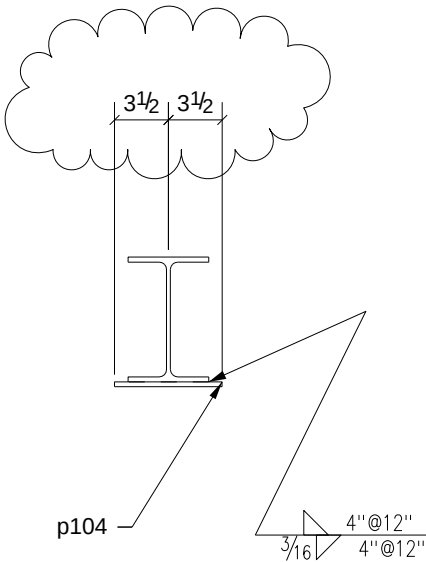

A - A

PHASE				
1	2	3	4	5
1	0	0	0	0


ONE - LINTEL - 12L43

W	8 1/8"x1/4"
F	5 1/4"x5/16"

BILL OF MATERIAL

SHIP	MARK	NO PCS	DESCRIPTION	LENGTH	PIECE MARK	REMARKS
1	12L43	1	W8X18	9'-0 5/8"		SQ-2 A992
		1	BAR3/8"X4"	0'-5 1/2"	p102	A36
		1	BAR5/16"X7"	6'-11 3/8"	p104	A36 GALVANIZED
		2	3/4"Ø A325N BOLT	0'-1 3/4"		

A	For Approval		7/23/10	TMc	TAN
REV.	DESCRIPTION		DATE	DWN	CHK
GENERAL NOTES			JOB USE		
MATERIAL: A992 / A36		ELECTRODES: E70XX LH	REF. DRG.		
HOLES: 13/16 DIA. U/N		CONN'S.: -		SHOP	
SURFACE PREP. SSPC-SP-2			APPROVAL		
AND PAINT: GREY PRIMER DEVOE NA-195 (U.N.)					
DESCRIPTION: LINTEL					
PROJECT NAME		Hamilton High School Phase III			
LOCATION		Hamilton City School District - Hamilton			
CONTRACTOR		GC Contracting			
	Avenue Fabricating Inc. 1281 Clough Pike Batavia, OH 45103 (513) 752-1911		DRAWN BY TMc		DATE 07/25/2010
			CHKD. BY TAN		DATE
			JOB No. 10-16		DRG. No. 12L43

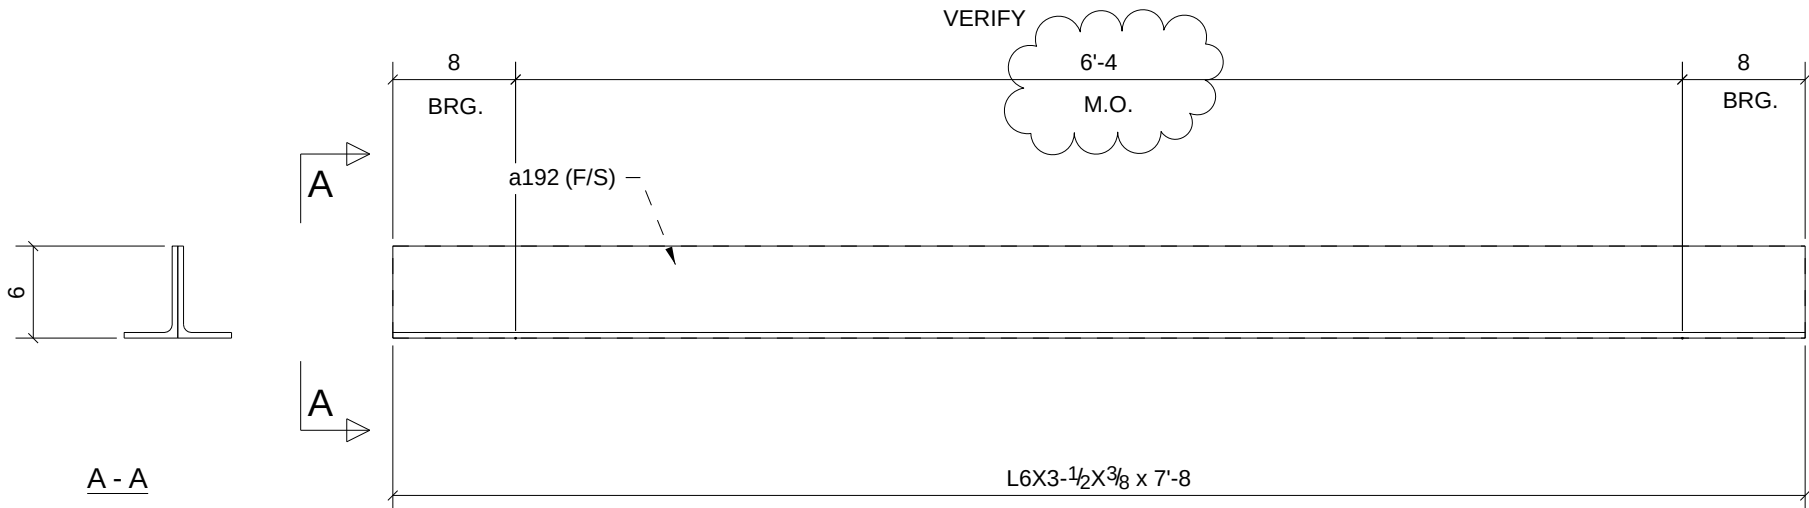

L-6 (M.O.=6'-0³/₁₆) LOCATION (2009)
(2005)

ARCH./ENG/OWNER
PLEASE VERIFY / PROVIDE
TYPE & LOCATIONS
ERECTOR / GC ~ PLEASE
VERIFY / PROVIDE
M.O. @ EACH LOCATION

PHASE				
1	2	3	4	5
2	0	0	0	0


2 - LINTELS - 12L7

(3 ANGLES EACH LINTEL)

BILL OF MATERIAL

SHIP	MARK	NO PCS	DESCRIPTION	LENGTH	PIECE MARK	REMARKS
2	12L7	2	L6X3-1/2X3/8	7'-8"		SQ-2 A36 1 S/C STD PRIMER
		2	L6X3-1/2X3/8	7'-8"	a192	A36 1 S/C STD PRIMER

A	For Approval			7/23/10	TMc	TAN
REV.	DESCRIPTION			DATE	DWN	CHK
GENERAL NOTES				JOB USE		
MATERIAL: A992 / A36		ELECTRODES: E70XX LH		REF. DRG.		
HOLES: 13/16 DIA. U/N		CONN'S.: -			SHOP	
SURFACE PREP. SS-PC-SP-2				APPROVAL		
AND PAINT: GREY PRIMER DEVOE NA-195 (U.N,)						
DESCRIPTION: LINTEL						
PROJECT NAME		Hamilton High School Phase III				
LOCATION		Hamilton City School District - Hamilton				
CONTRACTOR		GC Contracting				
	Avenue Fabricating Inc. 1281 Clough Pike Batavia, OH 45103 (513) 752-1911			DRAWN BY TMc		DATE 07/23/2010
				CHKD. BY TAN		DATE
				JOB No. 10-16		DRG. No. 12L7

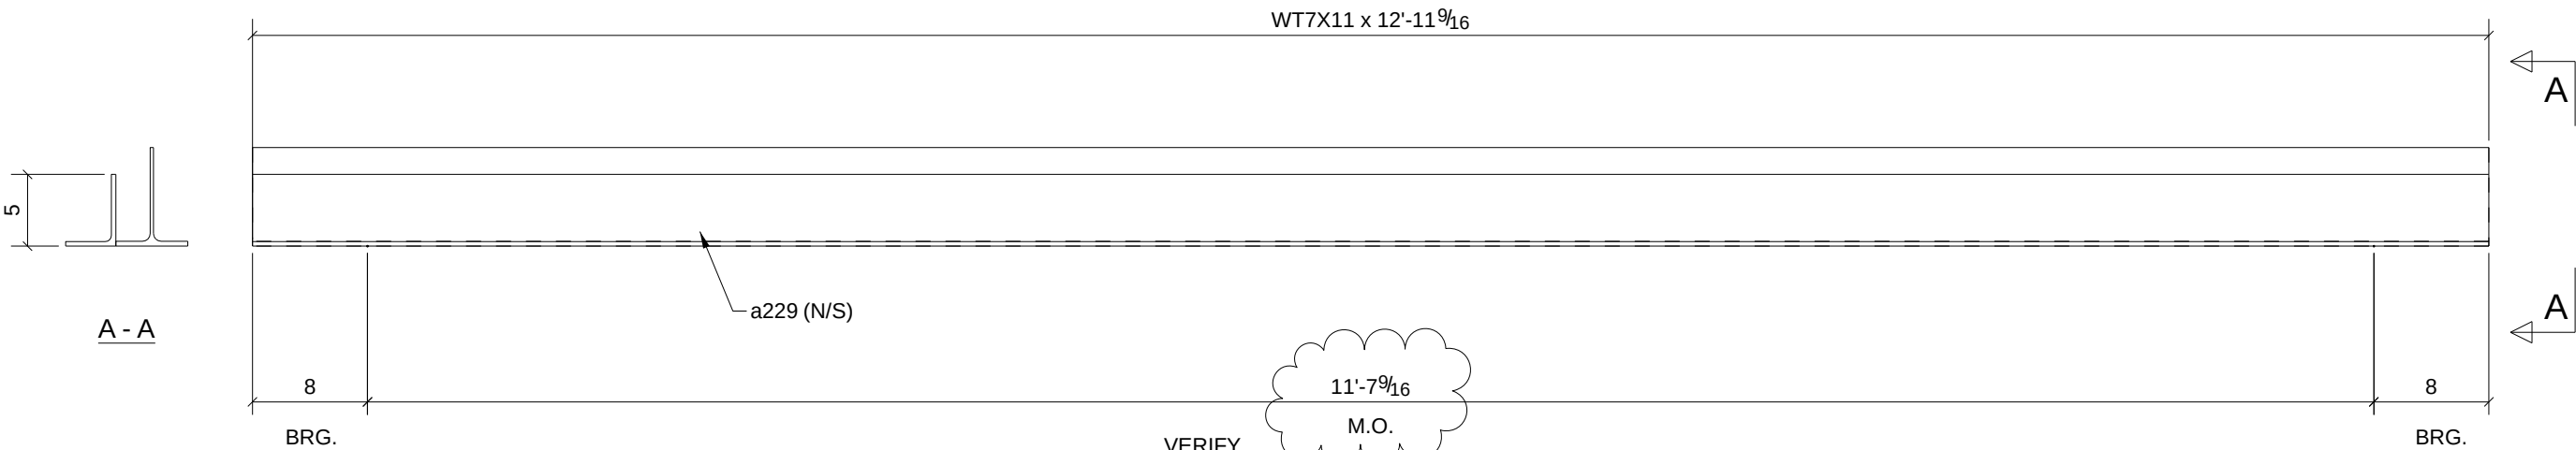

L-10 (M.O.=11'-7-9/16") LOCATION (2242)
(2202)

ARCH./ENG/OWNER
PLEASE VERIFY / PROVIDE
TYPE & LOCATIONS
ERECTOR / GC ~ PLEASE
VERIFY / PROVIDE
M.O. @ EACH LOCATION

PHASE				
1	2	3	4	5
2	0	0	0	0


2 - LINTELS - 12L8

(1 ANGLE / 1 TEE EACH LINTEL)

BILL OF MATERIAL

SHIP	MARK	NO PCS	DESCRIPTION	LENGTH	PIECE MARK	REMARKS
2	12L8	2	WT7X11	12'-11 9/16"		SQ-2 A36 GALVANIZED
		2	L5X3-1/2X5/16	12'-11 9/16"	a229	A36 GALVANIZED

A	For Approval		7/23/10	TMc	TAN
REV.	DESCRIPTION		DATE	DWN	CHK
GENERAL NOTES			JOB USE		
MATERIAL: A992 / A36		ELECTRODES: E70XX LH	REF. DRG.		
HOLES: 13/16 DIA. U/N		CONN'S.: -		SHOP	
SURFACE PREP. SS-PC-SP-2			APPROVAL		
AND PAINT: GREY PRIMER DEVOE NA-195 (U.N.)					
DESCRIPTION: LINTEL					
PROJECT NAME		Hamilton High School Phase III			
LOCATION		Hamilton City School District - Hamilton			
CONTRACTOR		GC Contracting			
	Avenue Fabricating Inc. 1281 Clough Pike Batavia, OH 45103 (513) 752-1911		DRAWN BY TMc		DATE 07/23/2010
			CHKD. BY TAN		DATE
			JOB No. 10-16	DRG. No. 12L8	REV. 1

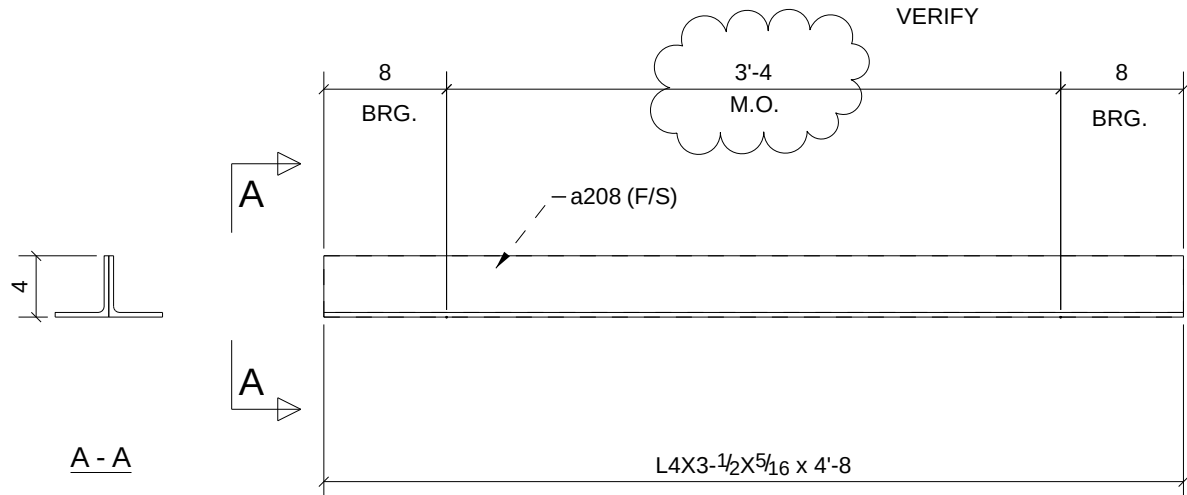

L-4 (M.O.=3'-4") LOCATION (1246)

NEAR
1022

ARCH./ENG/OWNER
PLEASE VERIFY / PROVIDE
TYPE & LOCATIONS
ERECTOR / GC ~ PLEASE
VERIFY / PROVIDE
M.O. @ EACH LOCATION

PHASE				
1	2	3	4	5
1	0	0	0	0


ONE - LINTEL - 12L9

(2 ANGLES EACH LINTEL)

BILL OF MATERIAL

SHIP	MARK	NO PCS	DESCRIPTION	LENGTH	PIECE MARK	REMARKS
1	12L9	1	L4X3-1/2X5/16	4'-8"		SQ-2 A36 GALVANIZED
		1	L4X3-1/2X5/16	4'-8"	a208	A36 GALVANIZED

A	For Approval		7/20/10	TMc	TAN	
REV.	DESCRIPTION		DATE	DWN	CHK	
GENERAL NOTES			JOB USE			
			MATERIAL: A992 / A36	ELECTRODES: E70XX LH	REF. DRG.	SHOP
HOLES: 13/16 DIA. U/N	CONN'S.: -					
SURFACE PREP. SSPC-SP-2 AND PAINT: GREY PRIMER DEVOE NA-195 (U.N,)			APPROVAL			
DESCRIPTION: LINTEL						
PROJECT NAME		Hamilton High School Phase III				
LOCATION		Hamilton City School District - Hamilton				
CONTRACTOR		GC Contracting				
	Avenue Fabricating Inc. 1281 Clough Pike Batavia, OH 45103 (513) 752-1911		DRAWN BY TMc		DATE 07/20/2010	
			CHKD. BY TAN		DATE	
			JOB No. 10-16		DRG. No. 12L9	

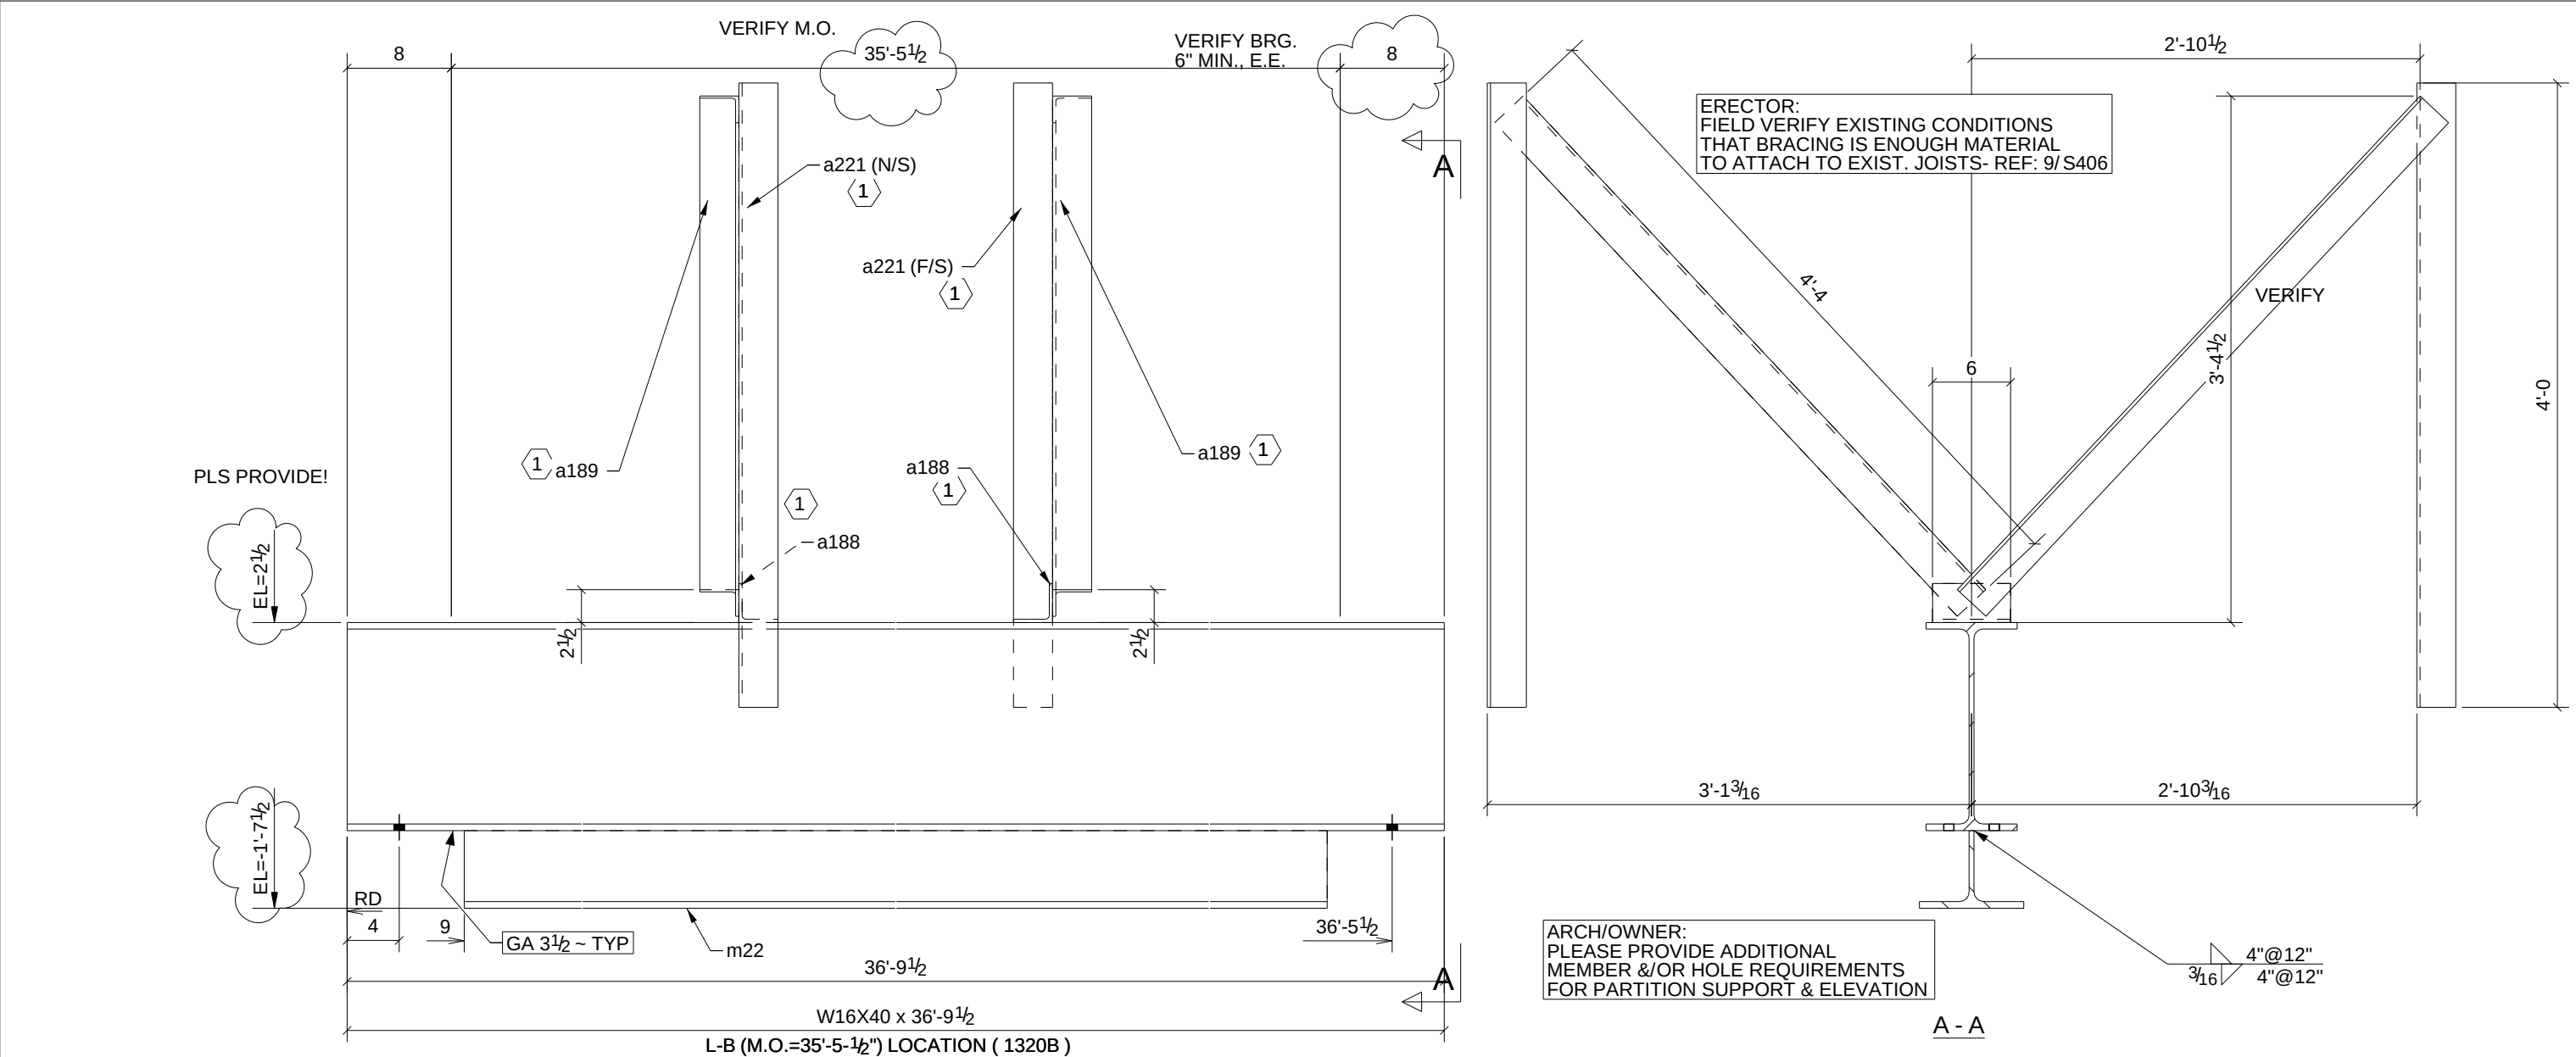

ONE - LINTEL - 22L1

PHASE				
1	2	3	4	5
0	1	0	0	0


W	16"x 1/4"
F	7"x 1/2"

1 SHOP NOTE: MARK WITH SHIP & PC MK. & SHIP LOOSE WITH BEAM

BILL OF MATERIAL

SHIP	MARK	NO PCS	DESCRIPTION	LENGTH	PIECE MARK	REMARKS
1	22L1	1	W16X40	36'-9 1/2"		SQ-2 A992 1 S/C STD PRIMER
		2	L3X3X1/4	0'-6"	a188	A36 1 S/C STD PRIMER
		2	L3X3X1/4	4'-4"	a189	A36 1 S/C STD PRIMER
		2	L3X3X1/4	4'-0"	a221	A36 1 S/C STD PRIMER
		1	WT6X20	35'-3 1/2"	m22	A36 1 S/C STD PRIMER

A	For Approval		7/20/10	TMc	TAN
REV.	DESCRIPTION		DATE	DWN	CHK
GENERAL NOTES			JOB USE		
MATERIAL: A992 / A36		ELECTRODES: E70XX LH	REF. DRG.		
HOLES: 13/16 DIA. U/N		CONN'S.: -		SHOP	
SURFACE PREP. SSPC-SP-2 AND PAINT: GREY PRIMER DEVOE NA-195 (U.N.)			APPROVAL		
DESCRIPTION: LINTEL					
PROJECT NAME		Hamilton High School Phase III			
LOCATION		Hamilton City School District - Hamilton			
CONTRACTOR		GC Contracting			
	Avenue Fabricating Inc. 1281 Clough Pike Batavia, OH 45103 (513) 752-1911		DRAWN BY TMc		DATE 07/19/2010
			CHKD. BY TAN		DATE
			JOB No. 10-16	DRG. No. 22L1	REV. 1

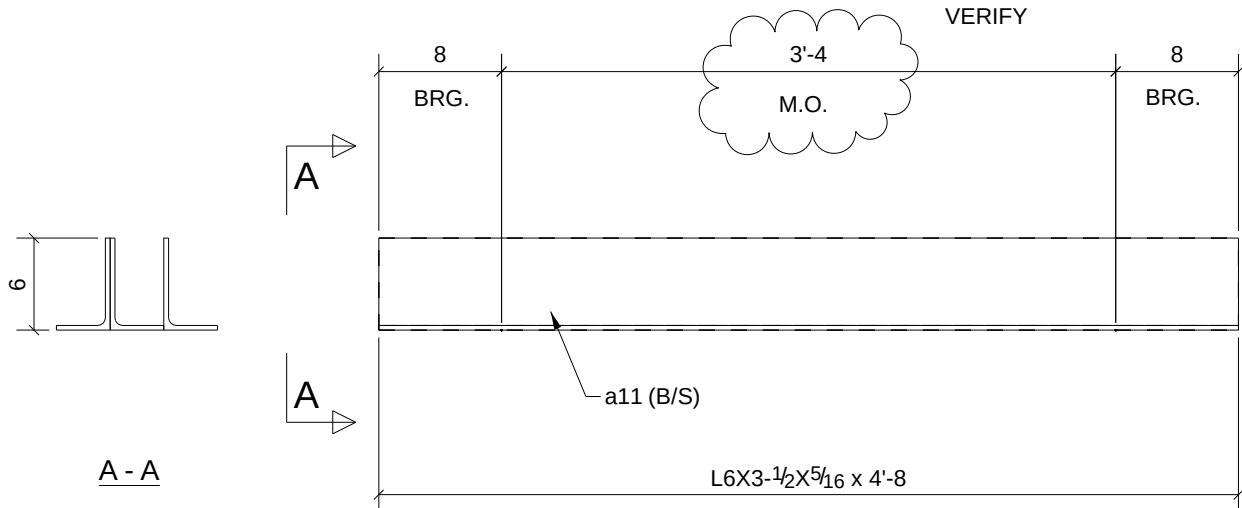

L-7 (M.O.=3'-4") LOCATION (M6?) NEAR 1313

ARCH./ENG/OWNER
PLEASE VERIFY / PROVIDE
TYPE & LOCATIONS
ERECTOR / GC ~ PLEASE
VERIFY / PROVIDE
M.O. @ EACH LOCATION

PHASE				
1	2	3	4	5
0	1	0	0	0


ONE - LINTEL - 22L10

(3 ANGLES EACH LINTEL)

BILL OF MATERIAL

SHIP	MARK	NO PCS	DESCRIPTION	LENGTH	PIECE MARK	REMARKS
1	22L10	1	L6X3-1/2X5/16	4'-8"		SQ-2 A36 1 S/C STD PRIMER
		2	L6X3-1/2X5/16	4'-8"	a11	A36 1 S/C STD PRIMER

A	For Approval		7/20/10	TMc	TAN
REV.	DESCRIPTION		DATE	DWN	CHK
GENERAL NOTES			JOB USE		
			SHOP		
MATERIAL: A992 / A36		ELECTRODES: E70XX LH	REF. DRG.		
HOLES: 13/16 DIA. U/N		CONN'S.: -			
SURFACE PREP. SS-PC-SP-2			APPROVAL		
AND PAINT: GREY PRIMER DEVOE NA-195 (U.N,)					
DESCRIPTION: LINTEL					
PROJECT NAME		Hamilton High School Phase III			
LOCATION		Hamilton City School District - Hamilton			
CONTRACTOR		GC Contracting			
	Avenue Fabricating Inc. 1281 Clough Pike Batavia, OH 45103 (513) 752-1911		DRAWN BY TMc		DATE 07/20/2010
			CHKD. BY TAN		DATE
			JOB No. 10-16		DRG. No. 22L10

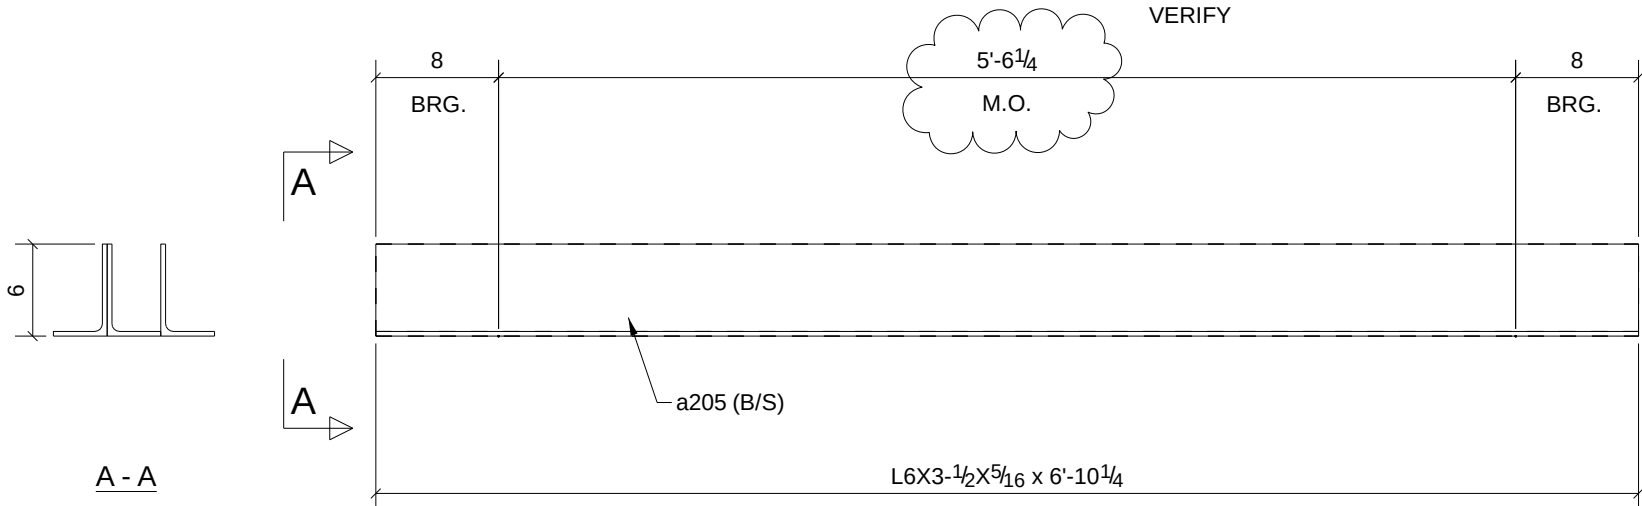

[L-7 (M.O.=5'-4") LOCATION (M6?)]

NEAR
1313

ARCH./ENG/OWNER
PLEASE VERIFY / PROVIDE
TYPE & LOCATIONS
ERECTOR / GC ~ PLEASE
VERIFY / PROVIDE
M.O. @ EACH LOCATION

PHASE				
1	2	3	4	5
0	1	0	0	0


ONE - LINTEL - 22L11

(3 ANGLES EACH LINTEL)

BILL OF MATERIAL

SHIP	MARK	NO PCS	DESCRIPTION	LENGTH	PIECE MARK	REMARKS
1	22L11	1	L6X3-1/2X5/16	6'-10 1/4"		SQ-2 A36 1 S/C STD PRIMER
		2	L6X3-1/2X5/16	6'-10 1/4"	a205	A36 1 S/C STD PRIMER

A	For Approval			7/20/10	TMc	TAN
REV.	DESCRIPTION			DATE	DWN	CHK
GENERAL NOTES				JOB USE		
MATERIAL: A992 / A36		ELECTRODES: E70XX LH	REF. DRG.			
HOLES: 13/16 DIA. U/N		CONN'S.: -		SHOP		
SURFACE PREP. SSPC-SP-2 AND PAINT: GREY PRIMER DEVOE NA-195 (U.N,)				APPROVAL		
DESCRIPTION: LINTEL						
PROJECT NAME		Hamilton High School Phase III				
LOCATION		Hamilton City School District - Hamilton				
CONTRACTOR		GC Contracting				
	Avenue Fabricating Inc. 1281 Clough Pike Batavia, OH 45103 (513) 752-1911			DRAWN BY TMc		DATE 07/20/2010
				CHKD. BY TAN		DATE
				JOB No. 10-16		DRG. No. 22L11

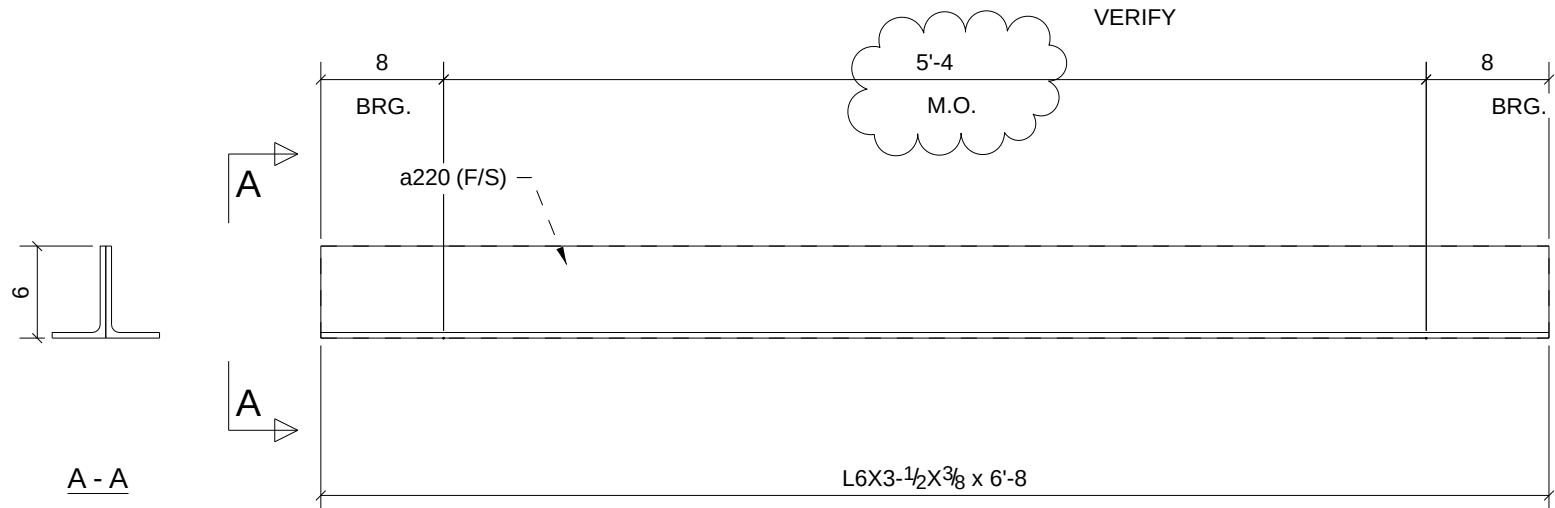

L-6 (M.O.=5'-4") LOCATION (M?) NEAR 1313

ARCH./ENG/OWNER
PLEASE VERIFY / PROVIDE
TYPE & LOCATIONS
ERECTOR / GC ~ PLEASE
VERIFY / PROVIDE
M.O. @ EACH LOCATION

PHASE				
1	2	3	4	5
0	1	0	0	0


ONE - LINTEL - 22L12

(2 ANGLES EACH LINTEL)

BILL OF MATERIAL

SHIP	MARK	NO PCS	DESCRIPTION	LENGTH	PIECE MARK	REMARKS
1	22L12	1	L6X3-1/2X3/8	6'-8"		SQ-2 A36 1 S/C STD PRIMER
		1	L6X3-1/2X3/8	6'-8"	a220	A36 1 S/C STD PRIMER

A	For Approval	7/20/10	TMc	TAN
REV.	DESCRIPTION	DATE	DWN	CHK
GENERAL NOTES		JOB USE		
MATERIAL: A992 / A36	ELECTRODES: E70XX LH	REF. DRG.	SHOP	
HOLES: 13/16 DIA. U/N	CONN'S.: -			
SURFACE PREP. SSPC-SP-2	AND PAINT: GREY PRIMER DEVOE NA-195 (U.N,)		APPROVAL	
DESCRIPTION:	LINTEL			
PROJECT NAME	Hamilton High School Phase III			
LOCATION	Hamilton City School District - Hamilton			
CONTRACTOR	GC Contracting			
	Avenue Fabricating Inc. 1281 Clough Pike Batavia, OH 45103 (513) 752-1911	DRAWN BY TMc	DATE 07/20/2010	
		CHKD. BY TAN	DATE	
		JOB No. 10-16	DRG. No. 22L12	REV. 1

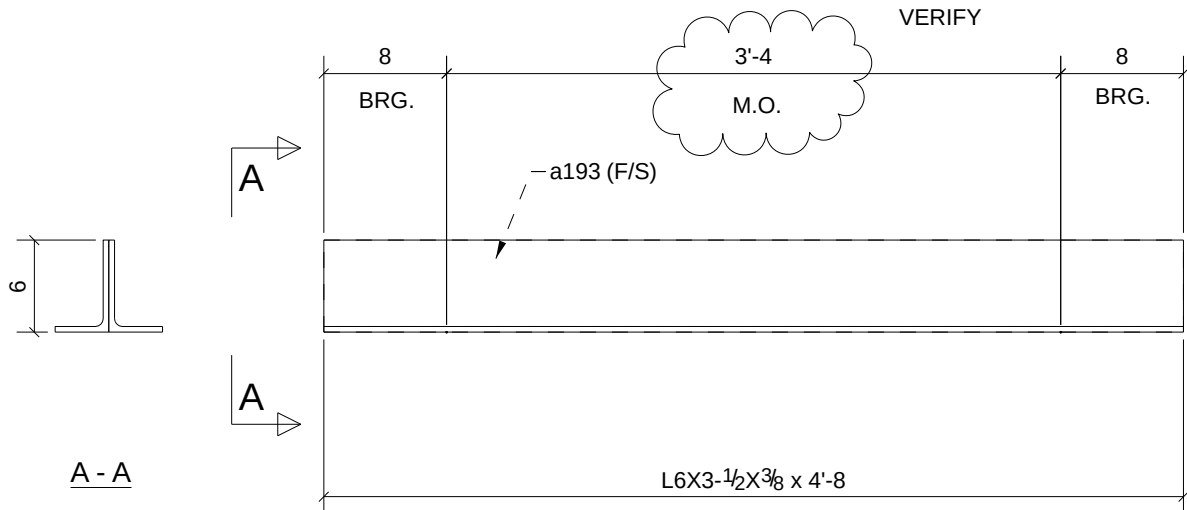

L-6 (M.O.=3'-4") LOCATION (M?) NEAR 1313

ARCH./ENG/OWNER
PLEASE VERIFY / PROVIDE
TYPE & LOCATIONS
ERECTOR / GC ~ PLEASE
VERIFY / PROVIDE
M.O. @ EACH LOCATION

PHASE				
1	2	3	4	5
0	1	0	0	0


ONE - LINTEL - 22L13

(2 ANGLES EACH LINTEL)

BILL OF MATERIAL

SHIP	MARK	NO PCS	DESCRIPTION	LENGTH	PIECE MARK	REMARKS
1	22L13	1	L6X3-1/2X3/8	4'-8"		SQ-2 A36 1 S/C STD PRIMER
		1	L6X3-1/2X3/8	4'-8"	a193	A36 1 S/C STD PRIMER

A	For Approval			7/20/10	TMc	TAN	
REV.	DESCRIPTION			DATE	DWN	CHK	
GENERAL NOTES				JOB USE			
MATERIAL: A992 / A36		ELECTRODES: E70XX LH	REF. DRG.		SHOP		
HOLES: 13/16 DIA. U/N		CONN'S.: -					
SURFACE PREP. SSPC-SP-2				APPROVAL			
AND PAINT: GREY PRIMER DEVOE NA-195 (U.N,)							
DESCRIPTION: LINTEL							
PROJECT NAME		Hamilton High School Phase III					
LOCATION		Hamilton City School District - Hamilton					
CONTRACTOR		GC Contracting					
		Avenue Fabricating Inc. 1281 Clough Pike Batavia, OH 45103 (513) 752-1911		DRAWN BY		DATE	
				TMc		07/20/2010	
				CHKD. BY		DATE	
		1281 Clough Pike Batavia, OH 45103 (513) 752-1911		TAN			
				JOB No.		DRG. No.	REV.
				10-16		22L13	1

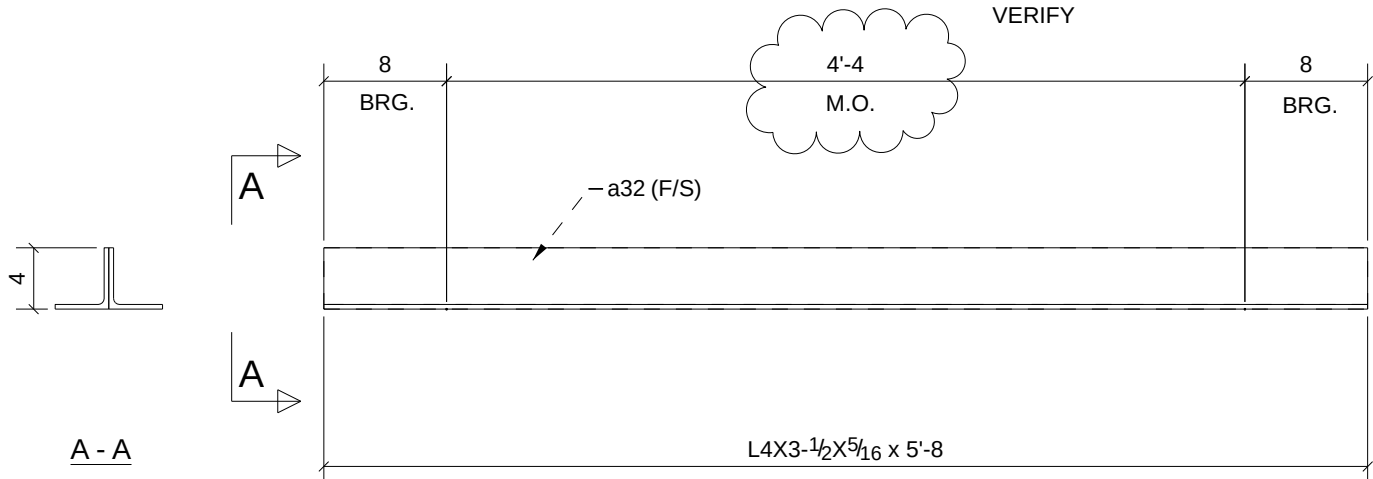

L-4 (M.O.=4'-4") LOCATION (1316C)
(1316B)

ARCH./ENG/OWNER
PLEASE VERIFY / PROVIDE
TYPE & LOCATIONS
ERECTOR / GC ~ PLEASE
VERIFY / PROVIDE
M.O. @ EACH LOCATION

PHASE				
1	2	3	4	5
0	2	0	0	0


2 - LINTELS - 22L14

(2 ANGLES EACH LINTEL)

BILL OF MATERIAL

SHIP	MARK	NO PCS	DESCRIPTION	LENGTH	PIECE MARK	REMARKS
2	22L14	2	L4X3-1/2X5/16	5'-8"		SQ-2 A36 1 S/C STD PRIMER
		2	L4X3-1/2X5/16	5'-8"	a32	A36 1 S/C STD PRIMER

A	For Approval		7/20/10	TMc	TAN
REV.	DESCRIPTION		DATE	DWN	CHK
GENERAL NOTES			JOB USE		
MATERIAL: A992 / A36		ELECTRODES: E70XX LH		REF. DRG.	
HOLES: 13/16 DIA. U/N		CONN'S.: -	SHOP		
SURFACE PREP. SSPC-SP-2 AND PAINT: GREY PRIMER DEVOE NA-195 (U.N,)			APPROVAL		
DESCRIPTION: LINTEL					
PROJECT NAME		Hamilton High School Phase III			
LOCATION		Hamilton City School District - Hamilton			
CONTRACTOR		GC Contracting			
	Avenue Fabricating Inc. 1281 Clough Pike Batavia, OH 45103 (513) 752-1911		DRAWN BY TMc		DATE 07/20/2010
			CHKD. BY TAN		DATE
			JOB No. 10-16		DRG. No. 22L14

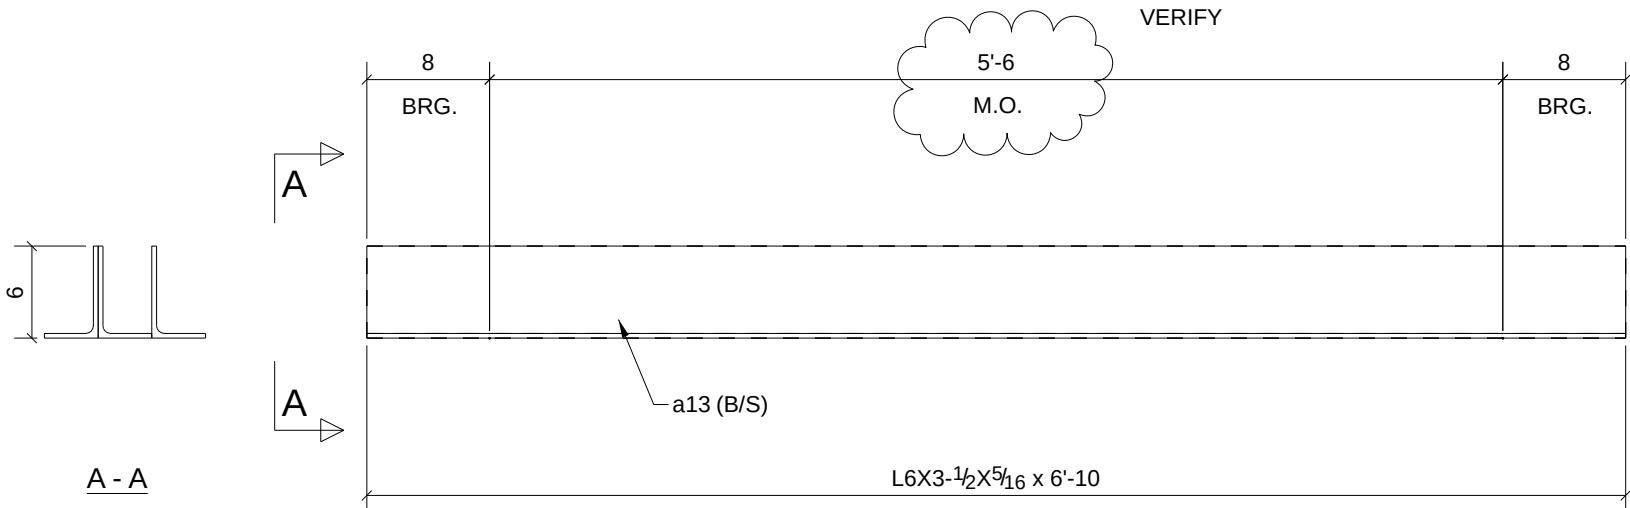

L-7 (M.O.=5'-6") LOCATION (1122)
(1101) (2X)

ARCH./ENG/OWNER
PLEASE VERIFY / PROVIDE
TYPE & LOCATIONS
ERECTOR / GC ~ PLEASE
VERIFY / PROVIDE
M.O. @ EACH LOCATION

PHASE				
1	2	3	4	5
0	3	0	0	0

3 - LINTELS - 22L15


(3 ANGLES EACH LINTEL)

BILL OF MATERIAL

SHIP	MARK	NO PCS	DESCRIPTION	LENGTH	PIECE MARK	REMARKS
3	22L15	3	L6X3-1/2X5/16	6'-10"		SQ-2 A36 GALVANIZED
		6	L6X3-1/2X5/16	6'-10"	a13	A36 GALVANIZED

A	For Approval		7/20/10	TMc	TAN
REV.	DESCRIPTION		DATE	DWN	CHK
GENERAL NOTES			JOB USE		
MATERIAL: A992 / A36		ELECTRODES: E70XX LH	REF. DRG.		
HOLES: 13/16 DIA. U/N		CONN'S.: -		SHOP	
SURFACE PREP. SS-PC-SP-2			APPROVAL		
AND PAINT: GREY PRIMER DEVOE NA-195 (U.N,)					
DESCRIPTION: LINTEL					
PROJECT NAME		Hamilton High School Phase III			
LOCATION		Hamilton City School District - Hamilton			
CONTRACTOR		GC Contracting			
	Avenue Fabricating Inc. 1281 Clough Pike Batavia, OH 45103 (513) 752-1911		DRAWN BY		DATE
			TMc		07/20/2010
			CHKD. BY		DATE
			TAN		
		JOB No.	DRG. No.	REV.	
		10-16	22L15	1	

Avenue Fabricating Inc.
1281 Clough Pike
Batavia, OH 45103
(513) 752-1911

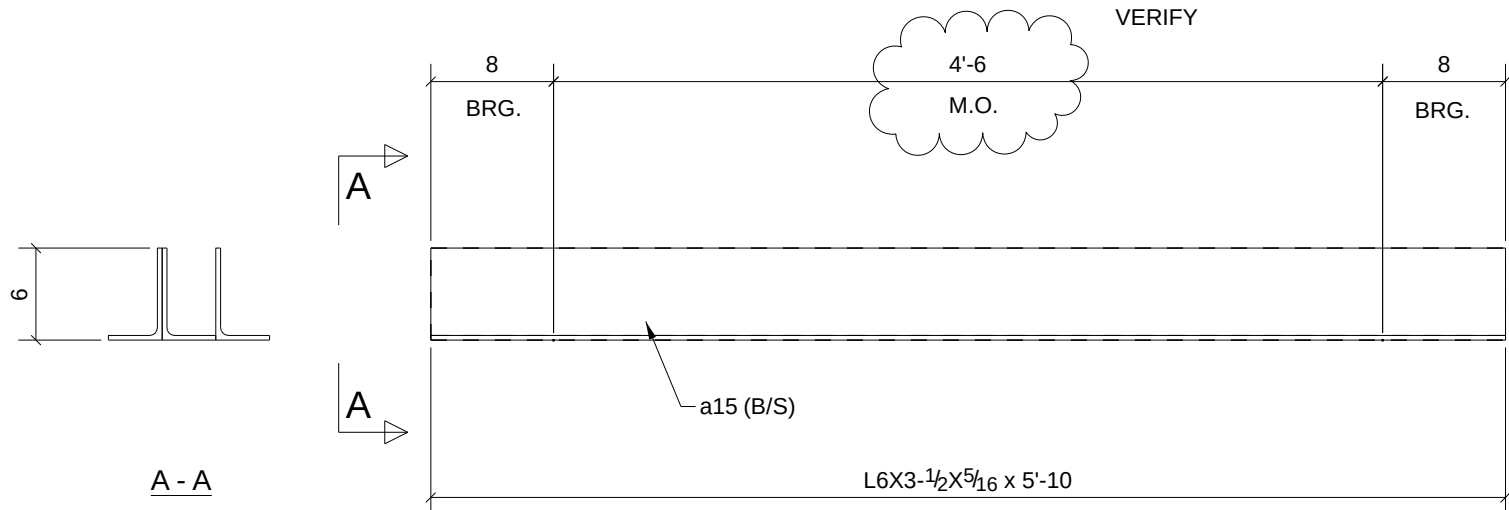

L-7 (M.O.=4'-6") LOCATION (1108) (2X)
(1106)

ARCH./ENG/OWNER
PLEASE VERIFY / PROVIDE
TYPE & LOCATIONS
ERECTOR / GC ~ PLEASE
VERIFY / PROVIDE
M.O. @ EACH LOCATION

PHASE				
1	2	3	4	5
0	3	0	0	0

3 - LINTELS - 22L16


(3 ANGLES EACH LINTEL)

BILL OF MATERIAL

SHIP	MARK	NO PCS	DESCRIPTION	LENGTH	PIECE MARK	REMARKS
3	22L16	3	L6X3-1/2X5/16	5'-10"		SQ-2 A36 GALVANIZED
		6	L6X3-1/2X5/16	5'-10"	a15	A36 GALVANIZED

A	For Approval		7/20/10	TMc	TAN
REV.	DESCRIPTION		DATE	DWN	CHK
GENERAL NOTES			JOB USE		
			SHOP		
MATERIAL: A992 / A36		ELECTRODES: E70XX LH	REF. DRG.		
HOLES: 13/16 DIA. U/N		CONN'S.: -			
SURFACE PREP. SSPC-SP-2 AND PAINT: GREY PRIMER DEVOE NA-195 (U.N,)			APPROVAL		
DESCRIPTION: LINTEL					
PROJECT NAME		Hamilton High School Phase III			
LOCATION		Hamilton City School District - Hamilton			
CONTRACTOR		GC Contracting			
	Avenue Fabricating Inc. 1281 Clough Pike Batavia, OH 45103 (513) 752-1911		DRAWN BY TMc		DATE 07/20/2010
			CHKD. BY TAN		DATE
			JOB No. 10-16		DRG. No. 22L16
					REV. 1

Avenue Fabricating Inc.
1281 Clough Pike
Batavia, OH 45103
(513) 752-1911

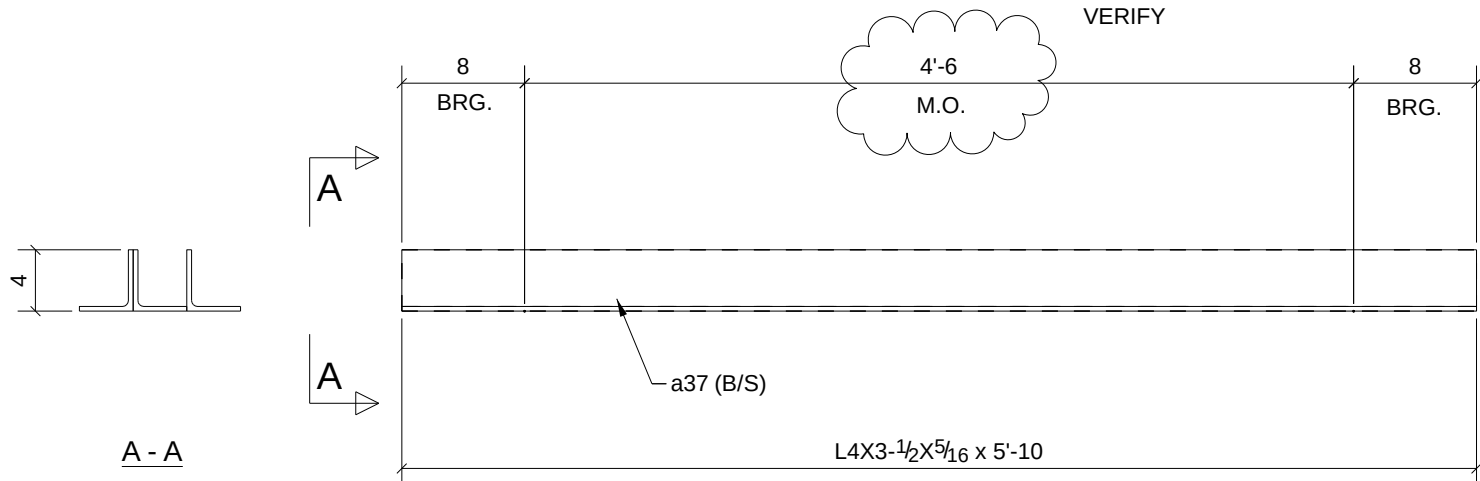

L-3 (M.O.=4'-6") LOCATION (1119)
(1116)

ARCH./ENG/OWNER
PLEASE VERIFY / PROVIDE
TYPE & LOCATIONS
ERECTOR / GC ~ PLEASE
VERIFY / PROVIDE
M.O. @ EACH LOCATION

PHASE				
1	2	3	4	5
0	2	0	0	0


2 - LINTELS - 22L17

(3 ANGLES EACH LINTEL)

BILL OF MATERIAL

SHIP	MARK	NO PCS	DESCRIPTION	LENGTH	PIECE MARK	REMARKS
2	22L17	2	L4X3-1/2X5/16	5'-10"		SQ-2 A36 GALVANIZED
		4	L4X3-1/2X5/16	5'-10"	a37	A36 GALVANIZED

A	For Approval		7/20/10	TMc	TAN	
REV.	DESCRIPTION		DATE	DWN	CHK	
GENERAL NOTES			JOB USE			
			MATERIAL: A992 / A36	ELECTRODES: E70XX LH	REF. DRG.	SHOP
HOLES: 13/16 DIA. U/N	CONN'S.: -					
SURFACE PREP. SSPC-SP-2 AND PAINT: GREY PRIMER DEVOE NA-195 (U.N,)			APPROVAL			
DESCRIPTION: LINTEL						
PROJECT NAME		Hamilton High School Phase III				
LOCATION		Hamilton City School District - Hamilton				
CONTRACTOR		GC Contracting				
	Avenue Fabricating Inc. 1281 Clough Pike Batavia, OH 45103 (513) 752-1911		DRAWN BY TMc		DATE 07/20/2010	
			CHKD. BY TAN		DATE	
			JOB No. 10-16		DRG. No. 22L17 REV. 1	

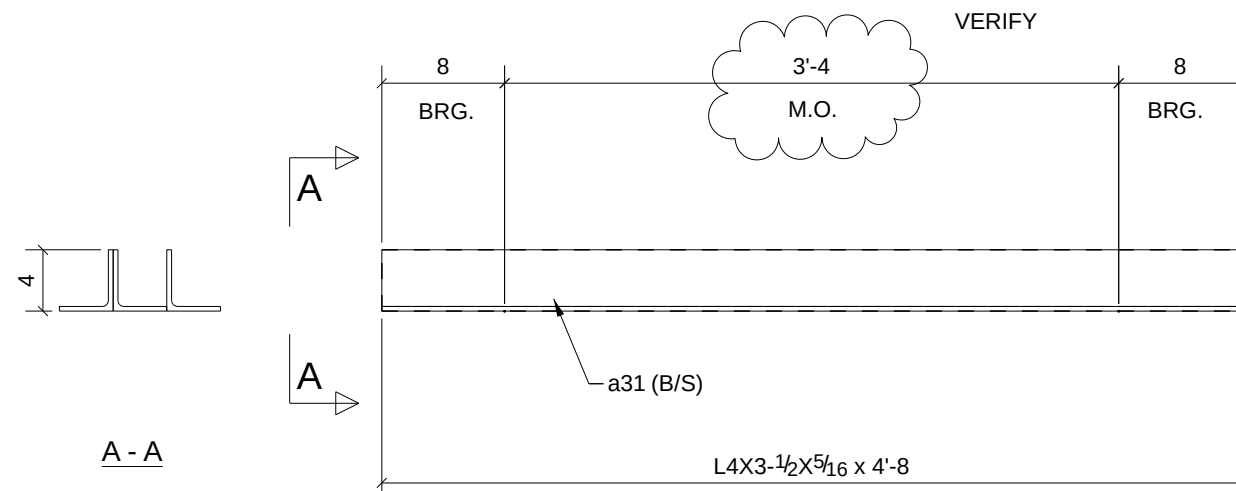

L-3 (M.O.=3'-4") LOCATION (1028B)

(1039)

ARCH./ENG/OWNER
PLEASE VERIFY / PROVIDE
TYPE & LOCATIONS
ERECTOR / GC ~ PLEASE
VERIFY / PROVIDE
M.O. @ EACH LOCATION


PHASE				
1	2	3	4	5
0	2	0	0	0

2 - LINTELS - 22L18

(3 ANGLES EACH LINTEL)

BILL OF MATERIAL						
SHIP	MARK	NO PCS	DESCRIPTION	LENGTH	PIECE MARK	REMARKS
2	22L18	2	L4X3-1/2X5/16	4'-8"		SQ-2 A36 1 S/C STD PRIMER
		4	L4X3-1/2X5/16	4'-8"	a31	A36 1 S/C STD PRIMER

A	For Approval		7/20/10	TMc	TAN
REV.	DESCRIPTION		DATE	DWN	CHK
GENERAL NOTES			JOB USE		
MATERIAL: A992 / A36	ELECTRODES: E70XX LH	REF. DRG.	SHOP		
HOLES: 13/16 DIA. U/N	CONN'S.: -				
SURFACE PREP. SSPC-SP-2			APPROVAL		
AND PAINT: GREY PRIMER DEVOE NA-195 (U.N.)					
DESCRIPTION:	LINTEL				
PROJECT NAME	Hamilton High School Phase III				
LOCATION	Hamilton City School District - Hamilton				
CONTRACTOR	GC Contracting				
	Avenue Fabricating Inc. 1281 Clough Pike Batavia, OH 45103 (513) 752-1911		DRAWN BY TMc	DATE 07/20/2010	
			CHKD. BY TAN	DATE	
			JOB No. 10-16	DRG. No. 22L18	REV. 1

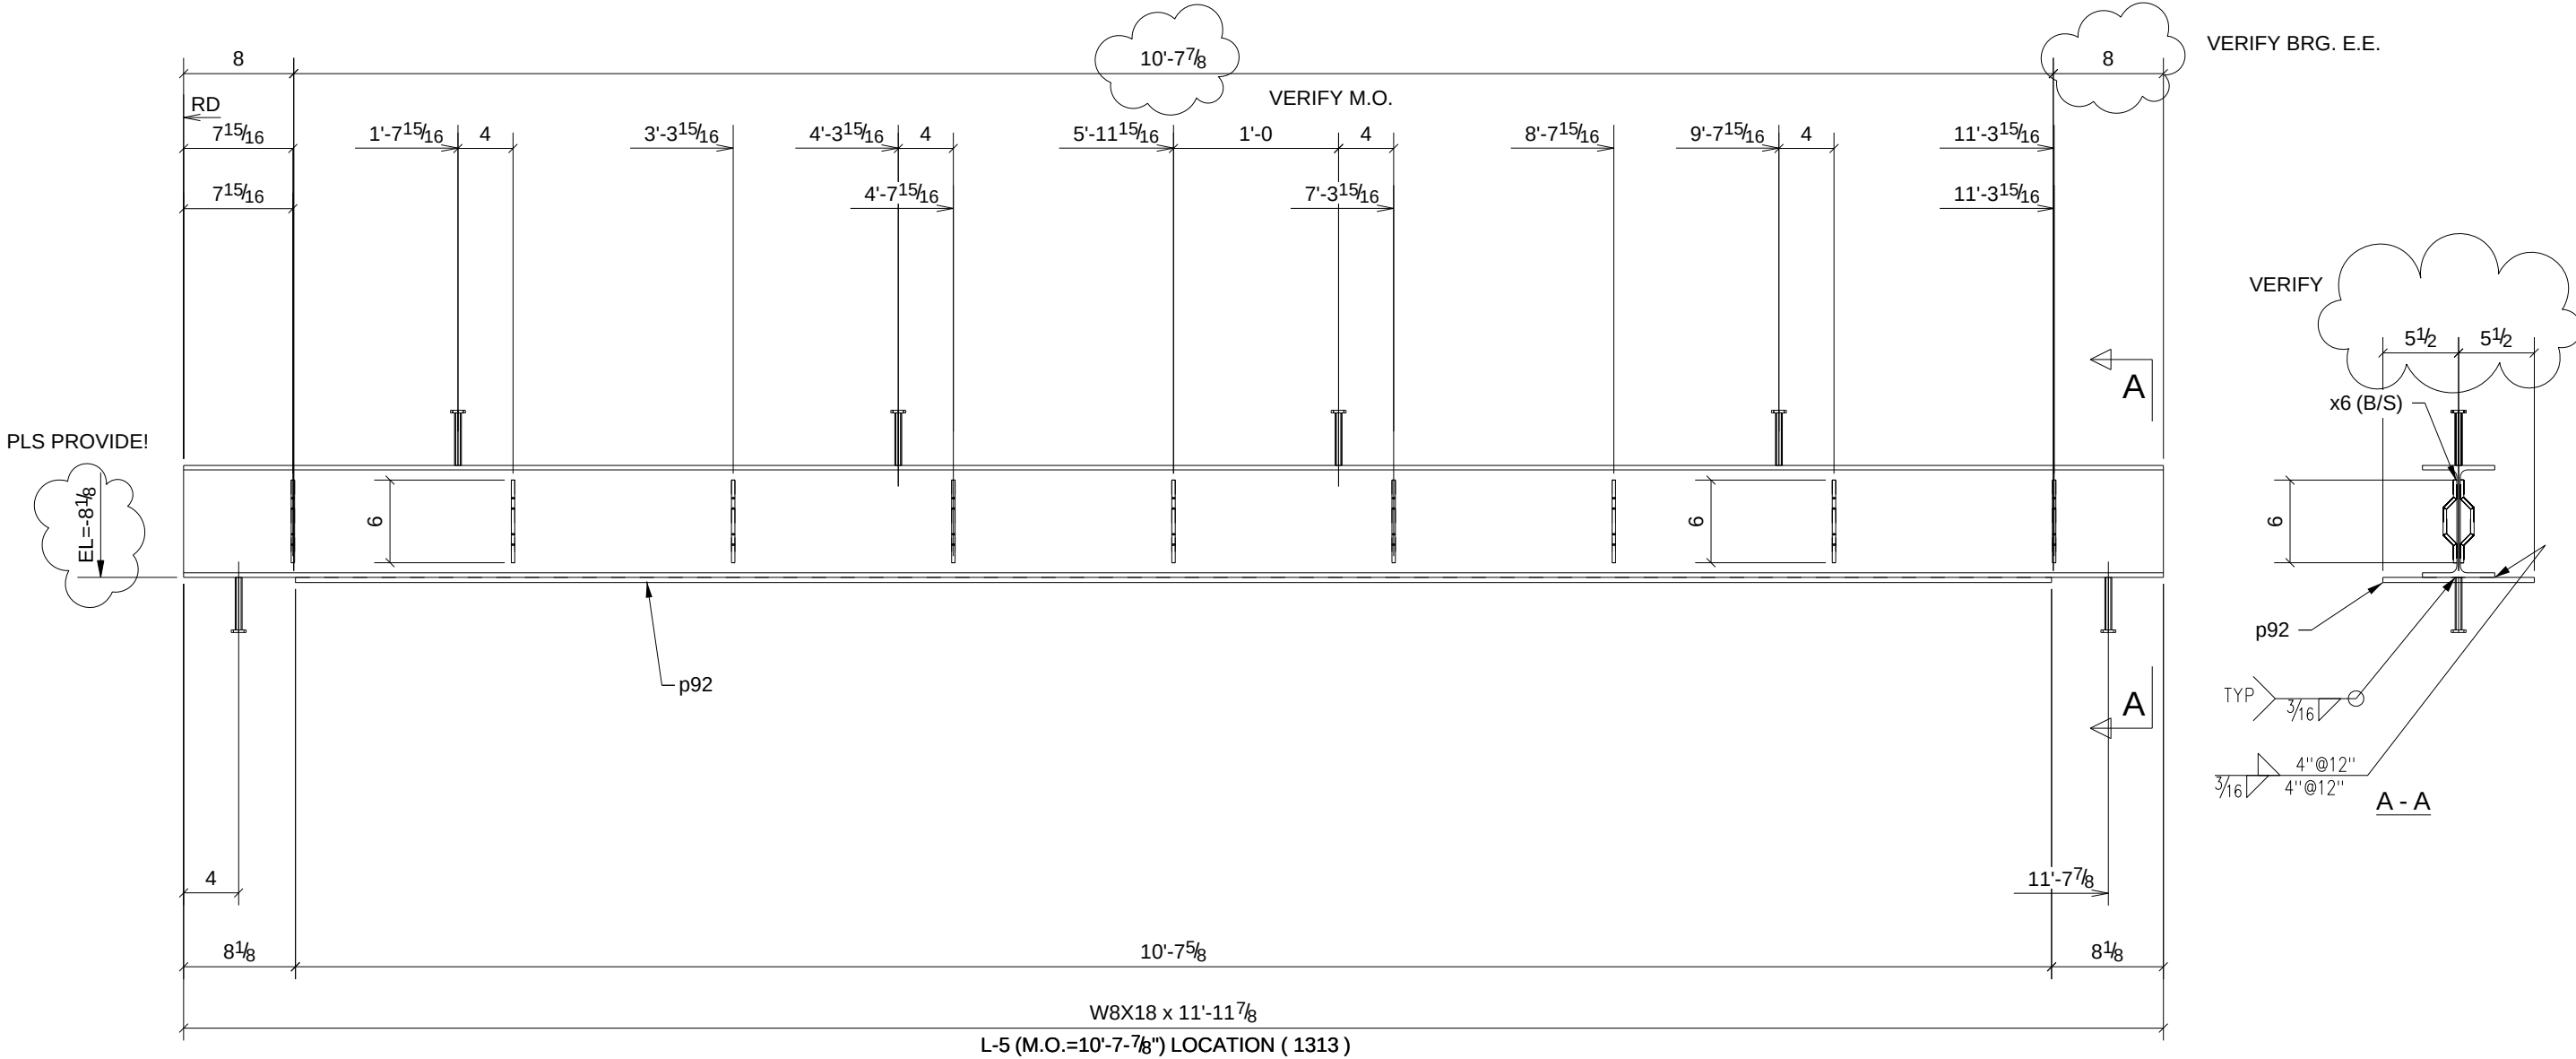


PHASE				
1	2	3	4	5
0	1	0	0	0

ONE - LINTEL - 22L2

W	8 1/8"x1/4"
F	5 1/4"x5/16"

BILL OF MATERIAL						
SHIP	MARK	NO PCS	DESCRIPTION	LENGTH	PIECE MARK	REMARKS
1	22L2	1	W8X18	11'-11 7/8"		SQ-2 A992 GALVANIZED
		1	BAR3/8"X11"	10'-7 5/8"	p92	A36 GALVANIZED
		18	H&B #359	0'-6 3/16"	x6	A36 GALVANIZED
		6	STUD 1/2" DIA	0'-4"		

A	For Approval		7/20/10	TMc	TAN
REV.	DESCRIPTION		DATE	DWN	CHK
GENERAL NOTES			JOB USE		
MATERIAL: A992 / A36		ELECTRODES: E70XX LH	REF. DRG.		
HOLES: 13/16 DIA. U/N		CONN'S.: -		SHOP	
SURFACE PREP. SSPC-SP-2 AND PAINT: GREY PRIMER DEVOE NA-195 (U.N.)			APPROVAL		
DESCRIPTION: LINTEL					
PROJECT NAME		Hamilton High School Phase III			
LOCATION		Hamilton City School District - Hamilton			
CONTRACTOR		GC Contracting			
	Avenue Fabricating Inc. 1281 Clough Pike Batavia, OH 45103 (513) 752-1911		DRAWN BY TMc		DATE 07/19/2010
			CHKD. BY TAN		DATE
			JOB No. 10-16		DRG. No. 22L2

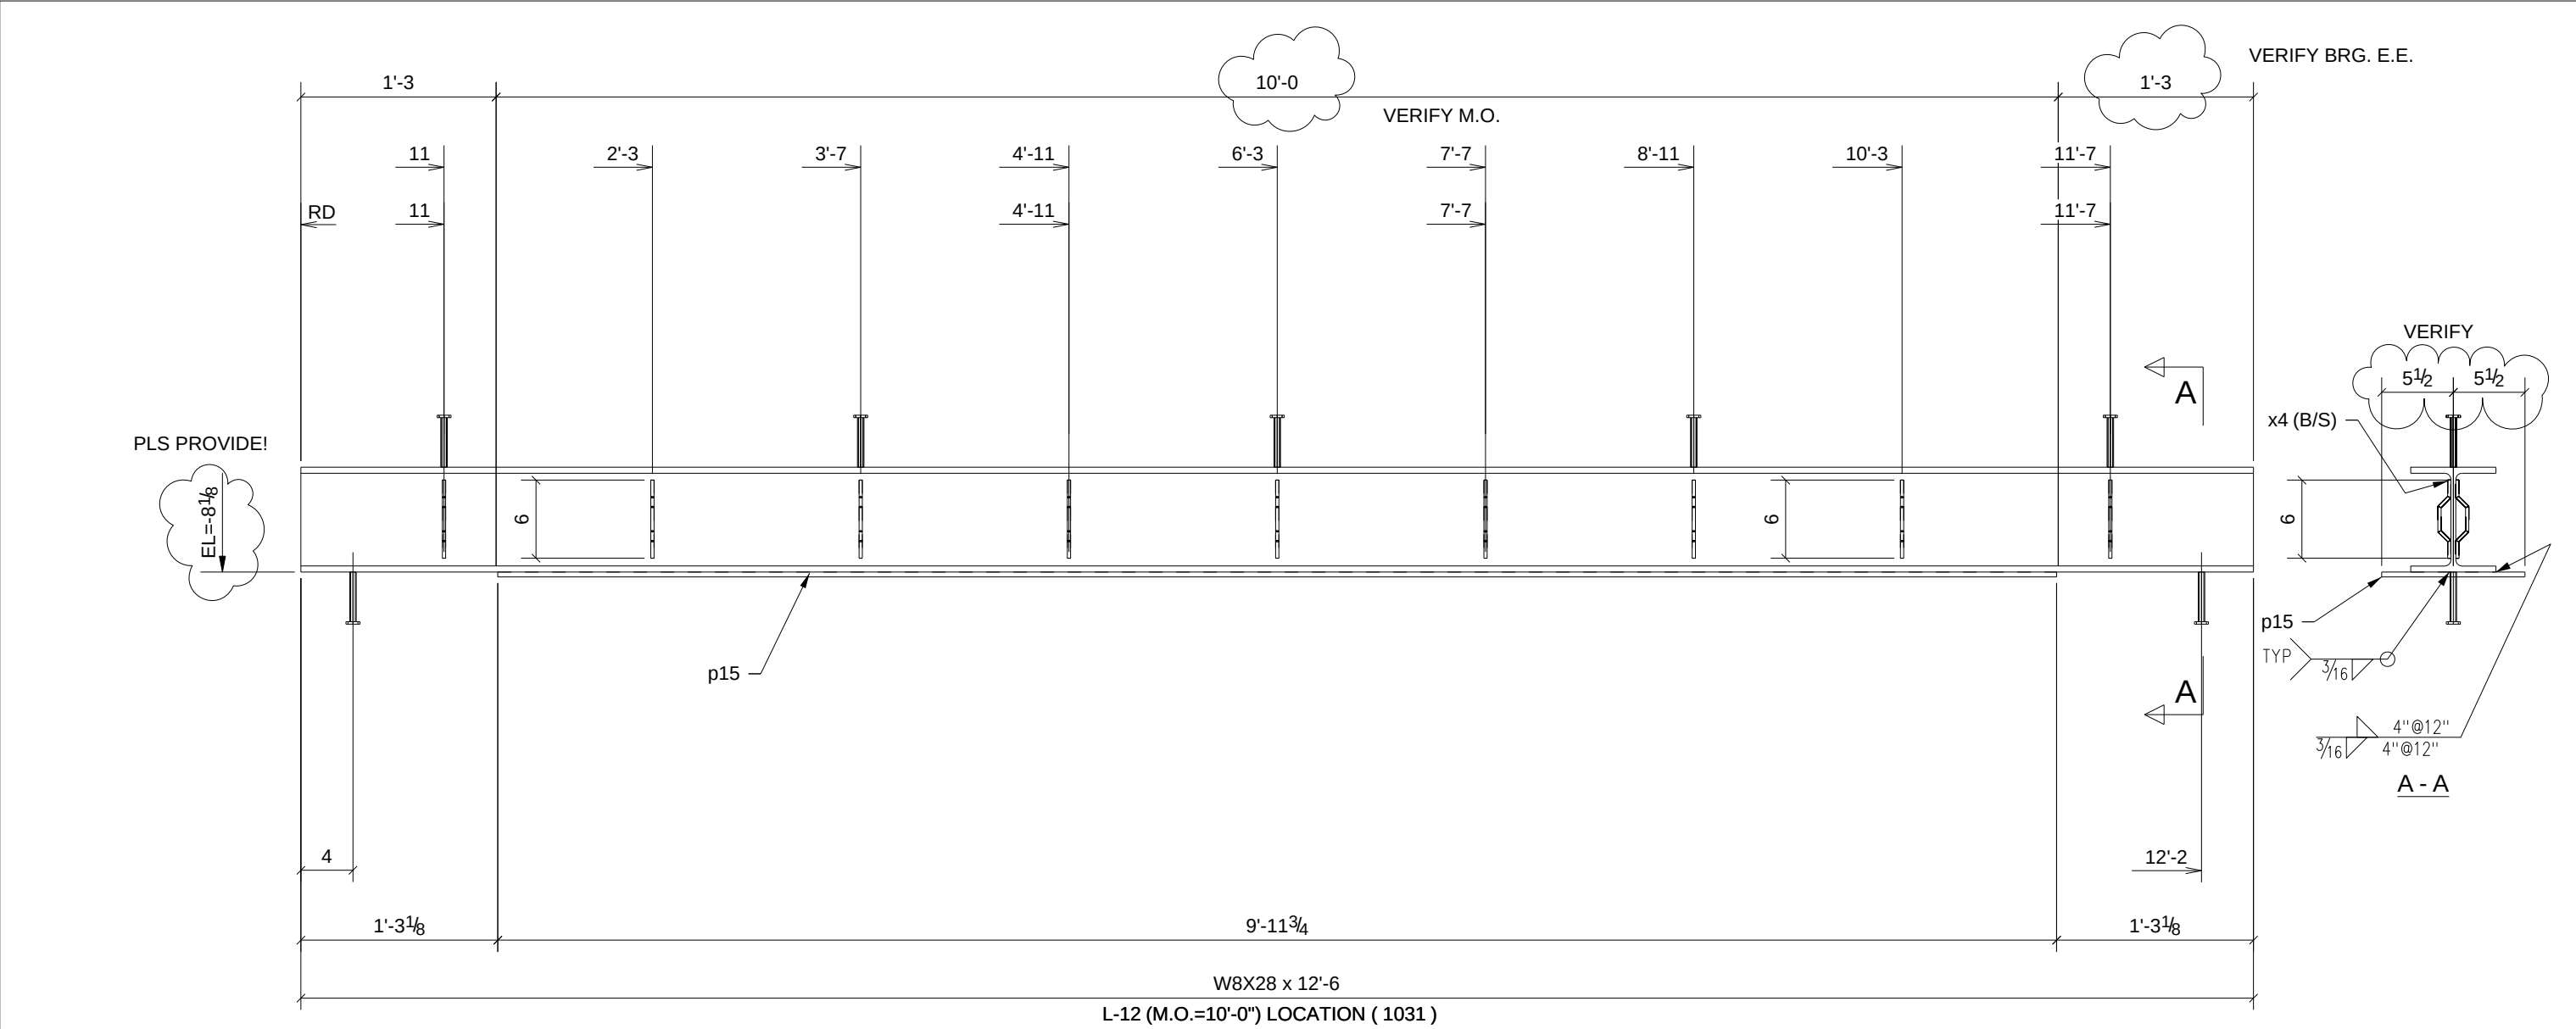

ONE - LINTEL - 22L20


PHASE				
1	2	3	4	5
0	1	0	0	0

W	8 1/16"x1/4"
F	6 9/16"x7/16"


BILL OF MATERIAL

SHIP	MARK	NO PCS	DESCRIPTION	LENGTH	PIECE MARK	REMARKS
1	22L20	1	W8X28	12'-6"		SQ-2 A992 1 S/C STD PRIMER
		1	BAR3/8"X11"	9'-11 3/4"	p15	A36 1 S/C STD PRIMER
		18	H&B #359	0'-6 3/16"	x4	A36 1 S/C STD PRIMER
		7	STUD 1/2" DIA	0'-4"		

A	For Approval		7/20/10	TMc	TAN
REV.	DESCRIPTION		DATE	DWN	CHK
GENERAL NOTES			JOB USE		
MATERIAL: A992 / A36	ELECTRODES: E70XX LH	REF. DRG.			
HOLES: 13/16 DIA. U/N	CONN'S.: -		SHOP		
SURFACE PREP. SSPC-SP-2 AND PAINT: GREY PRIMER DEVOE NA-195 (U.N.)			APPROVAL		
DESCRIPTION: LINTEL					
PROJECT NAME		Hamilton High School Phase III			
LOCATION		Hamilton City School District - Hamilton			
CONTRACTOR		GC Contracting			
	Avenue Fabricating Inc. 1281 Clough Pike Batavia, OH 45103 (513) 752-1911		DRAWN BY TMc		DATE 07/19/2010
			CHKD. BY TAN		DATE
			JOB No. 10-16		DRG. No. 22L20

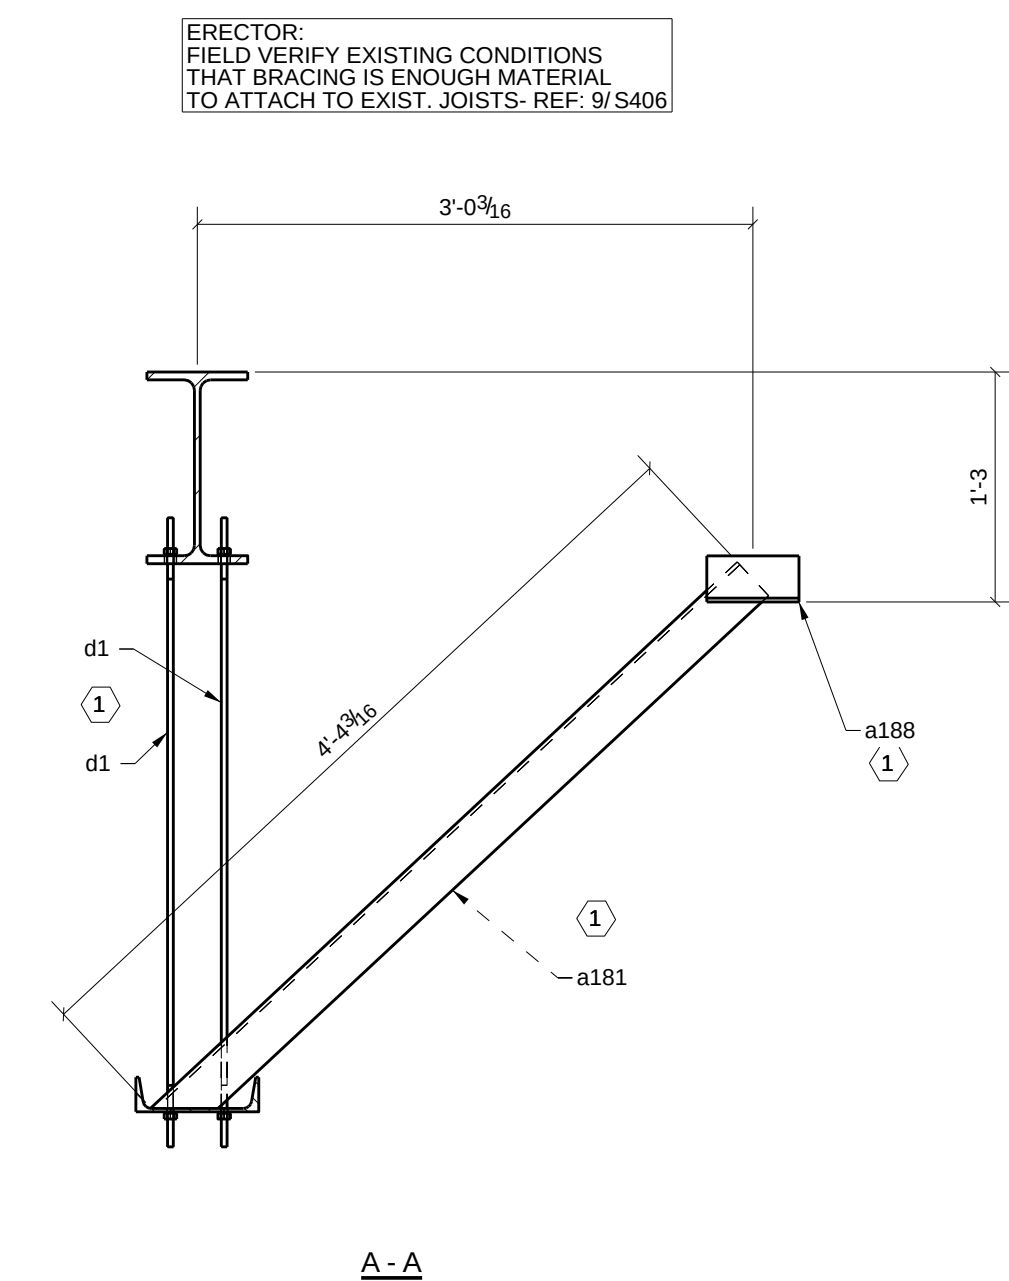

A	For Approval			7/20/10	TMc	TAN
REV.	DESCRIPTION			DATE	DWN	CHK
GENERAL NOTES				JOB USE		
MATERIAL: A992 / A36		ELECTRODES: E70XX LH		REF. DRG.		
HOLES: 13/16 DIA. U/N		CONN'S: -		SHOP		
SURFACE PREP: SSPC-SP-2				APPROVAL		
AND PAINT: GREY PRIMER DEVOE NA-195 (U.N.)						
DESCRIPTION:		LINTEL				
PROJECT NAME		Hamilton High School Phase III				
LOCATION		Hamilton City School District - Hamilton				
CONTRACTOR		GC Contracting				
		Avenue Fabricating Inc. 1281 Clough Pike Batavia, OH 45103 (513) 752-1911		DRAWN BY		DATE
				TMc		07/20/2010
				CHKD. BY		DATE
				TAN		
		JOB No.		DRG. No.	REV.	
		10-16		22L27	1	

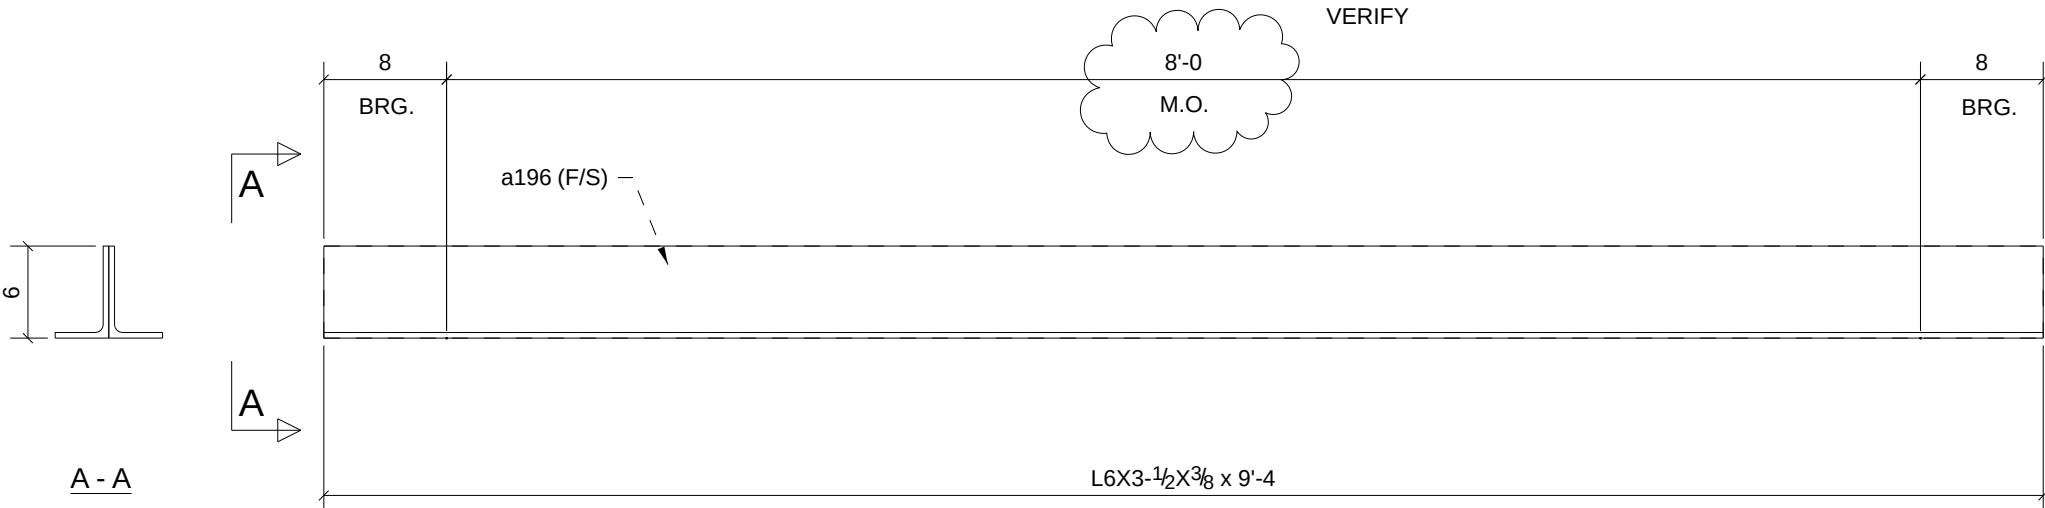

L-6 LOCATION (1207)

ARCH./ENG/OWNER
PLEASE VERIFY / PROVIDE
TYPE & LOCATIONS
ERECTOR / GC ~ PLEASE
VERIFY / PROVIDE
M.O. @ EACH LOCATION

PHASE				
1	2	3	4	5
0	1	0	0	0


ONE - LINTEL - 22L29

(3 ANGLES EACH LINTEL)

BILL OF MATERIAL

SHIP	MARK	NO PCS	DESCRIPTION	LENGTH	PIECE MARK	REMARKS
1	22L29	1	L6X3-1/2X3/8	9'-4"		SQ-2 A36 1 S/C STD PRIMER
		1	L6X3-1/2X3/8	9'-4"	a196	A36 1 S/C STD PRIMER

A	For Approval		7/20/10	TMc	TAN
REV.	DESCRIPTION		DATE	DWN	CHK
GENERAL NOTES			JOB USE		
MATERIAL: A992 / A36	ELECTRODES: E70XX LH	REF. DRG.	SHOP		
HOLES: 13/16 DIA. U/N	CONN'S.: -				
SURFACE PREP. SSPC-SP-2 AND PAINT: GREY PRIMER DEVOE NA-195 (U.N,)			APPROVAL		
DESCRIPTION: LINTEL					
PROJECT NAME	Hamilton High School Phase III				
LOCATION	Hamilton City School District - Hamilton				
CONTRACTOR	GC Contracting				
	Avenue Fabricating Inc. 1281 Clough Pike Batavia, OH 45103 (513) 752-1911		DRAWN BY TMc	DATE 07/20/2010	
			CHKD. BY TAN	DATE	
			JOB No. 10-16	DRG. No. 22L29	REV. 1

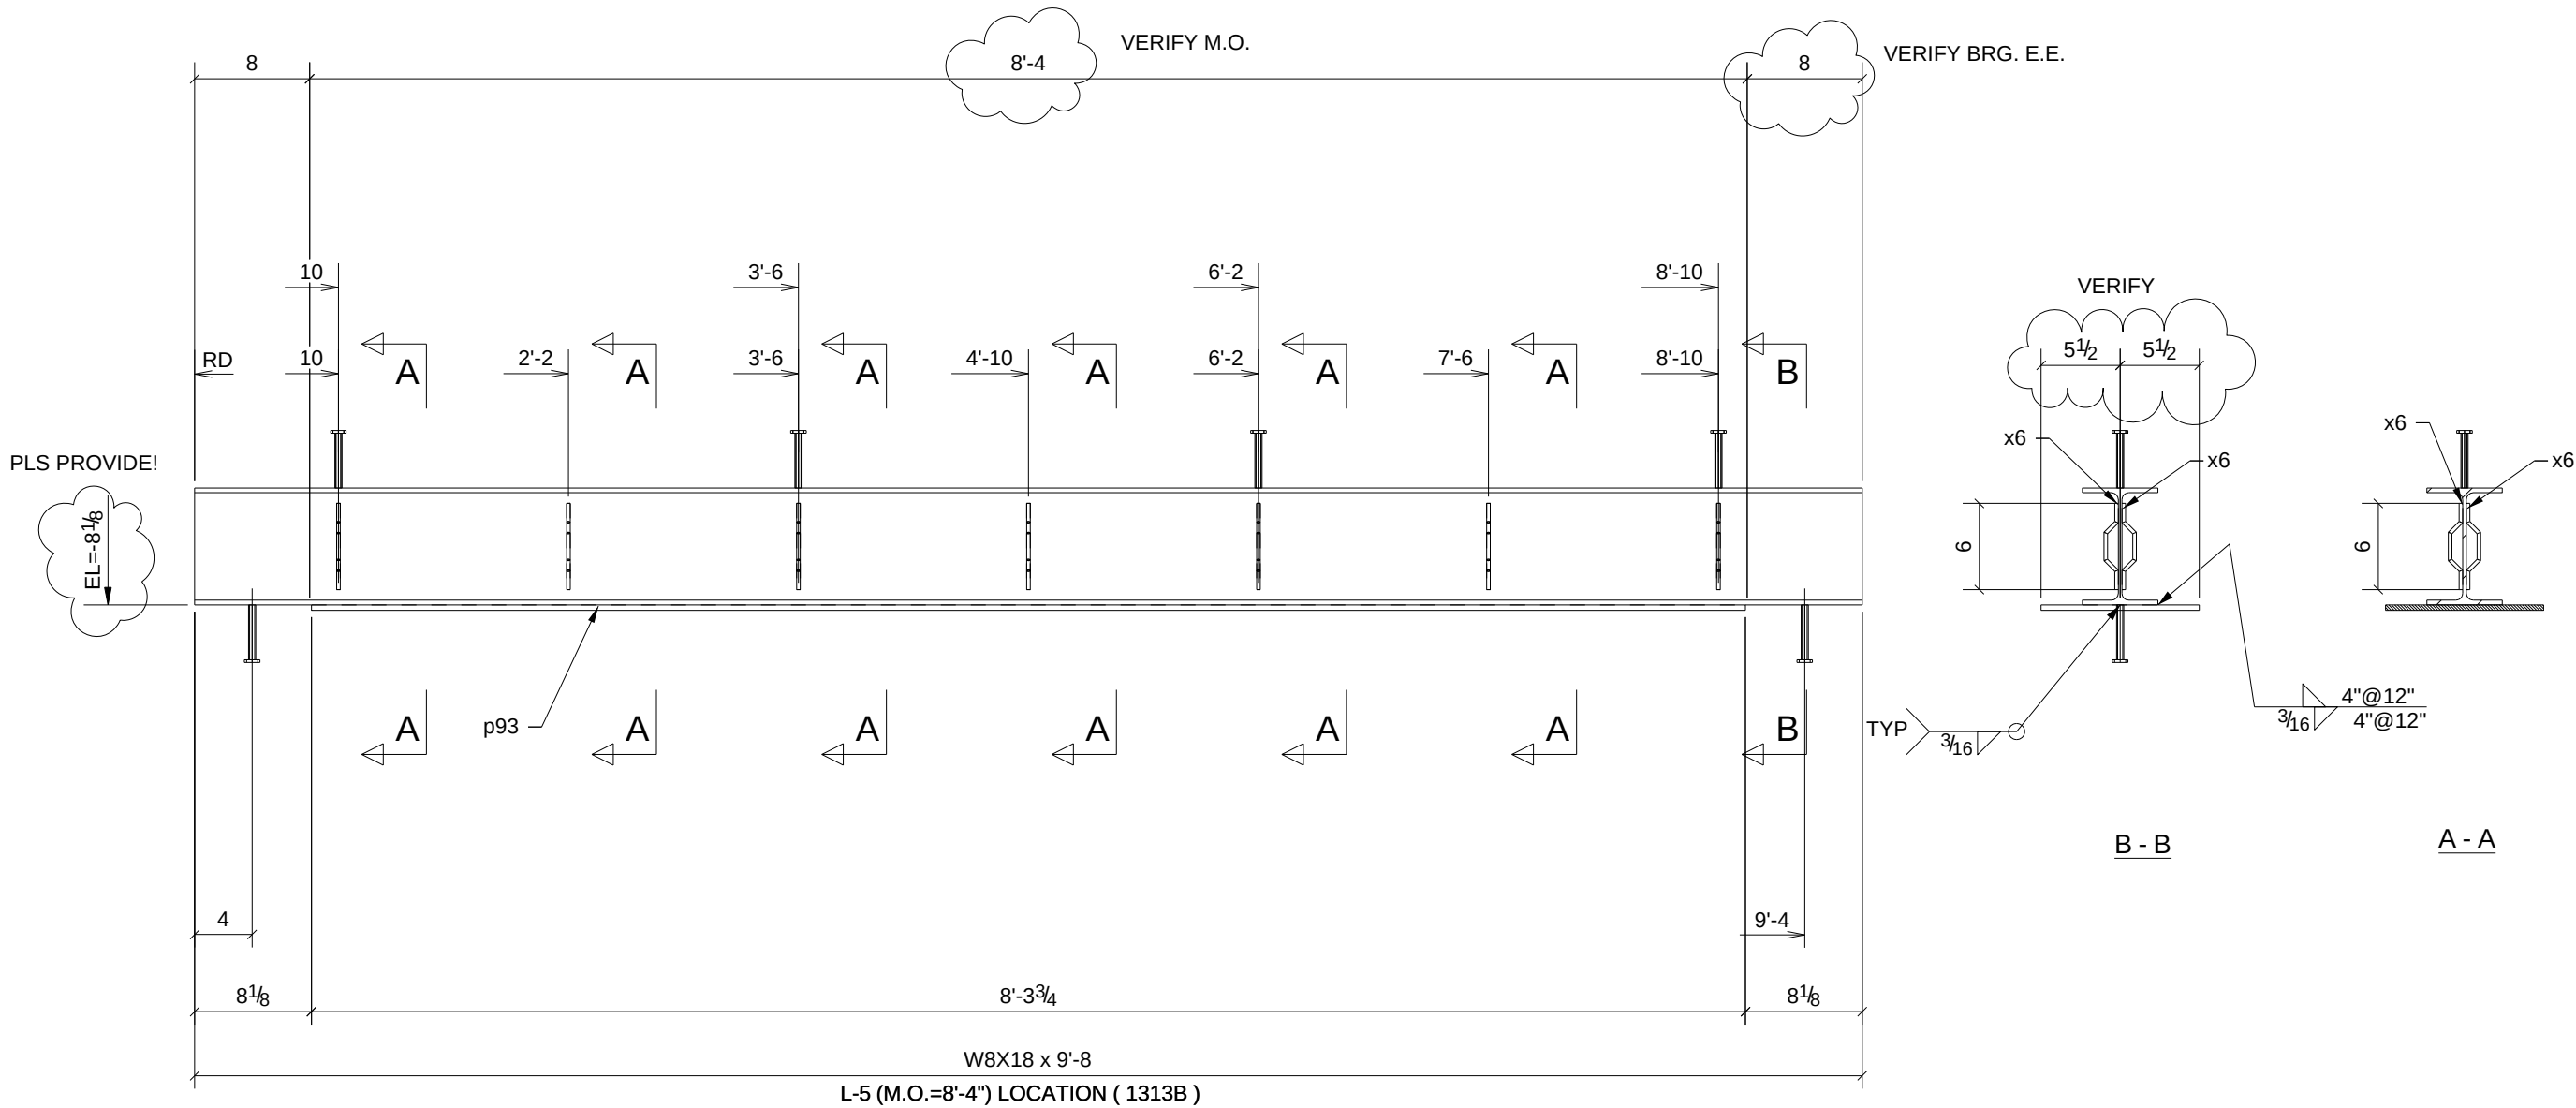

PHASE				
1	2	3	4	5
0	1	0	0	0


ONE - LINTEL - 22L3

W	8 1/8"x1/4"
F	5 1/4"x5/16"

BILL OF MATERIAL

SHIP	MARK	NO PCS	DESCRIPTION	LENGTH	PIECE MARK	REMARKS
1	22L3	1	W8X18	9'-8"		SQ-2 A992 GALVANIZED
		1	BAR3/8"X11"	8'-3 3/4"	p93	A36 GALVANIZED
		14	H&B #359	0'-6 3/16"	x6	A36 GALVANIZED
		6	STUD 1/2" DIA	0'-4"		

A	For Approval		7/20/10	TMc	TAN
REV.	DESCRIPTION		DATE	DWN	CHK
GENERAL NOTES			JOB USE		
MATERIAL: A992 / A36	ELECTRODES: E70XX LH	REF. DRG.	SHOP		
HOLES: 13/16 DIA. U/N	CONN'S.: -				
SURFACE PREP. SSPC-SP-2 AND PAINT: GREY PRIMER DEVOE NA-195 (U.N,)			APPROVAL		
DESCRIPTION: LINTEL					
PROJECT NAME	Hamilton High School Phase III				
LOCATION	Hamilton City School District - Hamilton				
CONTRACTOR	GC Contracting				
	Avenue Fabricating Inc. 1281 Clough Pike Batavia, OH 45103 (513) 752-1911		DRAWN BY TMc	DATE 07/19/2010	
			CHKD. BY TAN	DATE	
			JOB No. 10-16	DRG. No. 22L3	REV. 1

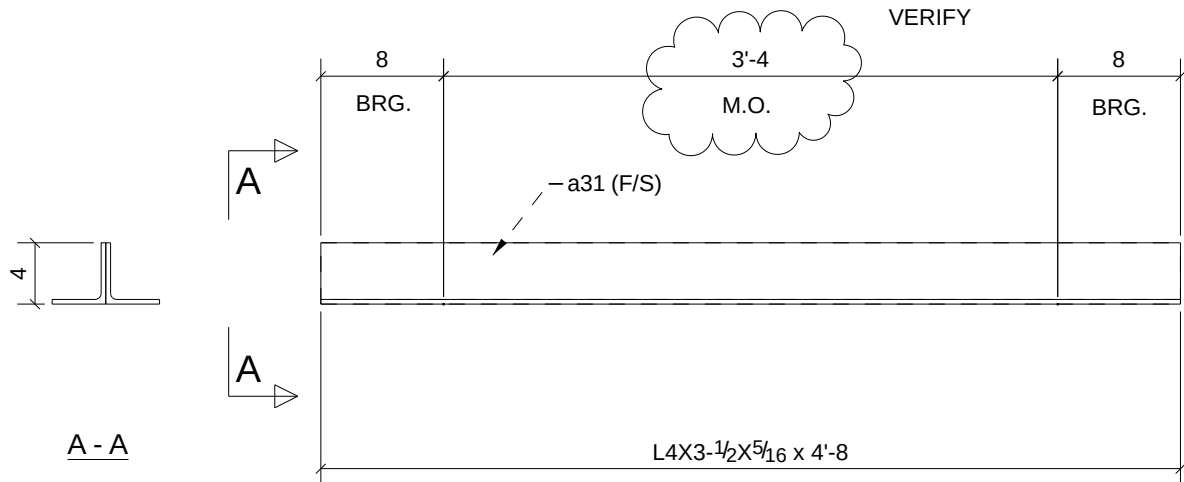

L-4 (M.O.=3'-4") LOCATION (1312)

(1318)
(1304)
(1306)
(1307)
(1316A)
(1317)
(1319A)
(1320)
(1321A)
(1327)

ARCH./ENG/OWNER
PLEASE VERIFY / PROVIDE
TYPE & LOCATIONS
ERECTOR / GC ~ PLEASE
VERIFY / PROVIDE
M.O. @ EACH LOCATION

PHASE				
1	2	3	4	5
0	11	0	0	0


11 - LINTELS - 22L4

(2 ANGLES EACH LINTEL)

BILL OF MATERIAL

SHIP	MARK	NO PCS	DESCRIPTION	LENGTH	PIECE MARK	REMARKS
11	22L4	11	L4X3-1/2X5/16	4'-8"		SQ-2 A36 1 S/C STD PRIMER
		11	L4X3-1/2X5/16	4'-8"	a31	A36 1 S/C STD PRIMER

A	For Approval			7/20/10	TMc	TAN
REV.	DESCRIPTION			DATE	DWN	CHK
GENERAL NOTES				JOB USE		
MATERIAL: A992 / A36		ELECTRODES: E70XX LH		REF. DRG.		
HOLES: 13/16 DIA. U/N		CONN'S.: -			SHOP	
SURFACE PREP. SSPC-SP-2				APPROVAL		
AND PAINT: GREY PRIMER DEVOE NA-195 (U.N,)						
DESCRIPTION: LINTEL						
PROJECT NAME		Hamilton High School Phase III				
LOCATION		Hamilton City School District - Hamilton				
CONTRACTOR		GC Contracting				
	Avenue Fabricating Inc. 1281 Clough Pike Batavia, OH 45103 (513) 752-1911			DRAWN BY TMc		DATE 07/20/2010
				CHKD. BY TAN		DATE
				JOB No. 10-16		DRG. No. 22L4

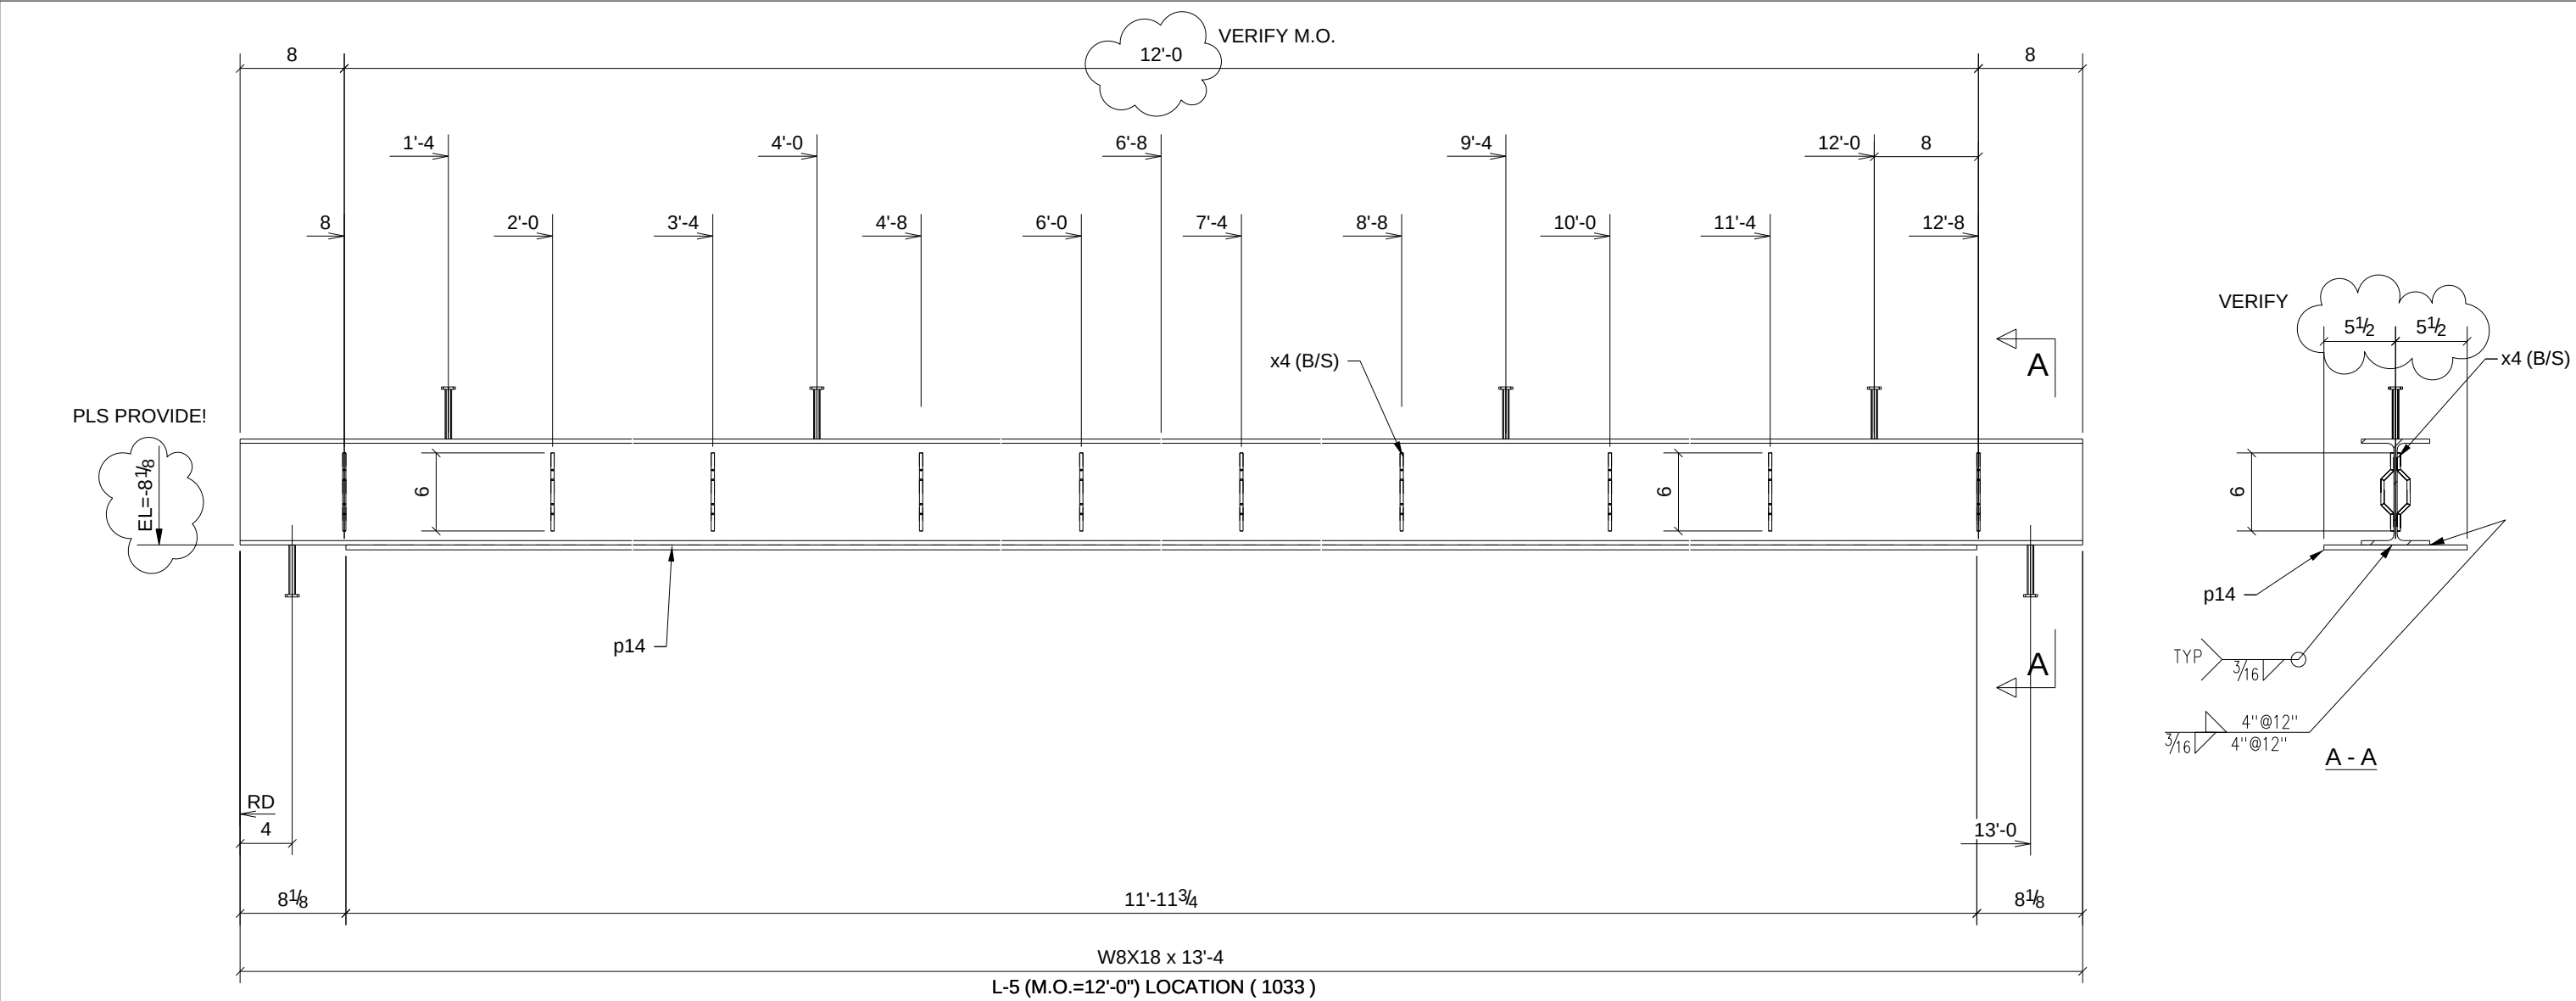


PHASE				
1	2	3	4	5
0	1	0	0	0

ONE - LINTEL - 22L5

W	8 1/8" x 1/4"
F	5 1/4" x 5/16"

A	For Approval		7/20/10	TMc	TAN
REV.	DESCRIPTION		DATE	DWN	CHK
GENERAL NOTES			JOB USE		
MATERIAL: A992 / A36		ELECTRODES: E70XX LH	REF. DRG.		
HOLES: 13/16 DIA. U/N		CONN'S.: -		SHOP	
SURFACE PREP. SSPC-SP-2			APPROVAL		
AND PAINT: GREY PRIMER DEVOE NA-195 (U.N.)					
DESCRIPTION: LINTEL					
PROJECT NAME		Hamilton High School Phase III			
LOCATION		Hamilton City School District - Hamilton			
CONTRACTOR		GC Contracting			
	Avenue Fabricating Inc. 1281 Clough Pike Batavia, OH 45103 (513) 752-1911		DRAWN BY TMc		DATE 07/19/2010
			CHKD. BY TAN		DATE
			JOB No. 10-16		DRG. No. 22L5

BILL OF MATERIAL						
SHIP	MARK	NO PCS	DESCRIPTION	LENGTH	PIECE MARK	REMARKS
1	22L5	1	W8X18	13'-4"		SQ-2 A992 1 S/C STD PRIMER
		1	BAR3/8"X11"	11'-11 3/4"	p14	A36 1 S/C STD PRIMER
		20	H&B #359	0'-6 3/16"	x4	A36 1 S/C STD PRIMER
		7	STUD 1/2" DIA	0'-4"		

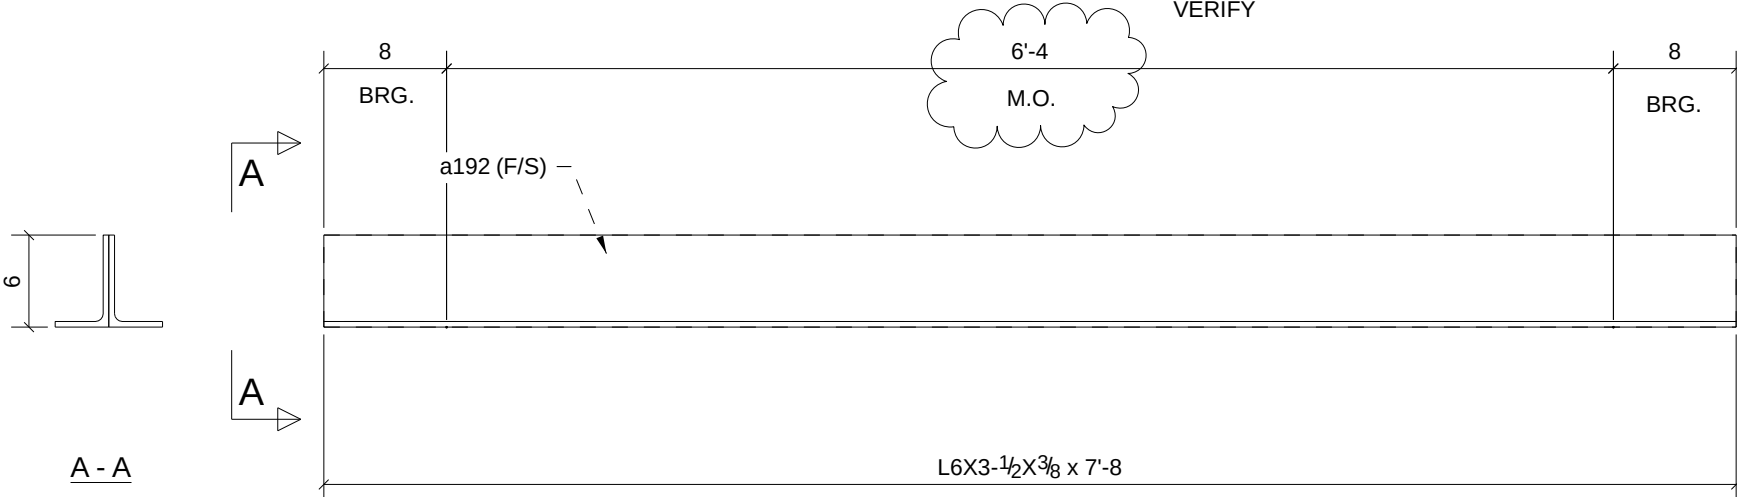

L-6 (M.O.=6'-4") LOCATION (1313A)
(1026)
(1028C)

ARCH./ENG/OWNER
PLEASE VERIFY / PROVIDE
TYPE & LOCATIONS
ERECTOR / GC ~ PLEASE
VERIFY / PROVIDE
M.O. @ EACH LOCATION

PHASE				
1	2	3	4	5
0	3	0	0	0


3 - LINTELS - 22L6

(3 ANGLES EACH LINTEL)

BILL OF MATERIAL

SHIP	MARK	NO PCS	DESCRIPTION	LENGTH	PIECE MARK	REMARKS
3	22L6	3	L6X3-1/2X3/8	7'-8"		SQ-2 A36 1 S/C STD PRIMER
		3	L6X3-1/2X3/8	7'-8"	a192	A36 1 S/C STD PRIMER

A	For Approval			7/20/10	TMc	TAN
REV.	DESCRIPTION			DATE	DWN	CHK
GENERAL NOTES				JOB USE		
				SHOP		
MATERIAL: A992 / A36		ELECTRODES: E70XX LH	REF. DRG.			
HOLES: 13/16 DIA. U/N		CONN'S.: -				
SURFACE PREP. SS-PC-SP-2				APPROVAL		
AND PAINT: GREY PRIMER DEVOE NA-195 (U.N,)						
DESCRIPTION: LINTEL						
PROJECT NAME		Hamilton High School Phase III				
LOCATION		Hamilton City School District - Hamilton				
CONTRACTOR		GC Contracting				
	Avenue Fabricating Inc. 1281 Clough Pike Batavia, OH 45103 (513) 752-1911			DRAWN BY TMc		DATE 07/20/2010
				CHKD. BY TAN		DATE
				JOB No. 10-16		DRG. No. 22L6

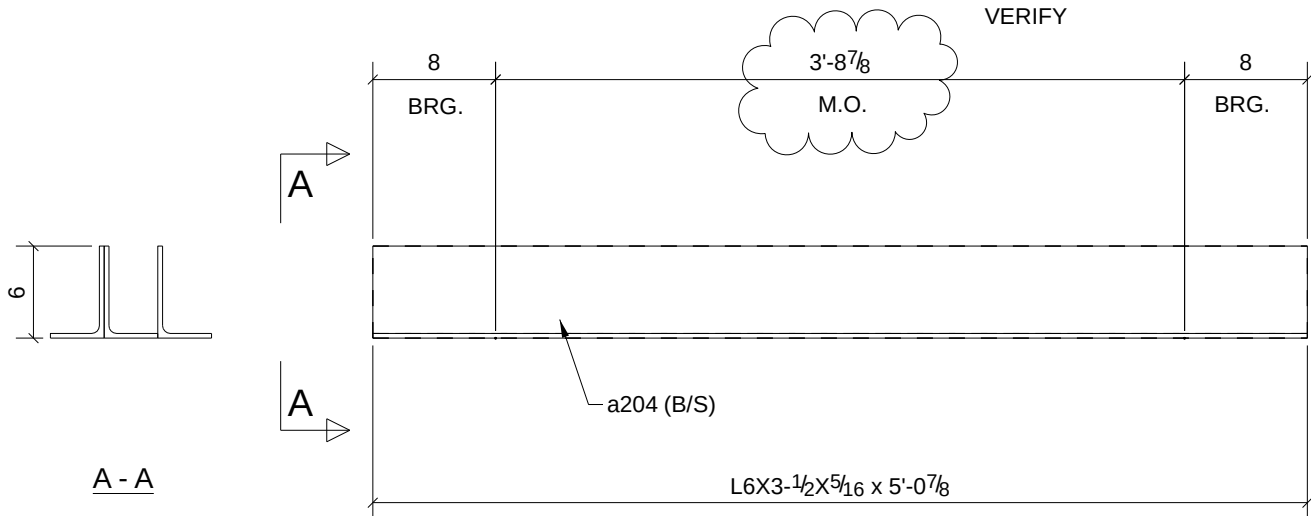

L-7 (M.O.=3'-8-7/8") LOCATION (1313)

ARCH./ENG/OWNER
PLEASE VERIFY / PROVIDE
TYPE & LOCATIONS
ERECTOR / GC ~ PLEASE
VERIFY / PROVIDE
M.O. @ EACH LOCATION

PHASE				
1	2	3	4	5
0	1	0	0	0

ONE - LINTEL - 22L7


(3 ANGLES EACH LINTEL)

GALVANIZED?
APPROVER PLEASE VERIFY

BILL OF MATERIAL

SHIP	MARK	NO PCS	DESCRIPTION	LENGTH	PIECE MARK	REMARKS
1	22L7	1	L6X3-1/2X5/16	5'-0 7/8"		SQ-2 A36 1 S/C STD PRIMER
		2	L6X3-1/2X5/16	5'-0 7/8"	a204	A36 1 S/C STD PRIMER

A	For Approval				7/20/10	TMc		TAN	
REV.	DESCRIPTION					DATE	DWN		CHK
GENERAL NOTES						JOB USE			
MATERIAL: A992 / A36		ELECTRODES: E70XX LH		REF. DRG.		SHOP			
HOLES: 13/16 DIA. U/N		CONN'S.: -							
SURFACE PREP. SSPC-SP-2						APPROVAL			
AND PAINT: GREY PRIMER DEVOE NA-195 (U.N.)									
DESCRIPTION: LINTEL									
PROJECT NAME		Hamilton High School Phase III							
LOCATION		Hamilton City School District - Hamilton							
CONTRACTOR		GC Contracting							
		Avenue Fabricating Inc. 1281 Clough Pike Batavia, OH 45103 (513) 752-1911				DRAWN BY TMc		DATE 07/20/2010	
						CHKD. BY TAN		DATE	
						JOB No. 10-16		DRG. No. 22L7	

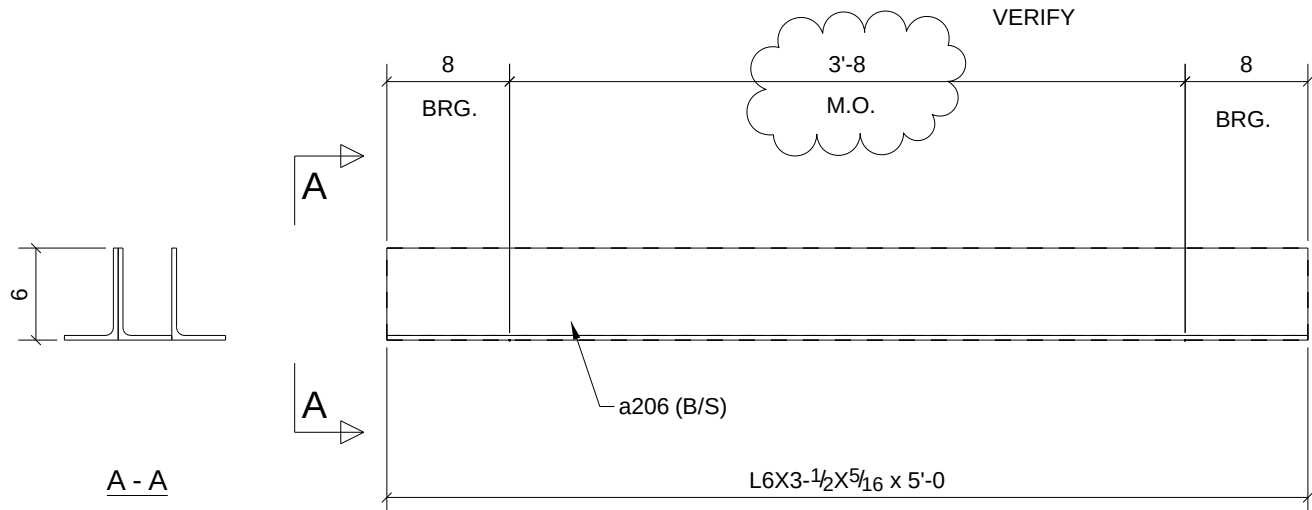

L-7 (M.O.=3'-4") LOCATION (1322)
(1325)

ARCH./ENG/OWNER
PLEASE VERIFY / PROVIDE
TYPE & LOCATIONS
ERECTOR / GC ~ PLEASE
VERIFY / PROVIDE
M.O. @ EACH LOCATION

PHASE				
1	2	3	4	5
0	2	0	0	0

2 - LINTELS - 22L8


(3 ANGLES EACH LINTEL)

BILL OF MATERIAL

SHIP	MARK	NO PCS	DESCRIPTION	LENGTH	PIECE MARK	REMARKS
2	22L8	2	L6X3-1/2X5/16	5'-0"		SQ-2 A36 1 S/C STD PRIMER
		4	L6X3-1/2X5/16	5'-0"	a206	A36 1 S/C STD PRIMER

A	For Approval			7/20/10	TMc	TAN	
REV.	DESCRIPTION			DATE	DWN	CHK	
GENERAL NOTES				JOB USE			
				MATERIAL: A992 / A36		ELECTRODES: E70XX LH	
HOLES: 13/16 DIA. U/N		CONN'S.: -		SHOP			
SURFACE PREP. SSPC-SP-2				APPROVAL			
AND PAINT: GREY PRIMER DEVOE NA-195 (U.N,)							
DESCRIPTION: LINTEL							
PROJECT NAME		Hamilton High School Phase III					
LOCATION		Hamilton City School District - Hamilton					
CONTRACTOR		GC Contracting					
	Avenue Fabricating Inc. 1281 Clough Pike Batavia, OH 45103 (513) 752-1911			DRAWN BY		DATE	
				TMc		07/20/2010	
				CHKD. BY		DATE	
				TAN			
				JOB No.		DRG. No.	REV.
				10-16		22L8	1

Avenue Fabricating Inc.
1281 Clough Pike
Batavia, OH 45103
(513) 752-1911

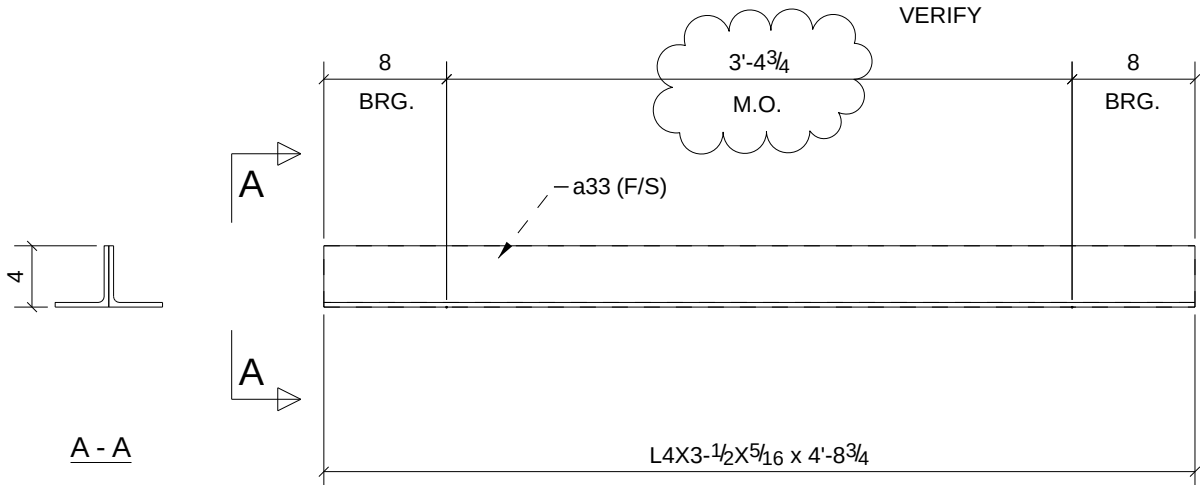

L-4 (M.O.=3'-4-3/4") LOCATION (1027-DF)

ARCH./ENG/OWNER
PLEASE VERIFY / PROVIDE
TYPE & LOCATIONS
ERECTOR / GC ~ PLEASE
VERIFY / PROVIDE
M.O. @ EACH LOCATION

PHASE				
1	2	3	4	5
0	1	0	0	0


ONE - LINTEL - 22L9

(2 ANGLES EACH LINTEL)

BILL OF MATERIAL

SHIP	MARK	NO PCS	DESCRIPTION	LENGTH	PIECE MARK	REMARKS
1	22L9	1	L4X3-1/2X5/16	4'-8 3/4"		SQ-2 A36 1 S/C STD PRIMER
		1	L4X3-1/2X5/16	4'-8 3/4"	a33	A36 1 S/C STD PRIMER

A	For Approval			7/20/10	TMc	TAN
REV.	DESCRIPTION			DATE	DWN	CHK
GENERAL NOTES				JOB USE		
MATERIAL: A992 / A36		ELECTRODES: E70XX LH	REF. DRG.	SHOP		
HOLES: 13/16 DIA. U/N		CONN'S.: -				
SURFACE PREP. SSPC-SP-2 AND PAINT: GREY PRIMER DEVOE NA-195 (U.N,)				APPROVAL		
DESCRIPTION: LINTEL						
PROJECT NAME		Hamilton High School Phase III				
LOCATION		Hamilton City School District - Hamilton				
CONTRACTOR		GC Contracting				
	Avenue Fabricating Inc. 1281 Clough Pike Batavia, OH 45103 (513) 752-1911			DRAWN BY TMc		DATE 07/20/2010
				CHKD. BY TAN		DATE
				JOB No. 10-16		DRG. No. 22L9

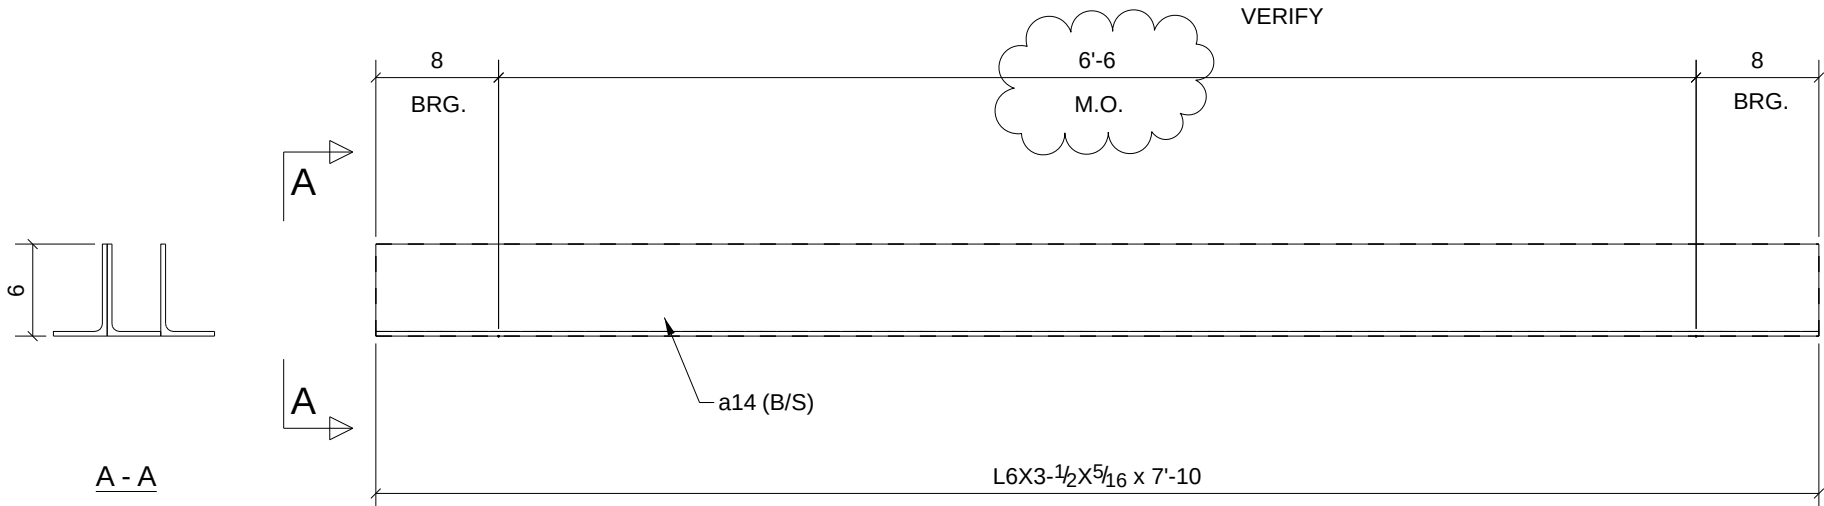

L-7 (M.O.=6'-6") LOCATION (1161) (2X)
(1156)
(1155)
(1151)

ARCH./ENG/OWNER
PLEASE VERIFY / PROVIDE
TYPE & LOCATIONS
ERECTOR / GC ~ PLEASE
VERIFY / PROVIDE
M.O. @ EACH LOCATION

PHASE				
1	2	3	4	5
0	0	5	0	0

5 - LINTELS - 32L1

(3 ANGLES EACH LINTEL)

BILL OF MATERIAL

SHIP	MARK	NO PCS	DESCRIPTION	LENGTH	PIECE MARK	REMARKS
5	32L1	5	L6X3-1/2X5/16	7'-10"		SQ-2 A36 GALVANIZED
		10	L6X3-1/2X5/16	7'-10"	a14	A36 GALVANIZED

A	For Approval			7/20/10	TMc	TAN
REV.	DESCRIPTION			DATE	DWN	CHK
GENERAL NOTES				JOB USE		
				SHOP		
MATERIAL: A992 / A36		ELECTRODES: E70XX LH	REF. DRG.			
HOLES: 13/16 DIA. U/N		CONN'S.: -				
SURFACE PREP. SS-PC-SP-2				APPROVAL		
AND PAINT: GREY PRIMER DEVOE NA-195 (U.N,)						
DESCRIPTION: LINTEL						
PROJECT NAME		Hamilton High School Phase III				
LOCATION		Hamilton City School District - Hamilton				
CONTRACTOR		GC Contracting				
	Avenue Fabricating Inc. 1281 Clough Pike Batavia, OH 45103 (513) 752-1911			DRAWN BY TMc		DATE 07/20/2010
				CHKD. BY TAN		DATE
				JOB No. 10-16		DRG. No. 32L1




ARCH./ENG/OWNER
PLEASE VERIFY / PROVIDE
TYPE & LOCATIONS
ERECTOR / GC ~ PLEASE
VERIFY / PROVIDE
M.O. @ EACH LOCATION

PHASE				
1	2	3	4	5
0	0	1	0	0

(3 ANGLES EACH LINTEL)

BILL OF MATERIAL						
SHIP	MARK	NO PCS	DESCRIPTION	LENGTH	PIECE MARK	REMARKS
1	32L10	1	L4X3-1/2X5/16	4'-8"		SQ-2 A36 1 S/C STD PRIMER
		2	L4X3-1/2X5/16	4'-8"	a31	A36 1 S/C STD PRIMER

A	For Approval	7/23/10	TMc	TAN
REV.	DESCRIPTION	DATE	DWN	CHK
GENERAL NOTES		JOB USE		
MATERIAL: A992 / A36	ELECTRODES: E70XX LH	REF. DRG.		
HOLES: 13/16 DIA. U/N	CONN'S.: -		SHOP	
SURFACE PREP. SSPC-SP-2 AND PAINT: GREY PRIMER DEVOE NA-195 (U.N.)		APPROVAL		
DESCRIPTION: LINTEL				
PROJECT NAME	Hamilton High School Phase III			
LOCATION	Hamilton City School District - Hamilton			
CONTRACTOR	GC Contracting			
	Avenue Fabricating Inc. 1281 Clough Pike Batavia, OH 45103 (513) 752-1911	DRAWN BY TMc		DATE 07/23/2010
		CHKD. BY TAN		DATE
		JOB No. 10-16	DRG. No. 32L10	REV. 1

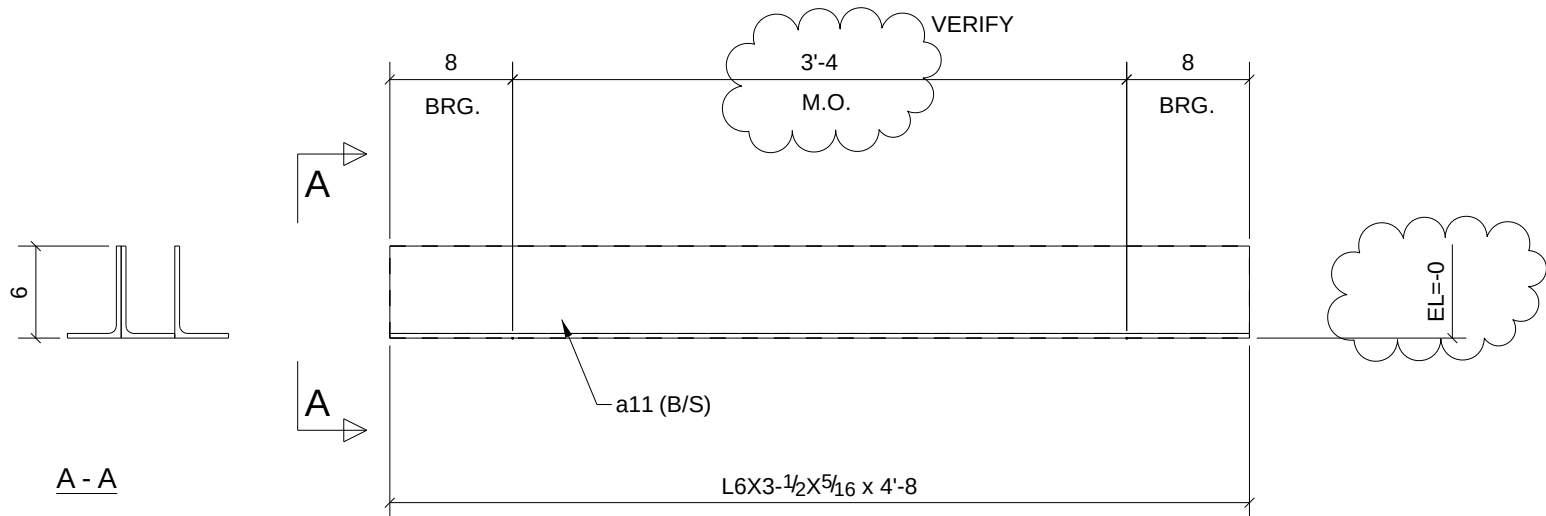

[L-7 (M.O.=3'-4") LOCATION (2136)]

ARCH./ENG/OWNER
PLEASE VERIFY / PROVIDE
TYPE & LOCATIONS
ERECTOR / GC ~ PLEASE
VERIFY / PROVIDE
M.O. @ EACH LOCATION

PHASE				
1	2	3	4	5
0	0	1	0	0


ONE - LINTEL - 32L11

(3 ANGLES EACH LINTEL)

BILL OF MATERIAL

SHIP	MARK	NO PCS	DESCRIPTION	LENGTH	PIECE MARK	REMARKS
1	32L11	1	L6X3-1/2X5/16	4'-8"		SQ-2 A36 1 S/C STD PRIMER
		2	L6X3-1/2X5/16	4'-8"	a11	A36 1 S/C STD PRIMER

A	For Approval	7/23/10	TMc	TAN
REV.	DESCRIPTION	DATE	DWN	CHK
GENERAL NOTES		JOB USE		
MATERIAL: A992 / A36	ELECTRODES: E70XX LH	REF. DRG.	SHOP	
HOLES: 13/16 DIA. U/N	CONN'S.: -			
SURFACE PREP. SSPC-SP-2	AND PAINT: GREY PRIMER DEVOE NA-195 (U.N,)		APPROVAL	
DESCRIPTION:	LINTEL			
PROJECT NAME	Hamilton High School Phase III			
LOCATION	Hamilton City School District - Hamilton			
CONTRACTOR	GC Contracting			
	Avenue Fabricating Inc. 1281 Clough Pike Batavia, OH 45103 (513) 752-1911	DRAWN BY TMc	DATE 07/23/2010	
		CHKD. BY TAN	DATE	
		JOB No. 10-16	DRG. No. 32L11	REV. 1

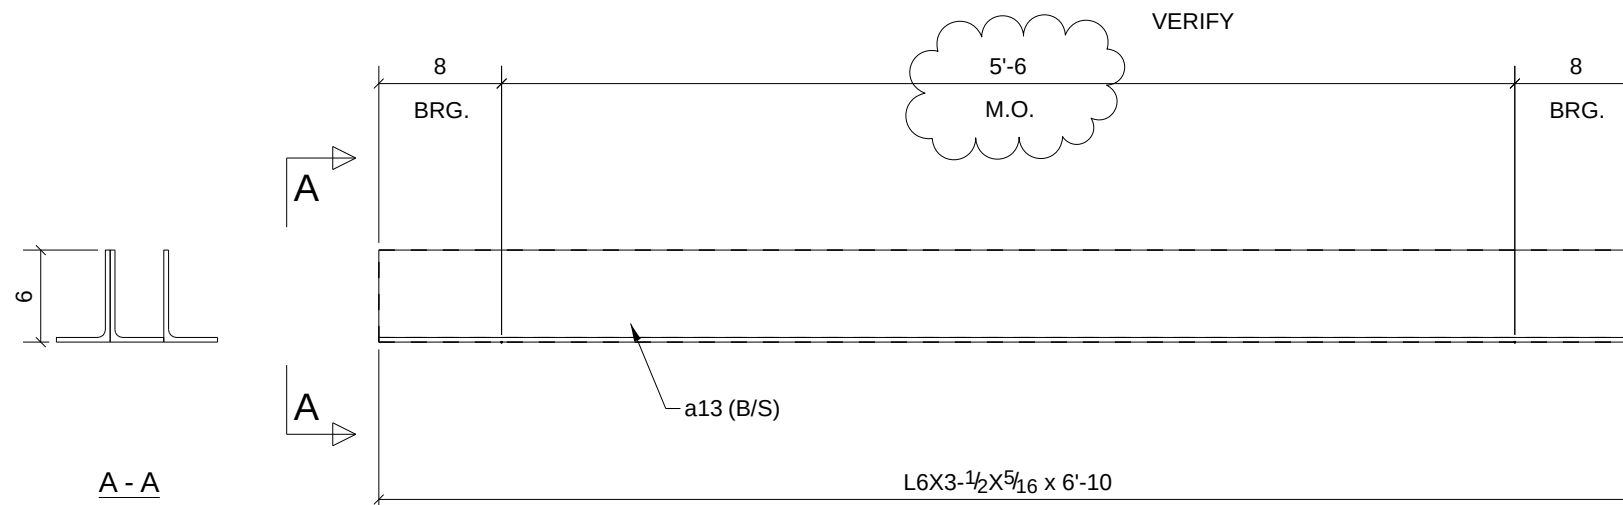

L-7 (M.O.=5'-6") LOCATION (2127)

ARCH./ENG/OWNER
PLEASE VERIFY / PROVIDE
TYPE & LOCATIONS
ERECTOR / GC ~ PLEASE
VERIFY / PROVIDE
M.O. @ EACH LOCATION

PHASE				
1	2	3	4	5
0	0	1	0	0

ONE - LINTEL - 32L12

(3 ANGLES EACH LINTEL)

BILL OF MATERIAL						
SHIP	MARK	NO PCS	DESCRIPTION	LENGTH	PIECE MARK	REMARKS
1	32L12	1	L6X3-1/2X5/16	6'-10"		SQ-2 A36 GALVANIZED
		2	L6X3-1/2X5/16	6'-10"	a13	A36 GALVANIZED

A	For Approval	7/23/10	TMc	TAN
REV.	DESCRIPTION	DATE	DWN	CHK
GENERAL NOTES		JOB USE		
MATERIAL: A992 / A36	ELECTRODES: E70XX LH	REF. DRG.		
HOLES: 13/16 DIA. U/N	CONN'S.: -		SHOP	
SURFACE PREP. SSPC-SP-2 AND PAINT: GREY PRIMER DEVOE NA-195 (U.N.)		APPROVAL		
DESCRIPTION:	LINTEL			
PROJECT NAME	Hamilton High School Phase III			
LOCATION	Hamilton City School District - Hamilton			
CONTRACTOR	GC Contracting			
	Avenue Fabricating Inc. 1281 Clough Pike Batavia, OH 45103 (513) 752-1911	DRAWN BY TMc	DATE 07/23/2010	
		CHKD. BY TAN	DATE	
		JOB No. 10-16	DRG. No. 32L12	REV. 1




ARCH./ENG./OWNER
PLEASE VERIFY / PROVIDE
TYPE & LOCATIONS
ERECTOR / GC ~ PLEASE
VERIFY / PROVIDE
M.O. @ EACH LOCATION


(3 ANGLES EACH LINTEL)

BILL OF MATERIAL

BILL OF MATERIAL						
SHIP	MARK	NO PCS	DESCRIPTION	LENGTH	PIECE MARK	REMARKS
1	32L13	1	L6X3-1/2X5/16	5'-11"		SQ-2 A36 GALVANIZED
		2	L6X3-1/2X5/16	5'-11"	a223	A36 GALVANIZED

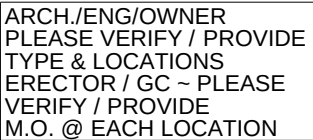

A	For Approval	7/23/10	TMc	TAN
REV.	DESCRIPTION	DATE	DWN	CHK
GENERAL NOTES		JOB USE		
MATERIAL: A992 / A36	ELECTRODES: E70XX LH	REF. DRG.		
HOLES: 13/16 DIA. U/N	CONN'S.: -		SHOP	
SURFACE PREP. SSPC-SP-2 AND PAINT: GREY PRIMER DEVOE NA-195 (U.N.)		APPROVAL		
DESCRIPTION: LINTEL				
PROJECT NAME Hamilton High School Phase III LOCATION Hamilton City School District - Hamilton				
CONTRACTOR GC Contracting				
	Avenue Fabricating Inc. 1281 Clough Pike Batavia, OH 45103 (513) 752-1911	DRAWN BY TMc	DATE 07/23/2010	
		CHKD. BY TAN	DATE	
		JOB No. 10-16	DRG. No. 32L14	REV. 1

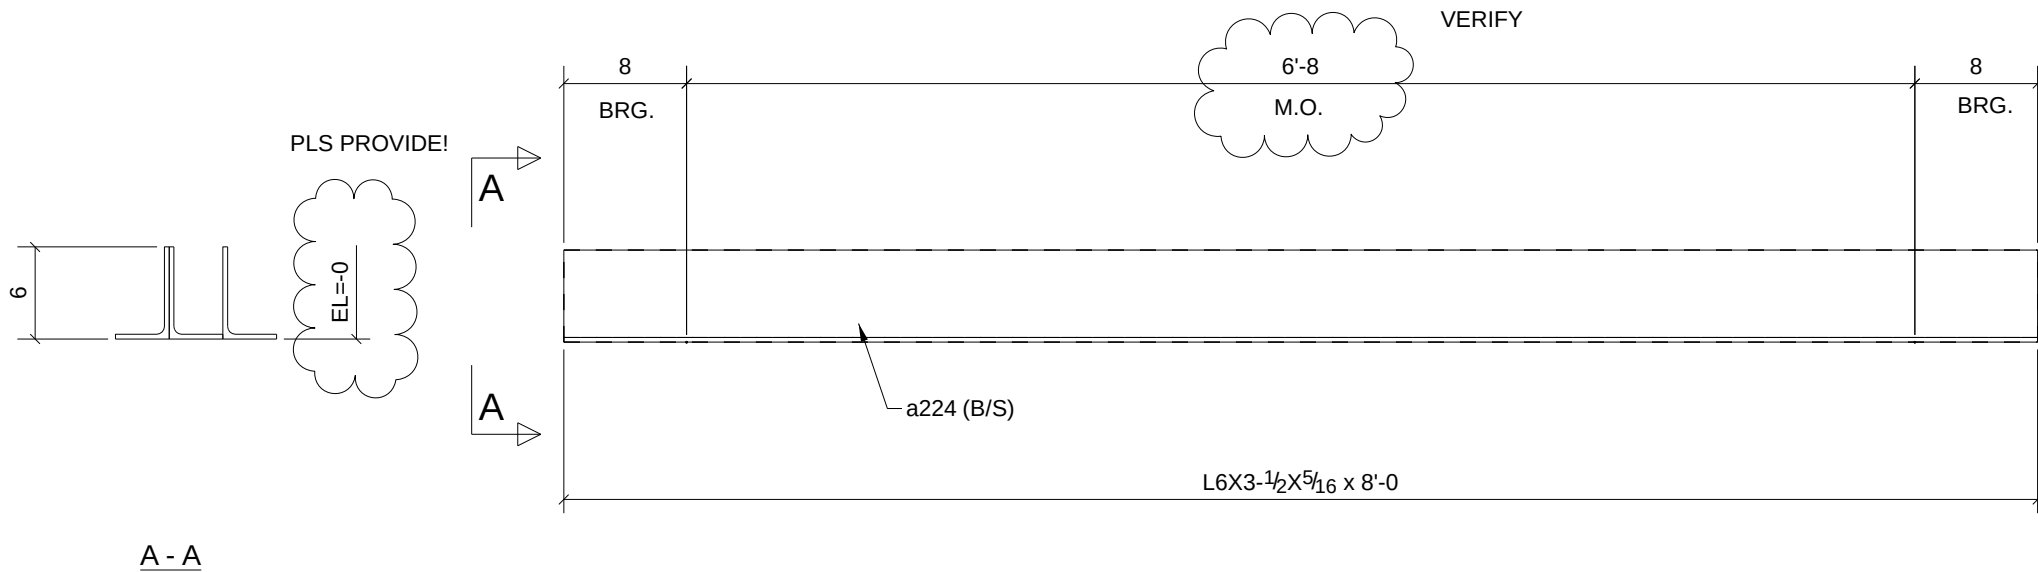

L-7 (M.O.=6'-8") LOCATION (2136)

ARCH./ENG/OWNER
PLEASE VERIFY / PROVIDE
TYPE & LOCATIONS
ERECTOR / GC ~ PLEASE
VERIFY / PROVIDE
M.O. @ EACH LOCATION

PHASE				
1	2	3	4	5
0	0	2	0	0


2 - LINTELS - 32L15

(3 ANGLES EACH LINTEL)

BILL OF MATERIAL

SHIP	MARK	NO PCS	DESCRIPTION	LENGTH	PIECE MARK	REMARKS
2	32L15	2	L6X3-1/2X5/16	8'-0"		SQ-2 A36 GALVANIZED
		4	L6X3-1/2X5/16	8'-0"	a224	A36 GALVANIZED

A	For Approval			7/23/10	TMc	TAN
REV.	DESCRIPTION			DATE	DWN	CHK
GENERAL NOTES				JOB USE		
MATERIAL: A992 / A36		ELECTRODES: E70XX LH		REF. DRG.		
HOLES: 13/16 DIA. U/N		CONN'S.: -				SHOP
SURFACE PREP. SS-PC-SP-2				APPROVAL		
AND PAINT: GREY PRIMER DEVOE NA-195 (U.N.)						
DESCRIPTION: LINTEL						
PROJECT NAME		Hamilton High School Phase III				
LOCATION		Hamilton City School District - Hamilton				
CONTRACTOR		GC Contracting				
	Avenue Fabricating Inc. 1281 Clough Pike Batavia, OH 45103 (513) 752-1911			DRAWN BY TMc		DATE 07/23/2010
				CHKD. BY TAN		DATE
				JOB No. 10-16		DRG. No. 32L15

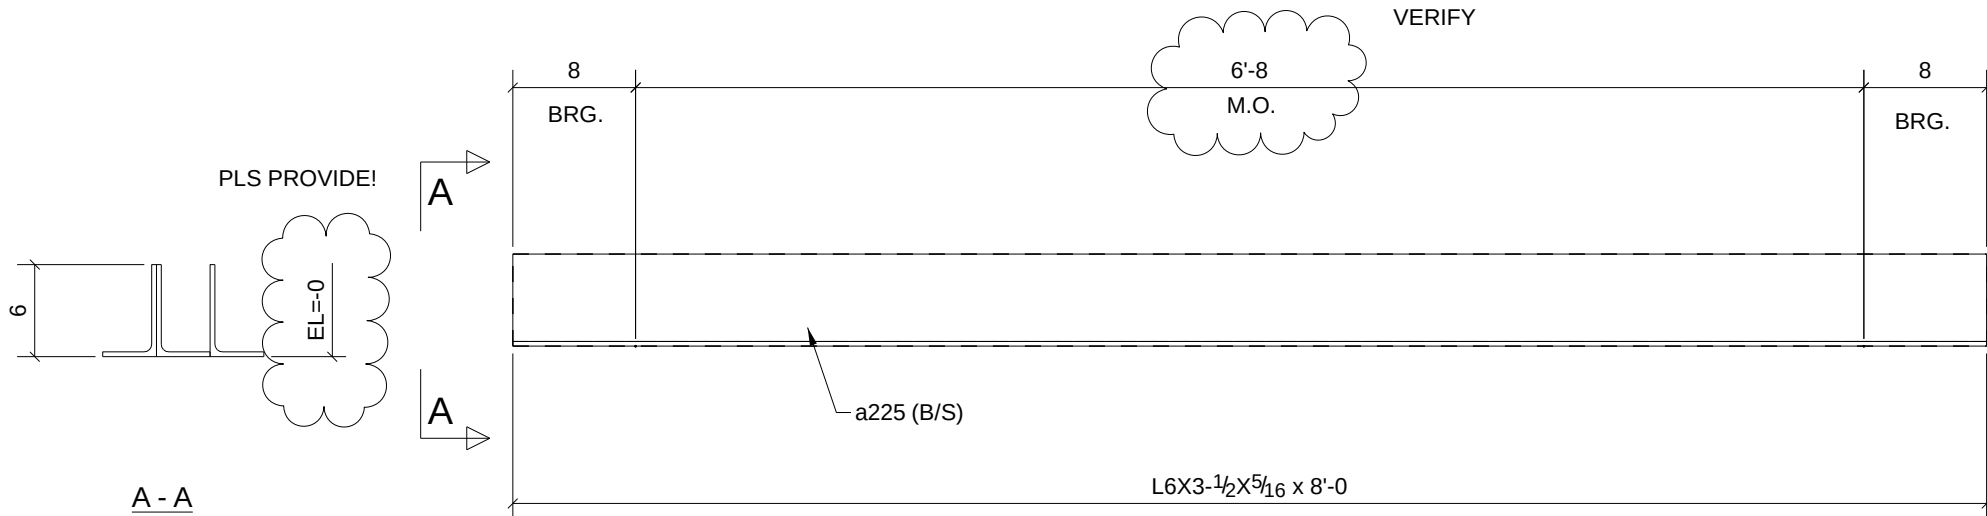

L-7 (M.O.=6'-8") LOCATION (2136)

ARCH./ENG/OWNER
PLEASE VERIFY / PROVIDE
TYPE & LOCATIONS
ERECTOR / GC ~ PLEASE
VERIFY / PROVIDE
M.O. @ EACH LOCATION

PHASE				
1	2	3	4	5
0	0	1	0	0


ONE - LINTEL - 32L16

(3 ANGLES EACH LINTEL)

BILL OF MATERIAL

SHIP	MARK	NO PCS	DESCRIPTION	LENGTH	PIECE MARK	REMARKS
1	32L16	1	L6X3-1/2X5/16	8'-0"		SQ-2 A36 1 S/C STD PRIMER
		2	L6X3-1/2X5/16	8'-0"	a225	A36 1 S/C STD PRIMER

A	For Approval	7/23/10	TMc	TAN
REV.	DESCRIPTION	DATE	DWN	CHK
GENERAL NOTES		JOB USE		
MATERIAL: A992 / A36	ELECTRODES: E70XX LH	REF. DRG.	SHOP	
HOLES: 13/16 DIA. U/N	CONN'S.: -		APPROVAL	
SURFACE PREP. SSPC-SP-2 AND PAINT: GREY PRIMER DEVOE NA-195 (U.N,)				
DESCRIPTION: LINTEL				
PROJECT NAME Hamilton High School Phase III LOCATION Hamilton City School District - Hamilton				
CONTRACTOR GC Contracting				
	Avenue Fabricating Inc. 1281 Clough Pike Batavia, OH 45103 (513) 752-1911	DRAWN BY TMc	DATE 07/23/2010	
		CHKD. BY TAN	DATE	
		JOB No. 10-16	DRG. No. 32L16	REV. 1

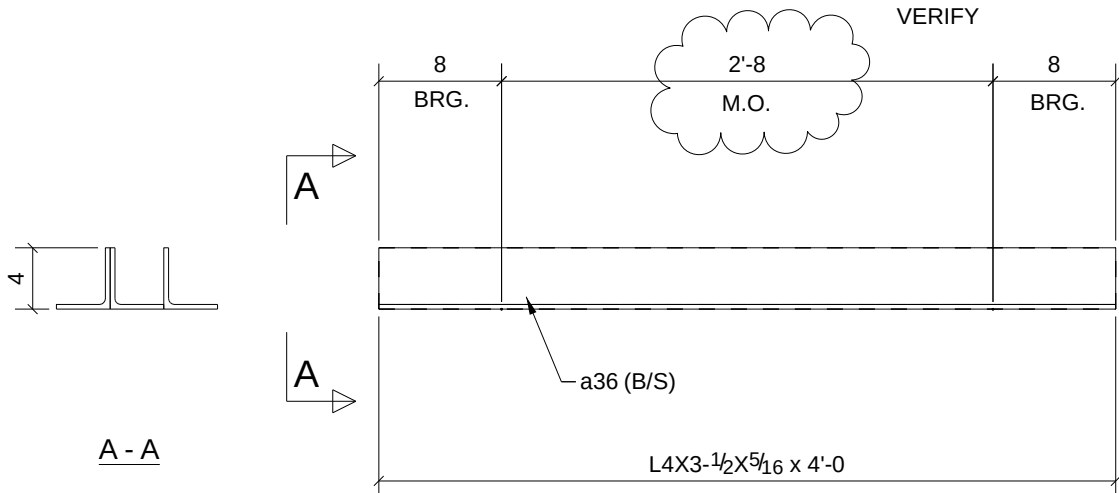

L-3 (M.O.=2'-8") LOCATION (1154)

ARCH./ENG/OWNER
PLEASE VERIFY / PROVIDE
TYPE & LOCATIONS
ERECTOR / GC ~ PLEASE
VERIFY / PROVIDE
M.O. @ EACH LOCATION

PHASE				
1	2	3	4	5
0	0	1	0	0

ONE - LINTEL - 32L2


(3 ANGLES EACH LINTEL)

BILL OF MATERIAL

SHIP	MARK	NO PCS	DESCRIPTION	LENGTH	PIECE MARK	REMARKS
1	32L2	1	L4X3-1/2X5/16	4'-0"		SQ-2 A36 GALVANIZED
		2	L4X3-1/2X5/16	4'-0"	a36	A36 GALVANIZED

A	For Approval		7/20/10	TMc	TAN
REV.	DESCRIPTION		DATE	DWN	CHK
GENERAL NOTES			JOB USE		
MATERIAL: A992 / A36		ELECTRODES: E70XX LH	REF. DRG.		
HOLES: 13/16 DIA. U/N		CONN'S.: -		SHOP	
SURFACE PREP. SSPC-SP-2			APPROVAL		
AND PAINT: GREY PRIMER DEVOE NA-195 (U.N,)					
DESCRIPTION: LINTEL					
PROJECT NAME		Hamilton High School Phase III			
LOCATION		Hamilton City School District - Hamilton			
CONTRACTOR		GC Contracting			
	Avenue Fabricating Inc. 1281 Clough Pike Batavia, OH 45103 (513) 752-1911		DRAWN BY		DATE
			TMc		07/20/2010
			CHKD. BY		DATE
			TAN		
		JOB No.	DRG. No.	REV.	
		10-16	32L2	1	

Avenue Fabricating Inc.
1281 Clough Pike
Batavia, OH 45103
(513) 752-1911

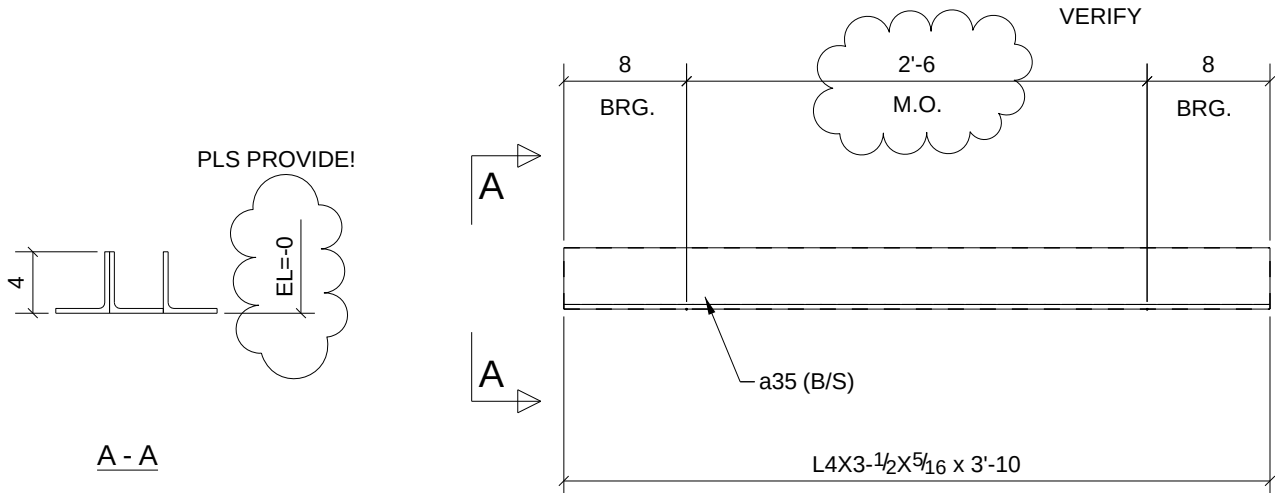

L-3 (M.O.=2'-6") LOCATION (1163)
(2133)

ARCH./ENG/OWNER
PLEASE VERIFY / PROVIDE
TYPE & LOCATIONS
ERECTOR / GC ~ PLEASE
VERIFY / PROVIDE
M.O. @ EACH LOCATION

PHASE				
1	2	3	4	5
0	0	2	0	0


2 - LINTELS - 32L3

(3 ANGLES EACH LINTEL)

BILL OF MATERIAL

SHIP	MARK	NO PCS	DESCRIPTION	LENGTH	PIECE MARK	REMARKS
2	32L3	2	L4X3-1/2X5/16	3'-10"		SQ-2 A36 GALVANIZED
		4	L4X3-1/2X5/16	3'-10"	a35	A36 GALVANIZED

A	For Approval			7/20/10	TMc	TAN
REV.	DESCRIPTION			DATE	DWN	CHK
GENERAL NOTES				JOB USE		
				SHOP		
MATERIAL: A992 / A36		ELECTRODES: E70XX LH	REF. DRG.			
HOLES: 13/16 DIA. U/N		CONN'S.: -				
SURFACE PREP. SSPC-SP-2 AND PAINT: GREY PRIMER DEVOE NA-195 (U.N,)				APPROVAL		
DESCRIPTION: LINTEL						
PROJECT NAME		Hamilton High School Phase III				
LOCATION		Hamilton City School District - Hamilton				
CONTRACTOR		GC Contracting				
	Avenue Fabricating Inc. 1281 Clough Pike Batavia, OH 45103 (513) 752-1911			DRAWN BY TMc		DATE 07/20/2010
				CHKD. BY TAN		DATE
				JOB No. 10-16		DRG. No. 32L3 REV. 1

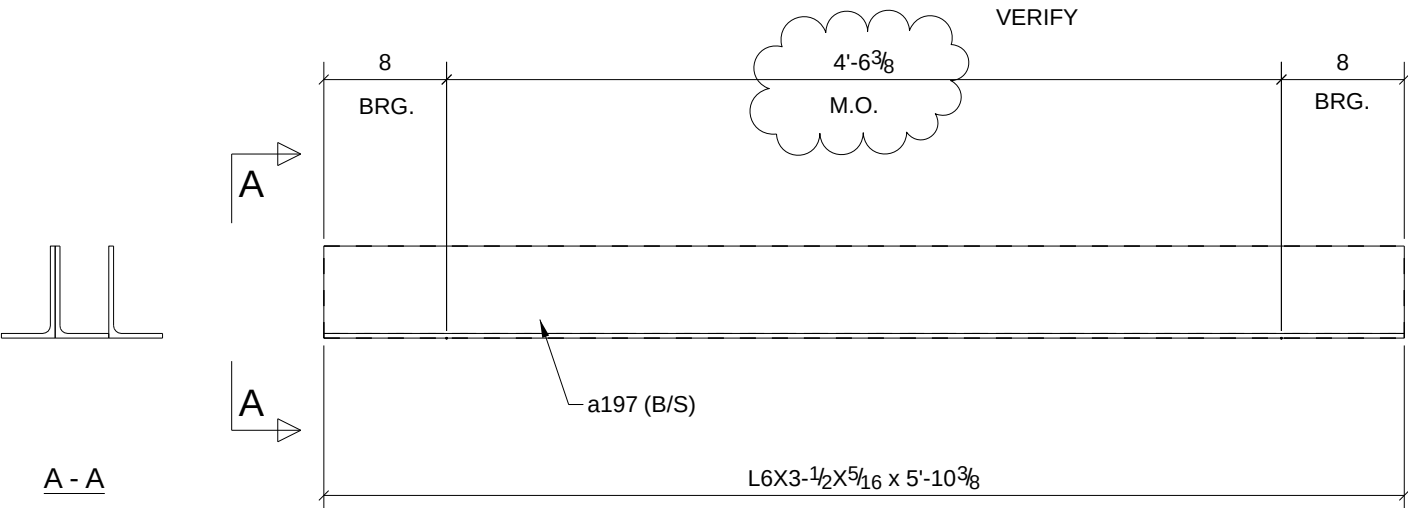

L-7 (M.O.=4'-8-3/8") LOCATION (1006 Verify)

ARCH./ENG/OWNER
PLEASE VERIFY / PROVIDE
TYPE & LOCATIONS
ERECTOR / GC ~ PLEASE
VERIFY / PROVIDE
M.O. @ EACH LOCATION

PHASE				
1	2	3	4	5
0	0	0	0	1


ONE - LINTEL - 32L4

(3 ANGLES EACH LINTEL)

BILL OF MATERIAL

SHIP	MARK	NO PCS	DESCRIPTION	LENGTH	PIECE MARK	REMARKS
1	32L4	1	L6X3-1/2X5/16	5'-10 3/8"		SQ-2 A36 1 S/C STD PRIMER
		2	L6X3-1/2X5/16	5'-10 3/8"	a197	A36 1 S/C STD PRIMER

A	For Approval			7/20/10	TMc	TAN
REV.	DESCRIPTION			DATE	DWN	CHK
GENERAL NOTES				JOB USE		
MATERIAL: A992 / A36		ELECTRODES: E70XX LH	REF. DRG.	SHOP		
HOLES: 13/16 DIA. U/N		CONN'S.: -				
SURFACE PREP. SSPC-SP-2 AND PAINT: GREY PRIMER DEVOE NA-195 (U.N,)				APPROVAL		
DESCRIPTION: LINTEL						
PROJECT NAME		Hamilton High School Phase III				
LOCATION		Hamilton City School District - Hamilton				
CONTRACTOR		GC Contracting				
	Avenue Fabricating Inc. 1281 Clough Pike Batavia, OH 45103 (513) 752-1911			DRAWN BY TMc		DATE 07/20/2010
				CHKD. BY TAN		DATE
				JOB No. 10-16		DRG. No. 32L4
				REV. 1		

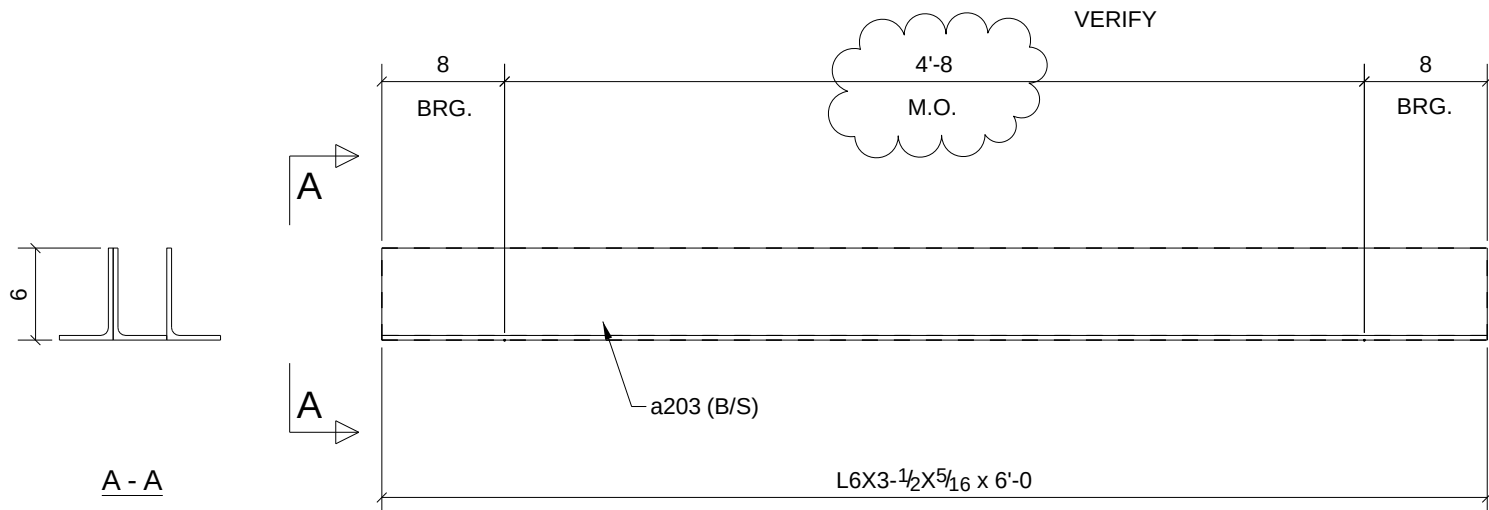

L-7 (M.O.=4'-8") LOCATION (1006 Verify) (2X)

ARCH./ENG/OWNER
PLEASE VERIFY / PROVIDE
TYPE & LOCATIONS
ERECTOR / GC ~ PLEASE
VERIFY / PROVIDE
M.O. @ EACH LOCATION

PHASE				
1	2	3	4	5
0	0	2	0	0

2 - LINTELS - 32L5


(3 ANGLES EACH LINTEL)

BILL OF MATERIAL

SHIP	MARK	NO PCS	DESCRIPTION	LENGTH	PIECE MARK	REMARKS
2	32L5	2	L6X3-1/2X5/16	6'-0"		SQ-2 A36 1 S/C STD PRIMER
		4	L6X3-1/2X5/16	6'-0"	a203	A36 1 S/C STD PRIMER

A	For Approval		7/20/10	TMc	TAN
REV.	DESCRIPTION		DATE	DWN	CHK
GENERAL NOTES			JOB USE		
MATERIAL: A992 / A36		ELECTRODES: E70XX LH	REF. DRG.		
HOLES: 13/16 DIA. U/N		CONN'S.: -		SHOP	
SURFACE PREP. SSPC-SP-2 AND PAINT: GREY PRIMER DEVOE NA-195 (U.N,)			APPROVAL		
DESCRIPTION: LINTEL					
PROJECT NAME		Hamilton High School Phase III			
LOCATION		Hamilton City School District - Hamilton			
CONTRACTOR		GC Contracting			
	Avenue Fabricating Inc. 1281 Clough Pike Batavia, OH 45103 (513) 752-1911		DRAWN BY		DATE
			TMc		07/20/2010
			CHKD. BY		DATE
			TAN		
		JOB No.	DRG. No.	REV.	
		10-16	32L5	1	

Avenue Fabricating Inc.
1281 Clough Pike
Batavia, OH 45103
(513) 752-1911

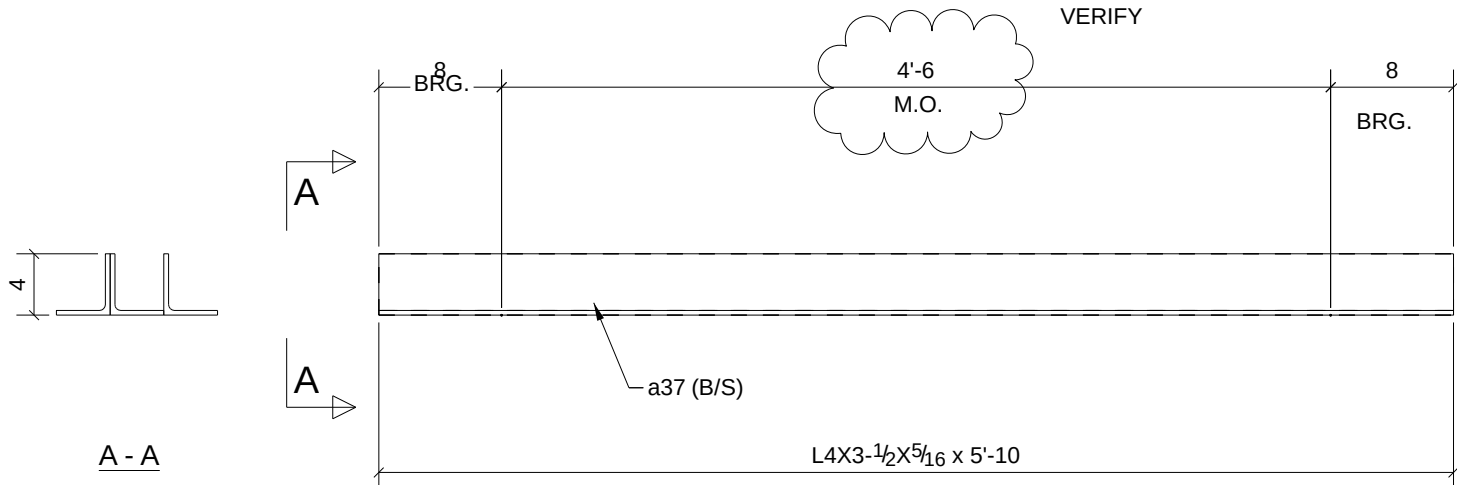

L-3 (M.O.=4'-6") LOCATION (1134)

ARCH./ENG/OWNER
PLEASE VERIFY / PROVIDE
TYPE & LOCATIONS
ERECTOR / GC ~ PLEASE
VERIFY / PROVIDE
M.O. @ EACH LOCATION

PHASE				
1	2	3	4	5
0	0	1	0	0


ONE - LINTEL - 32L6

(3 ANGLES EACH LINTEL)

BILL OF MATERIAL

SHIP	MARK	NO PCS	DESCRIPTION	LENGTH	PIECE MARK	REMARKS
1	32L6	1	L4X3-1/2X5/16	5'-10"		SQ-2 A36 GALVANIZED
		2	L4X3-1/2X5/16	5'-10"	a37	A36 GALVANIZED

A	For Approval		7/20/10	TMc	TAN
REV.	DESCRIPTION		DATE	DWN	CHK
GENERAL NOTES			JOB USE		
			SHOP		
MATERIAL: A992 / A36		ELECTRODES: E70XX LH	REF. DRG.		
HOLES: 13/16 DIA. U/N		CONN'S.: -			
SURFACE PREP. SS-PC-SP-2			APPROVAL		
AND PAINT: GREY PRIMER DEVOE NA-195 (U.N,)					
DESCRIPTION: LINTEL					
PROJECT NAME		Hamilton High School Phase III			
LOCATION		Hamilton City School District - Hamilton			
CONTRACTOR		GC Contracting			
	Avenue Fabricating Inc. 1281 Clough Pike Batavia, OH 45103 (513) 752-1911		DRAWN BY TMc		DATE 07/20/2010
			CHKD. BY TAN		DATE
			JOB No. 10-16		DRG. No. 32L6

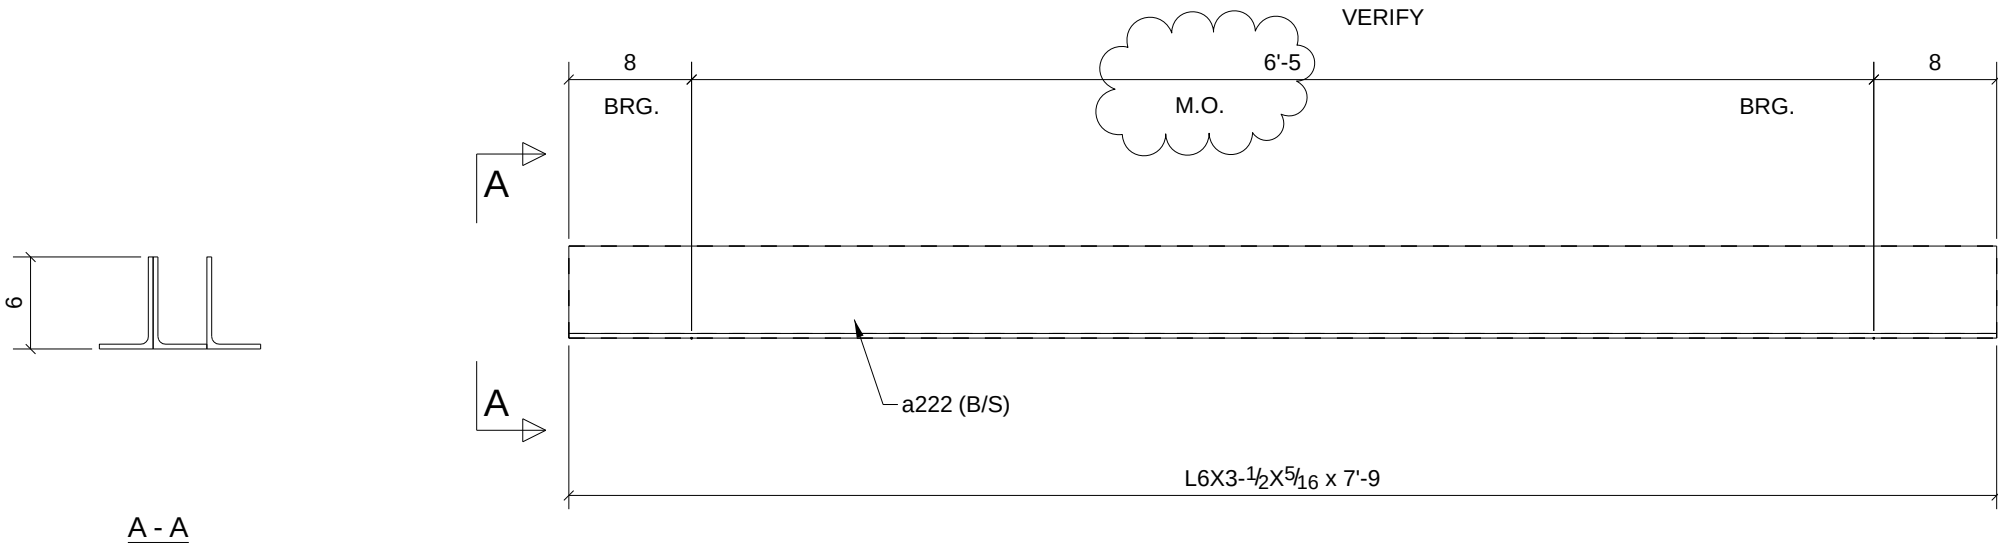

L-7 (M.O.=6'-5") LOCATION (2132)
(2131)
(2128)
(2124)
(2123)

ARCH./ENG/OWNER
PLEASE VERIFY / PROVIDE
TYPE & LOCATIONS
ERECTOR / GC ~ PLEASE
VERIFY / PROVIDE
M.O. @ EACH LOCATION

PHASE				
1	2	3	4	5
0	0	5	0	0


5 - LINTELS - 32L7

(3 ANGLES EACH LINTEL)

BILL OF MATERIAL

SHIP	MARK	NO PCS	DESCRIPTION	LENGTH	PIECE MARK	REMARKS
5	32L7	5	L6X3-1/2X5/16	7'-9"		SQ-2 A36 GALVANIZED
		10	L6X3-1/2X5/16	7'-9"	a222	A36 GALVANIZED

A	For Approval	7/23/10	TMc	TAN
REV.	DESCRIPTION	DATE	DWN	CHK
GENERAL NOTES		JOB USE		
MATERIAL: A992 / A36	ELECTRODES: E70XX LH	REF. DRG.	SHOP	
HOLES: 13/16 DIA. U/N	CONN'S.: -			
SURFACE PREP. SS-PC-SP-2	AND PAINT: GREY PRIMER DEVOE NA-195 (U.N,)		APPROVAL	
DESCRIPTION:	LINTEL			
PROJECT NAME	Hamilton High School Phase III			
LOCATION	Hamilton City School District - Hamilton			
CONTRACTOR	GC Contracting			
	Avenue Fabricating Inc. 1281 Clough Pike Batavia, OH 45103 (513) 752-1911	DRAWN BY TMc	DATE 07/23/2010	
		CHKD. BY TAN	DATE	
		JOB No. 10-16	DRG. No. 32L7	REV. 1

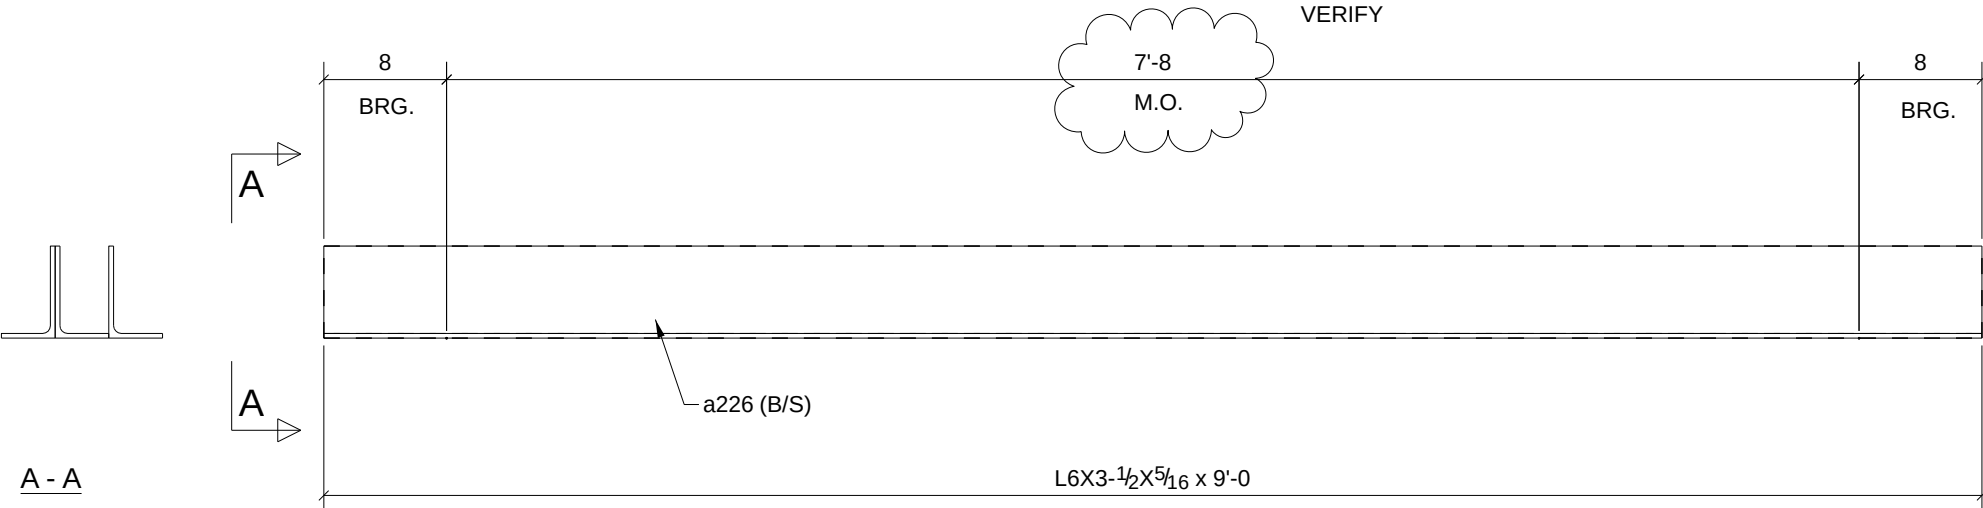

L-7 (M.O.=7'-8") LOCATION (2120)

ARCH./ENG/OWNER
PLEASE VERIFY / PROVIDE
TYPE & LOCATIONS
ERECTOR / GC ~ PLEASE
VERIFY / PROVIDE
M.O. @ EACH LOCATION

PHASE				
1	2	3	4	5
0	0	1	0	0

ONE - LINTEL - 32L8

(3 ANGLES EACH LINTEL)

BILL OF MATERIAL

SHIP	MARK	NO PCS	DESCRIPTION	LENGTH	PIECE MARK	REMARKS
1	32L8	1	L6X3-1/2X5/16	9'-0"		SQ-2 A36 1 S/C STD PRIMER
		2	L6X3-1/2X5/16	9'-0"	a226	A36 1 S/C STD PRIMER

A	For Approval			7/23/10	TMc	TAN
REV.	DESCRIPTION			DATE	DWN	CHK
GENERAL NOTES				JOB USE		
				SHOP		
MATERIAL: A992 / A36		ELECTRODES: E70XX LH		REF. DRG.		
HOLES: 13/16 DIA. U/N		CONN'S.: -				
SURFACE PREP. SSPC-SP-2 AND PAINT: GREY PRIMER DEVOE NA-195 (U.N,)				APPROVAL		
DESCRIPTION: LINTEL						
PROJECT NAME		Hamilton High School Phase III				
LOCATION		Hamilton City School District - Hamilton				
CONTRACTOR		GC Contracting				
	Avenue Fabricating Inc. 1281 Clough Pike Batavia, OH 45103 (513) 752-1911			DRAWN BY TMc		DATE 07/23/2010
				CHKD. BY TAN		DATE
				JOB No. 10-16		DRG. No. 32L8





ARCH./ENG/OWNER
PLEASE VERIFY / PROVIDE
TYPE & LOCATIONS
ERECTOR / GC ~ PLEASE
VERIFY / PROVIDE
M.O. @ EACH LOCATION

PHASE				
1	2	3	4	5
0	0	1	0	0

(2 ANGLES EACH LINTEL)

BILL OF MATERIAL						
SHIP	MARK	NO PCS	DESCRIPTION	LENGTH	PIECE MARK	REMARKS
1	32L9	1	L4X3-1/2X5/16	4'-8"		SQ-2 A36 1 S/C STD PRIMER
		1	L4X3-1/2X5/16	4'-8"	a31	A36 1 S/C STD PRIMER

A	For Approval	7/23/10	TMc	TAN
REV.	DESCRIPTION	DATE	DWN	CHK
GENERAL NOTES		JOB USE		
MATERIAL: A992 / A36	ELECTRODES: E70XX LH	REF. DRG.		
HOLES: 13/16 DIA. U/N	CONN'S.: -		SHOP	
SURFACE PREP. SSPC-SP-2 AND PAINT: GREY PRIMER DEVOE NA-195 (U.N.)		APPROVAL		
DESCRIPTION: LINTEL				
PROJECT NAME	Hamilton High School Phase III			
LOCATION	Hamilton City School District - Hamilton			
CONTRACTOR	GC Contracting			
	Avenue Fabricating Inc. 1281 Clough Pike Batavia, OH 45103 (513) 752-1911	DRAWN BY TMc	DATE 07/23/2010	
		CHKD. BY TAN	DATE	
		JOB No. 10-16	DRG. No. 32L9	REV. 1

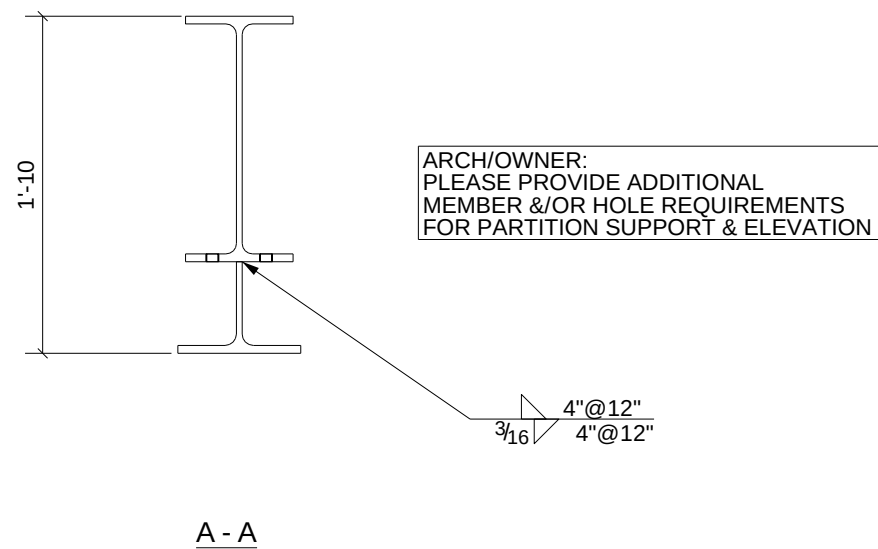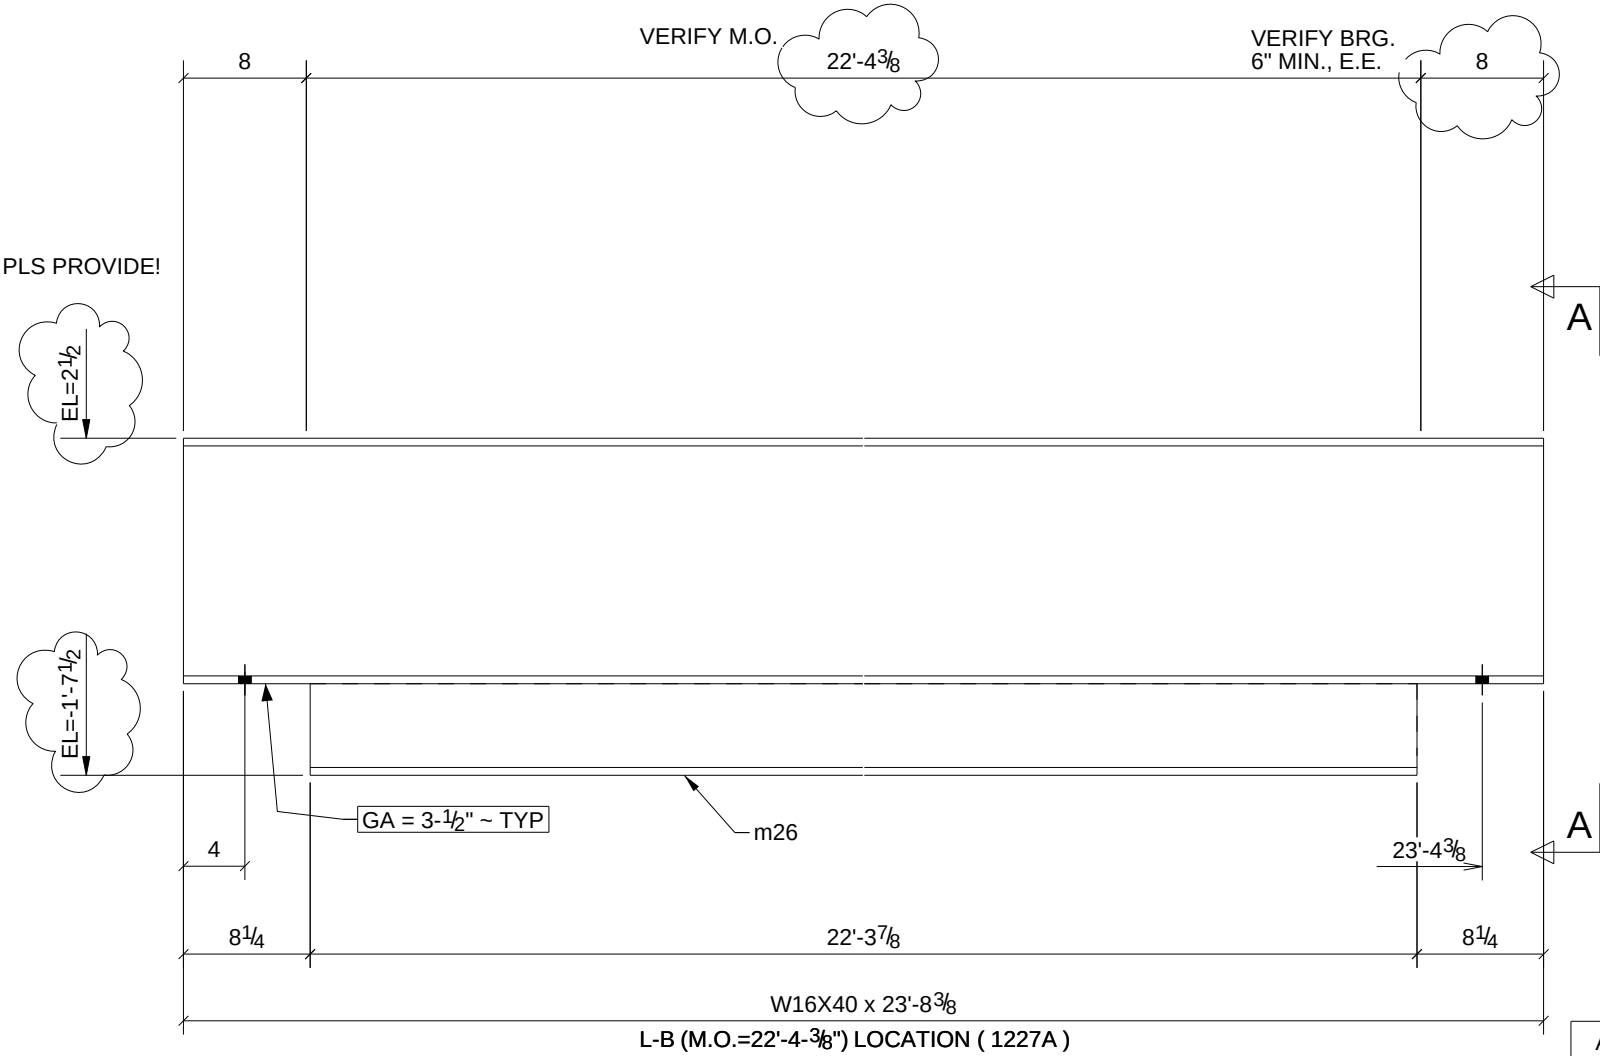

PHASE				
1	2	3	4	5
0	0	0	0	1

ONE - LINTEL - 42L1


1 SHOP NOTE: MARK WITH SHIP & PC MK. & SHIP LOOSE WITH BEAM

W	16" x 1/4"
F	7" x 1/2"


BILL OF MATERIAL

SHIP	MARK	NO PCS	DESCRIPTION	LENGTH	PIECE MARK	REMARKS
1	42L1	1	W16X40	23'-8 3/8"		SQ-2 A992 -
		1	WT6X20	22'-3 7/8"	m26	A36

A	For Approval				7/20/10	TMc	TAN	
REV.	DESCRIPTION				DATE	DWN	CHK	
GENERAL NOTES					JOB USE			
MATERIAL: A992 / A36		ELECTRODES: E70XX LH		REF. DRG.				
HOLES: 13/16 DIA. U/N		CONN'S.: -				SHOP		
SURFACE PREP. SSPC-SP-2					APPROVAL			
AND PAINT: GREY PRIMER DEVOE NA-195 (U.N.)								
DESCRIPTION: LINTEL								
PROJECT NAME		Hamilton High School Phase III						
LOCATION		Hamilton City School District - Hamilton						
CONTRACTOR		GC Contracting						
	Avenue Fabricating Inc. 1281 Clough Pike Batavia, OH 45103 (513) 752-1911				DRAWN BY TMc		DATE 07/20/2010	
					CHKD. BY TAN		DATE	
					JOB No. 10-16		DRG. No. 42L1	

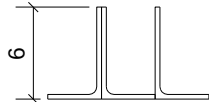

A - A

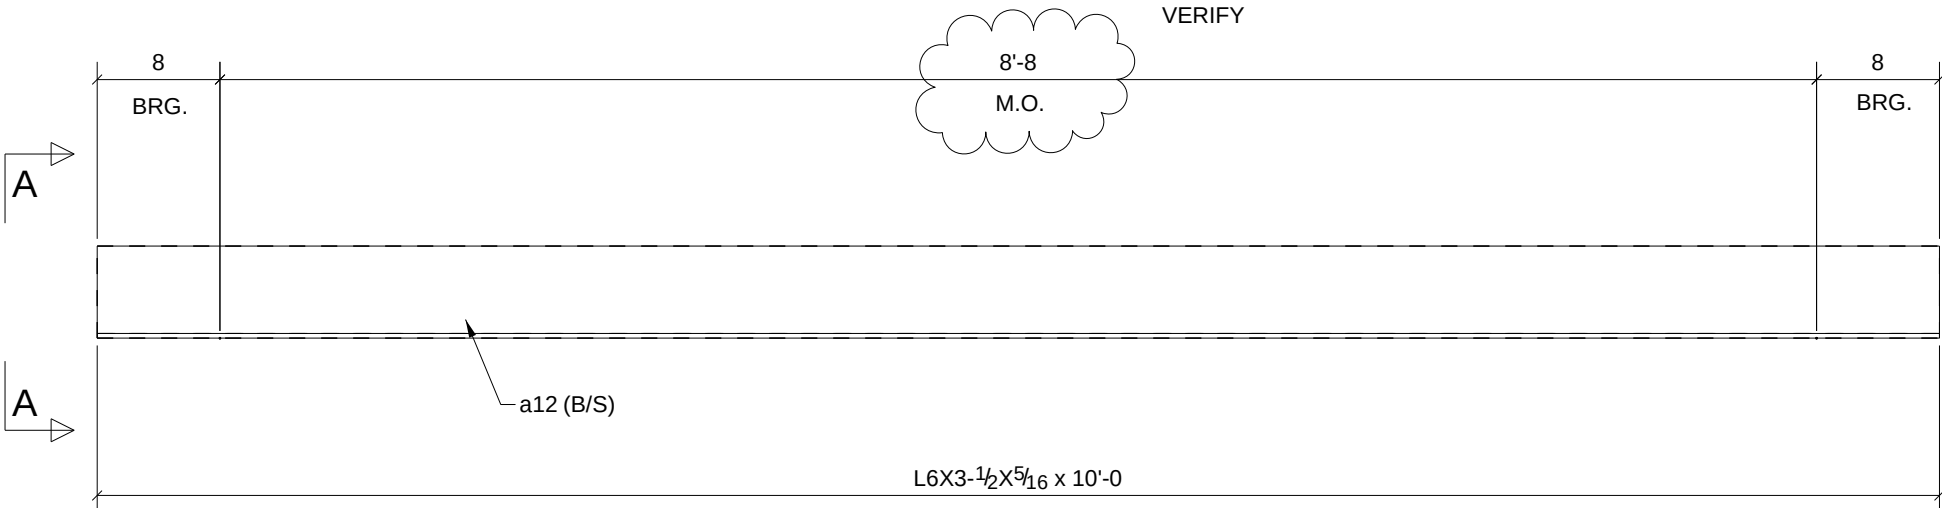

L-7 (M.O.=8'-8") LOCATION (1515)
(1116)
(1117)
(1118)
(1119)

ARCH./ENG/OWNER
PLEASE VERIFY / PROVIDE
TYPE & LOCATIONS
ERECTOR / GC ~ PLEASE
VERIFY / PROVIDE
M.O. @ EACH LOCATION

PHASE				
1	2	3	4	5
0	0	0	5	0


5 - LINTELS - 42L10

(3 ANGLES EACH LINTEL)

BILL OF MATERIAL

SHIP	MARK	NO PCS	DESCRIPTION	LENGTH	PIECE MARK	REMARKS
5	42L10	5	L6X3-1/2X5/16	10'-0"		SQ-2 A36 GALVANIZED
		10	L6X3-1/2X5/16	10'-0"	a12	A36 GALVANIZED

A	For Approval			7/20/10	TMc	TAN
REV.	DESCRIPTION			DATE	DWN	CHK
GENERAL NOTES				JOB USE		
				SHOP		
				APPROVAL		
MATERIAL: A992 / A36		ELECTRODES: E70XX LH		REF. DRG.		
HOLES: 13/16 DIA. U/N		CONN'S.: -				
SURFACE PREP. SSPC-SP-2				AND PAINT: GREY PRIMER DEVOE NA-195 (U.N,)		
DESCRIPTION: LINTEL						
PROJECT NAME		Hamilton High School Phase III				
LOCATION		Hamilton City School District - Hamilton				
CONTRACTOR		GC Contracting				
	Avenue Fabricating Inc. 1281 Clough Pike Batavia, OH 45103 (513) 752-1911			DRAWN BY TMc		DATE 07/20/2010
				CHKD. BY TAN		DATE
				JOB No. 10-16		DRG. No. 42L10

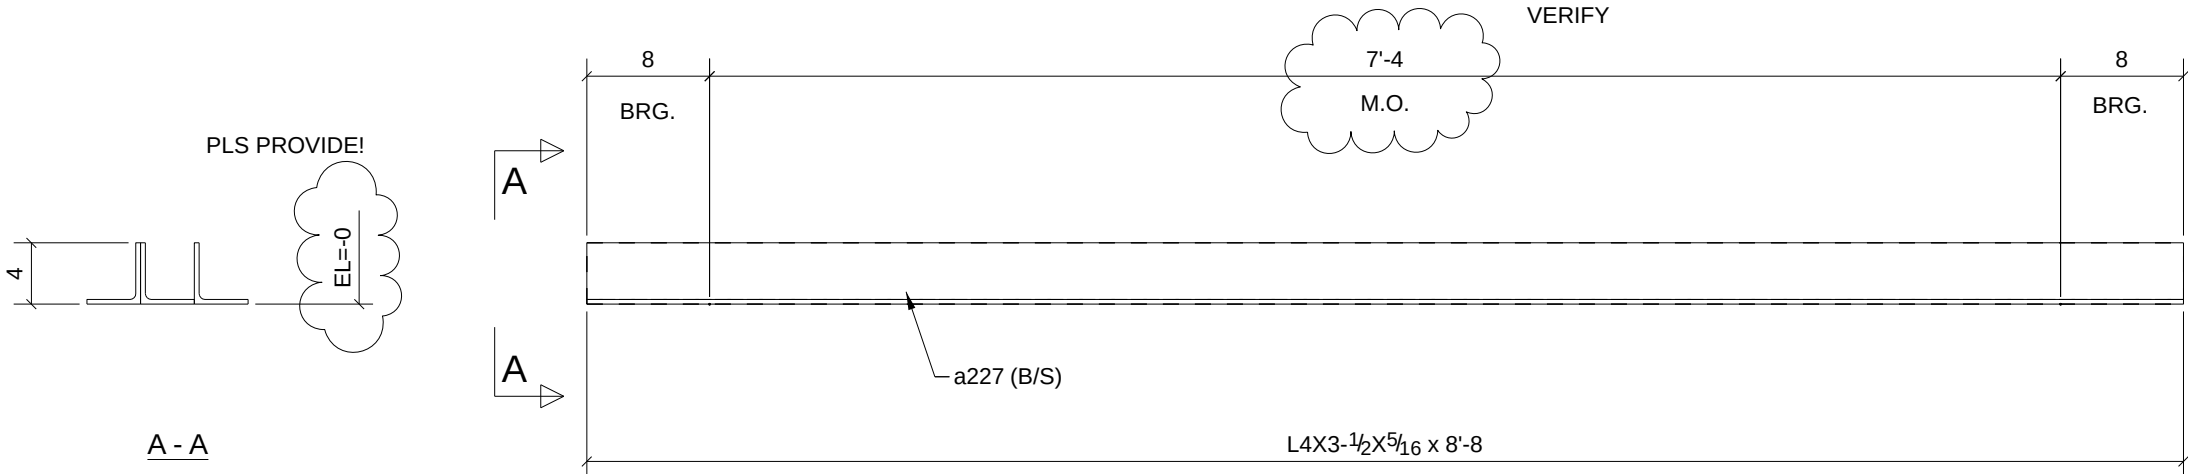

L-3 (M.O.=7'-4") LOCATION (2117)

ARCH./ENG/OWNER
PLEASE VERIFY / PROVIDE
TYPE & LOCATIONS
ERECTOR / GC ~ PLEASE
VERIFY / PROVIDE
M.O. @ EACH LOCATION

PHASE				
1	2	3	4	5
0	0	0	1	0

ONE - LINTEL - 42L11



(3 ANGLES EACH LINTEL)

BILL OF MATERIAL

SHIP	MARK	NO PCS	DESCRIPTION	LENGTH	PIECE MARK	REMARKS
1	42L11	1	L4X3-1/2X5/16	8'-8"		SQ-2 A36 GALVANIZED
		2	L4X3-1/2X5/16	8'-8"	a227	A36 GALVANIZED

A	For Approval			7/23/10	TMc	TAN		
REV.	DESCRIPTION			DATE	DWN	CHK		
GENERAL NOTES				JOB USE				
				SHOP				
				APPROVAL				
MATERIAL: A992 / A36		ELECTRODES: E70XX LH		REF. DRG.				
HOLES: 13/16 DIA. U/N		CONN'S.: -						
SURFACE PREP. SSPC-SP-2				APPROVAL				
AND PAINT: GREY PRIMER DEVOE NA-195 (U.N,)								
DESCRIPTION: LINTEL								
PROJECT NAME		Hamilton High School Phase III						
LOCATION		Hamilton City School District - Hamilton						
CONTRACTOR		GC Contracting						
		Avenue Fabricating Inc. 1281 Clough Pike Batavia, OH 45103 (513) 752-1911			DRAWN BY		DATE	
					TMc		07/23/2010	
					CHKD. BY		DATE	
					TAN			
		JOB No.			DRG. No.		REV.	
		10-16			42L11		1	

Avenue Fabricating Inc.
1281 Clough Pike
Batavia, OH 45103
(513) 752-1911

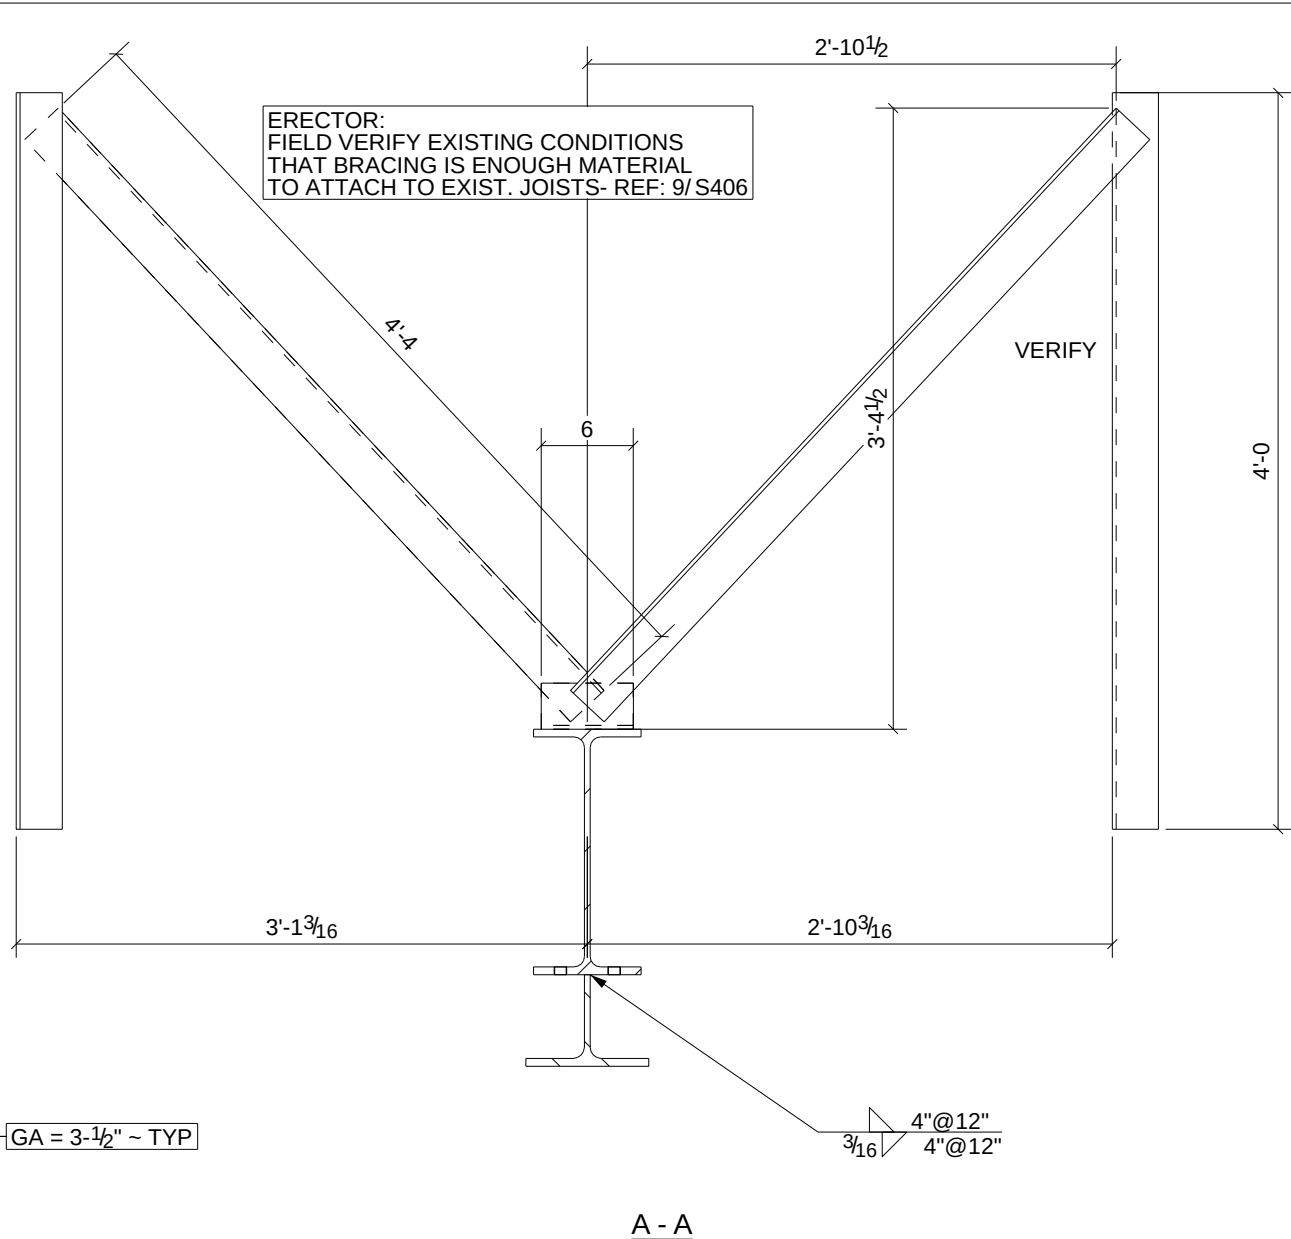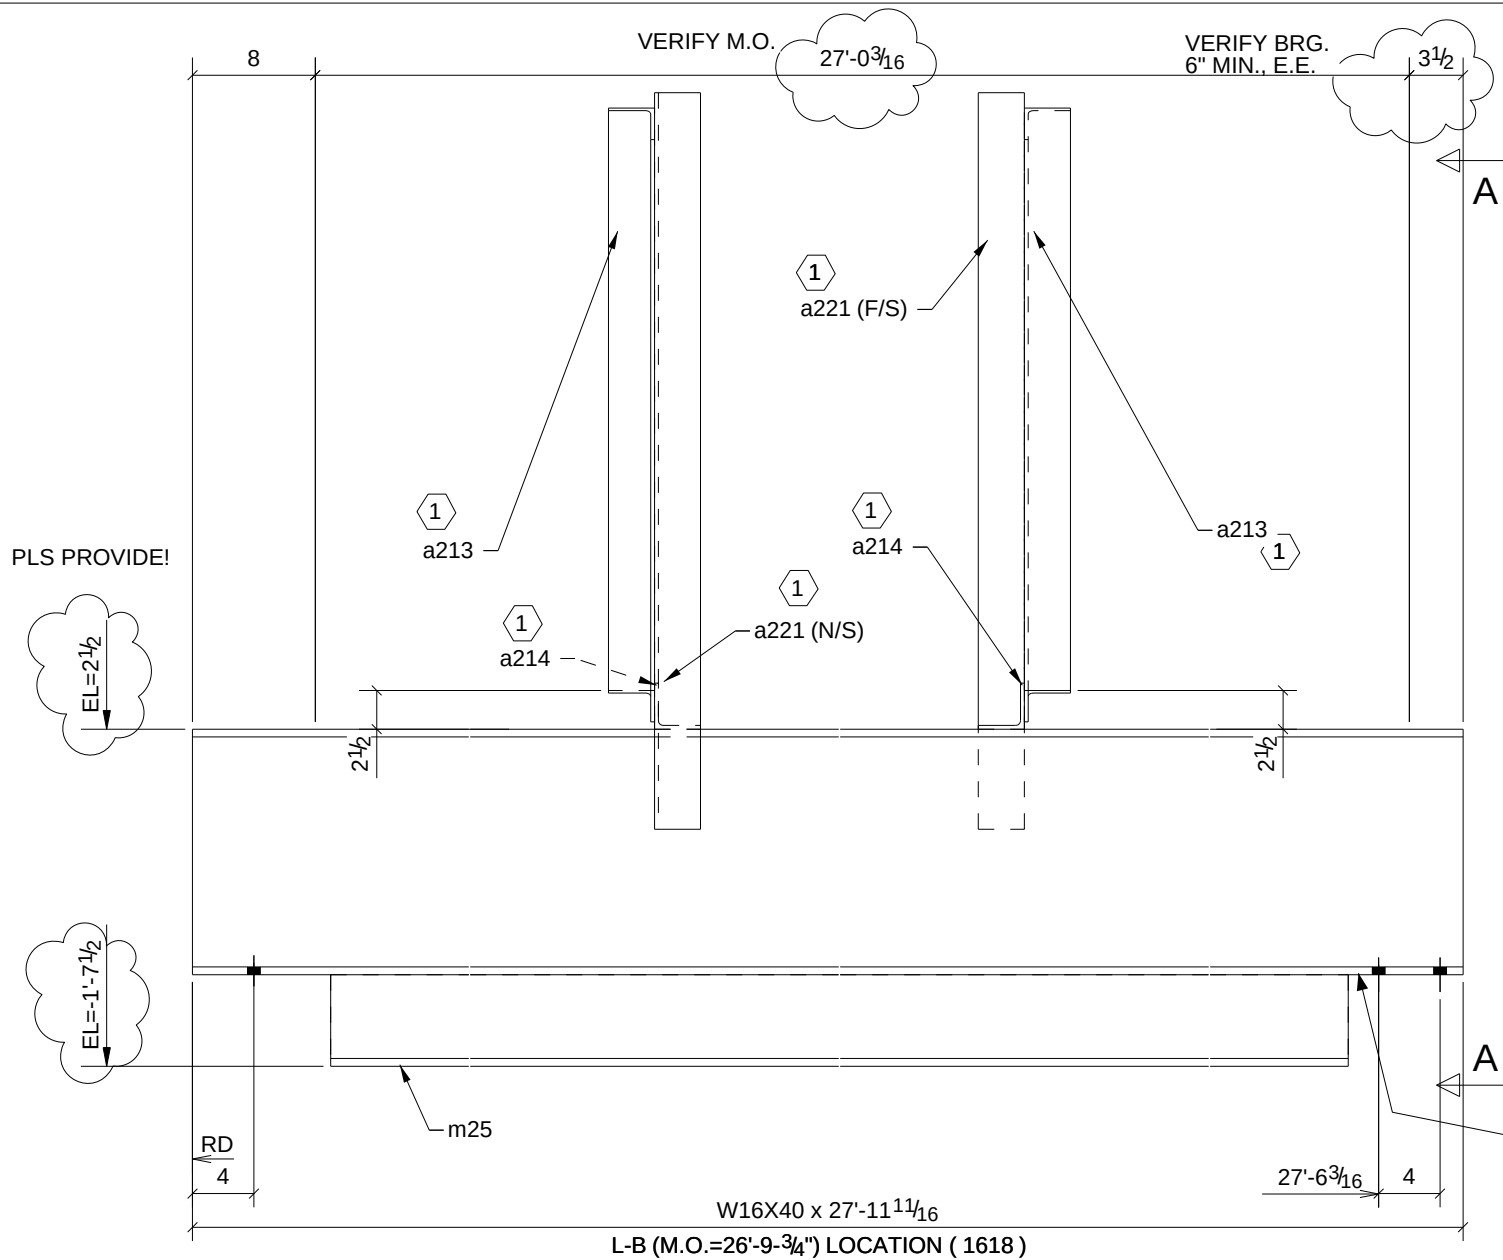

PHASE					
1	2	3	4	5	
0	0	0	1	0	

ONE - LINTEL - 42L12


W	16"x1/4"
F	7"x1/2"

1 SHOP NOTE: MARK WITH SHIP & PC MK. & SHIP LOOSE WITH BEAM


BILL OF MATERIAL

SHIP	MARK	NO PCS	DESCRIPTION	LENGTH	PIECE MARK	REMARKS
1	42L12	1	W16X40	27'-11 11/16"		SQ-2 A992 1 S/C STD PRIMER
		2	L3X3X1/4	4'-4"	a213	A36 1 S/C STD PRIMER
		2	L3X3X1/4	0'-6"	a214	A36 1 S/C STD PRIMER
		2	L3X3X1/4	4'-0"	a221	A36 1 S/C STD PRIMER
		1	WT6X20	26'-7 3/16"	m25	A36 1 S/C STD PRIMER

A	For Approval	ARCH/OWNER: PLEASE PROVIDE ADDITIONAL MEMBER &/OR HOLE REQUIREMENTS FOR PARTITION & ELEVATION	7/20/10	TMc	TAN
REV.		DESCRIPTION	DATE	DWN	CHK
GENERAL NOTES			JOB USE		
MATERIAL: A992 / A36		ELECTRODES: E70XX LH	REF. DRG.	SHOP	
HOLES: 13/16 DIA. U/N		CONN'S.: -			
SURFACE PREP. SSPC-SP-2 AND PAINT: GREY PRIMER DEVOE NA-195 (U.N.)			APPROVAL		
DESCRIPTION: LINTEL					
PROJECT NAME		Hamilton High School Phase III			
LOCATION		Hamilton City School District - Hamilton			
CONTRACTOR		GC Contracting			
		Avenue Fabricating Inc. 1281 Clough Pike Batavia, OH 45103 (513) 752-1911	DRAWN BY TMc		DATE 07/20/2010
			CHKD. BY TAN		DATE
			JOB No. 10-16	DRG. No. 42L12	REV. 1

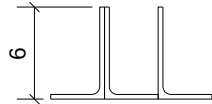

A - A

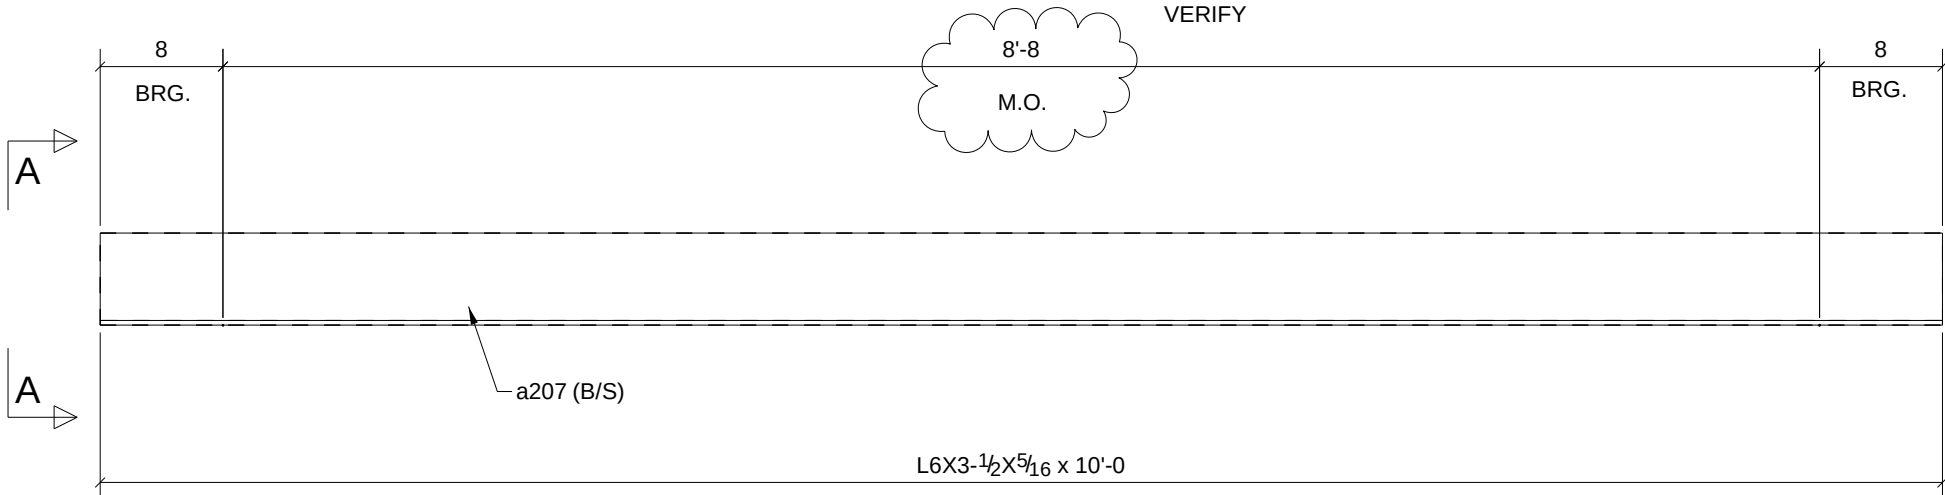

L-7 (M.O.=8'-8") LOCATION (1618)
(1619)

ARCH./ENG/OWNER
PLEASE VERIFY / PROVIDE
TYPE & LOCATIONS
ERECTOR / GC ~ PLEASE
VERIFY / PROVIDE
M.O. @ EACH LOCATION

PHASE				
1	2	3	4	5
0	0	0	2	0

2 - LINTELS - 42L13


(3 ANGLES EACH LINTEL)

BILL OF MATERIAL

SHIP	MARK	NO PCS	DESCRIPTION	LENGTH	PIECE MARK	REMARKS
2	42L13	2	L6X3-1/2X5/16	10'-0"		SQ-2 A36 1 S/C STD PRIMER
		4	L6X3-1/2X5/16	10'-0"	a207	A36 1 S/C STD PRIMER

A	For Approval				7/20/10	TMc		TAN	
REV.	DESCRIPTION				DATE	DWN		CHK	
GENERAL NOTES					JOB USE				
MATERIAL: A992 / A36		ELECTRODES: E70XX LH		REF. DRG.		SHOP			
HOLES: 13/16 DIA. U/N		CONN'S.: -							
SURFACE PREP. SSPC-SP-2					APPROVAL				
AND PAINT: GREY PRIMER DEVOE NA-195 (U.N,)									
DESCRIPTION: LINTEL									
PROJECT NAME		Hamilton High School Phase III							
LOCATION		Hamilton City School District - Hamilton							
CONTRACTOR		GC Contracting							
		Avenue Fabricating Inc. 1281 Clough Pike Batavia, OH 45103 (513) 752-1911			DRAWN BY TMc		DATE 07/20/2010		
					CHKD. BY TAN		DATE		
					JOB No. 10-16		DRG. No. 42L13		REV. 1

GRID LOCATION	BOTTOM ELEVATION
	-12'-5"5/8

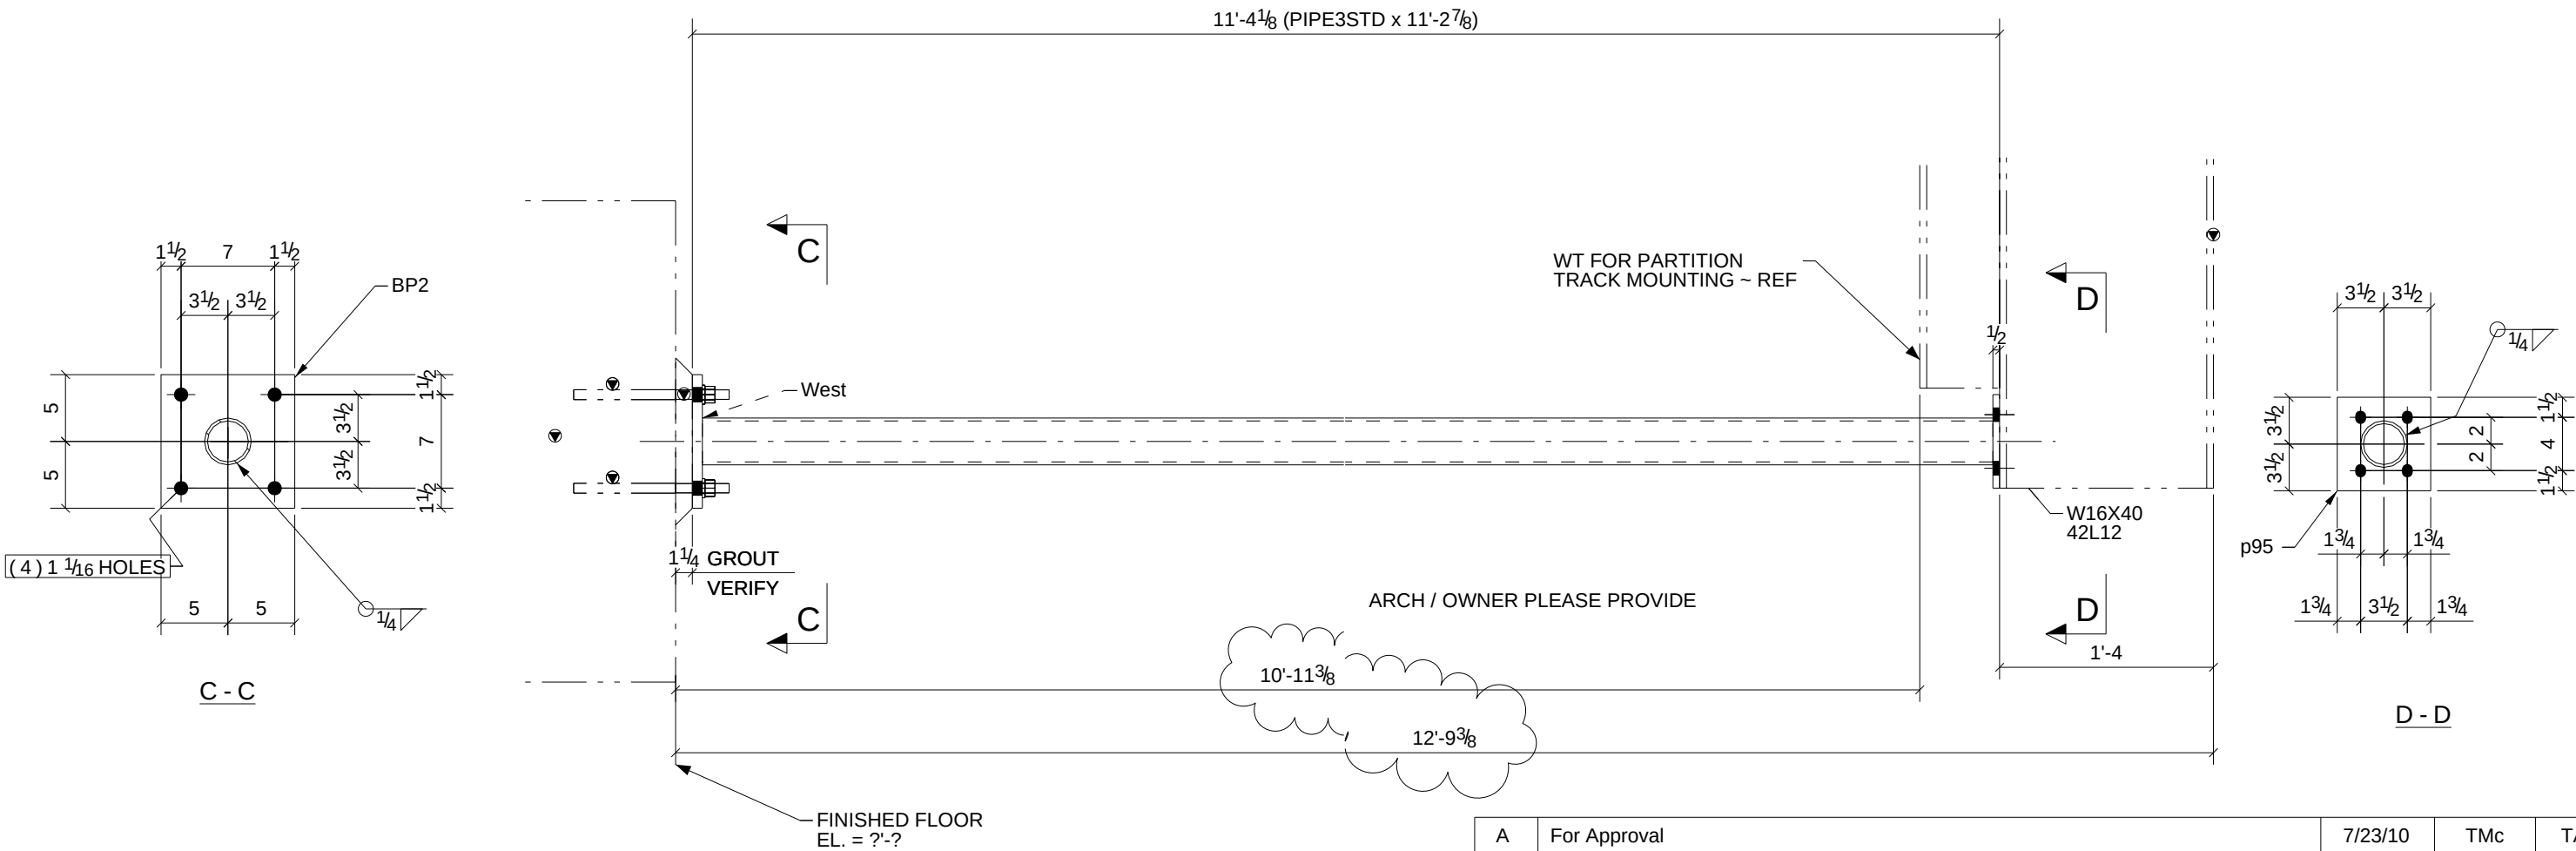


PHASE				
1	2	3	4	5
1	0	0	0	0

ONE - COLUMN - 42L14

BILL OF MATERIAL						
SHIP	MARK	NO PCS	DESCRIPTION	LENGTH	PIECE MARK	REMARKS
1	42L14	1	PIPE3STD	11'-2 7/8"		SQ-2 A53 1 S/C STD PRIMER
		1	BAR3/4"X10"	0'-10"	BP2	A36 1 S/C STD PRIMER
		1	BAR1/2"X7"	0'-7"	p95	A36 1 S/C STD PRIMER

A	For Approval		7/23/10	TMc	TAN
REV.	DESCRIPTION		DATE	DWN	CHK
GENERAL NOTES			JOB USE		
MATERIAL: A992 / A36	ELECTRODES: E70XX LH	REF. DRG.	SHOP		
HOLES: 13/16 DIA. U/N	CONN'S.: -				
SURFACE PREP. SSPC-SP-2 AND PAINT: GREY PRIMER DEVOE NA-195 (U.N,)			APPROVAL		
DESCRIPTION: COLUMN					
PROJECT NAME	Hamilton High School Phase III				
LOCATION	Hamilton City School District - Hamilton				
CONTRACTOR	GC Contracting				
	Avenue Fabricating Inc. 1281 Clough Pike Batavia, OH 45103 (513) 752-1911		DRAWN BY TMc	DATE 07/23/2010	
			CHKD. BY TAN	DATE	
			JOB No. 10-16	DRG. No. 42L14	REV. 1

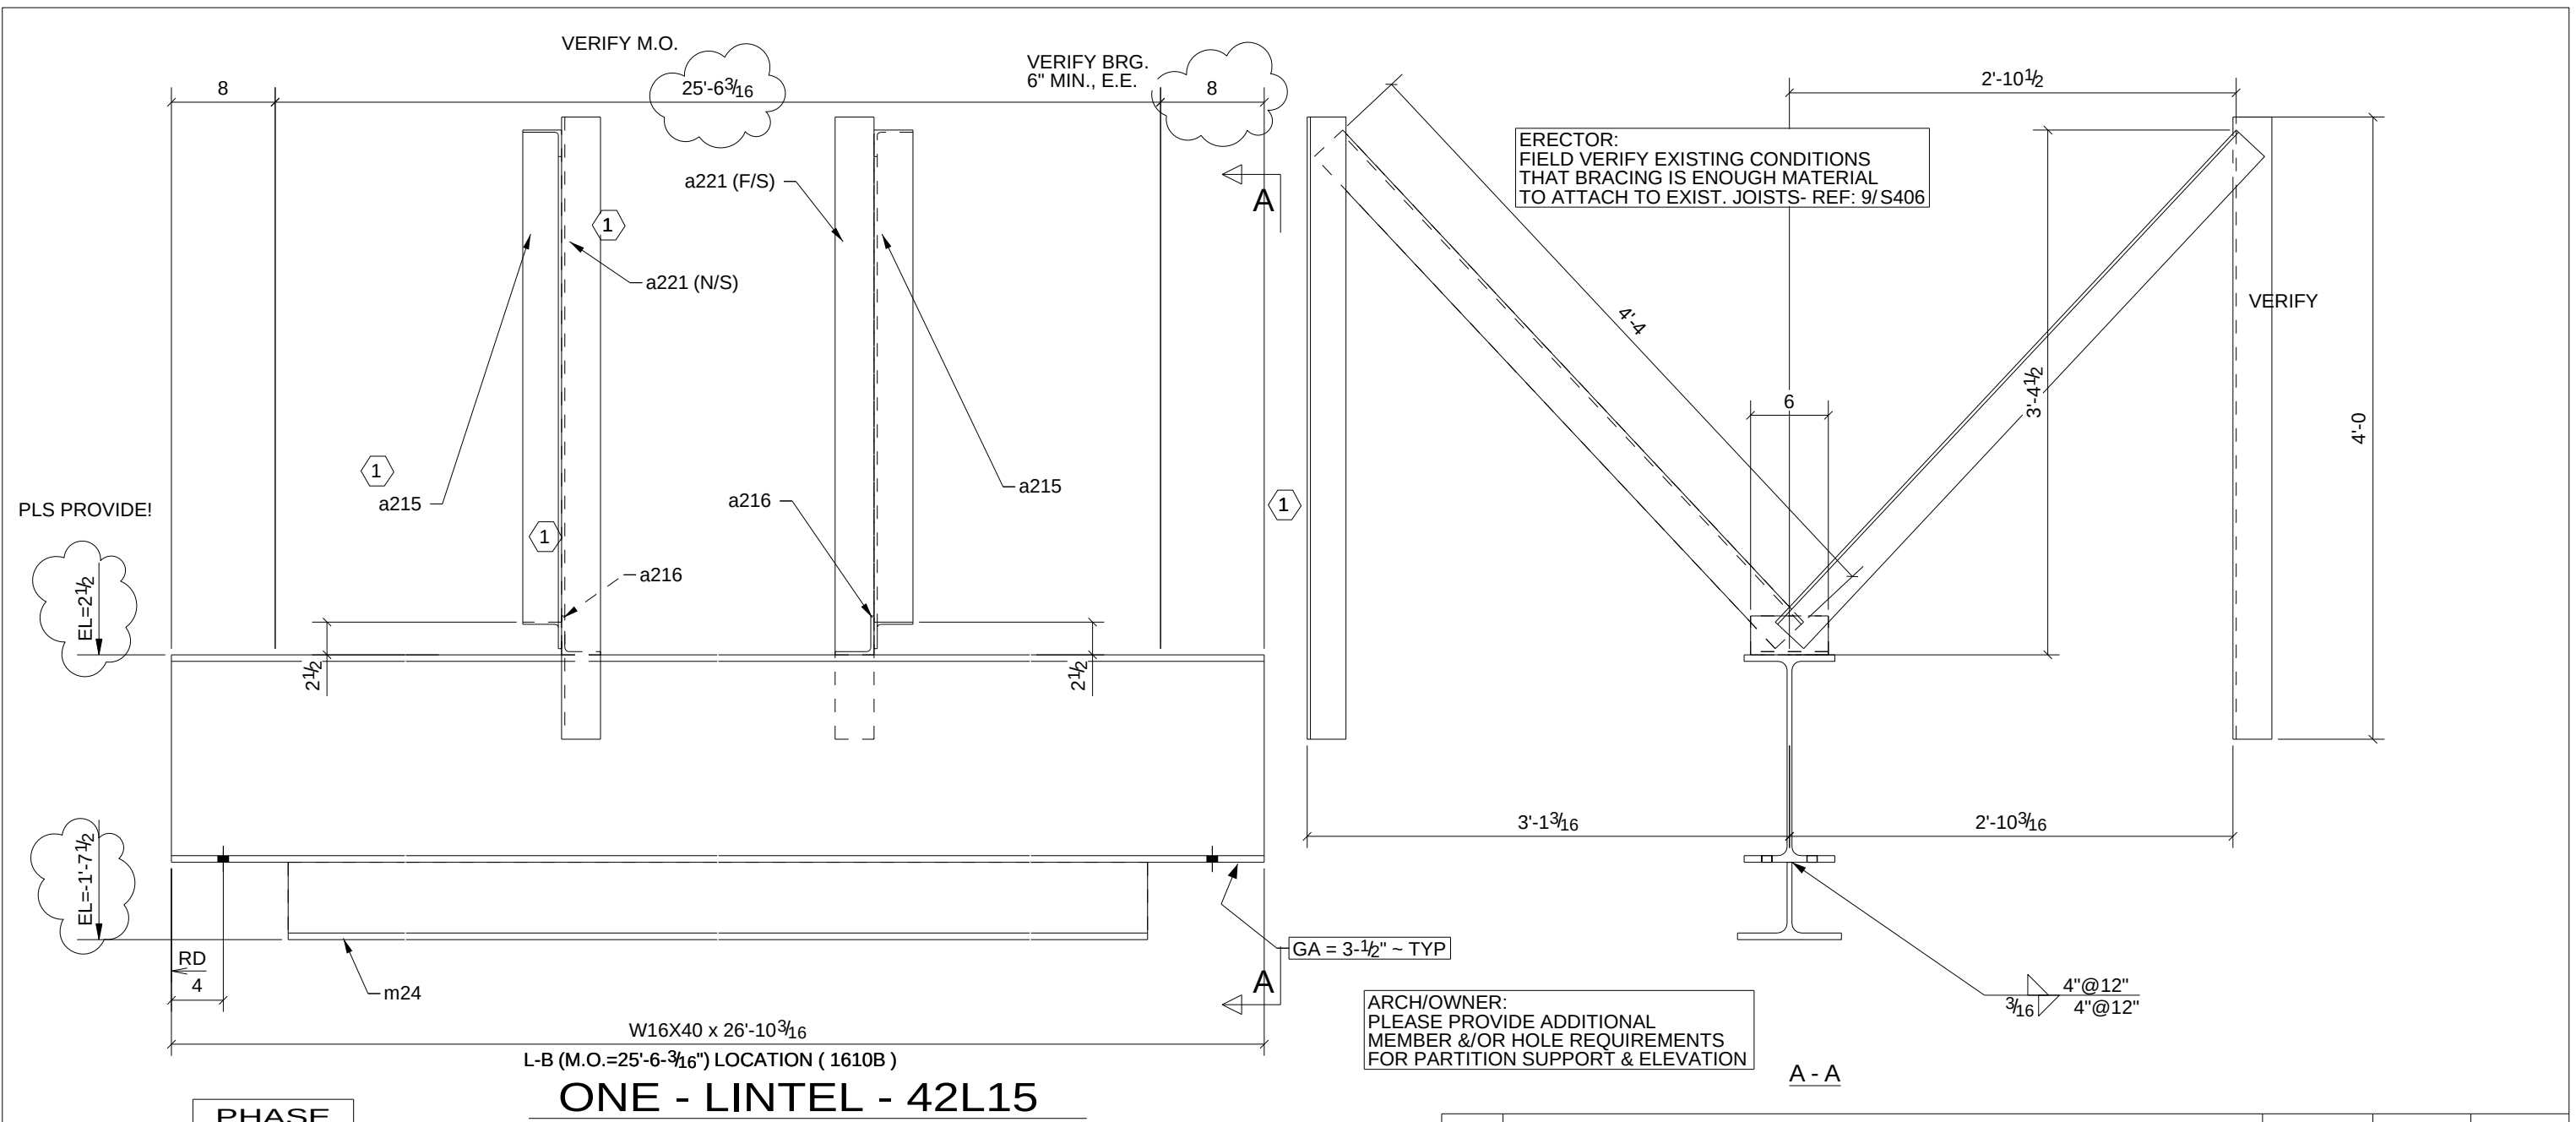


PHASE				
1	2	3	4	5
0	1	0	0	0

1 SHOP NOTE: MARK WITH SHIP & PC MK. & SHIP LOOSE WITH BEAM

BILL OF MATERIAL						
SHIP	MARK	NO PCS	DESCRIPTION	LENGTH	PIECE MARK	REMARKS
1	42L15	1	W16X40	26'-10 3/16"		SQ-2 A992 1 S/C STD PRIMER
		2	L3X3X1/4	4'-4"	a215	A36 1 S/C STD PRIMER
		2	L3X3X1/4	0'-6"	a216	A36 1 S/C STD PRIMER
		2	L3X3X1/4	4'-0"	a221	A36 1 S/C STD PRIMER
		1	WT6X20	25'-4 3/16"	m24	A36 1 S/C STD PRIMER

A	For Approval	7/20/10	TMc	TAN
REV.	DESCRIPTION	DATE	DWN	CHK
GENERAL NOTES MATERIAL: A992 / A36 ELECTRODES: E70XX LH REF. DRG. HOLES: 13/16 DIA. U/N CONN'S.: - SURFACE PREP: SSPC-SP-2 AND PAINT: GREY PRIMER DEVOE NA-195 (U.N.)		JOB USE		
		SHOP		
DESCRIPTION: LINTEL				
PROJECT NAME LOCATION		Hamilton High School Phase III Hamilton City School District - Hamilton		
CONTRACTOR		GC Contracting		
	Avenue Fabricating Inc. 1281 Clough Pike Batavia, OH 45103 (513) 752-1911	DRAWN BY TMc	DATE 07/20/2010	
		CHKD. BY TAN	DATE	
		JOB No. 10-16	DRG. No. 42L15	REV. 1

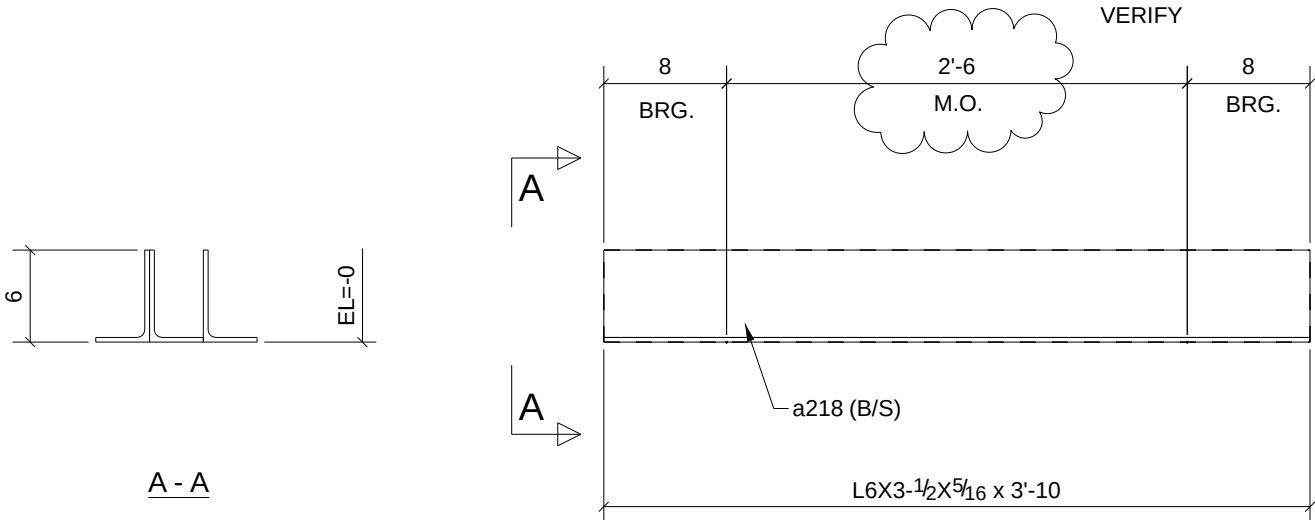

L-7 (M.O.=2'-6") LOCATION (2105)

ARCH./ENG/OWNER
PLEASE VERIFY / PROVIDE
TYPE & LOCATIONS
ERECTOR / GC ~ PLEASE
VERIFY / PROVIDE
M.O. @ EACH LOCATION

PHASE				
1	2	3	4	5
0	0	0	1	0


ONE - LINTEL - 42L16

(3 ANGLES EACH LINTEL)

BILL OF MATERIAL

SHIP	MARK	NO PCS	DESCRIPTION	LENGTH	PIECE MARK	REMARKS
1	42L16	1	L6X3-1/2X5/16	3'-10"		SQ-2 A36 GALVANIZED
		2	L6X3-1/2X5/16	3'-10"	a218	A36 GALVANIZED

A	For Approval			7/23/10	TMc	TAN
REV.	DESCRIPTION			DATE	DWN	CHK
GENERAL NOTES				JOB USE		
				SHOP		
MATERIAL: A992 / A36		ELECTRODES: E70XX LH		REF. DRG.		
HOLES: 13/16 DIA. U/N		CONN'S.: -				
SURFACE PREP. SS-PC-SP-2				APPROVAL		
AND PAINT: GREY PRIMER DEVOE NA-195 (U.N,)						
DESCRIPTION: LINTEL						
PROJECT NAME		Hamilton High School Phase III				
LOCATION		Hamilton City School District - Hamilton				
CONTRACTOR		GC Contracting				
	Avenue Fabricating Inc. 1281 Clough Pike Batavia, OH 45103 (513) 752-1911			DRAWN BY TMc		DATE 07/23/2010
				CHKD. BY TAN		DATE
				JOB No. 10-16		DRG. No. 42L16
						REV. 1

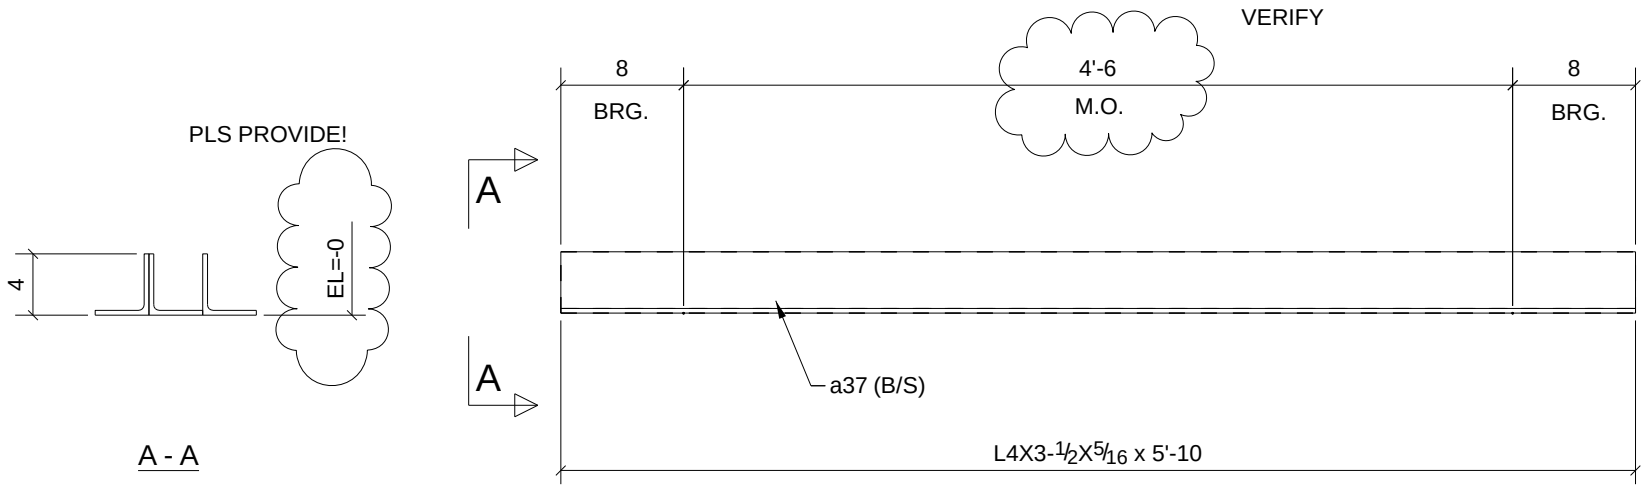

L-3 (M.O.=2'-6") LOCATION (2111)

ARCH./ENG/OWNER
PLEASE VERIFY / PROVIDE
TYPE & LOCATIONS
ERECTOR / GC ~ PLEASE
VERIFY / PROVIDE
M.O. @ EACH LOCATION

PHASE				
1	2	3	4	5
0	0	0	1	0


ONE - LINTEL - 42L17

(3 ANGLES EACH LINTEL)

BILL OF MATERIAL

SHIP	MARK	NO PCS	DESCRIPTION	LENGTH	PIECE MARK	REMARKS
1	42L17	1	L4X3-1/2X5/16	5'-10"		SQ-2 A36 GALVANIZED
		2	L4X3-1/2X5/16	5'-10"	a37	A36 GALVANIZED

A	For Approval		7/23/10	TMc	TAN
REV.	DESCRIPTION		DATE	DWN	CHK
GENERAL NOTES			JOB USE		
MATERIAL: A992 / A36		ELECTRODES: E70XX LH	REF. DRG.		
HOLES: 13/16 DIA. U/N		CONN'S.: -		SHOP	
SURFACE PREP. SSPC-SP-2			APPROVAL		
AND PAINT: GREY PRIMER DEVOE NA-195 (U.N,)					
DESCRIPTION: LINTEL					
PROJECT NAME		Hamilton High School Phase III			
LOCATION		Hamilton City School District - Hamilton			
CONTRACTOR		GC Contracting			
	Avenue Fabricating Inc. 1281 Clough Pike Batavia, OH 45103 (513) 752-1911		DRAWN BY TMc		DATE 07/23/2010
			CHKD. BY TAN		DATE
			JOB No. 10-16		DRG. No. 42L17

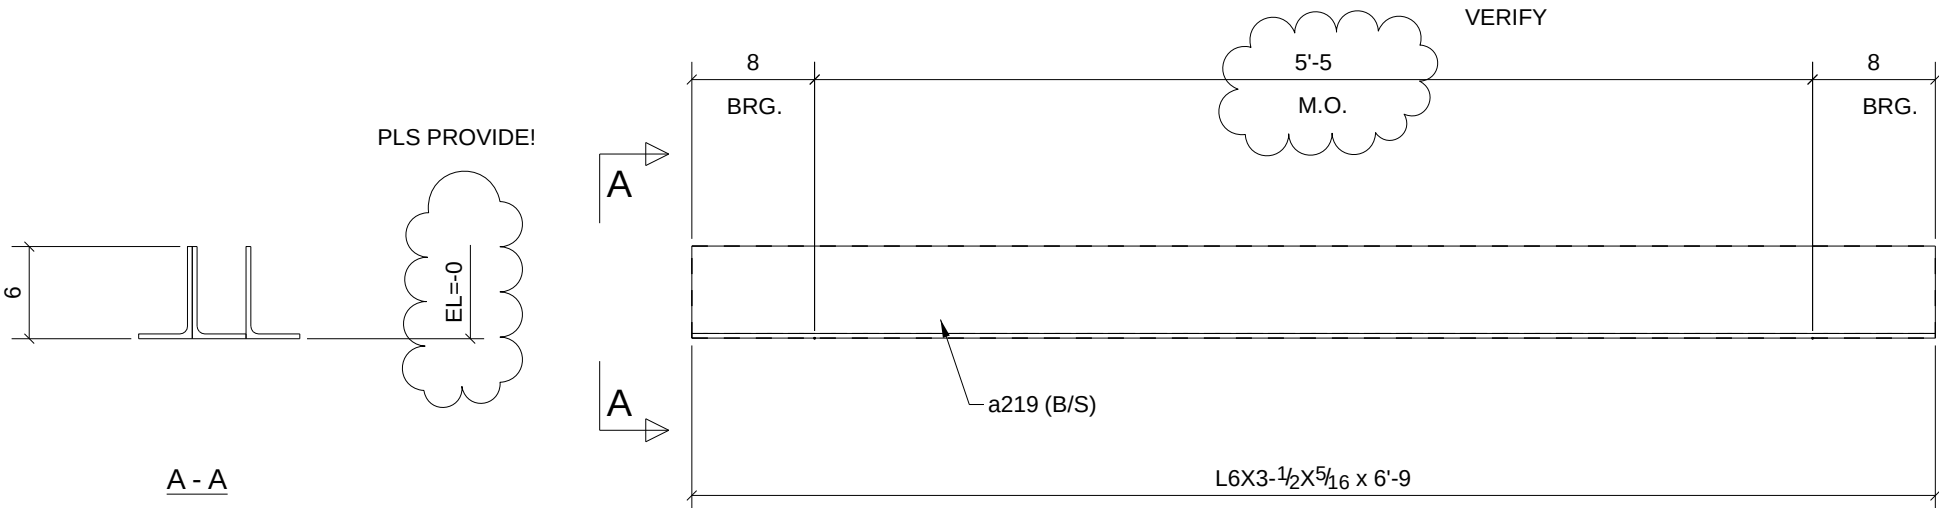

L-7 (M.O.=5'-7") LOCATION (2115)

ARCH./ENG/OWNER
PLEASE VERIFY / PROVIDE
TYPE & LOCATIONS
ERECTOR / GC ~ PLEASE
VERIFY / PROVIDE
M.O. @ EACH LOCATION

PHASE				
1	2	3	4	5
0	0	0	1	0


ONE - LINTEL - 42L18

(3 ANGLES EACH LINTEL)

BILL OF MATERIAL


SHIP	MARK	NO PCS	DESCRIPTION	LENGTH	PIECE MARK	REMARKS
1	42L18	1	L6X3-1/2X5/16	6'-9"		SQ-2 A36 GALVANIZED
		2	L6X3-1/2X5/16	6'-9"	a219	A36 GALVANIZED

A	For Approval	7/23/10	TMc	TAN
REV.	DESCRIPTION	DATE	DWN	CHK
GENERAL NOTES		JOB USE		
MATERIAL: A992 / A36	ELECTRODES: E70XX LH	REF. DRG.	SHOP	
HOLES: 13/16 DIA. U/N	CONN'S.: -			
SURFACE PREP. SS-PC-SP-2	AND PAINT: GREY PRIMER DEVOE NA-195 (U.N,)		APPROVAL	
DESCRIPTION:	LINTEL			
PROJECT NAME	Hamilton High School Phase III			
LOCATION	Hamilton City School District - Hamilton			
CONTRACTOR	GC Contracting			
	Avenue Fabricating Inc. 1281 Clough Pike Batavia, OH 45103 (513) 752-1911	DRAWN BY TMc	DATE 07/23/2010	
		CHKD. BY TAN	DATE	
		JOB No. 10-16	DRG. No. 42L18	REV. 1

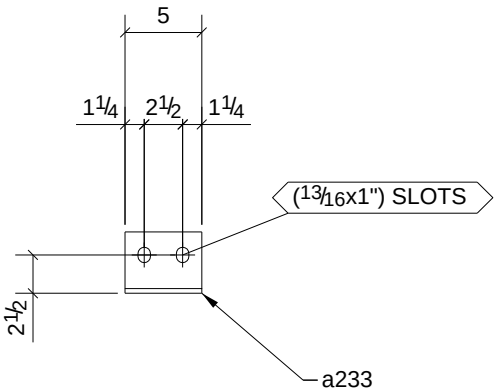

W	13 7/8"x 1/4"
F	5"x 7/16"

A	For Approval		7/23/10	TMc	TAN
REV.	DESCRIPTION		DATE	DWN	CHK
GENERAL NOTES			JOB USE		
MATERIAL: A992 / A36	ELECTRODES: E70XX LH	REF. DRG.			
HOLES: 13/16 DIA. U/N	CONN'S.: -		SHOP		
SURFACE PREP: SSPC-SP-2 AND PAINT: GREY PRIMER DEVOE NA-195 (U.N.)			APPROVAL		
DESCRIPTION: LINTEL					
PROJECT NAME		Hamilton High School Phase III			
LOCATION		Hamilton City School District - Hamilton			
CONTRACTOR		GC Contracting			
	Avenue Fabricating Inc. 1281 Clough Pike Batavia, OH 45103 (513) 752-1911		DRAWN BY TMc	DATE 07/25/2010	
			CHKD. BY TAN	DATE	
			JOB No. 10-16	DRG. No. 42L19	REV. 1

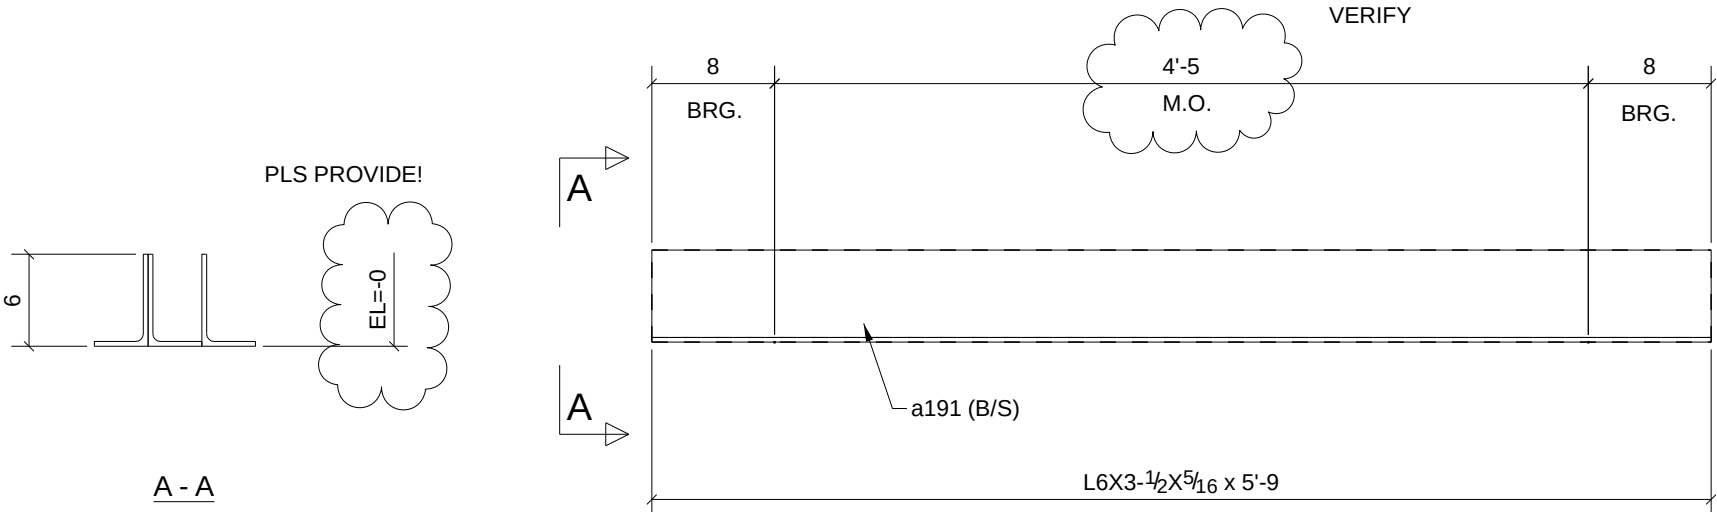

L-7 (M.O.=4'-5") LOCATION (2112)
(2104) (2X)

ARCH./ENG/OWNER
PLEASE VERIFY / PROVIDE
TYPE & LOCATIONS
ERECTOR / GC ~ PLEASE
VERIFY / PROVIDE
M.O. @ EACH LOCATION

PHASE				
1	2	3	4	5
0	0	0	4	0

4 - LINTELS - 42L2


(3 ANGLES EACH LINTEL)

BILL OF MATERIAL

SHIP	MARK	NO PCS	DESCRIPTION	LENGTH	PIECE MARK	REMARKS
4	42L2	4	L6X3-1/2X5/16	5'-9"		SQ-2 A36 GALVANIZED
		8	L6X3-1/2X5/16	5'-9"	a191	A36 GALVANIZED

A	For Approval			7/23/10	TMc	TAN			
REV.	DESCRIPTION			DATE	DWN	CHK			
GENERAL NOTES				JOB USE					
MATERIAL: A992 / A36		ELECTRODES: E70XX LH		REF. DRG.					
HOLES: 13/16 DIA. U/N		CONN'S.: -				SHOP			
SURFACE PREP. SSPC-SP-2				APPROVAL					
AND PAINT: GREY PRIMER DEVOE NA-195 (U.N,)									
DESCRIPTION: LINTEL									
PROJECT NAME		Hamilton High School Phase III							
LOCATION		Hamilton City School District - Hamilton							
CONTRACTOR		GC Contracting							
		Avenue Fabricating Inc. 1281 Clough Pike Batavia, OH 45103 (513) 752-1911			DRAWN BY		DATE		
					TMc		07/23/2010		
					CHKD. BY		DATE		
					TAN				
					JOB No.		DRG. No.		REV.
					10-16		42L2		1

Avenue Fabricating Inc.
1281 Clough Pike
Batavia, OH 45103
(513) 752-1911

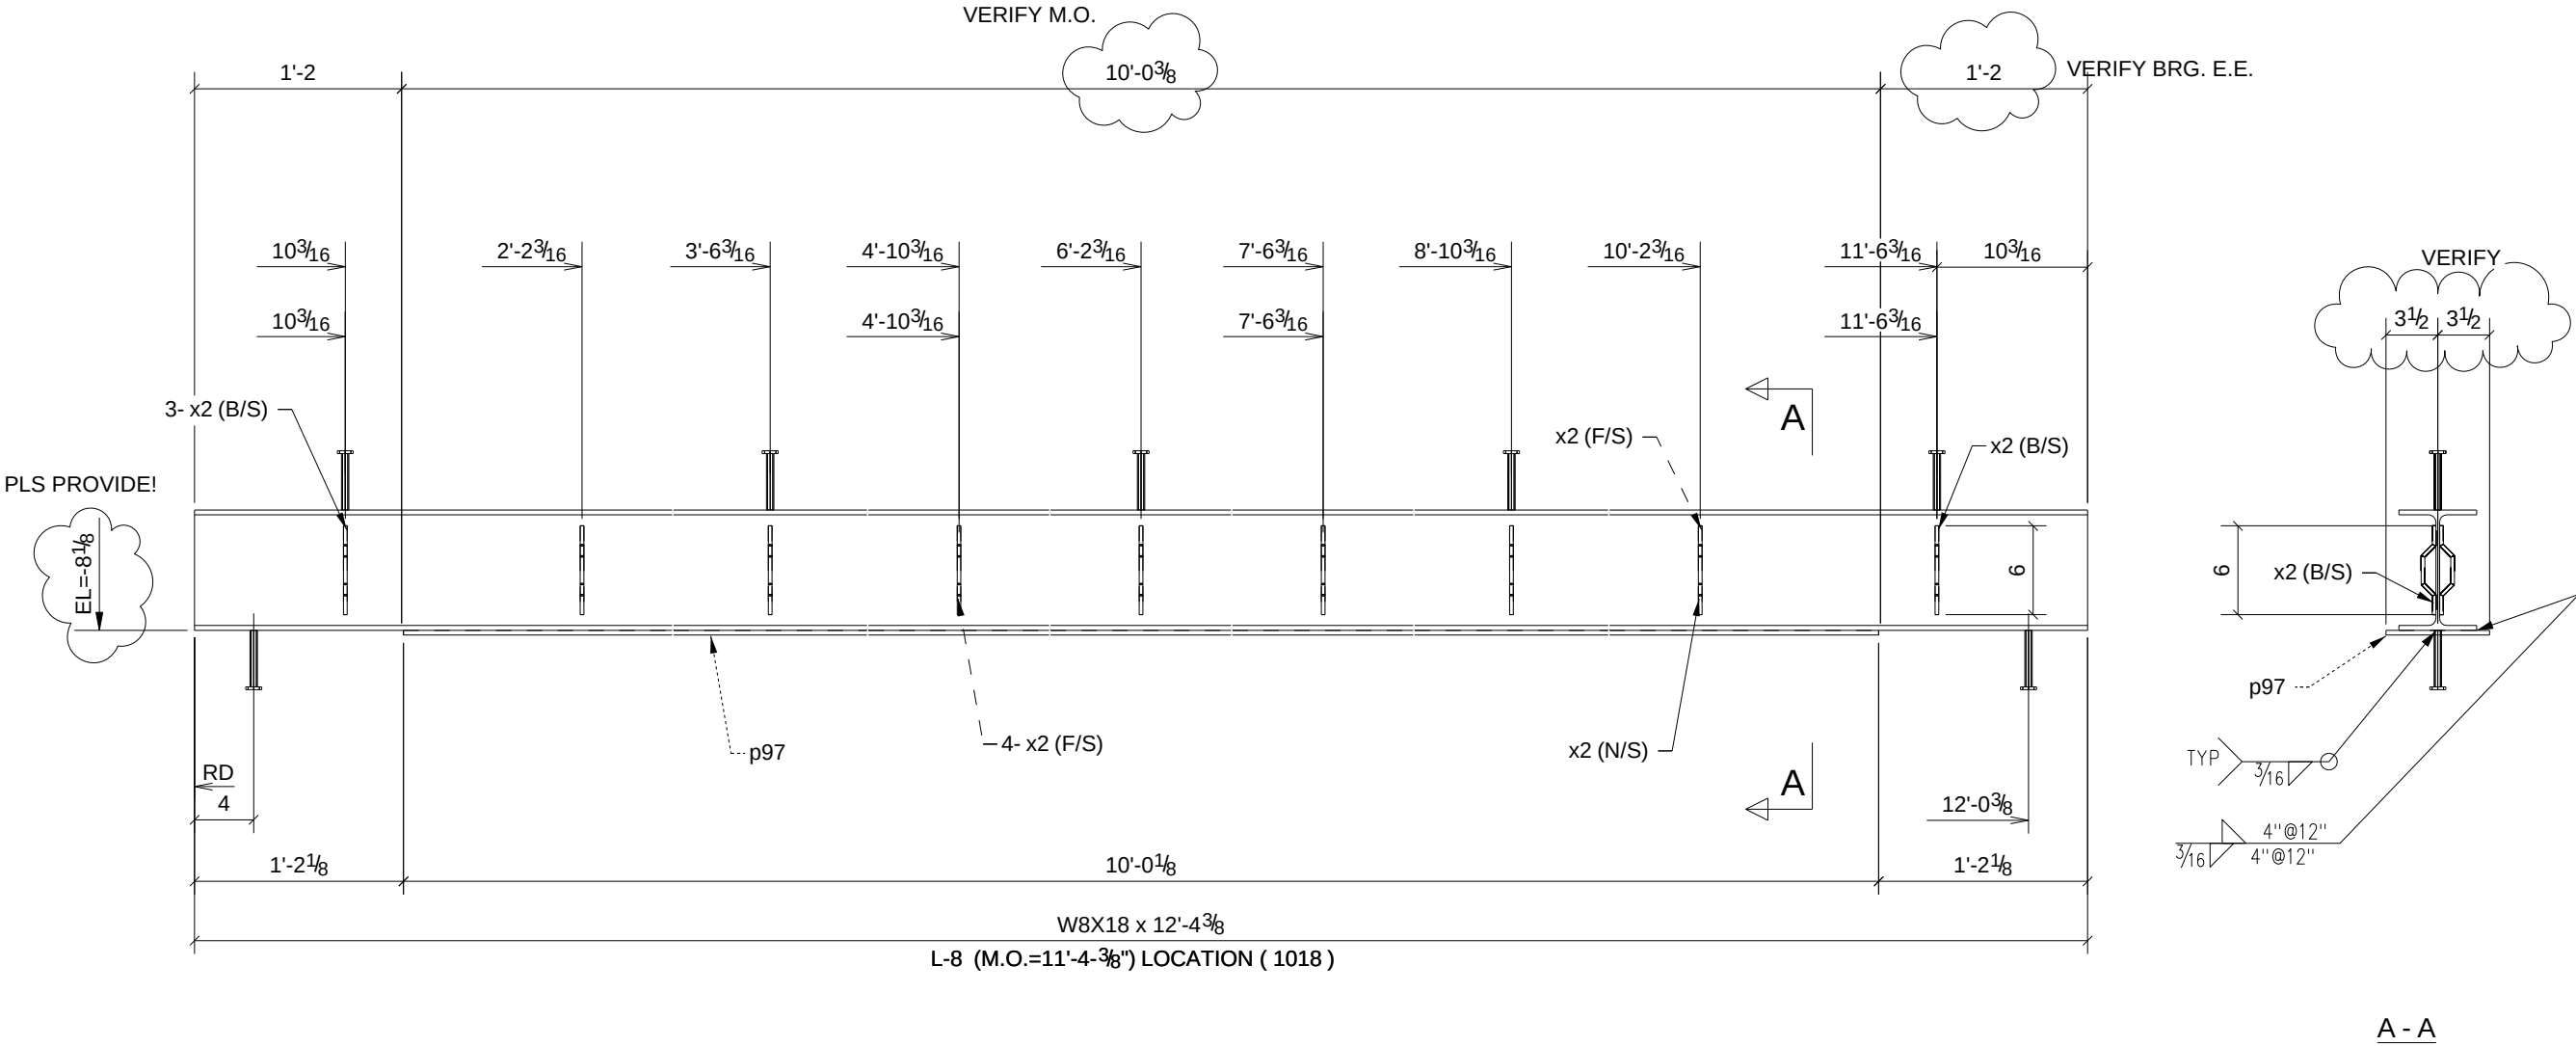


PHASE				
1	2	3	4	5
1	0	0	0	0

ONE - LINTEL - 42L3

W	8 1/8" x 1/4"
F	5 1/4" x 5/16"

BILL OF MATERIAL						
SHIP	MARK	NO PCS	DESCRIPTION	LENGTH	PIECE MARK	REMARKS
1	42L3	1	W8X18	12'-4 3/8"		SQ-2 A992 -
		1	BAR5/16"X7"	10'-0 1/8"	p97	A36 GALVANIZED
		18	H&B #359	0'-6 3/16"	x2	A36
		7	STUD 1/2" DIA	0'-4"		

A	For Approval			7/20/10	TMc	TAN		
REV.	DESCRIPTION			DATE	DWN	CHK		
GENERAL NOTES				JOB USE				
				SHOP				
MATERIAL: A992 / A36		ELECTRODES: E70XX LH		REF. DRG.				
HOLES: 13/16 DIA. U/N		CONN'S.: -						
SURFACE PREP. SSPC-SP-2				APPROVAL				
AND PAINT: GREY PRIMER DEVOE NA-195 (U.N.)								
DESCRIPTION: LINTEL								
PROJECT NAME		Hamilton High School Phase III						
LOCATION		Hamilton City School District - Hamilton						
CONTRACTOR		GC Contracting						
		Avenue Fabricating Inc. 1281 Clough Pike Batavia, OH 45103 (513) 752-1911			DRAWN BY		DATE	
					TMc		07/20/2010	
					CHKD. BY		DATE	
					TAN			
		JOB No.			DRG. No.		REV.	
		10-16			42L3		1	

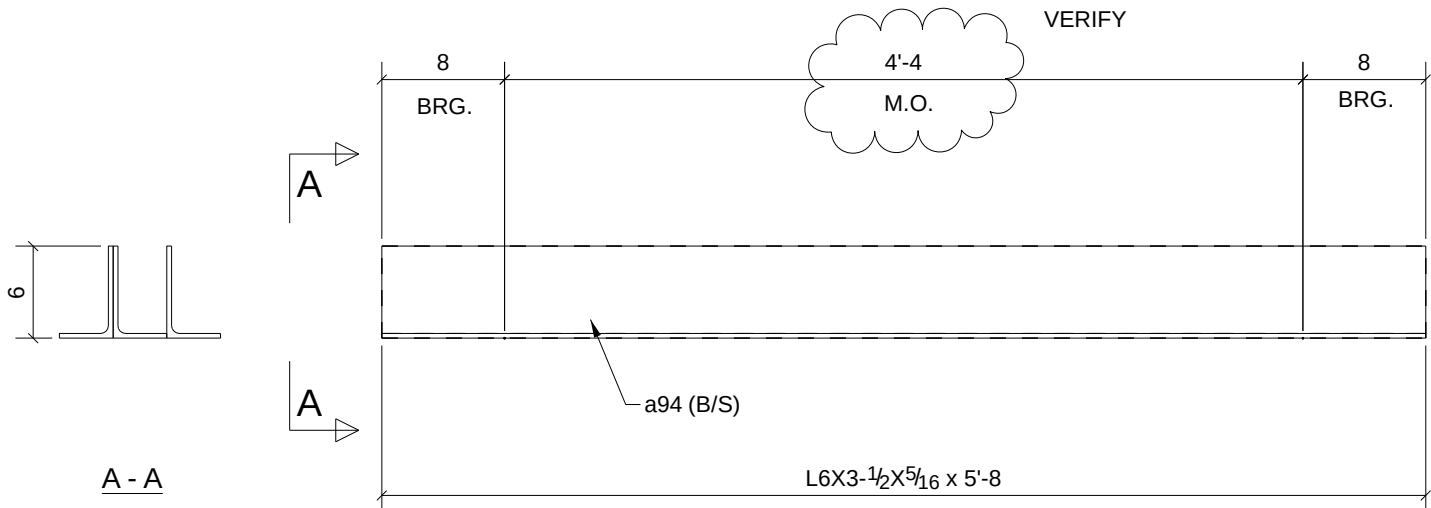

L-7 (M.O.=4'-4") LOCATION (1158)

ARCH./ENG/OWNER
PLEASE VERIFY / PROVIDE
TYPE & LOCATIONS
ERECTOR / GC ~ PLEASE
VERIFY / PROVIDE
M.O. @ EACH LOCATION

PHASE				
1	2	3	4	5
0	0	0	0	1

ONE - LINTEL - 42L4


(3 ANGLES EACH LINTEL)

BILL OF MATERIAL

SHIP	MARK	NO PCS	DESCRIPTION	LENGTH	PIECE MARK	REMARKS
1	42L4	1	L6X3-1/2X5/16	5'-8"		SQ-2 A36 GALVANIZED
		2	L6X3-1/2X5/16	5'-8"	a94	A36 GALVANIZED

A	For Approval		7/20/10	TMc	TAN	
REV.	DESCRIPTION		DATE	DWN	CHK	
GENERAL NOTES			JOB USE			
MATERIAL: A992 / A36		ELECTRODES: E70XX LH	REF. DRG.			
HOLES: 13/16 DIA. U/N		CONN'S.: -		SHOP		
SURFACE PREP. SSPC-SP-2 AND PAINT: GREY PRIMER DEVOE NA-195 (U.N,)			APPROVAL			
DESCRIPTION: LINTEL						
PROJECT NAME		Hamilton High School Phase III				
LOCATION		Hamilton City School District - Hamilton				
CONTRACTOR		GC Contracting				
	Avenue Fabricating Inc. 1281 Clough Pike Batavia, OH 45103 (513) 752-1911		DRAWN BY		DATE	
			TMc		07/20/2010	
			CHKD. BY		DATE	
			TAN			
		JOB No.	DRG. No.		REV.	
		10-16	42L4		1	

Avenue Fabricating Inc.
1281 Clough Pike
Batavia, OH 45103
(513) 752-1911

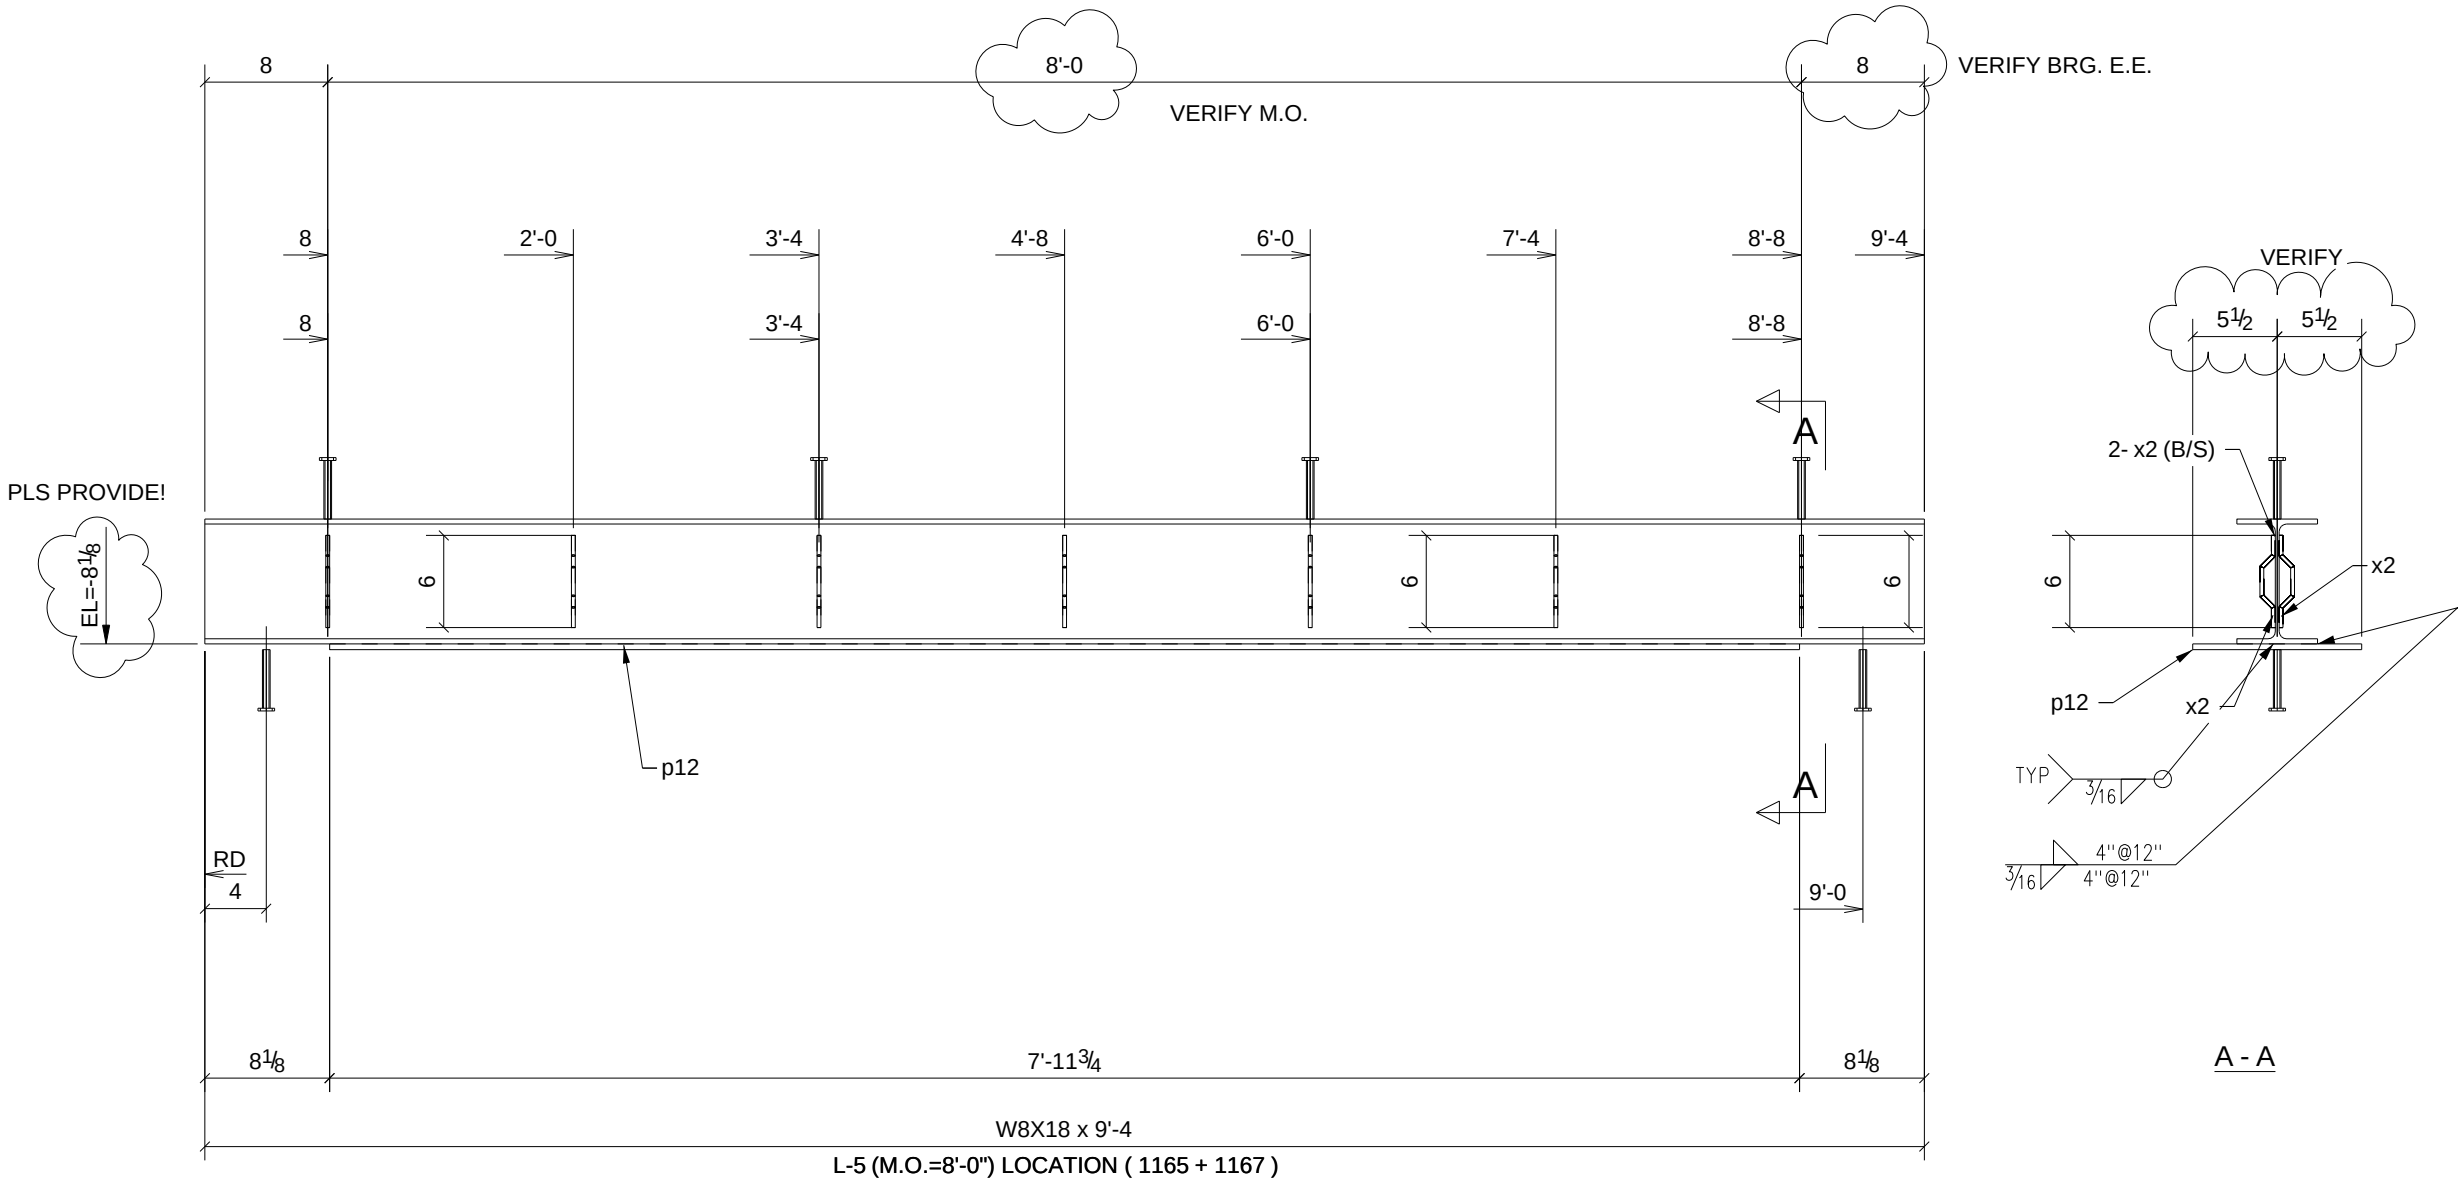

PHASE					
1	2	3	4	5	
0	0	0	2	0	


2 - LINTELS - 42L5

W	8 1/8"x1/4"
F	5 1/4"x5/16"

BILL OF MATERIAL

SHIP	MARK	NO PCS	DESCRIPTION	LENGTH	PIECE MARK	REMARKS
2	42L5	2	W8X18	9'-4"		SQ-2 A992 GALVANIZED
		2	BAR3/8"X11"	7'-11 3/4"	p12	A36 GALVANIZED
		28	H&B #359	0'-6 3/16"	x2	A36
		12	STUD 1/2" DIA	0'-4"		

A	For Approval	7/20/10	TMc	TAN
REV.	DESCRIPTION	DATE	DWN	CHK
GENERAL NOTES		JOB USE		
MATERIAL: A992 / A36	ELECTRODES: E70XX LH	REF. DRG.	SHOP	
HOLES: 13/16 DIA. U/N	CONN'S.: -			
SURFACE PREP. SSPC-SP-2	AND PAINT: GREY PRIMER DEVOE NA-195 (U.N.)		APPROVAL	
DESCRIPTION:	LINTEL			
PROJECT NAME	Hamilton High School Phase III			
LOCATION	Hamilton City School District - Hamilton			
CONTRACTOR	GC Contracting			
Avenue Fabricating Inc. 1281 Clough Pike Batavia, OH 45103 (513) 752-1911		DRAWN BY	DATE	
		TMc	07/19/2010	
		CHKD. BY	DATE	
		TAN		
		JOB No.	DRG. No.	REV.
		10-16	42L5	1

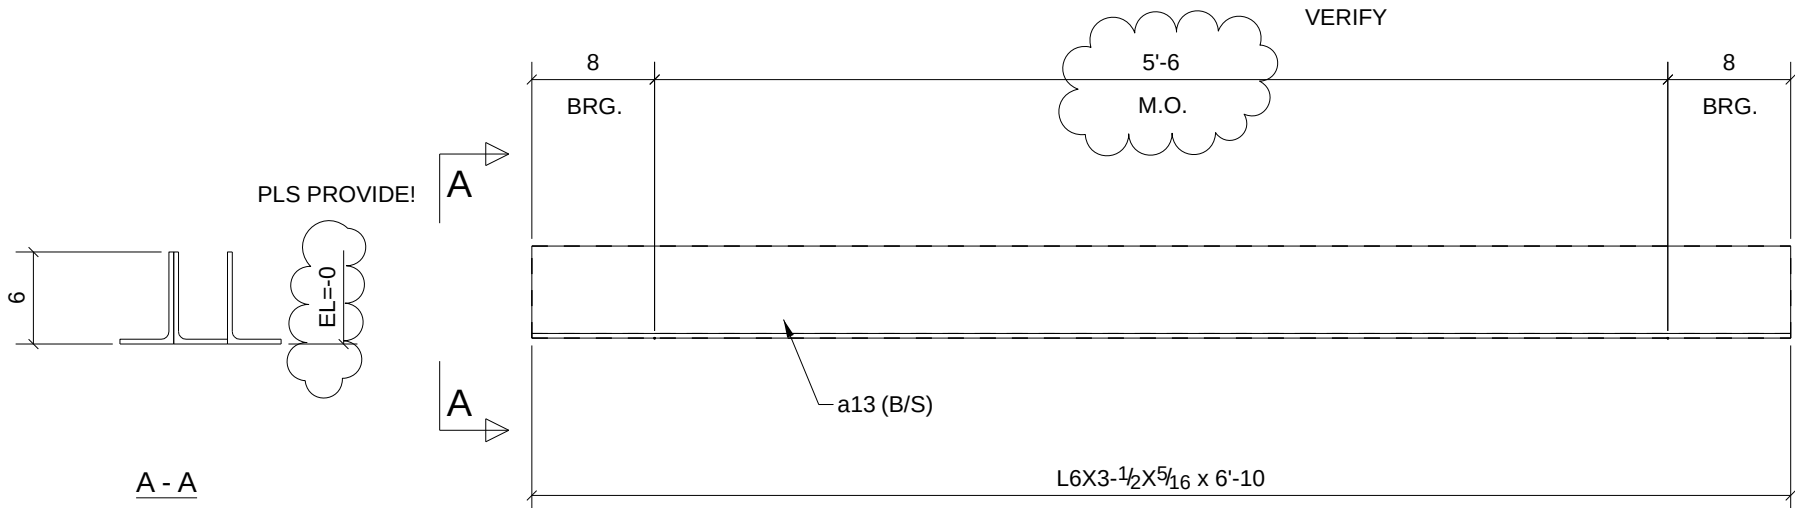

L-7 (M.O.=5'-5") LOCATION (2108)
(2102)

ARCH./ENG/OWNER
PLEASE VERIFY / PROVIDE
TYPE & LOCATIONS
ERECTOR / GC ~ PLEASE
VERIFY / PROVIDE
M.O. @ EACH LOCATION

PHASE				
1	2	3	4	5
0	0	0	2	0


2 - LINTELS - 42L6

(3 ANGLES EACH LINTEL)

BILL OF MATERIAL

SHIP	MARK	NO PCS	DESCRIPTION	LENGTH	PIECE MARK	REMARKS
2	42L6	2	L6X3-1/2X5/16	6'-10"		SQ-2 A36 GALVANIZED
		4	L6X3-1/2X5/16	6'-10"	a13	A36 GALVANIZED

A	For Approval		7/23/10	TMc	TAN	
REV.	DESCRIPTION		DATE	DWN	CHK	
GENERAL NOTES			JOB USE			
			MATERIAL: A992 / A36	ELECTRODES: E70XX LH	REF. DRG.	SHOP
HOLES: 13/16 DIA. U/N	CONN'S.: -					
SURFACE PREP. SS-PC-SP-2			APPROVAL			
AND PAINT: GREY PRIMER DEVOE NA-195 (U.N,)						
DESCRIPTION: LINTEL						
PROJECT NAME		Hamilton High School Phase III				
LOCATION		Hamilton City School District - Hamilton				
CONTRACTOR		GC Contracting				
	Avenue Fabricating Inc. 1281 Clough Pike Batavia, OH 45103 (513) 752-1911		DRAWN BY TMc		DATE 07/23/2010	
			CHKD. BY TAN		DATE	
			JOB No. 10-16		DRG. No. 42L6	

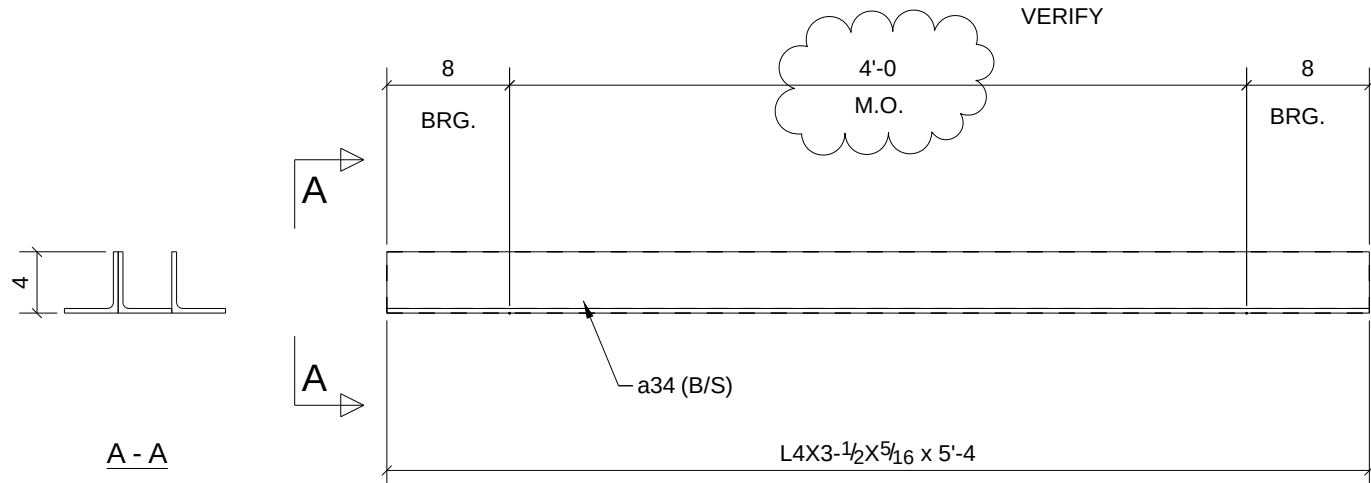

L-3 (M.O.=3'-4") LOCATION (1157B)

ARCH./ENG/OWNER
PLEASE VERIFY / PROVIDE
TYPE & LOCATIONS
ERECTOR / GC ~ PLEASE
VERIFY / PROVIDE
M.O. @ EACH LOCATION

PHASE				
1	2	3	4	5
0	0	1	0	0

ONE - LINTEL - 42L7


(3 ANGLES EACH LINTEL)

BILL OF MATERIAL

SHIP	MARK	NO PCS	DESCRIPTION	LENGTH	PIECE MARK	REMARKS
1	42L7	1	L4X3-1/2X5/16	5'-4"		SQ-2 A36 GALVANIZED
		2	L4X3-1/2X5/16	5'-4"	a34	A36 GALVANIZED

A	For Approval		7/20/10	TMc	TAN
REV.	DESCRIPTION		DATE	DWN	CHK
GENERAL NOTES			JOB USE		
MATERIAL: A992 / A36		ELECTRODES: E70XX LH	REF. DRG.		
HOLES: 13/16 DIA. U/N		CONN'S.: -		SHOP	
SURFACE PREP. SS-PC-SP-2 AND PAINT: GREY PRIMER DEVOE NA-195 (U.N,)			APPROVAL		
DESCRIPTION: LINTEL					
PROJECT NAME		Hamilton High School Phase III			
LOCATION		Hamilton City School District - Hamilton			
CONTRACTOR		GC Contracting			
	Avenue Fabricating Inc. 1281 Clough Pike Batavia, OH 45103 (513) 752-1911		DRAWN BY		DATE
			TMc		07/20/2010
			CHKD. BY		DATE
			TAN		
		JOB No.	DRG. No.	REV.	
		10-16	42L7	1	

Avenue Fabricating Inc.
1281 Clough Pike
Batavia, OH 45103
(513) 752-1911

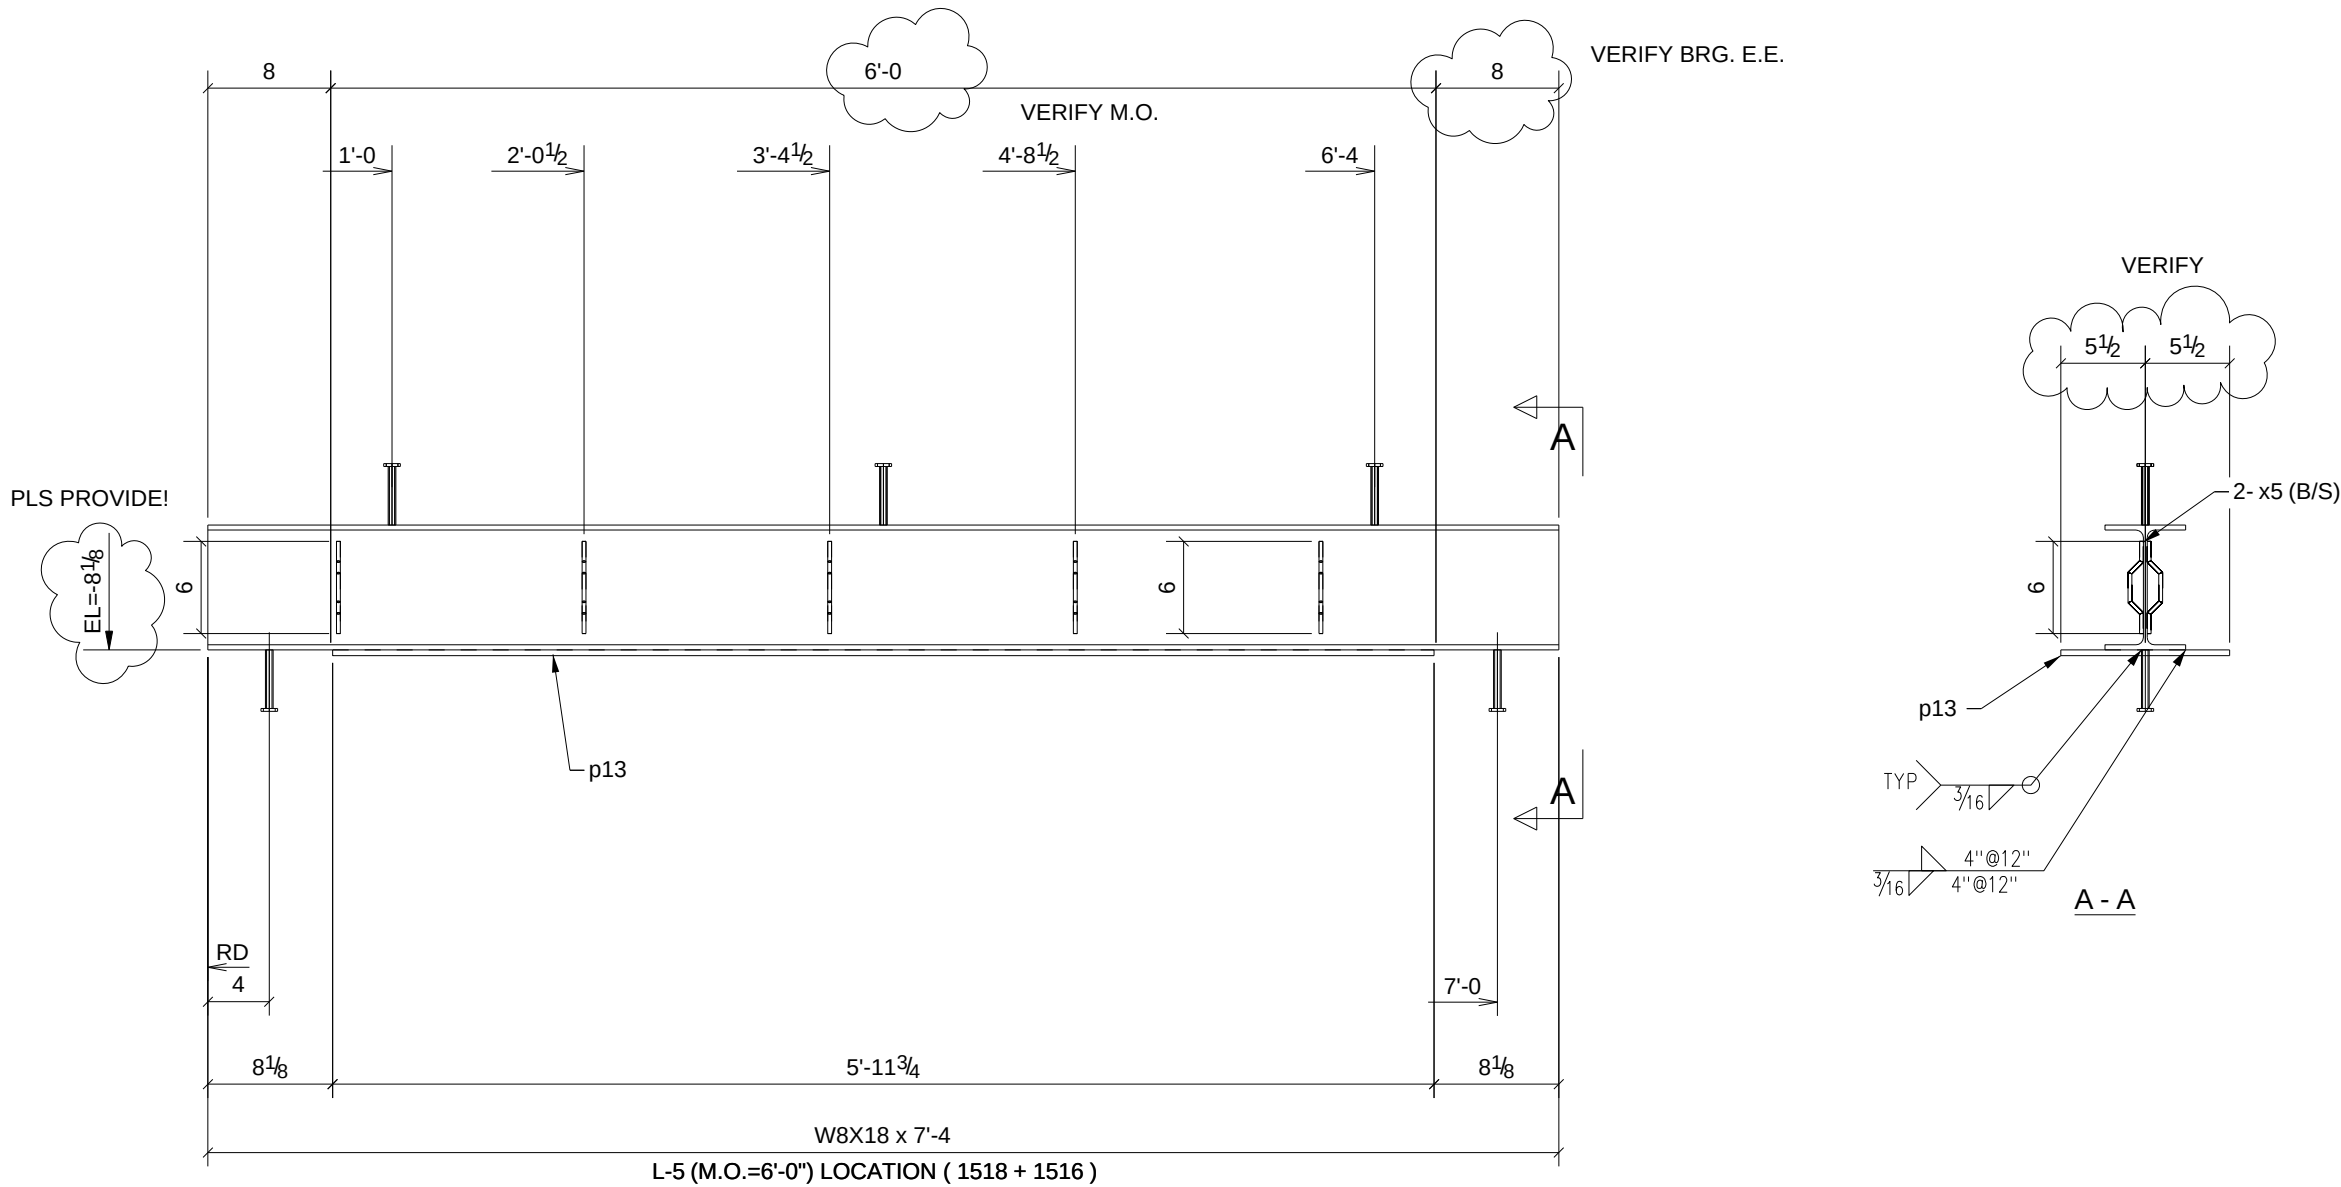

2 - LINTELS - 42L8


PHASE					
1	2	3	4	5	
0	0	0	2	0	

W	8 1/8"x1/4"
F	5 1/4"x5/16"

A	For Approval		7/20/10	TMc	TAN
REV.	DESCRIPTION		DATE	DWN	CHK
GENERAL NOTES			JOB USE		
MATERIAL: A992 / A36	ELECTRODES: E70XX LH	REF. DRG.	SHOP		
HOLES: 13/16 DIA. U/N	CONN'S.: -				
SURFACE PREP. SSPC-SP-2 AND PAINT: GREY PRIMER DEVOE NA-195 (U.N,)			APPROVAL		
DESCRIPTION: LINTEL					
PROJECT NAME		Hamilton High School Phase III			
LOCATION		Hamilton City School District - Hamilton			
CONTRACTOR		GC Contracting			
	Avenue Fabricating Inc. 1281 Clough Pike Batavia, OH 45103 (513) 752-1911		DRAWN BY TMc	DATE 07/19/2010	
			CHKD. BY TAN	DATE	
			JOB No. 10-16	DRG. No. 42L8	REV. 1

BILL OF MATERIAL

SHIP	MARK	NO PCS	DESCRIPTION	LENGTH	PIECE MARK	REMARKS
2	42L8	2	W8X18	7'-4"		SQ-2 A992 GALVANIZED
		2	BAR3/8"X11"	5'-11 3/4"	p13	A36 GALVANIZED
		20	H&B #359	0'-6 3/16"	x5	A36 GALVANIZED
		10	STUD 1/2" DIA	0'-4"		

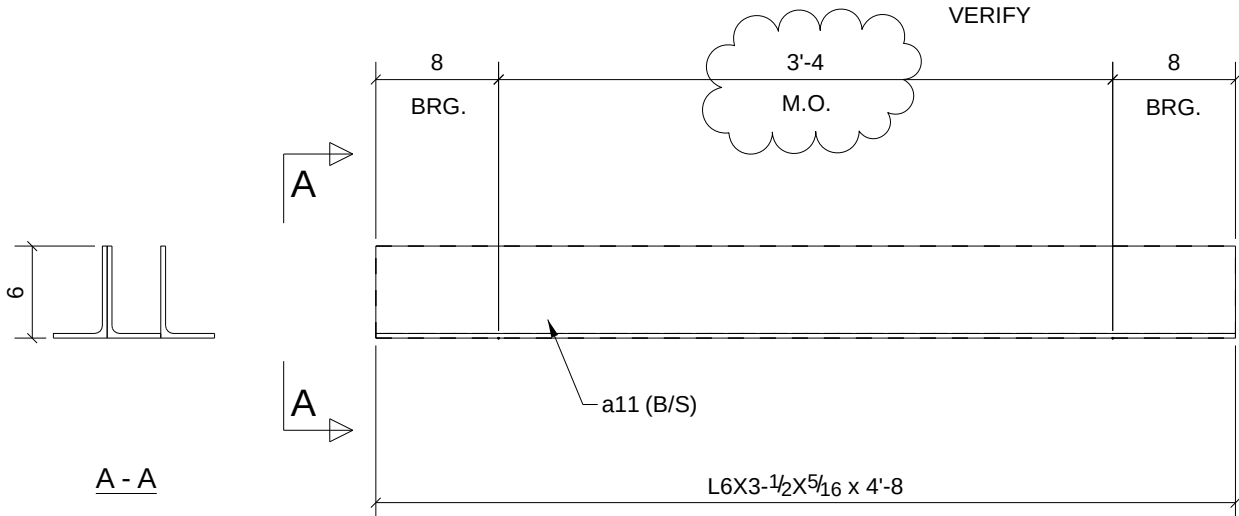

L-7 (M.O.=3'-4") LOCATION (1515)
(1116)
(1117)
(1118)
(1119)

ARCH./ENG/OWNER
PLEASE VERIFY / PROVIDE
TYPE & LOCATIONS
ERECTOR / GC ~ PLEASE
VERIFY / PROVIDE
M.O. @ EACH LOCATION

PHASE				
1	2	3	4	5
0	0	0	5	0


5 - LINTELS - 42L9

(3 ANGLES EACH LINTEL)

BILL OF MATERIAL

SHIP	MARK	NO PCS	DESCRIPTION	LENGTH	PIECE MARK	REMARKS
5	42L9	5	L6X3-1/2X5/16	4'-8"		SQ-2 A36 1 S/C STD PRIMER
		10	L6X3-1/2X5/16	4'-8"	a11	A36 1 S/C STD PRIMER

A	For Approval		7/20/10	TMc	TAN
REV.	DESCRIPTION		DATE	DWN	CHK
GENERAL NOTES			JOB USE		
MATERIAL: A992 / A36		ELECTRODES: E70XX LH	REF. DRG.		
HOLES: 13/16 DIA. U/N		CONN'S.: -		SHOP	
SURFACE PREP. SS-PC-SP-2			APPROVAL		
AND PAINT: GREY PRIMER DEVOE NA-195 (U.N,)					
DESCRIPTION: LINTEL					
PROJECT NAME		Hamilton High School Phase III			
LOCATION		Hamilton City School District - Hamilton			
CONTRACTOR		GC Contracting			
	Avenue Fabricating Inc. 1281 Clough Pike Batavia, OH 45103 (513) 752-1911		DRAWN BY		DATE
			TMc		07/20/2010
			CHKD. BY		DATE
			TAN		
		JOB No.	DRG. No.	REV.	
		10-16	42L9	1	

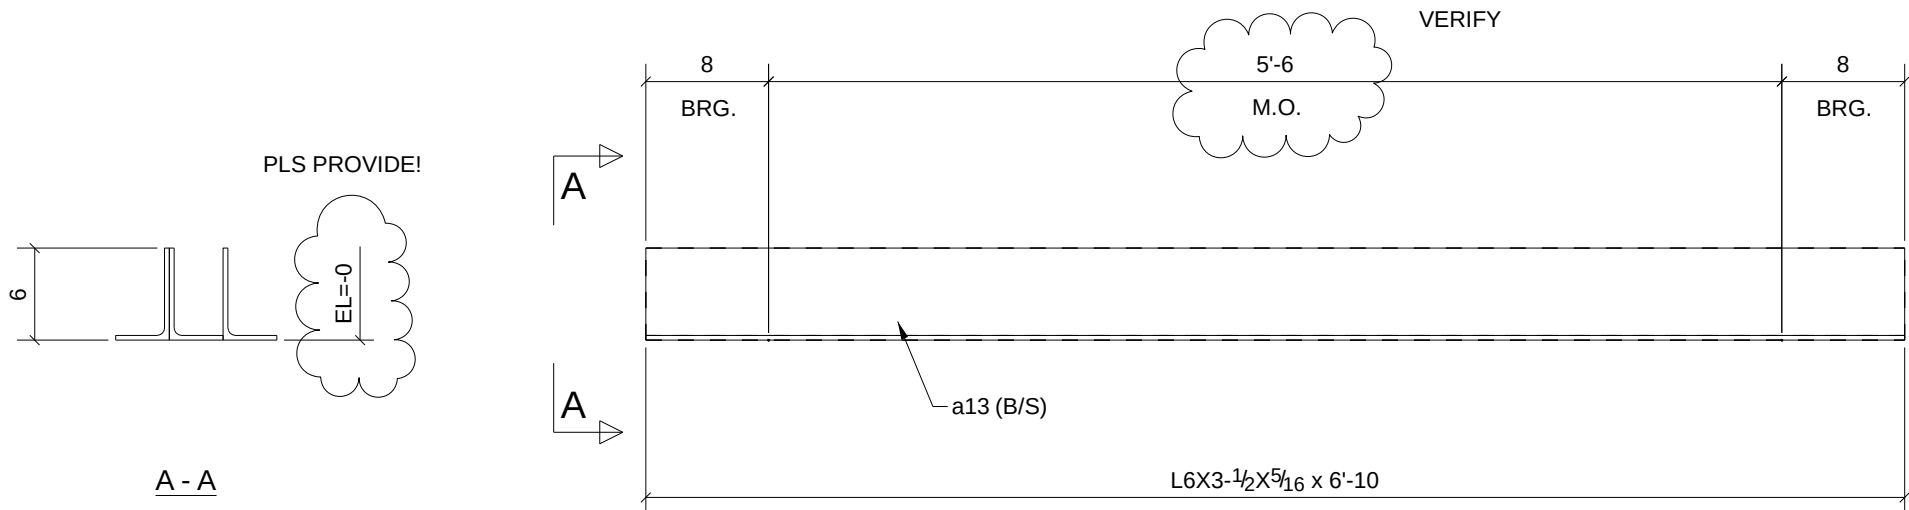

L-7 (M.O.=5'-6") LOCATION (1102) (2X)
(1110)
(1128A)
(2101)
(2107(2X))
2113

ARCH./ENG/OWNER
PLEASE VERIFY / PROVIDE
TYPE & LOCATIONS
ERECTOR / GC ~ PLEASE
VERIFY / PROVIDE
M.O. @ EACH LOCATION

PHASE				
1	2	3	4	5
0	0	0	0	8

8 - LINTELS - 52L1


(3 ANGLES EACH LINTEL)

BILL OF MATERIAL

SHIP	MARK	NO PCS	DESCRIPTION	LENGTH	PIECE MARK	REMARKS
8	52L1	8	L6X3-1/2X5/16	6'-10"		SQ-2 A36 GALVANIZED
		16	L6X3-1/2X5/16	6'-10"	a13	A36 GALVANIZED

A	For Approval		7/20/10	TMc	TAN
REV.	DESCRIPTION		DATE	DWN	CHK
GENERAL NOTES			JOB USE		
MATERIAL: A992 / A36		ELECTRODES: E70XX LH	REF. DRG.		
HOLES: 13/16 DIA. U/N		CONN'S.: -		SHOP	
SURFACE PREP. SS-PC-SP-2			APPROVAL		
AND PAINT: GREY PRIMER DEVOE NA-195 (U.N,)					
DESCRIPTION: LINTEL					
PROJECT NAME		Hamilton High School Phase III			
LOCATION		Hamilton City School District - Hamilton			
CONTRACTOR		GC Contracting			
	Avenue Fabricating Inc. 1281 Clough Pike Batavia, OH 45103 (513) 752-1911		DRAWN BY		DATE
			TMc		07/20/2010
			CHKD. BY		DATE
			TAN		
		JOB No.	DRG. No.	REV.	
		10-16	52L1	1	

Avenue Fabricating Inc.
1281 Clough Pike
Batavia, OH 45103
(513) 752-1911

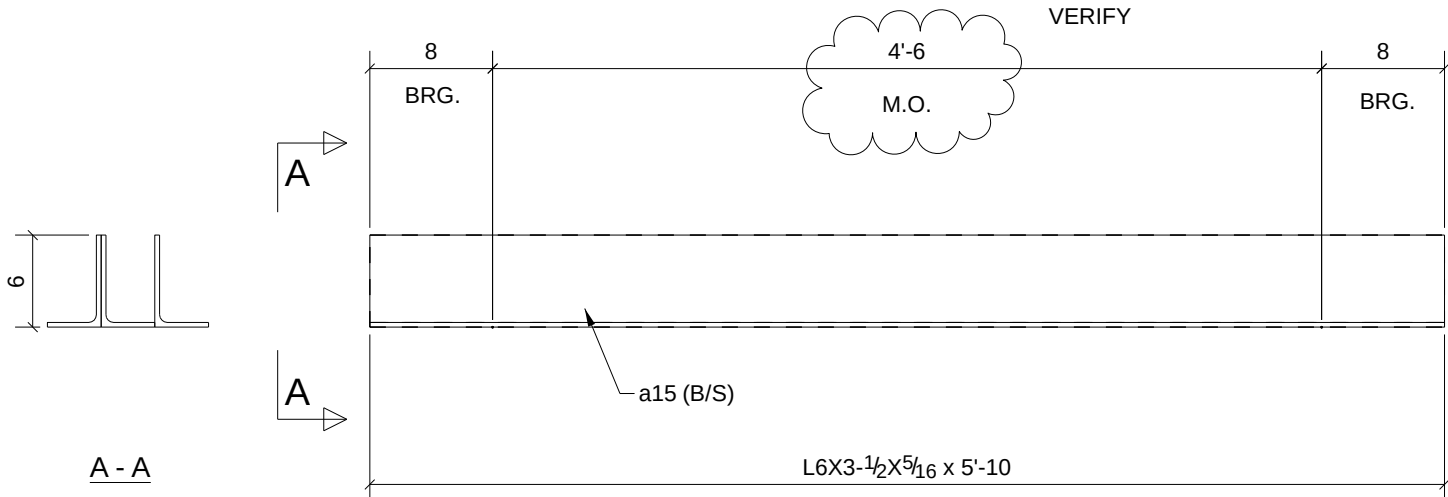

L-7 (M.O.=4'-6") LOCATION (1112)

(1105) (2X)

ARCH./ENG/OWNER
PLEASE VERIFY / PROVIDE
TYPE & LOCATIONS
ERECTOR / GC ~ PLEASE
VERIFY / PROVIDE
M.O. @ EACH LOCATION

PHASE				
1	2	3	4	5
0	0	0	0	3


3 - LINTELS - 52L2

(3 ANGLES EACH LINTEL)

BILL OF MATERIAL

SHIP	MARK	NO PCS	DESCRIPTION	LENGTH	PIECE MARK	REMARKS
3	52L2	3	L6X3-1/2X5/16	5'-10"		SQ-2 A36 GALVANIZED
		6	L6X3-1/2X5/16	5'-10"	a15	A36 GALVANIZED

A	For Approval			7/20/10	TMc	TAN
REV.	DESCRIPTION			DATE	DWN	CHK
GENERAL NOTES				JOB USE		
				SHOP		
MATERIAL: A992 / A36		ELECTRODES: E70XX LH		REF. DRG.		
HOLES: 13/16 DIA. U/N		CONN'S.: -				
SURFACE PREP. SSPC-SP-2 AND PAINT: GREY PRIMER DEVOE NA-195 (U.N,)				APPROVAL		
DESCRIPTION: LINTEL						
PROJECT NAME		Hamilton High School Phase III				
LOCATION		Hamilton City School District - Hamilton				
CONTRACTOR		GC Contracting				
	Avenue Fabricating Inc. 1281 Clough Pike Batavia, OH 45103 (513) 752-1911			DRAWN BY TMc		DATE 07/20/2010
				CHKD. BY TAN		DATE
				JOB No. 10-16		DRG. No. 52L2

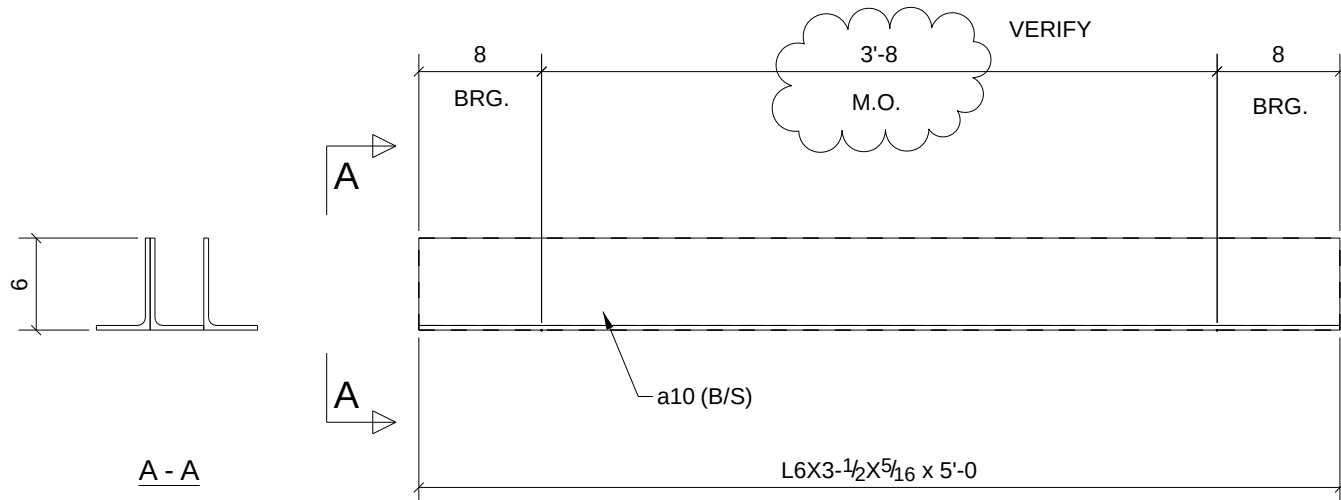

L-7 (M.O.=3'-8") LOCATION (1110) (2X)

ARCH./ENG/OWNER
PLEASE VERIFY / PROVIDE
TYPE & LOCATIONS
ERECTOR / GC ~ PLEASE
VERIFY / PROVIDE
M.O. @ EACH LOCATION

PHASE				
1	2	3	4	5
0	0	0	0	2

2 - LINTELS - 52L3


(3 ANGLES EACH LINTEL)

BILL OF MATERIAL

SHIP	MARK	NO PCS	DESCRIPTION	LENGTH	PIECE MARK	REMARKS
2	52L3	2	L6X3-1/2X5/16	5'-0"		SQ-2 A36 GALVANIZED
		4	L6X3-1/2X5/16	5'-0"	a10	A36 GALVANIZED

A	For Approval		7/20/10	TMc	TAN
REV.	DESCRIPTION		DATE	DWN	CHK
GENERAL NOTES			JOB USE		
MATERIAL: A992 / A36		ELECTRODES: E70XX LH	REF. DRG.		
HOLES: 13/16 DIA. U/N		CONN'S.: -		SHOP	
SURFACE PREP. SS-PC-SP-2			APPROVAL		
AND PAINT: GREY PRIMER DEVOE NA-195 (U.N,)					
DESCRIPTION: LINTEL					
PROJECT NAME		Hamilton High School Phase III			
LOCATION		Hamilton City School District - Hamilton			
CONTRACTOR		GC Contracting			
	Avenue Fabricating Inc. 1281 Clough Pike Batavia, OH 45103 (513) 752-1911		DRAWN BY		DATE
			TMc		07/20/2010
			CHKD. BY		DATE
			TAN		
		JOB No.	DRG. No.	REV.	
		10-16	52L3	1	

Avenue Fabricating Inc.
1281 Clough Pike
Batavia, OH 45103
(513) 752-1911

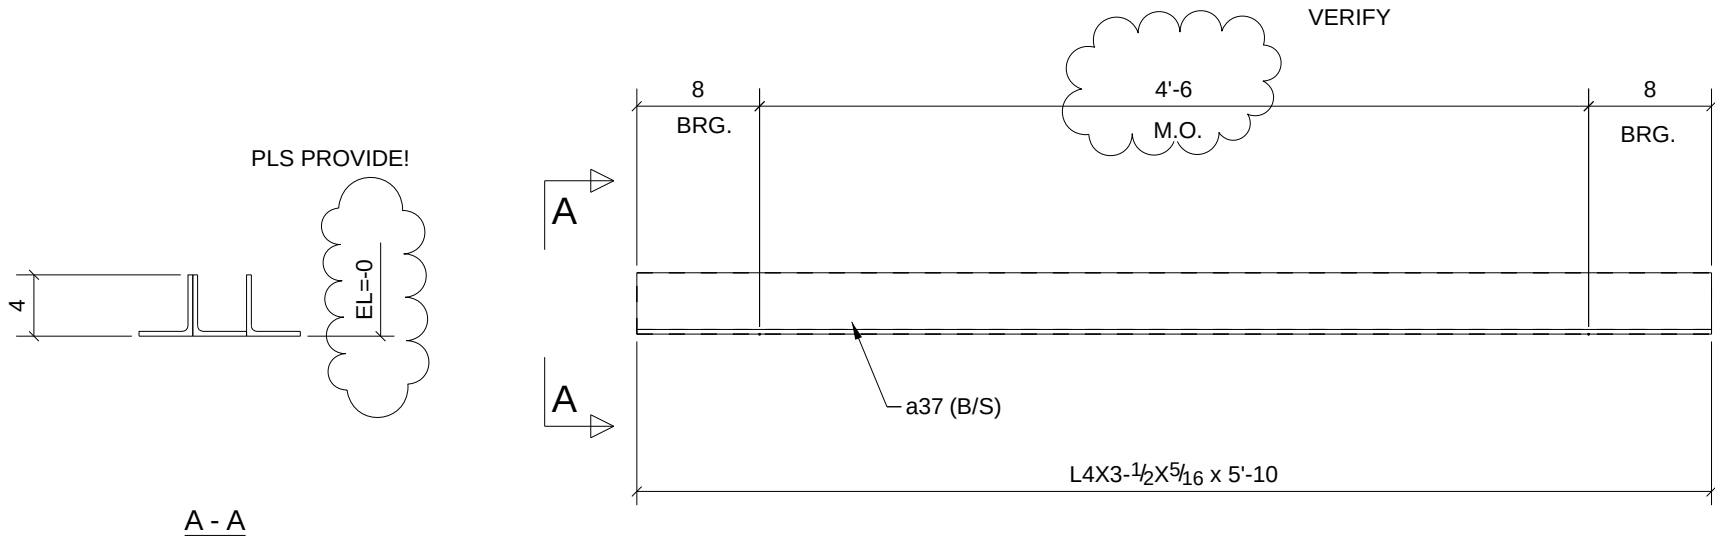

L-3 (M.O.=4'-6") LOCATION (1110)

ARCH./ENG/OWNER
PLEASE VERIFY / PROVIDE
TYPE & LOCATIONS
ERECTOR / GC ~ PLEASE
VERIFY / PROVIDE
M.O. @ EACH LOCATION

PHASE				
1	2	3	4	5
0	0	0	0	1

ONE - LINTEL - 52L4


(3 ANGLES EACH LINTEL)

BILL OF MATERIAL

SHIP	MARK	NO PCS	DESCRIPTION	LENGTH	PIECE MARK	REMARKS
1	52L4	1	L4X3-1/2X5/16	5'-10"		SQ-2 A36 GALVANIZED
		2	L4X3-1/2X5/16	5'-10"	a37	A36 GALVANIZED

A	For Approval			7/20/10	TMc	TAN		
REV.	DESCRIPTION			DATE	DWN	CHK		
GENERAL NOTES				JOB USE				
				SHOP				
MATERIAL: A992 / A36		ELECTRODES: E70XX LH		REF. DRG.				
HOLES: 13/16 DIA. U/N		CONN'S.: -						
SURFACE PREP. SS-PC-SP-2				APPROVAL				
AND PAINT: GREY PRIMER DEVOE NA-195 (U.N,)								
DESCRIPTION: LINTEL								
PROJECT NAME		Hamilton High School Phase III						
LOCATION		Hamilton City School District - Hamilton						
CONTRACTOR		GC Contracting						
		Avenue Fabricating Inc. 1281 Clough Pike Batavia, OH 45103 (513) 752-1911			DRAWN BY		DATE	
					TMc		07/20/2010	
					CHKD. BY		DATE	
					TAN			
		JOB No.			DRG. No.		REV.	
		10-16			52L4		1	

Avenue Fabricating Inc.
1281 Clough Pike
Batavia, OH 45103
(513) 752-1911

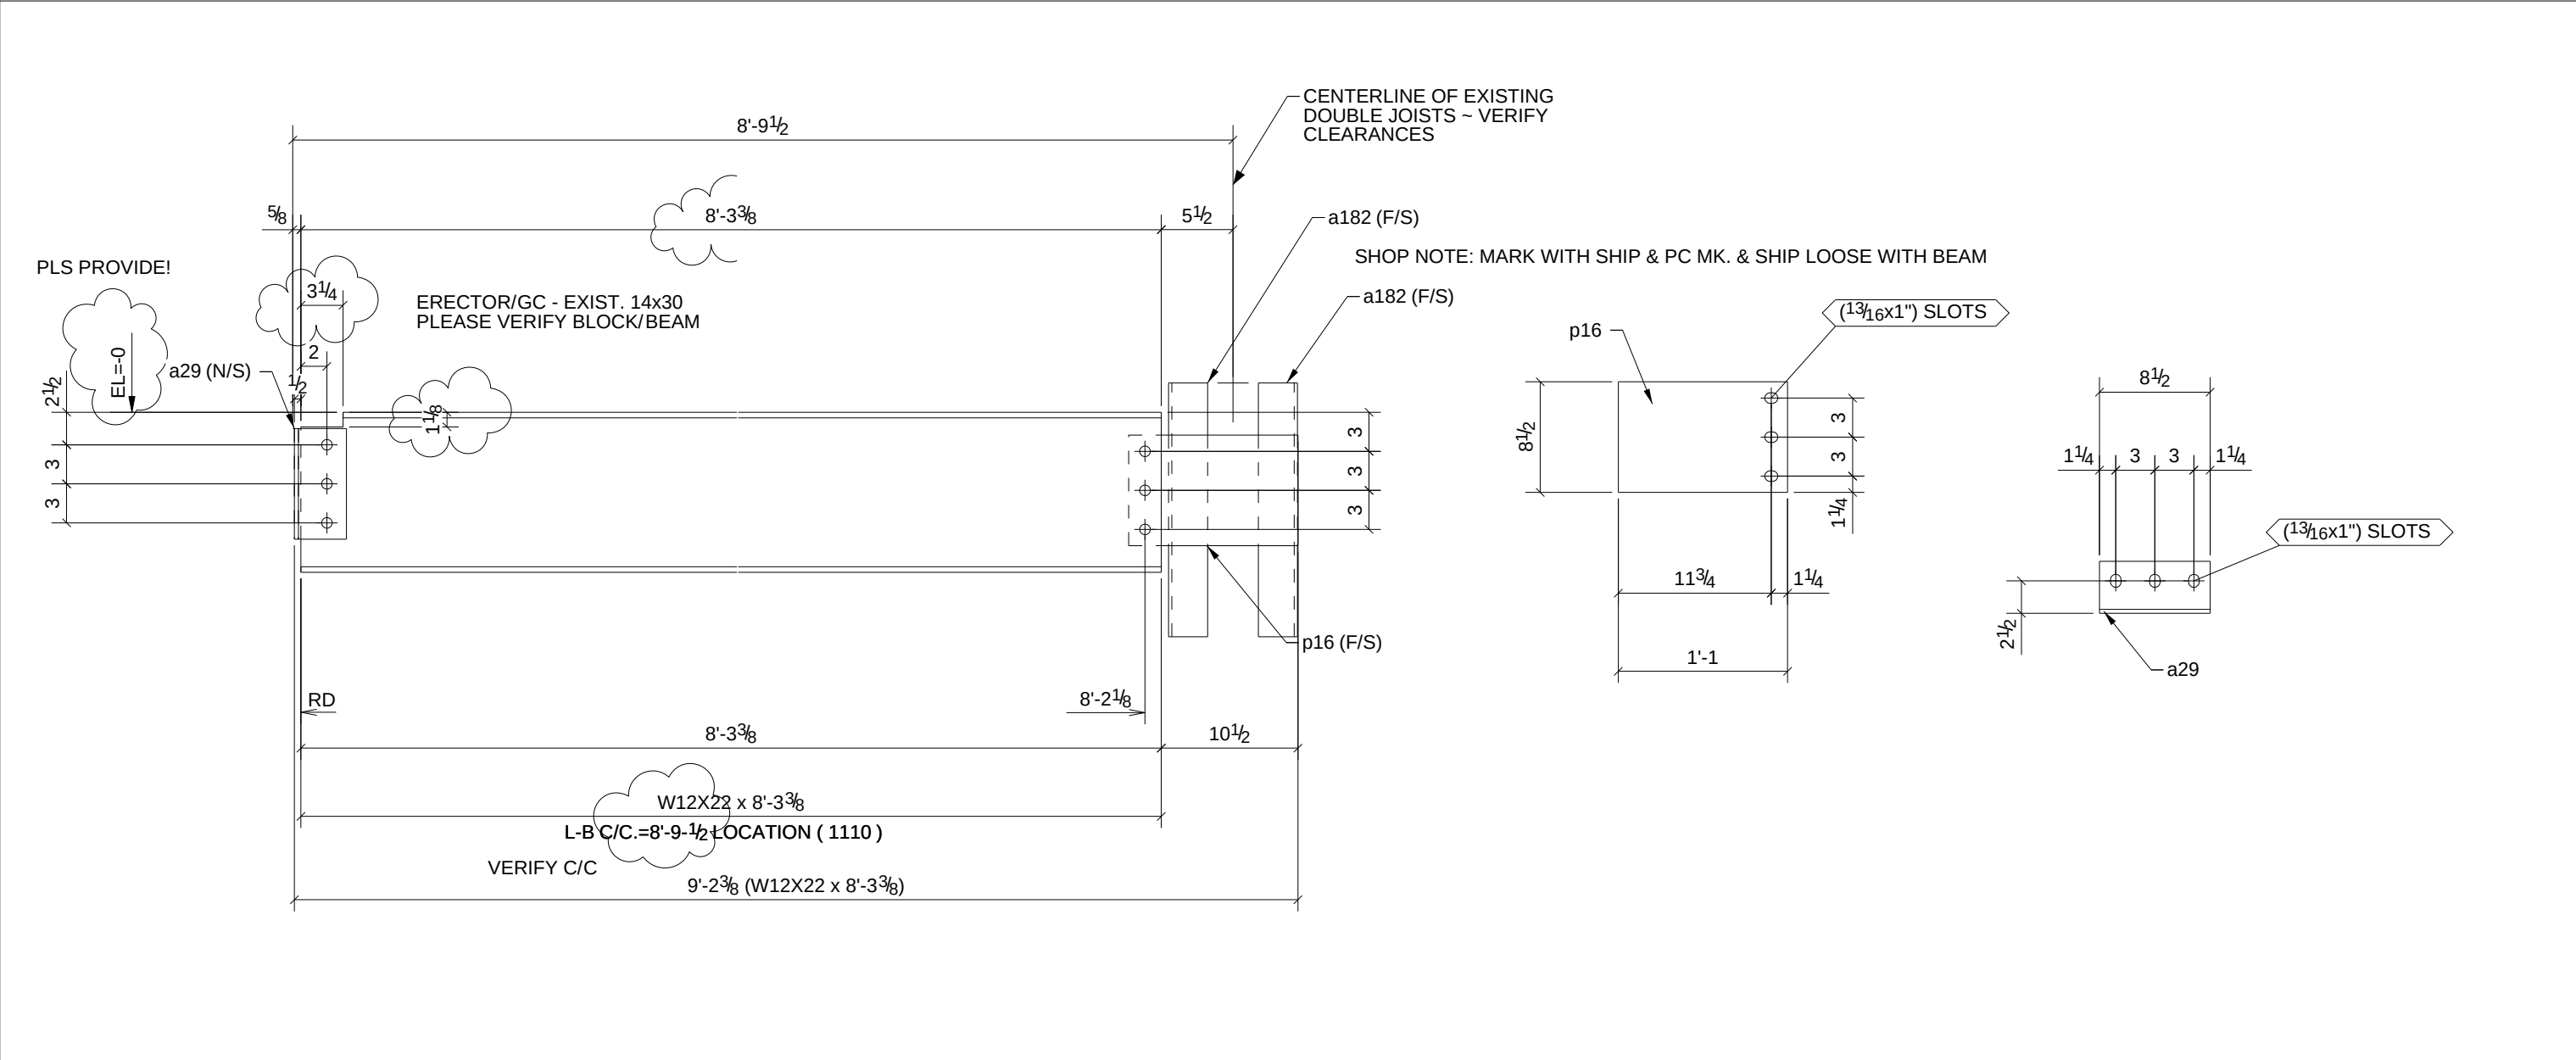

ONE - LINTEL - 52L5


PHASE				
1	2	3	4	5
1	0	0	0	0

W	12 5/16"x 1/4"
F	4"x 7/16"

BILL OF MATERIAL

SHIP	MARK	NO PCS	DESCRIPTION	LENGTH	PIECE MARK	REMARKS
1	52L5	1	W12X22	8'-3 3/8"		SQ-2 A992 -
		1	L4X3-1/2X5/16	0'-8 1/2"	a29	A36
		2	L3X3X1/4	1'-7 1/2"	a182	A36
		1	BAR3/8"X8 1/2"	1'-1"	p16	A36
		6	3/4"Ø A325N BOLT	0'-1 3/4"		

A	For Approval			7/20/10	TMc	TAN	
REV.	DESCRIPTION			DATE	DWN	CHK	
GENERAL NOTES				JOB USE			
				MATERIAL: A992 / A36	ELECTRODES: E70XX LH	REF. DRG.	SHOP
HOLES: 13/16 DIA. U/N	CONN'S.: -						
SURFACE PREP: SS-PC-SP-2 AND PAINT: GREY PRIMER DEVOE NA-195 (U.N.)				APPROVAL			
DESCRIPTION: LINTEL							
PROJECT NAME Hamilton High School Phase III LOCATION Hamilton City School District - Hamilton							
CONTRACTOR GC Contracting							
	Avenue Fabricating Inc. 1281 Clough Pike Batavia, OH 45103 (513) 752-1911			DRAWN BY TMc		DATE 07/20/2010	
				CHKD. BY TAN		DATE	
				JOB No. 10-16		DRG. No. 52L5	
						REV. 1	

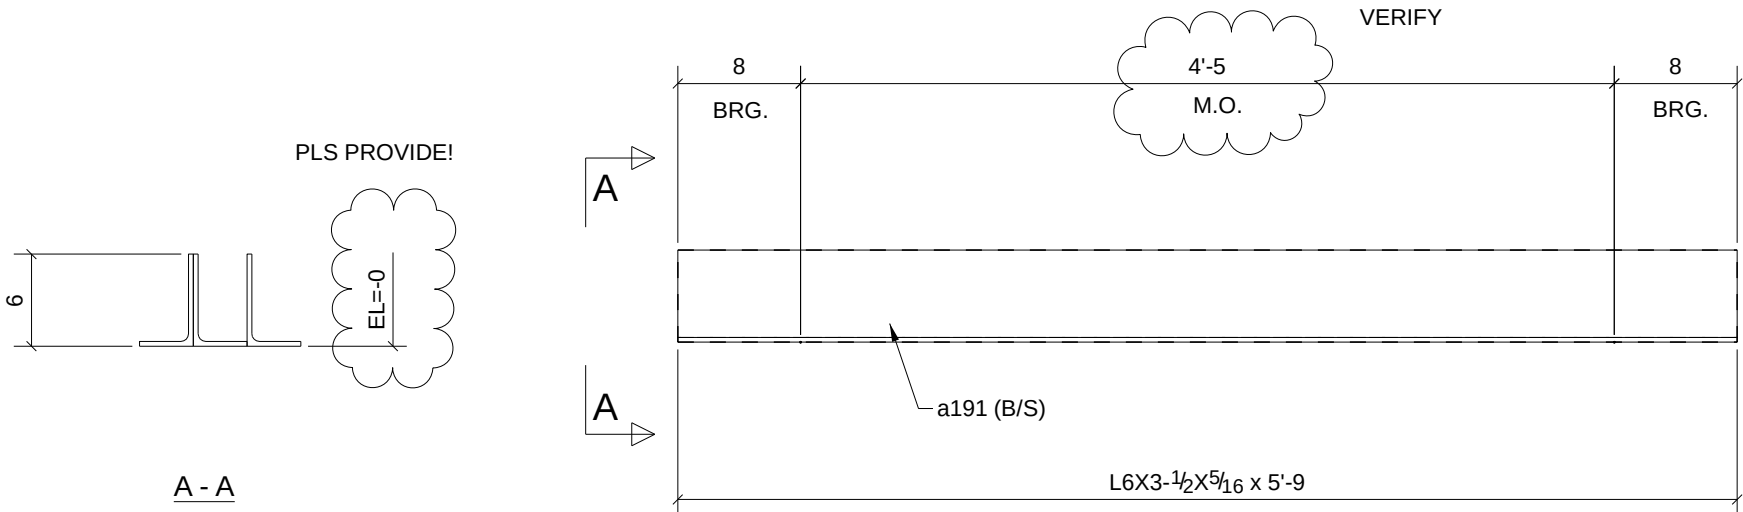

L-7 (M.O.=4'-5") LOCATION (2103) (2X)

ARCH./ENG/OWNER
PLEASE VERIFY / PROVIDE
TYPE & LOCATIONS
ERECTOR / GC ~ PLEASE
VERIFY / PROVIDE
M.O. @ EACH LOCATION

PHASE				
1	2	3	4	5
0	0	0	0	2

2 - LINTELS - 52L6

(3 ANGLES EACH LINTEL)


BILL OF MATERIAL

SHIP	MARK	NO PCS	DESCRIPTION	LENGTH	PIECE MARK	REMARKS
2	52L6	2	L6X3-1/2X5/16	5'-9"		SQ-2 A36 GALVANIZED
		4	L6X3-1/2X5/16	5'-9"	a191	A36 GALVANIZED

A	For Approval		7/23/10	TMc	TAN
REV.	DESCRIPTION		DATE	DWN	CHK
GENERAL NOTES			JOB USE		
			SHOP		
MATERIAL: A992 / A36		ELECTRODES: E70XX LH	REF. DRG.		
HOLES: 13/16 DIA. U/N		CONN'S.: -			
SURFACE PREP. SSPC-SP-2			APPROVAL		
AND PAINT: GREY PRIMER DEVOE NA-195 (U.N,)					
DESCRIPTION: LINTEL					
PROJECT NAME		Hamilton High School Phase III			
LOCATION		Hamilton City School District - Hamilton			
CONTRACTOR		GC Contracting			
	Avenue Fabricating Inc. 1281 Clough Pike Batavia, OH 45103 (513) 752-1911		DRAWN BY TMc		DATE 07/23/2010
			CHKD. BY TAN		DATE
			JOB No. 10-16		DRG. No. 52L6



A	For Approval	7/23/10	TMc	TAN
REV.	DESCRIPTION	DATE	DWN	CHK
GENERAL NOTES		JOB USE		
MATERIAL: A992 / A36	ELECTRODES: E70XX LH	SHOP		
HOLES: 13/16 DIA. U/N	CONN'S: -			
SURFACE PREP. SSPC-SP-2 AND PAINT: GREY PRIMER DEVOE NA-195 (U.N.)		APPROVAL		
DESCRIPTION:	LINTEL			
PROJECT NAME LOCATION	Hamilton High School Phase III Hamilton City School District - Hamilton			
CONTRACTOR	GC Contracting			
	Avenue Fabricating Inc. 1281 Clough Pike Batavia, OH 45103 (513) 752-1911	DRAWN BY TMC	DATE 07/23/2010	
		CHKD. BY TAN	DATE	
		JOB No. 10-16	DRG. No. 52L7	REV. 1

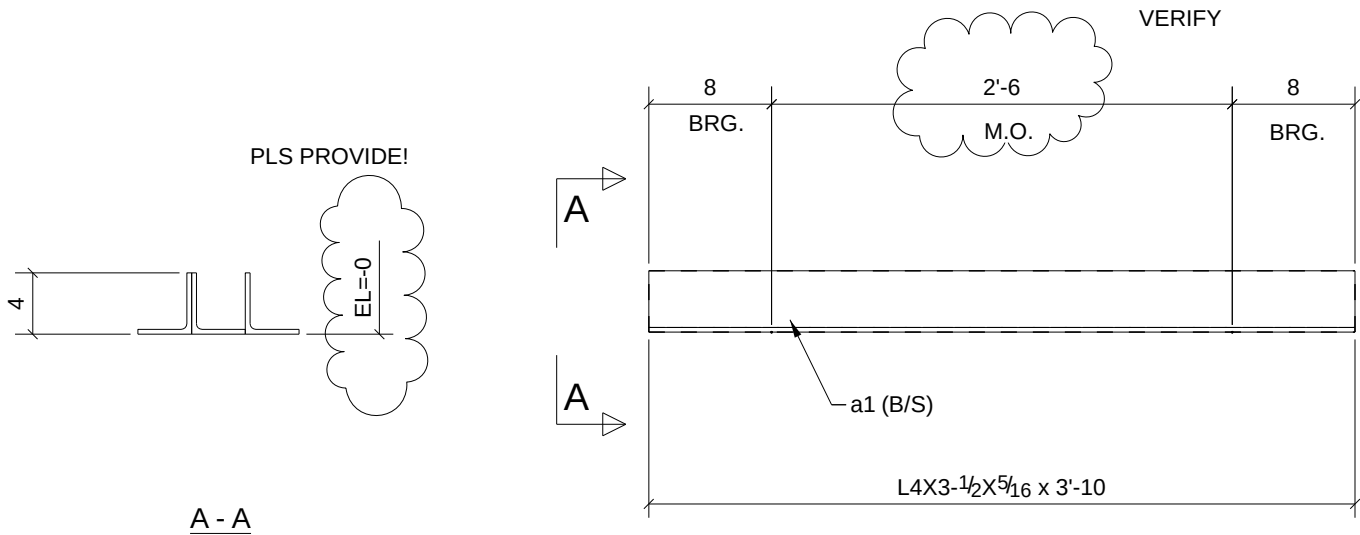

L-3 (M.O.=2'-6") LOCATION (2106)

ARCH./ENG/OWNER
PLEASE VERIFY / PROVIDE
TYPE & LOCATIONS
ERECTOR / GC ~ PLEASE
VERIFY / PROVIDE
M.O. @ EACH LOCATION

PHASE				
1	2	3	4	5
0	0	0	0	1


ONE - LINTEL - 52L8

(3 ANGLES EACH LINTEL)

BILL OF MATERIAL

SHIP	MARK	NO PCS	DESCRIPTION	LENGTH	PIECE MARK	REMARKS
1	52L8	1	L4X3-1/2X5/16	3'-10"		SQ-2 A36 GALVANIZED
		2	L4X3-1/2X5/16	3'-10"	a1	A36 GALVANIZED


A	For Approval		7/23/10	TMc	TAN
REV.	DESCRIPTION		DATE	DWN	CHK
GENERAL NOTES			JOB USE		
MATERIAL: A992 / A36		ELECTRODES: E70XX LH	REF. DRG.		
HOLES: 13/16 DIA. U/N		CONN'S.: -		SHOP	
SURFACE PREP. SS-PC-SP-2			APPROVAL		
AND PAINT: GREY PRIMER DEVOE NA-195 (U.N,)					
DESCRIPTION: LINTEL					
PROJECT NAME		Hamilton High School Phase III			
LOCATION		Hamilton City School District - Hamilton			
CONTRACTOR		GC Contracting			
	Avenue Fabricating Inc. 1281 Clough Pike Batavia, OH 45103 (513) 752-1911		DRAWN BY TMc		DATE 07/26/2010
			CHKD. BY TAN		DATE
			JOB No. 10-16	DRG. No. 52L8	REV. 1

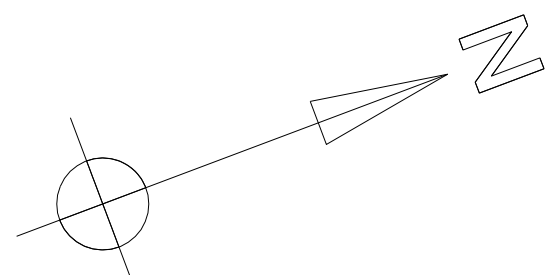


This project shall be erected in accordance with Section 7 of the AGC Code of Standard Practice, which includes 7.14 Correction of Errors, that states the following:

The corrections of minor mistakes by moderate reaming, grinding, welding or cutting, and the correction of elements of construction that are considered to be normal construction errors that cannot be corrected using the foregoing means, or that require major changes in member or connection configuration, shall be promptly reported to the owner's representatives for design and construction, and the fabricator by the erector, to enable the responsible party to either correct the error or approve the most efficient and economical method of correction to be used by others.


All field welds to be made with E70XX low hydrogen electrodes.

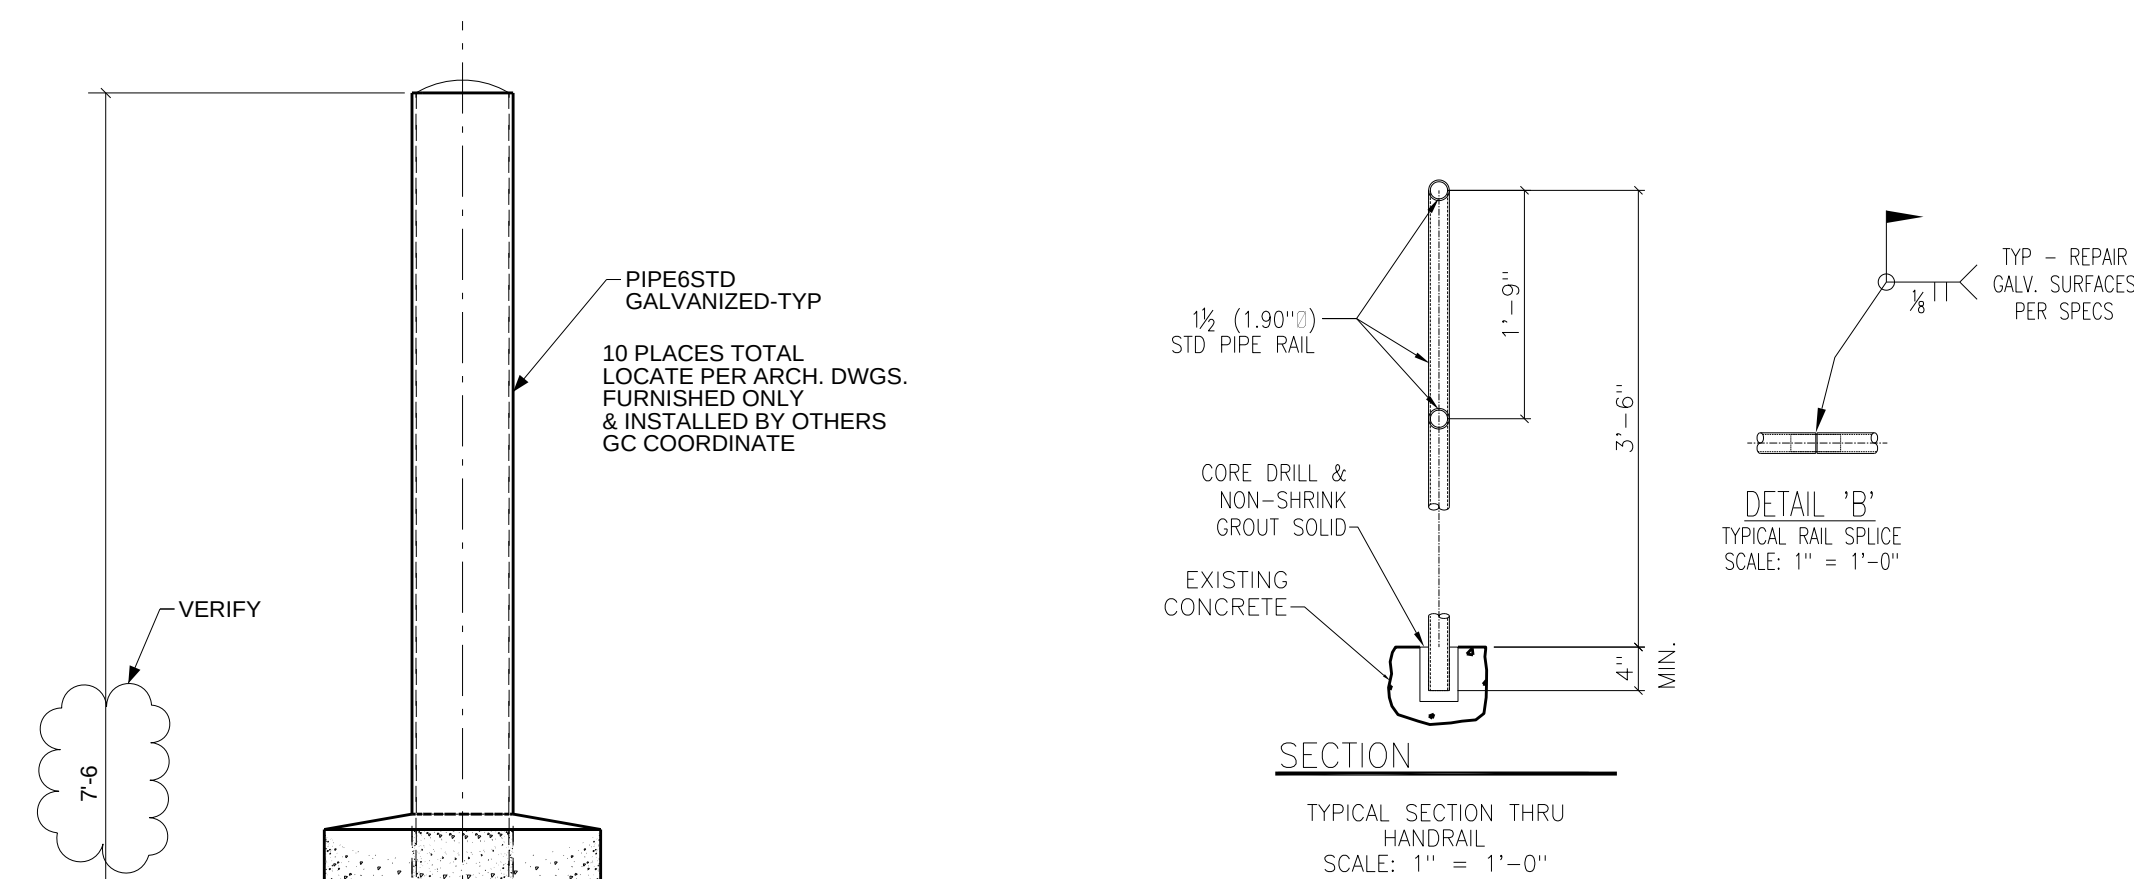

A		For Approval & Field Survey		10/4/10		TMC		TAN	
REV.		DESCRIPTION		DATE		DWN		CHK	
GENERAL NOTES						JOB USE			
MATERIAL: A992 / A36 UN		ELECTRODES: E70XX LH		REF. DRG.					
HOLES: 13/16 DIA UN		CONNS: -				SHOP			
SURFACE PREP: AND PAINT:						APPROVAL			
SSPC-SP-2									
GREY PRIMER DEVOE NA-195 (U.N.)									
DESCRIPTION: RAILS @ EXISTING CONCRETE RAMPS									
PROJ. NAME		Hamilton High School Phase III							
LOCATION		Hamilton City School District - Hamilton, OH							
CONTRACTOR GC Contracting				ARCH./ENG. SHP					
		Avenue Fabricating Inc. 1281 Clough Pike Batavia, OH 45103 (513) 752-1911							
						DRAWN BY TMC DATE 10/01/2010 CHKD. BY TAN DATE 10-16-10 Dwg. No. E-100 REV. A			

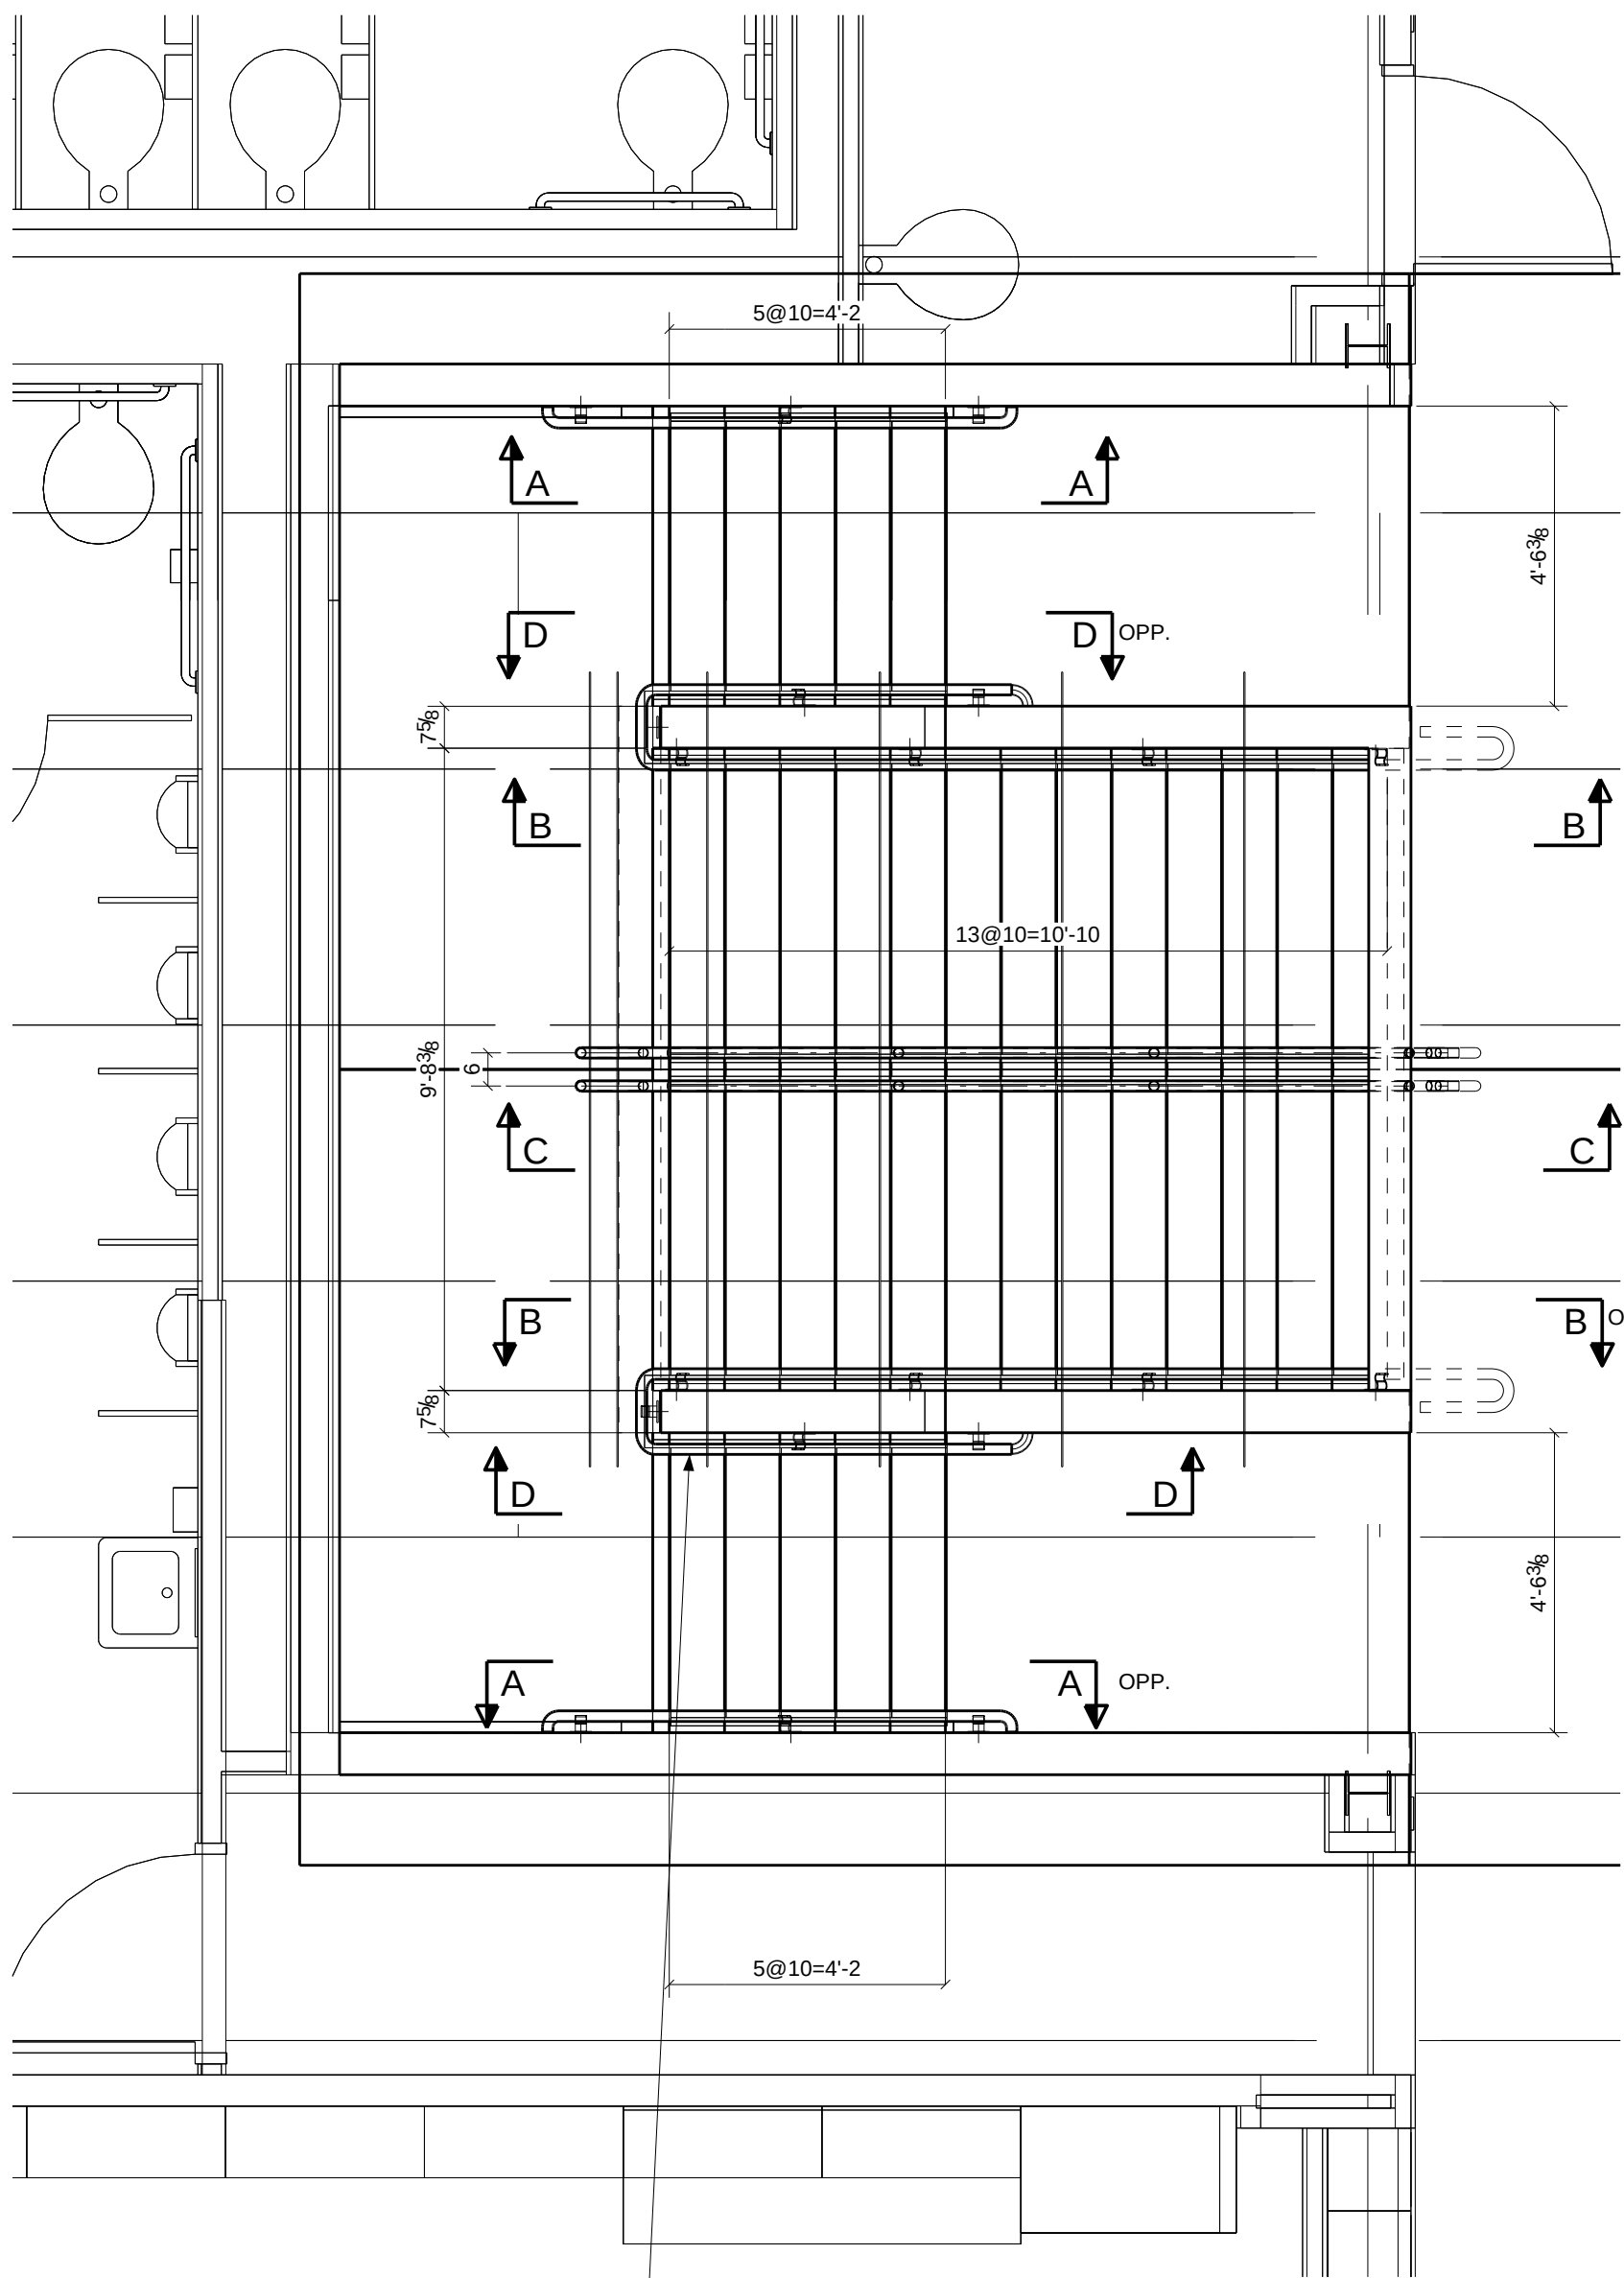


STAIR S2 - CLASSROOMS EAST WING

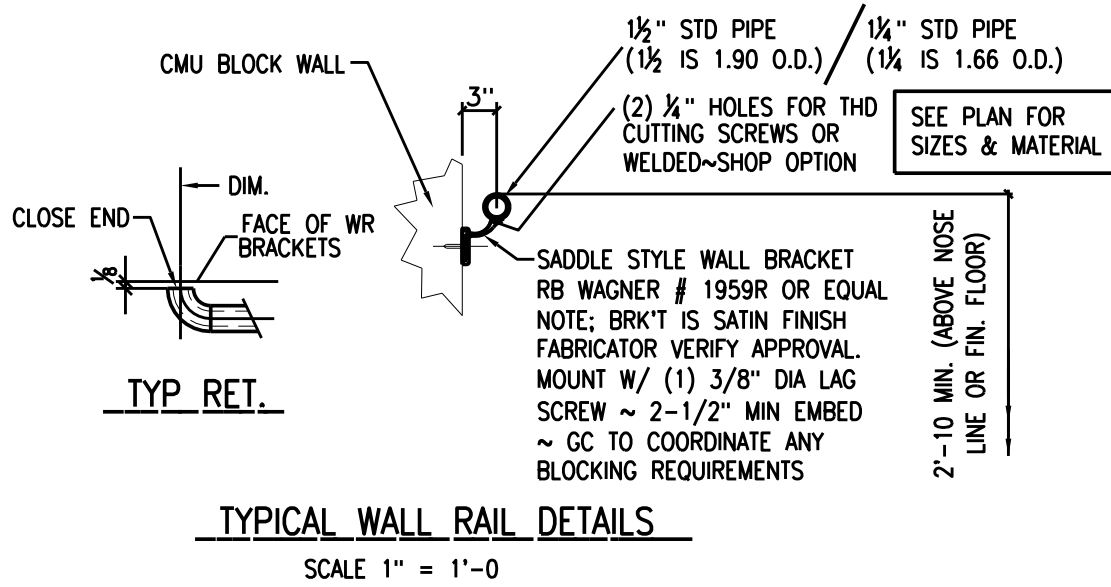


TYPICAL WALL RAIL DETAILS
SCALE 1" = 1'-0"


FABRICATOR SHOULD CHECK ALL EXISTING STAIRS & WALLS AND FIELD VERIFY MEASUREMENTS AND MARK UP RETURNED SUBMITTALS TO DETAILER BEFORE RELEASING FOR FABRICATION.

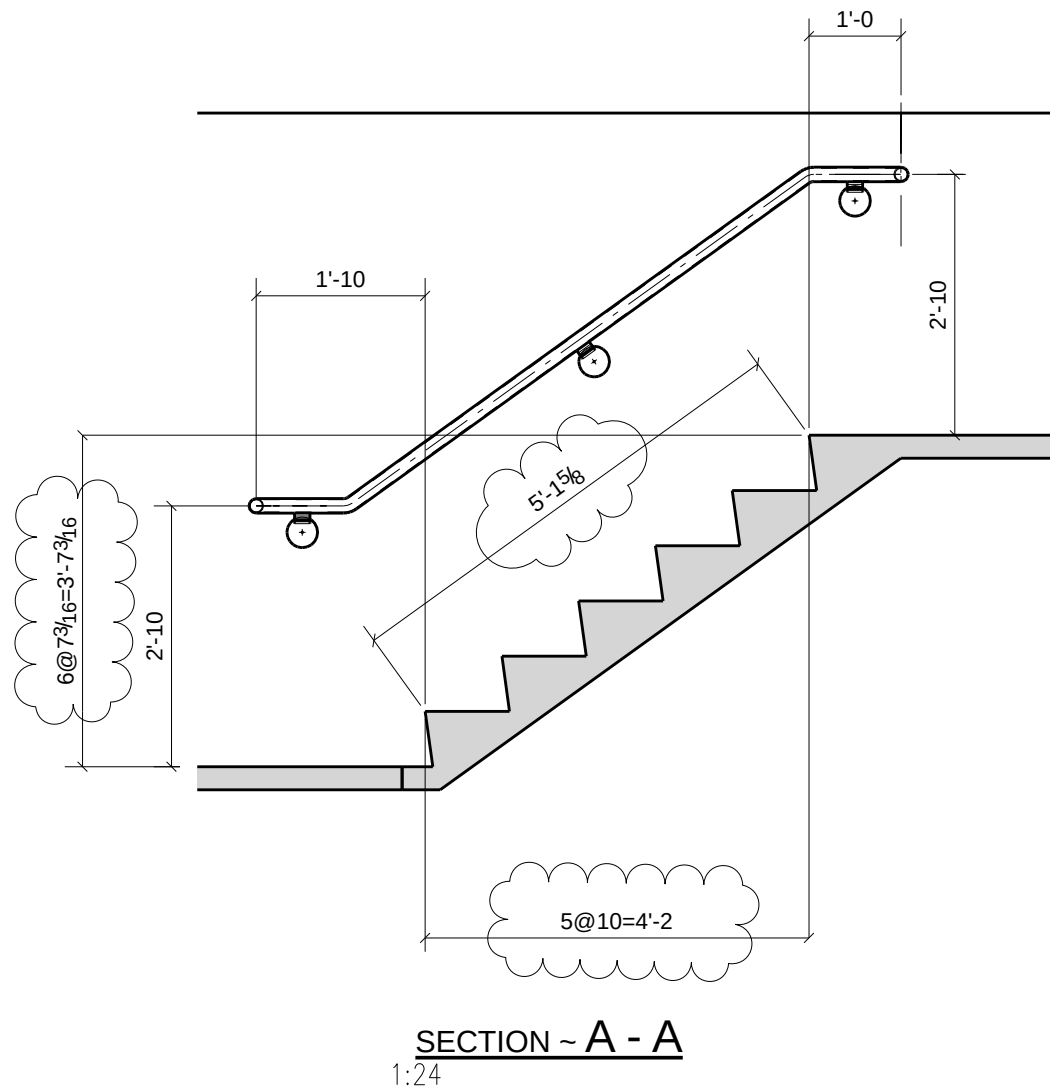


SECTION - A - A
1:24

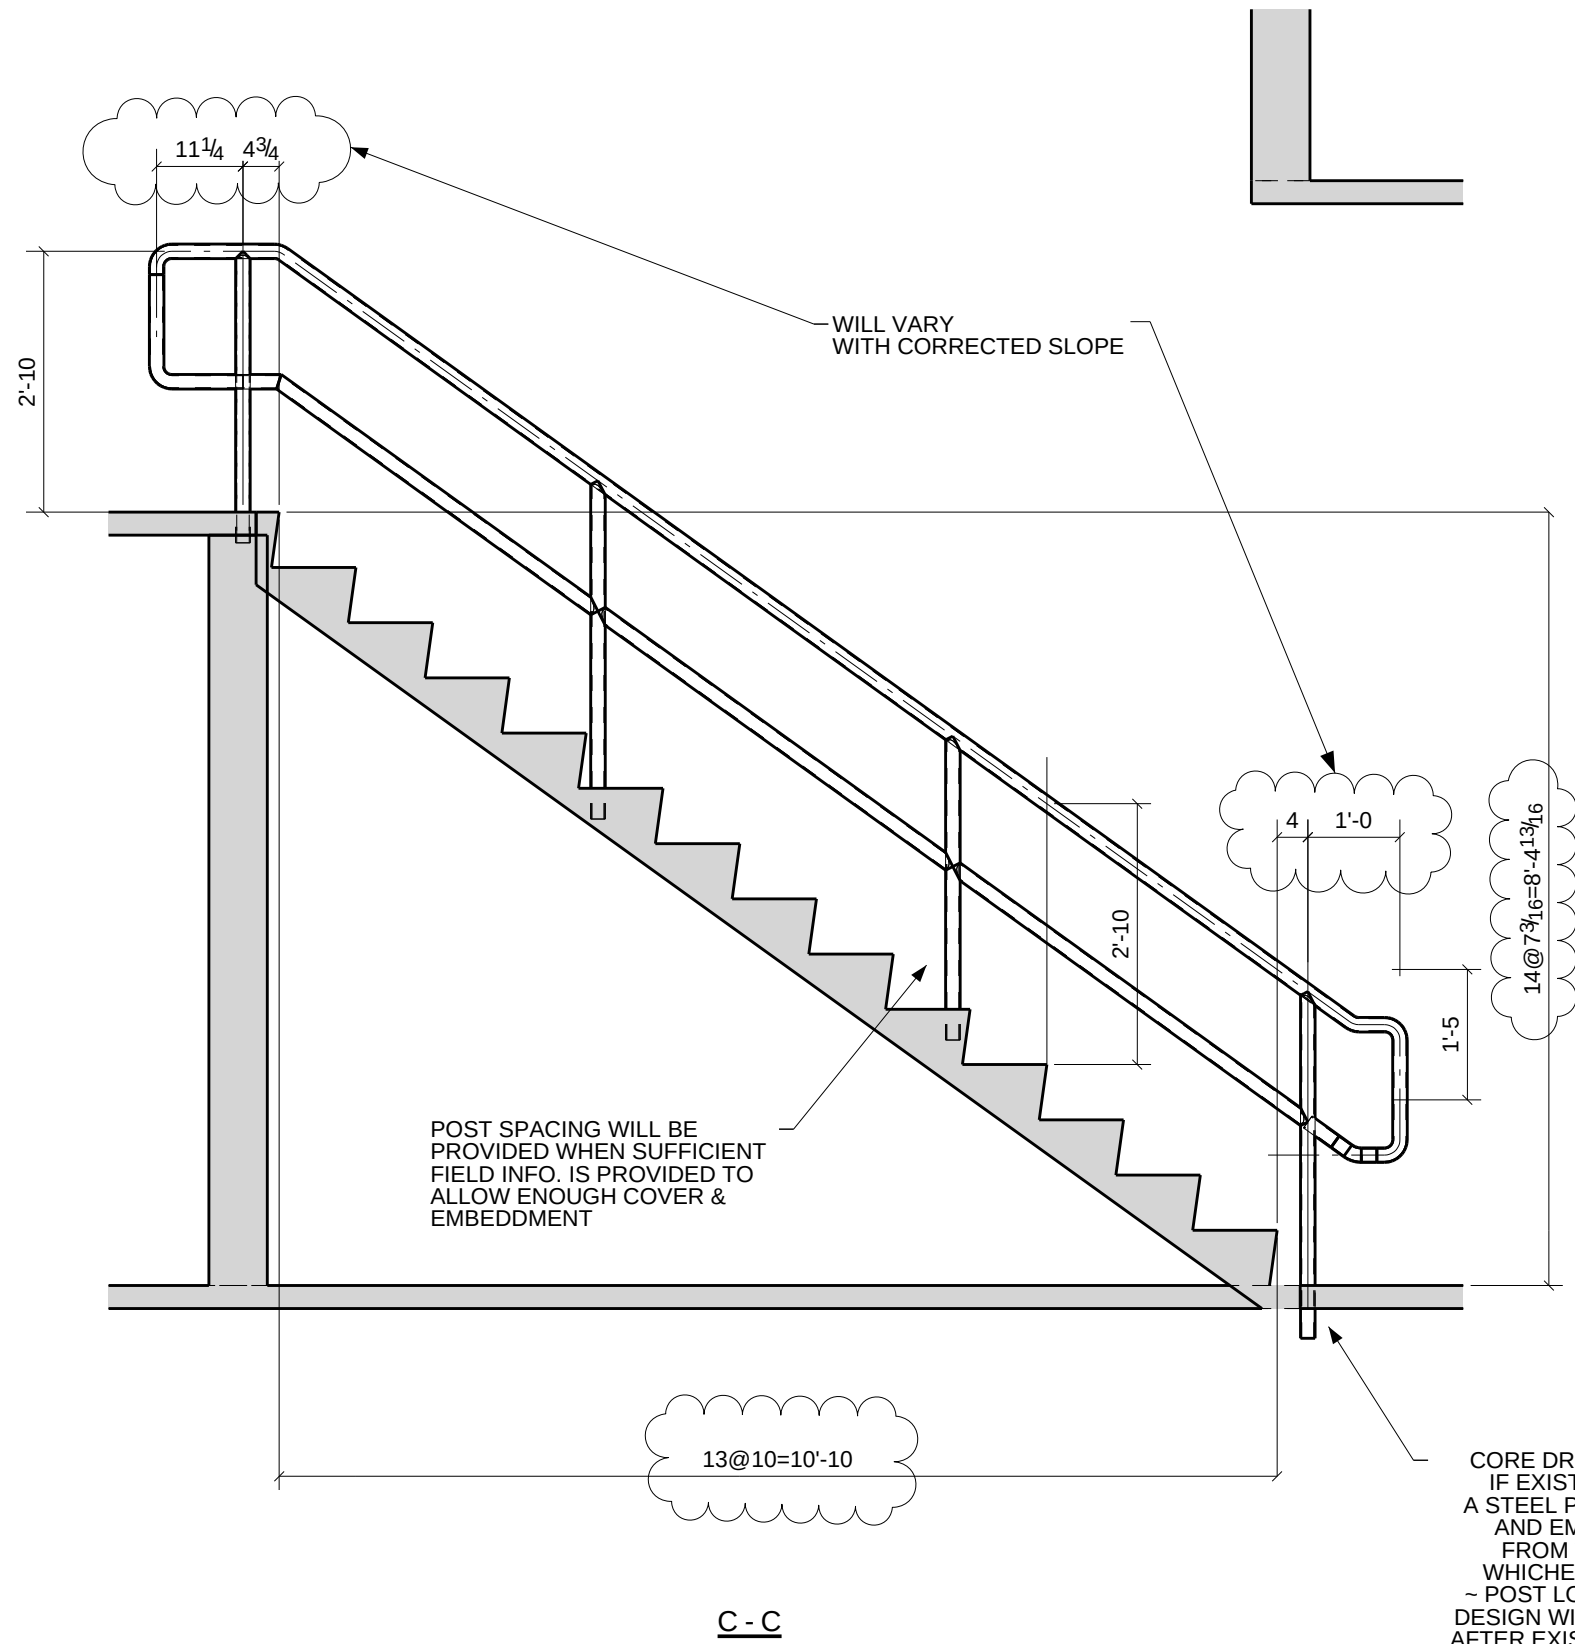

C - C

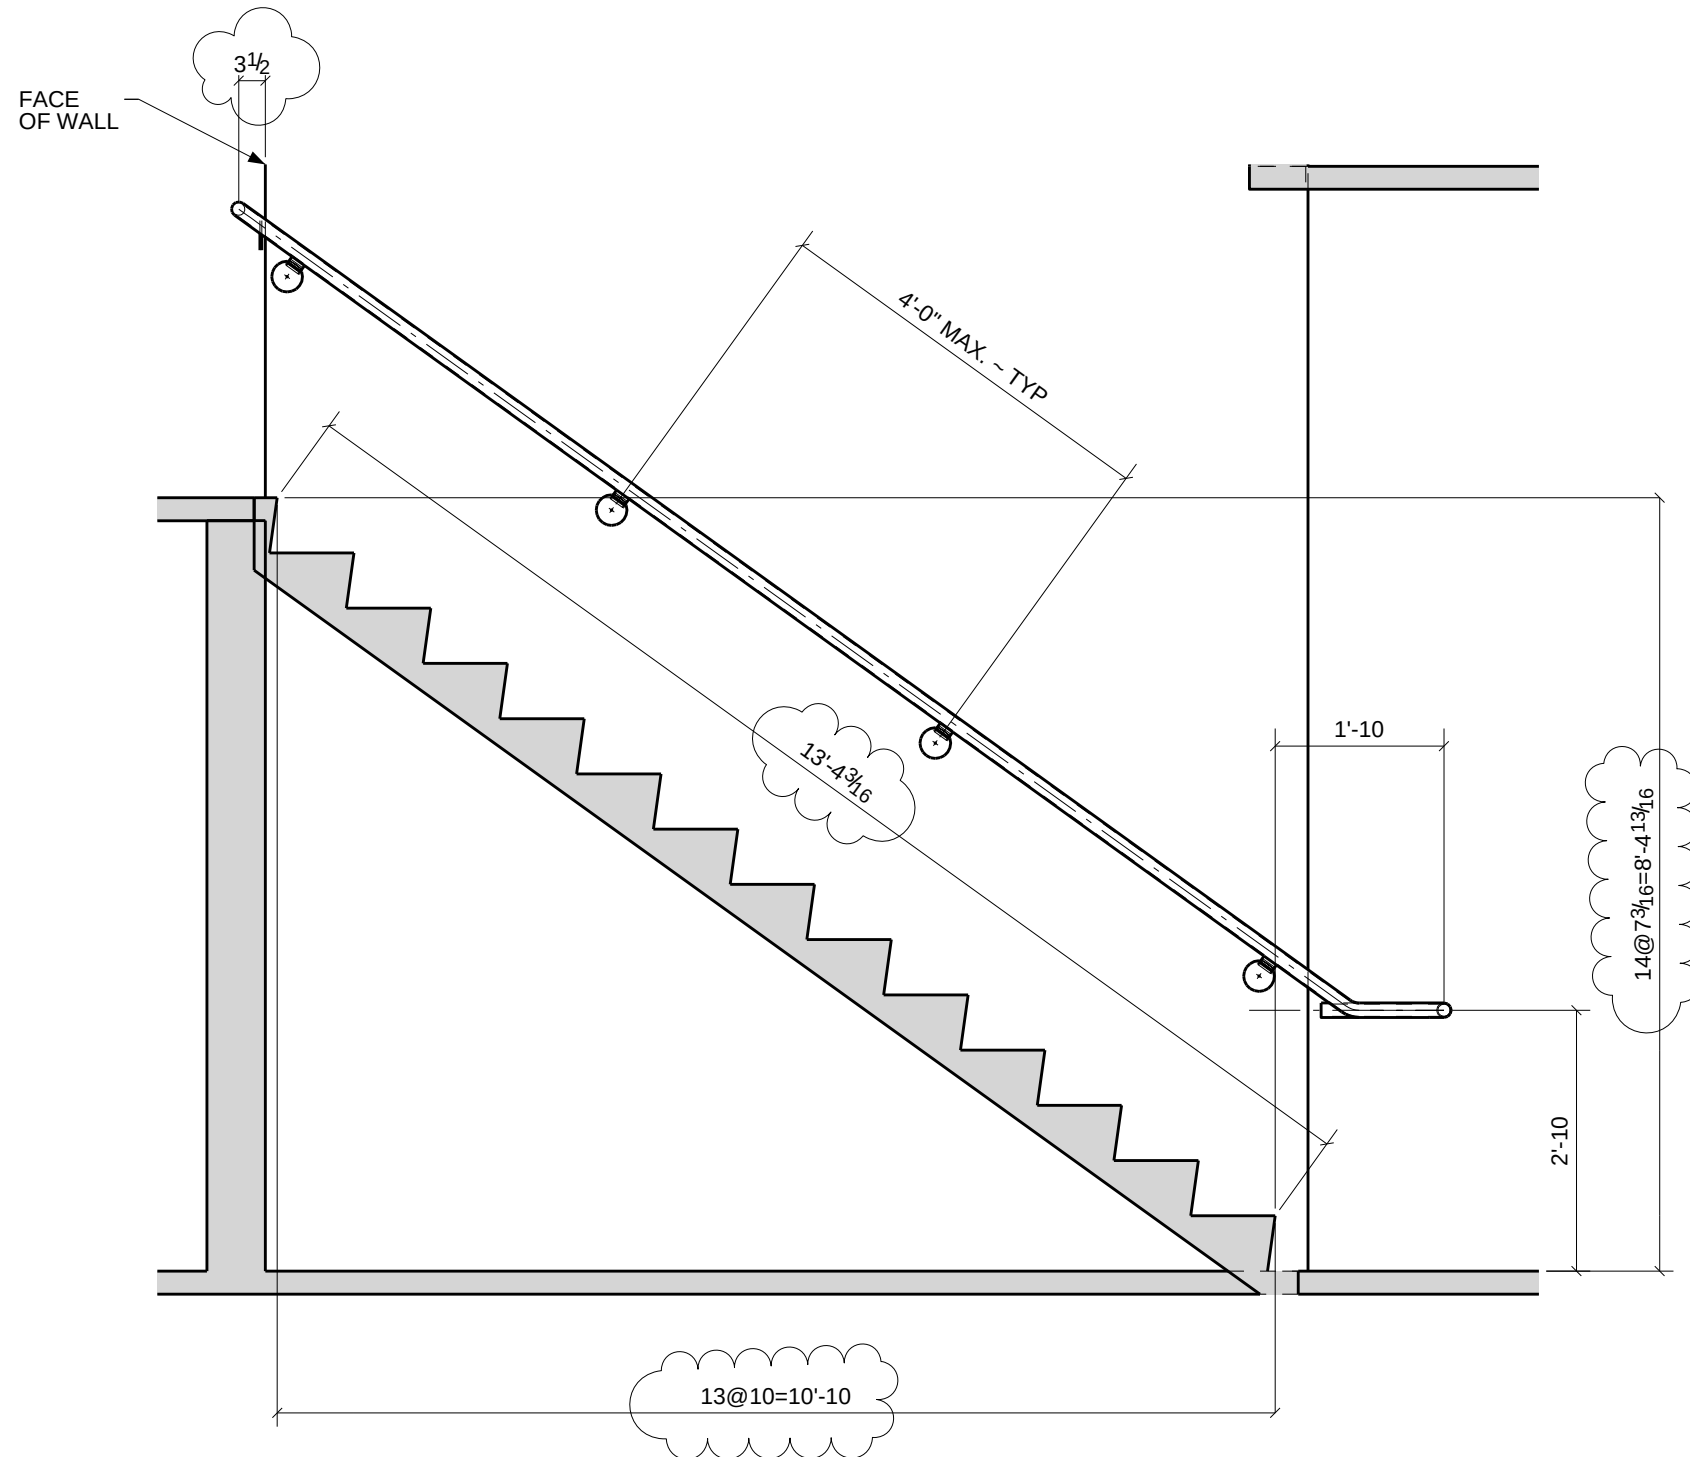

SECTION - B - B
1:24

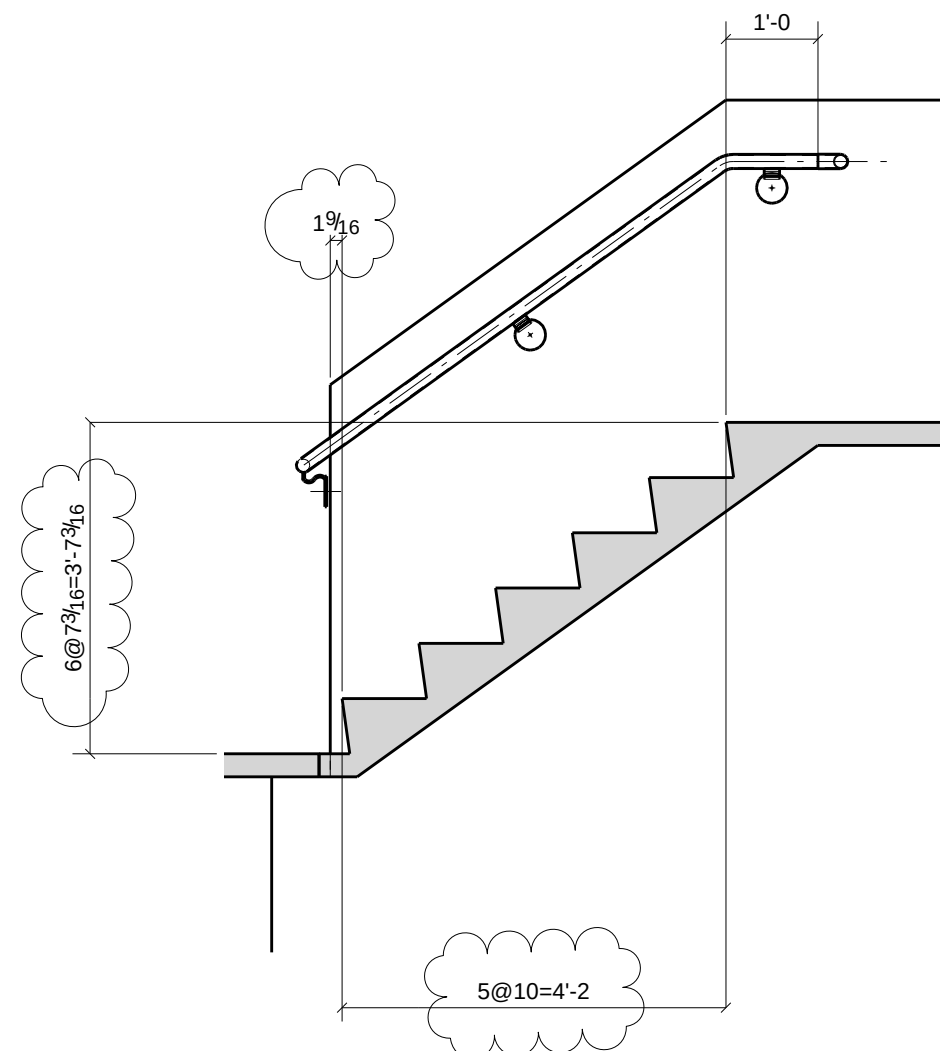


D - D




DRAWINGS PREPARED BY DETAILER FROM INFORMATION CONTAINED IN THE PROJECT DOCUMENTS WITH INSTRUCTIONS FROM THE FABRICATOR. DETAILER IS NOT RESPONSIBLE FOR ANY DESIGN, ENGINEERING OR CODE ISSUES WHICH MAY ARISE FROM THE USE OF THESE DRAWINGS. APPROVALS SHOULD BE OBTAINED FROM THE OWNER, ARCHITECT, ENGINEER, CONTRACTOR, WHICH EVER IS APPLICABLE. THE FABRICATOR SHOULD CHECK THE DETAIL DOCUMENTS FOR CORRECTNESS BEFORE RELEASING FOR FABRICATION. THE USE OF THE DETAILED DRAWINGS FOR FABRICATION CONSTITUTES ACCEPTANCE AND APPROVAL OF THE DRAWINGS, MATERIAL LIST OR CUT LIST, WHICH EVER APPLIES.

This project shall be executed in accordance with Section 7 of the AISC Code of Standard Practice, which includes 7.14 Correction of Errors, that states the following:
The correction of minor errors by moderate reworking, grinding, welding or cutting, and the changing of elements into the work with care, and the correction to be made in the most efficient and economical method of correction to be used by others.
All field work to be made with E70XX low hydrogen electrodes.

A	For Approval & Field Survey	10/4/10	TMc	TAN
REV.	DESCRIPTION	DATE	DWN	CHK
GENERAL NOTES				
MATERIAL: A992 / A36 UN		ELECTRODES: E70XX LH	REF. DRG.	JOB USE
HOLES: 13/16 DIA. UN		CONNS: -		SHOP
SURFACE PREP. AND PAINT:				APPROVAL
SSPC-SP-2				
GREY PRIMER DEVOE NA-195 (U.N.)				
DESCRIPTION: RAILS @ EXISTING STAIR S2				
PROJ. NAME		Hamilton High School Phase III		DRAWN BY TMc
LOCATION		Hamilton City School District - Hamilton, OH		DATE 10/04/2010
CONTRACTOR GC Contracting		ARCH./ENG. SHP		CHKD. BY TAN
		Avenue Fabricating Inc.		DATE
		1281 Clough Pike		JOB No. 10-16
		Batavia, OH 45103		DRG. No. E102
		(513) 752-1911		REV. A

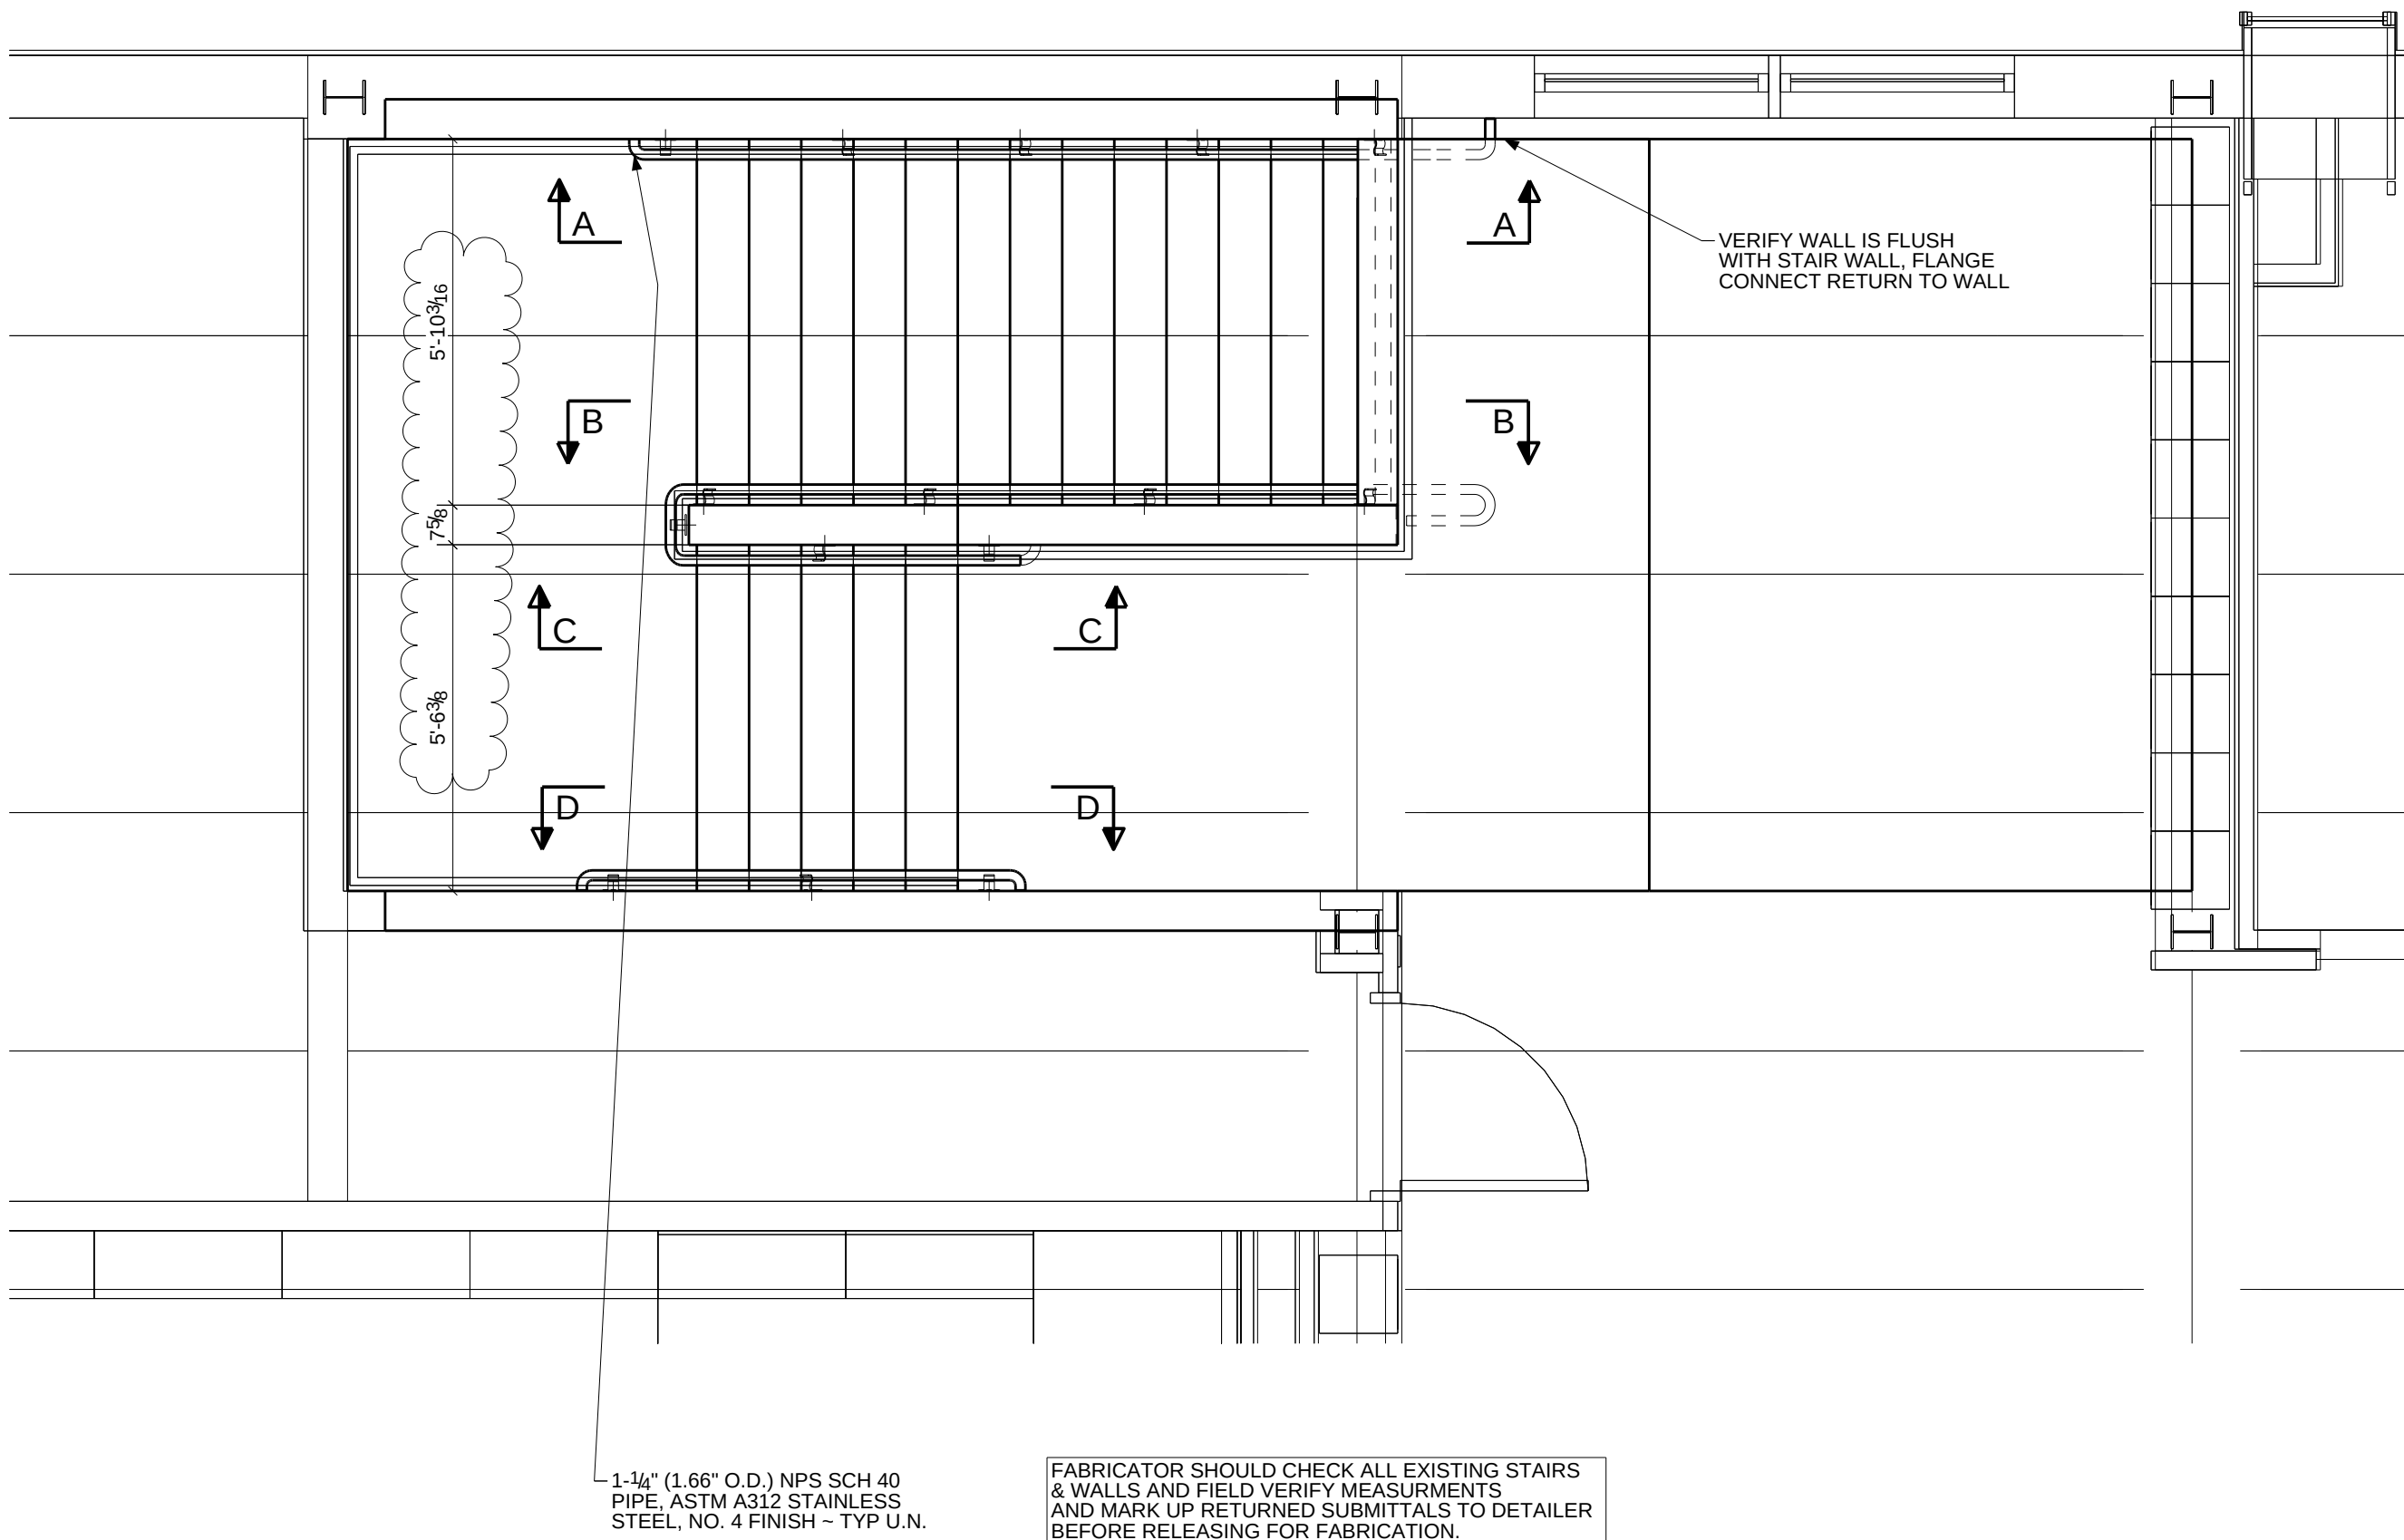


STAIR S3 - CLASSROOMS EAST WING
1:32

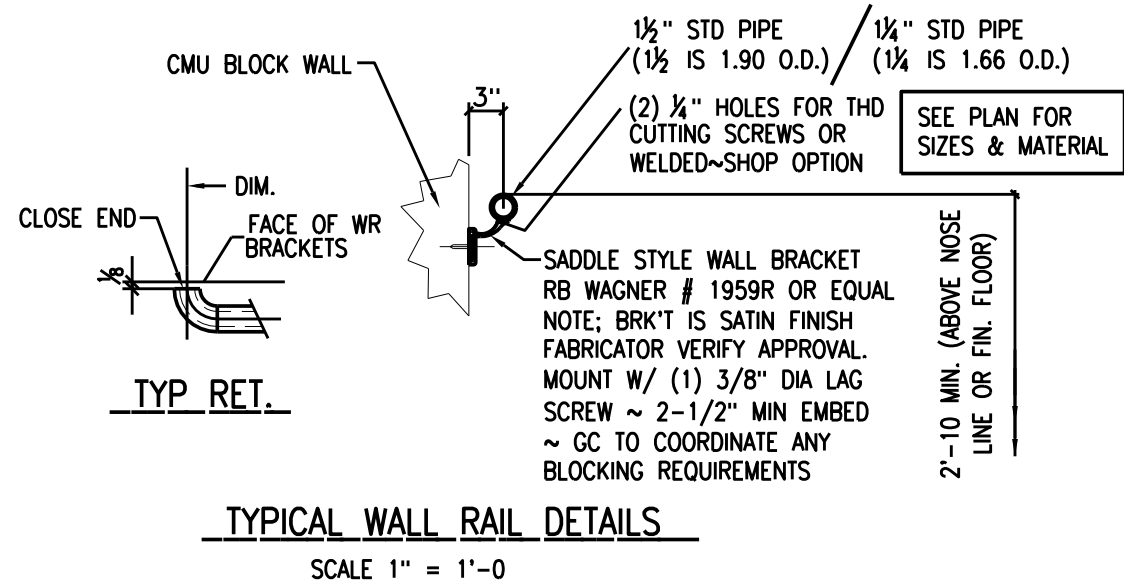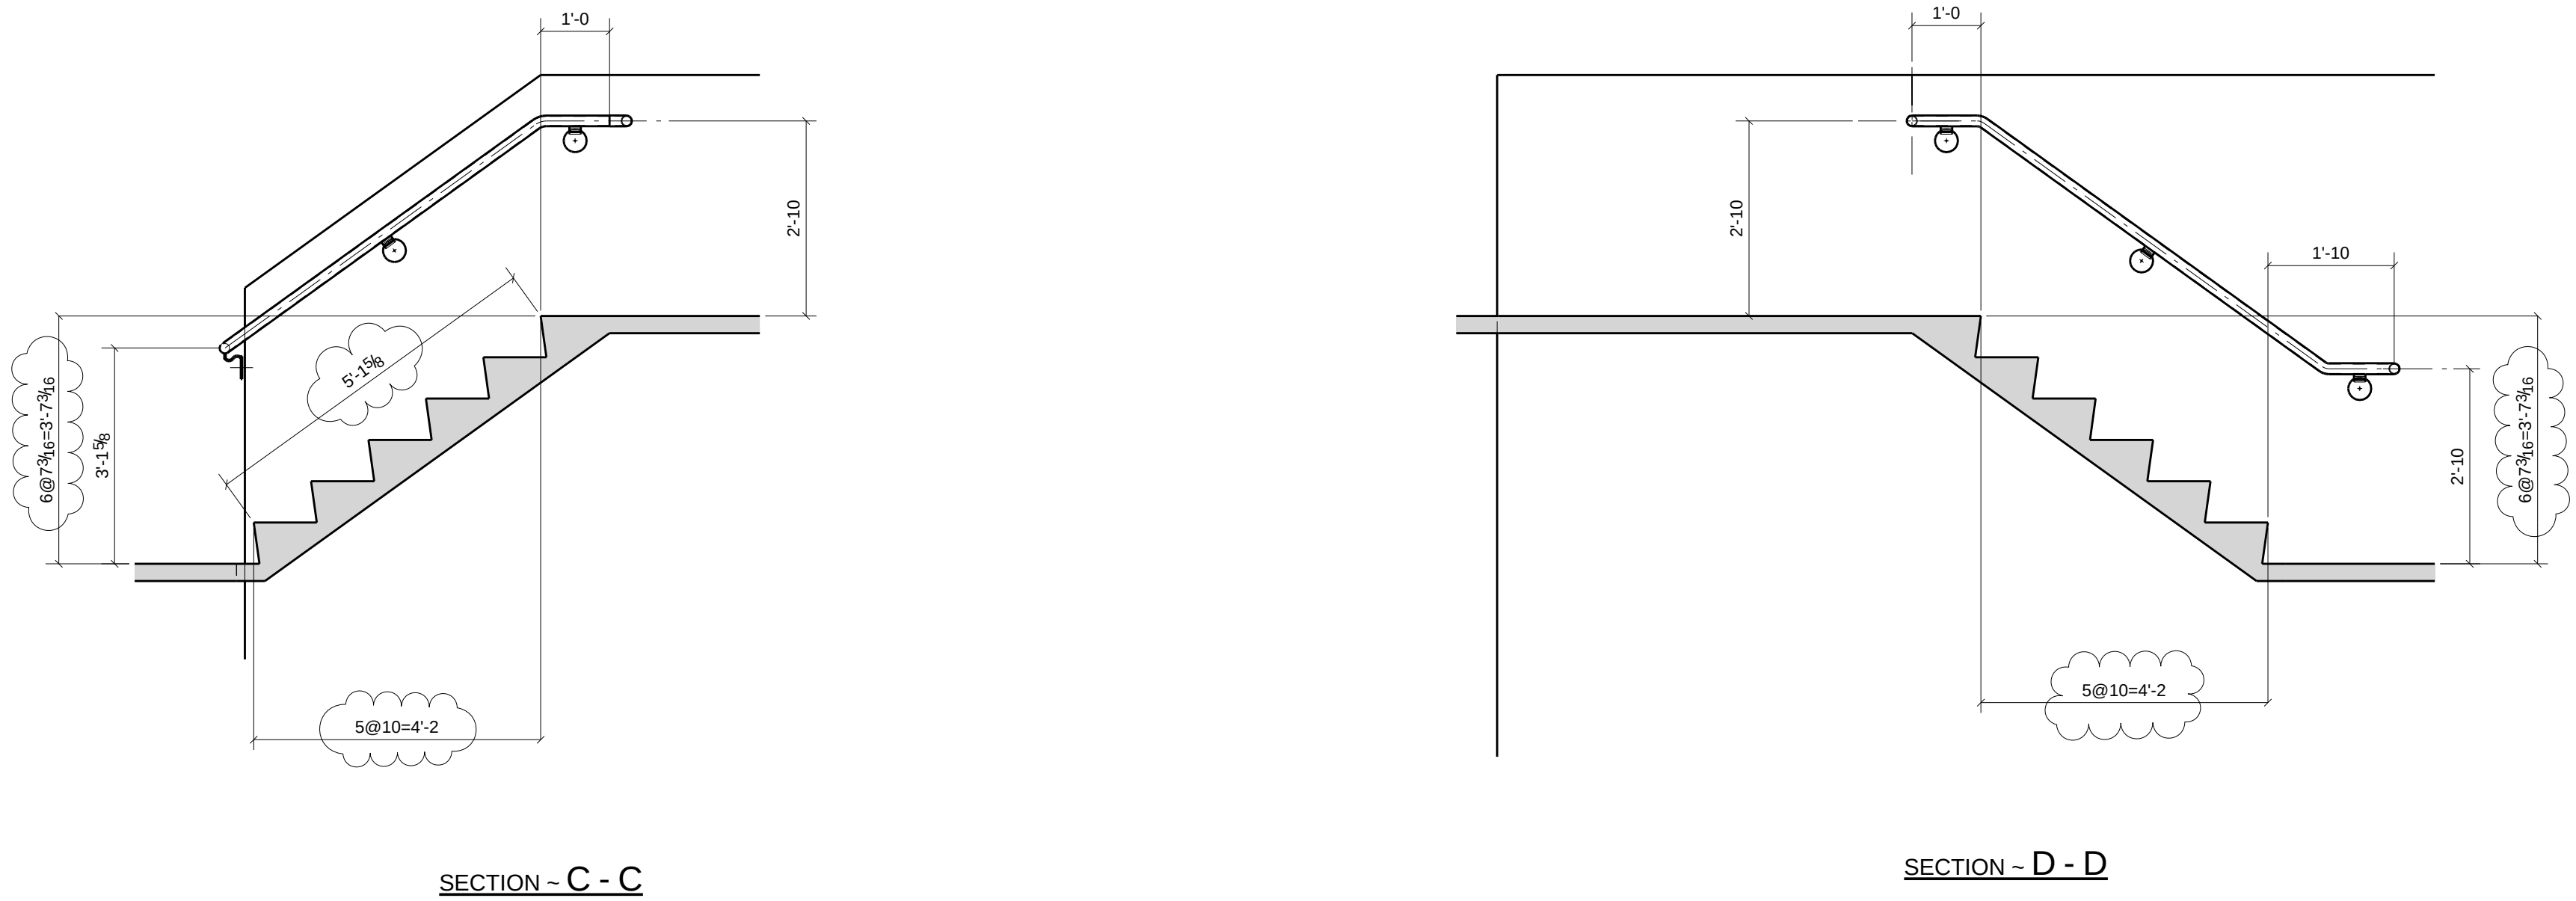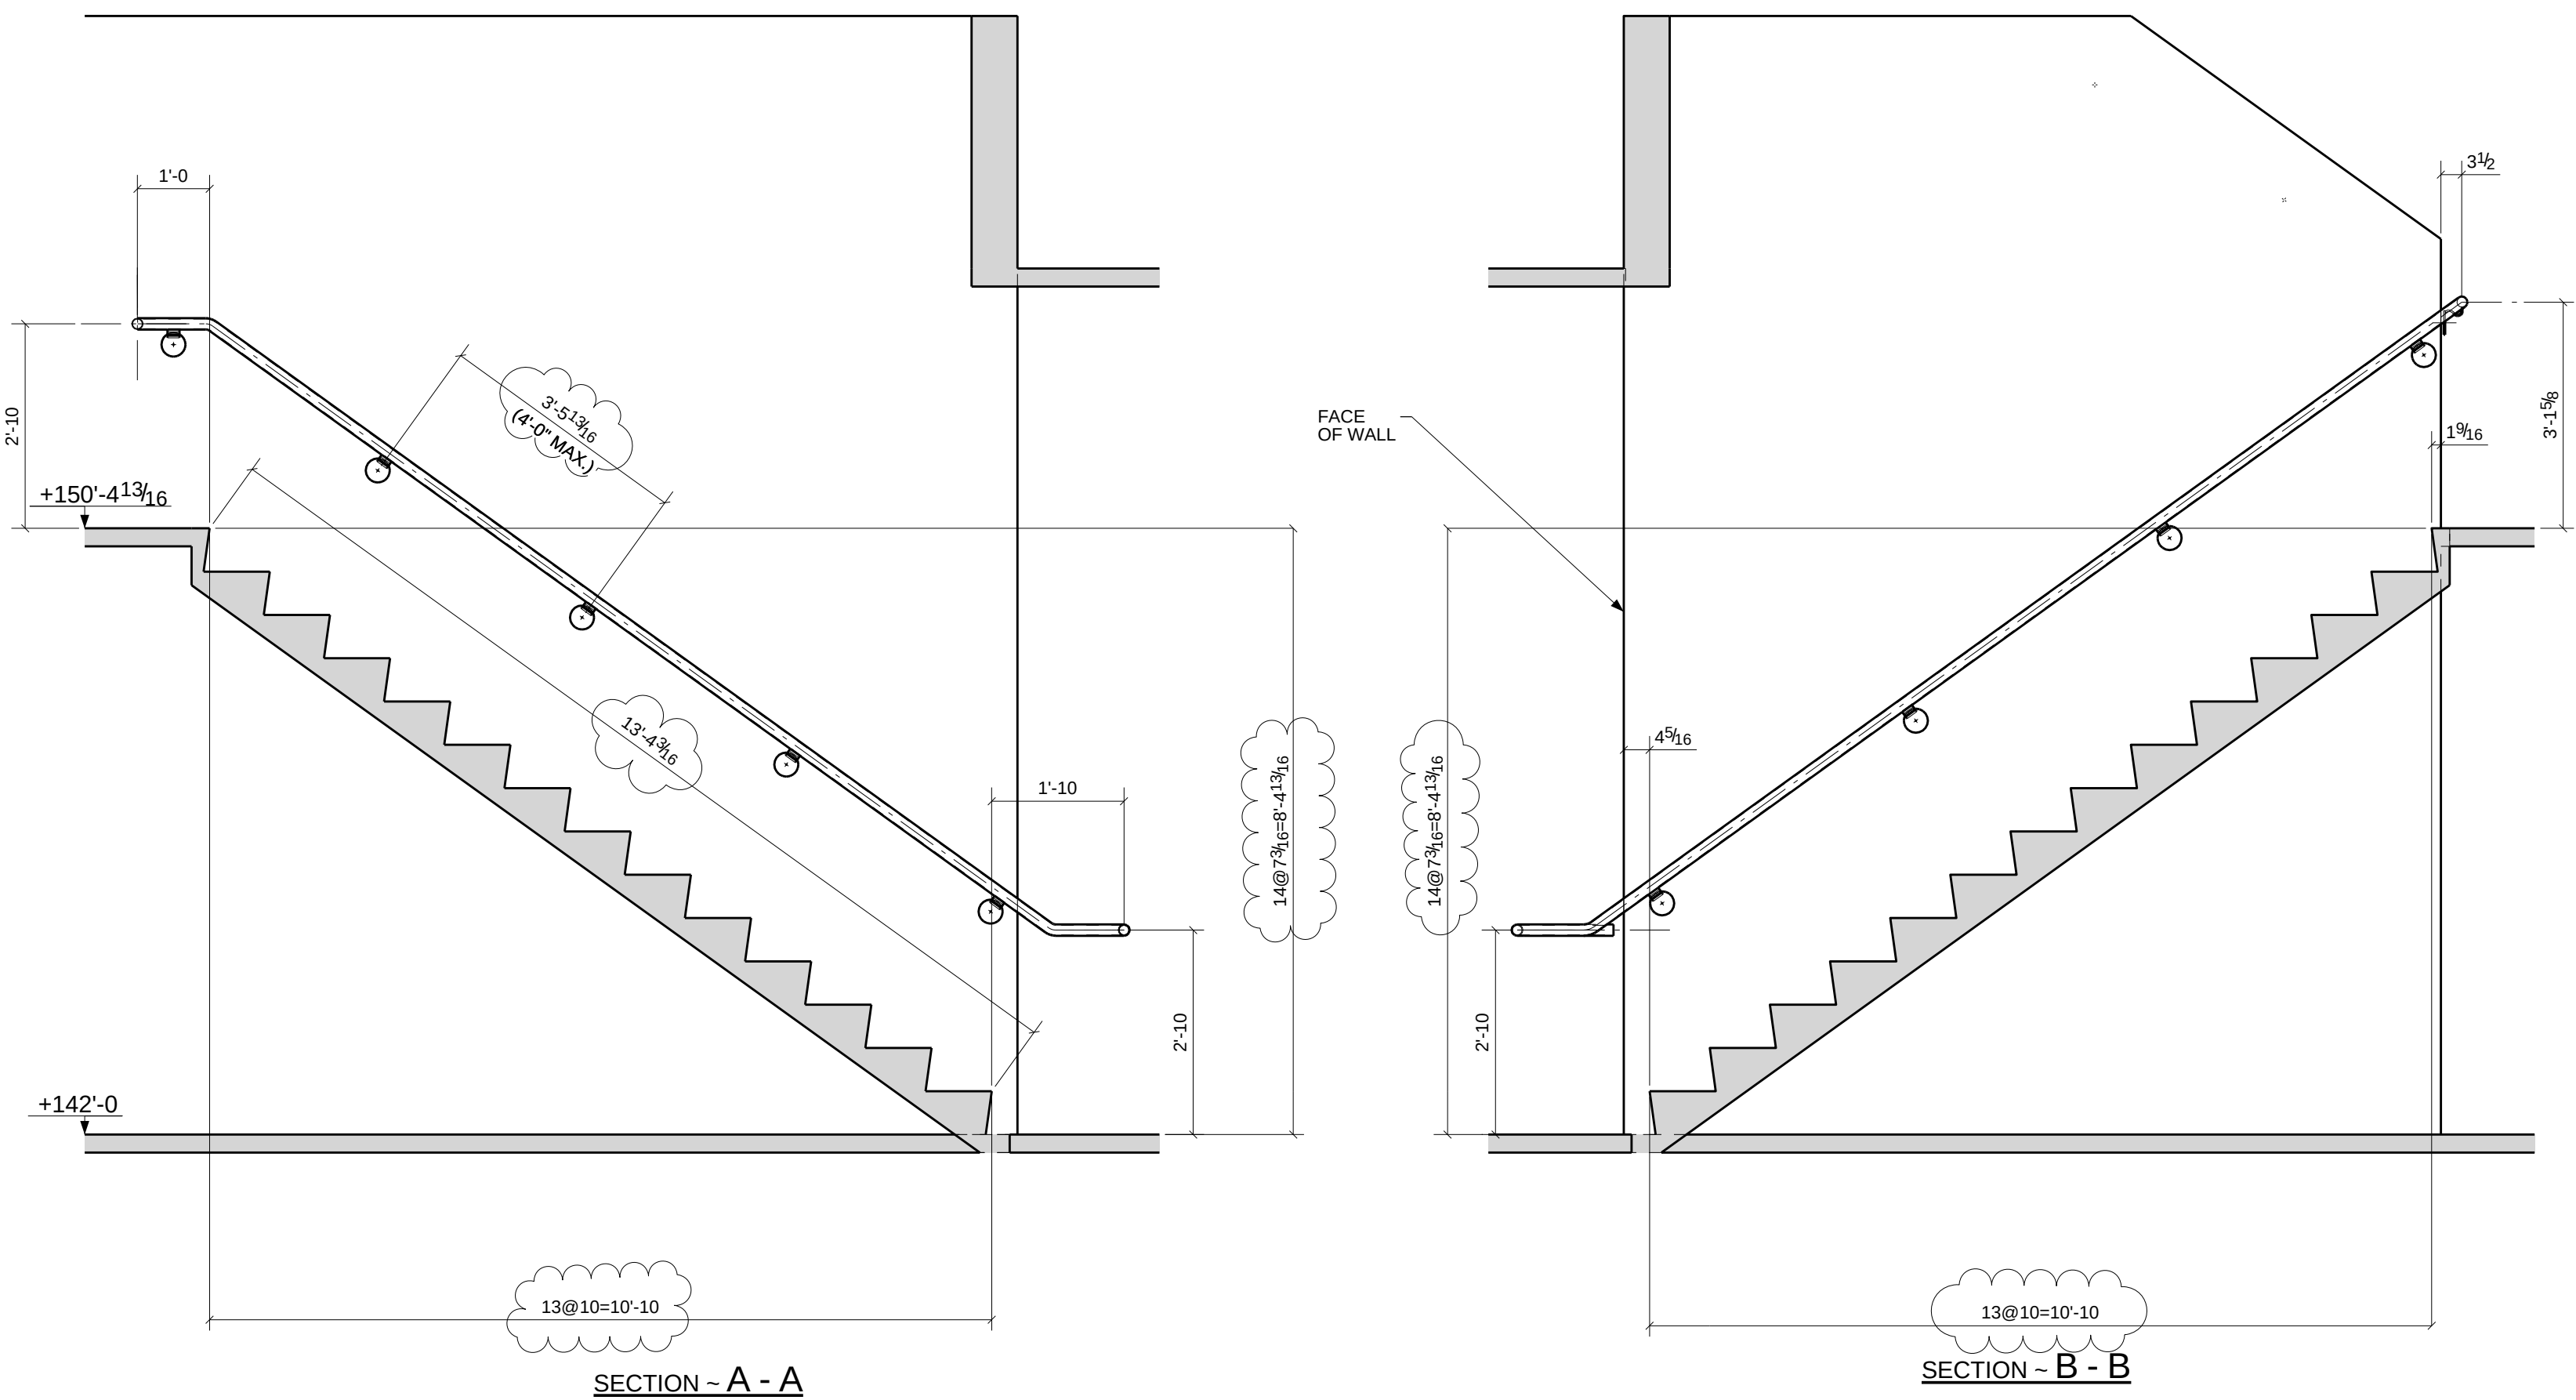


DRAWINGS PREPARED BY DETAILER FROM INFORMATION CONTAINED IN THE PROJECT DOCUMENTS WITH INSTRUCTIONS FROM THE FABRICATOR. DETAILER IS NOT RESPONSIBLE FOR ANY DESIGN, ENGINEERING OR CODE ISSUES WHICH MAY ARISE FROM THE USE OF THESE DRAWINGS. APPROVALS SHOULD BE OBTAINED FROM THE OWNER, ARCHITECT, ENGINEER, CONTRACTOR, WHICH EVER IS APPLICABLE. THE FABRICATOR SHOULD CHECK THE DETAIL DOCUMENTS FOR CORRECTNESS BEFORE RELEASING FOR FABRICATION. THE USE OF THE DETAILED DRAWINGS FOR FABRICATION CONSTITUTES ACCEPTANCE AND APPROVAL OF THE DRAWINGS, MATERIAL LIST OR CUT LIST, WHICH EVER APPLIES.

This project shall be executed in accordance with Section 7 of the AISC Code of Standard Practice, which includes 7.14 Correction of Errors, that states the following:
The fabrication of steel results in inevitable errors in welding, cutting or drilling and the drawing of elements into line with stiff parts, and be considered to be normal erection operations. Errors that cannot be corrected along the foregoing means, or that require major changes in member or connection configuration, shall be promptly reported by the erector's representatives for design and construction, and the fabricator by the erector. In order the responsible party to either correct the error or approve the most efficient and economical method of correction to be used by others.
All field welds to be made with E70XX low hydrogen electrodes.

A		For Approval & Field Survey		10/4/10	TMc	TAN
REV.	DESCRIPTION			DATE	DWN	CHK
GENERAL NOTES				JOB USE		
MATERIAL: A992 / A36 UN		ELECTRODES: E70XX LH		REF. DRG.		
HOLES: 13/16 DIA. UN		CONNS: -		SHOP		
SURFACE PREP.				APPROVAL		
AND PAINT:						
SSPC-SP-2						
GREY PRIMER DEVCOE NA-195 (U.N.)						
DESCRIPTION: RAILS @ EXISTING STAIR S3						
PROJ. NAME Hamilton High School Phase III				DRAWN BY TMc		
LOCATION Hamilton City School District - Hamilton, OH				DATE 10/04/2010		
CONTRACTOR GC Contracting ARCH/ENG. SHP				CHKD. BY TAN		
				DATE		
Avenue Fabricating Inc.				JOB No. 10-16		
1281 Clough Pike				DRG. No. E103		
Batavia, OH 45103				REV. A		
(513) 752-1911						

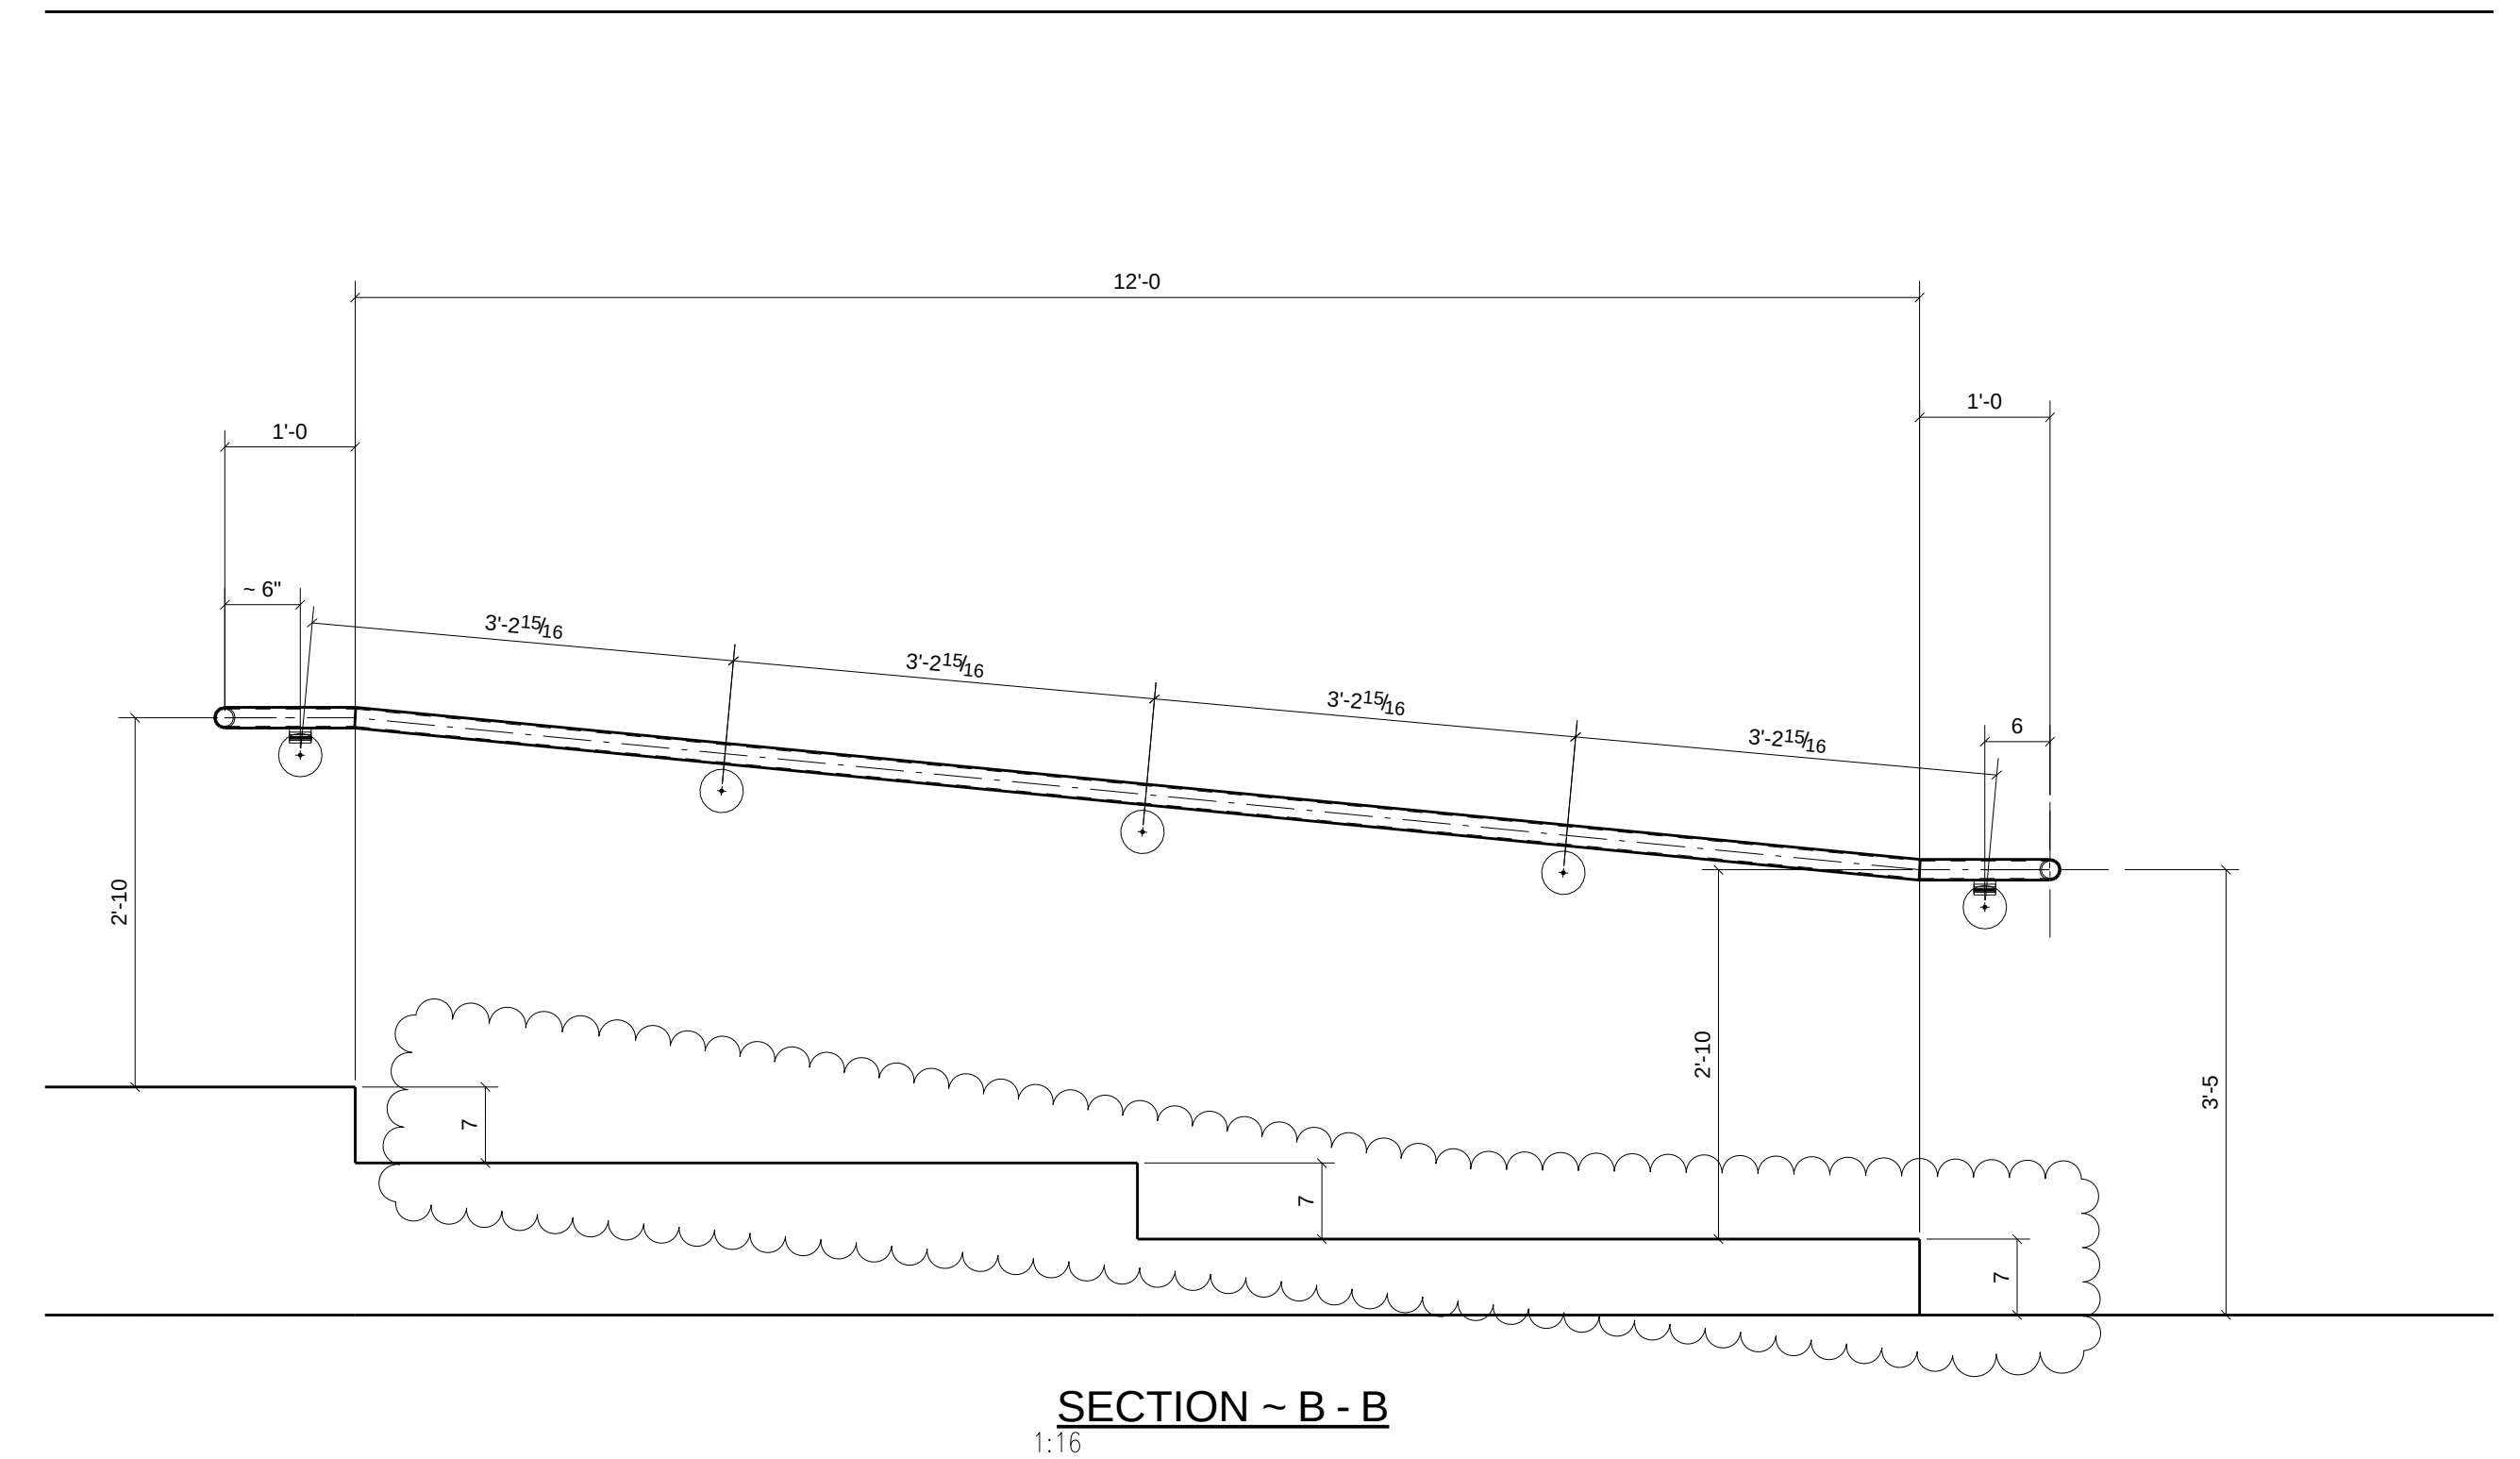

SECTION ~ B - B
1:16

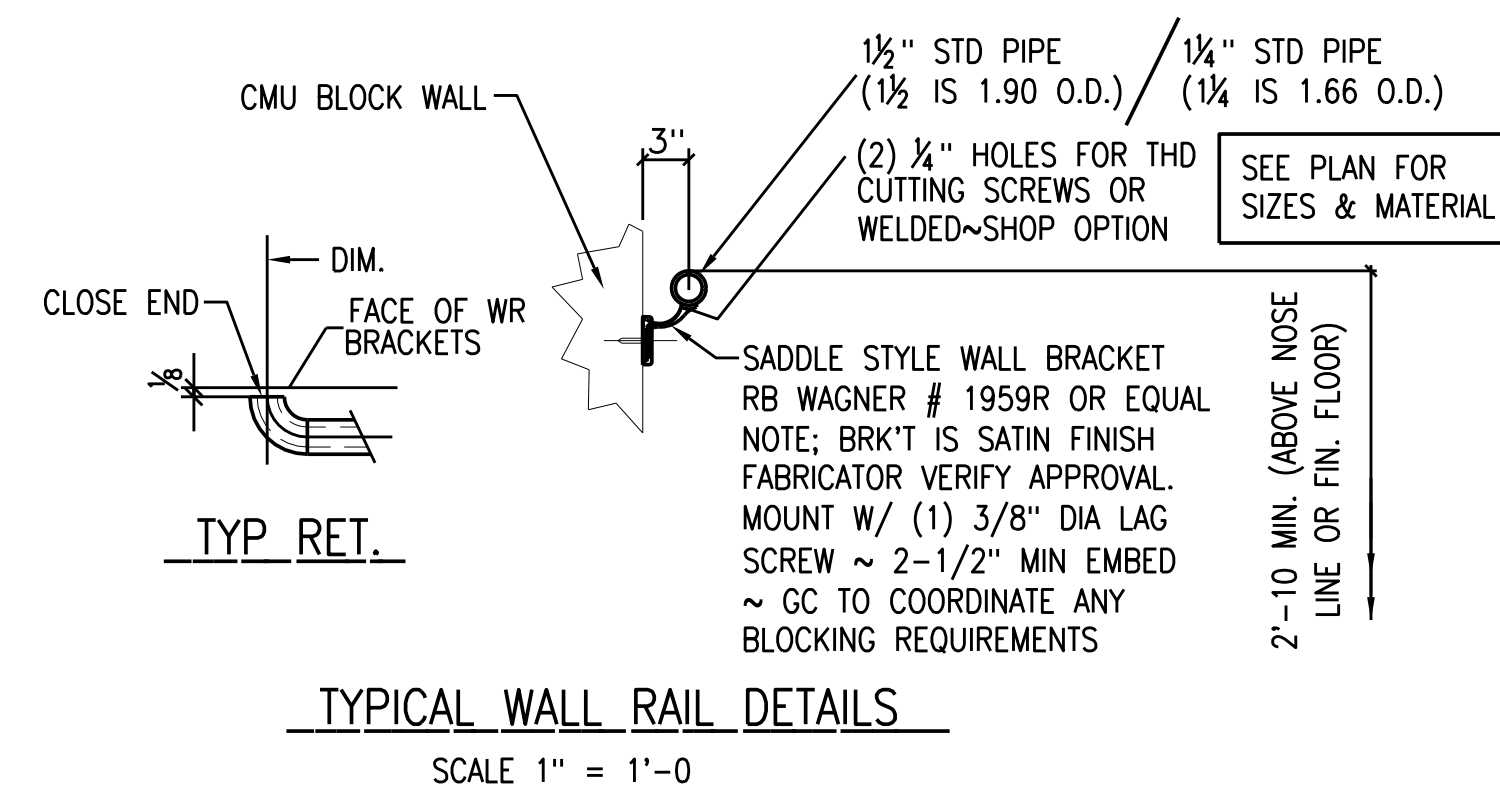


TYPICAL WALL RAIL DETAILS
SCALE 1" = 1'-0"

This project shall be erected in accordance with Section 7 of the ASCE Code of Standard Practice, which includes 7.1.4 Connection of Erection, stating the following:


The corrections to minor misalignments by moderate raising, grading, welding or cutting, and the drawing of elements into line with drill pins, shall be considered to be normal erection operations. Errors that cannot be corrected using the foregoing means, or that require major changes in member or connection configuration, shall be promptly reported to the owner's representatives for design and construction, and the fabricator by the erector, to enable the responsible entity to either correct the error or approve the most efficient and economical method of correction to be used by others.

A	For Approval & Field Survey			10/12/10	TMC	TAN
REV.	DESCRIPTION			DATE	DWN	CHK
GENERAL NOTES MATERIAL: A992 / A36 UIN ELECTRODES: E70XX LH REF. DRG. HOLES: 13/16 DIA. UIN CONNYS: - SURFACE PREP. AND PAINT: SSPC-SP-2 GREY PRIMER DEVCOE NA-195 (U.N.)				JOB USE		
				SHOP		
				APPROVAL		
DESIGNATION: MULTI-PURPOSE RAILS @ 2136						
PROJ. NAME Hamilton High School Phase III				DRAWN BY TMC		
LOCATION Hamilton City School District - Hamilton, OH				DATE 10/11/2010		
CONTRACTOR GC Contracting ARCH/ENG. SHP				CHKD. BY TAN		
Avenue Fabricating Inc. 1281 Clough Pike Batavia, OH 45103 (513) 752-1911				DATE		
				JOB NO. 10-16		
				DRG. No. E104 REV. A		

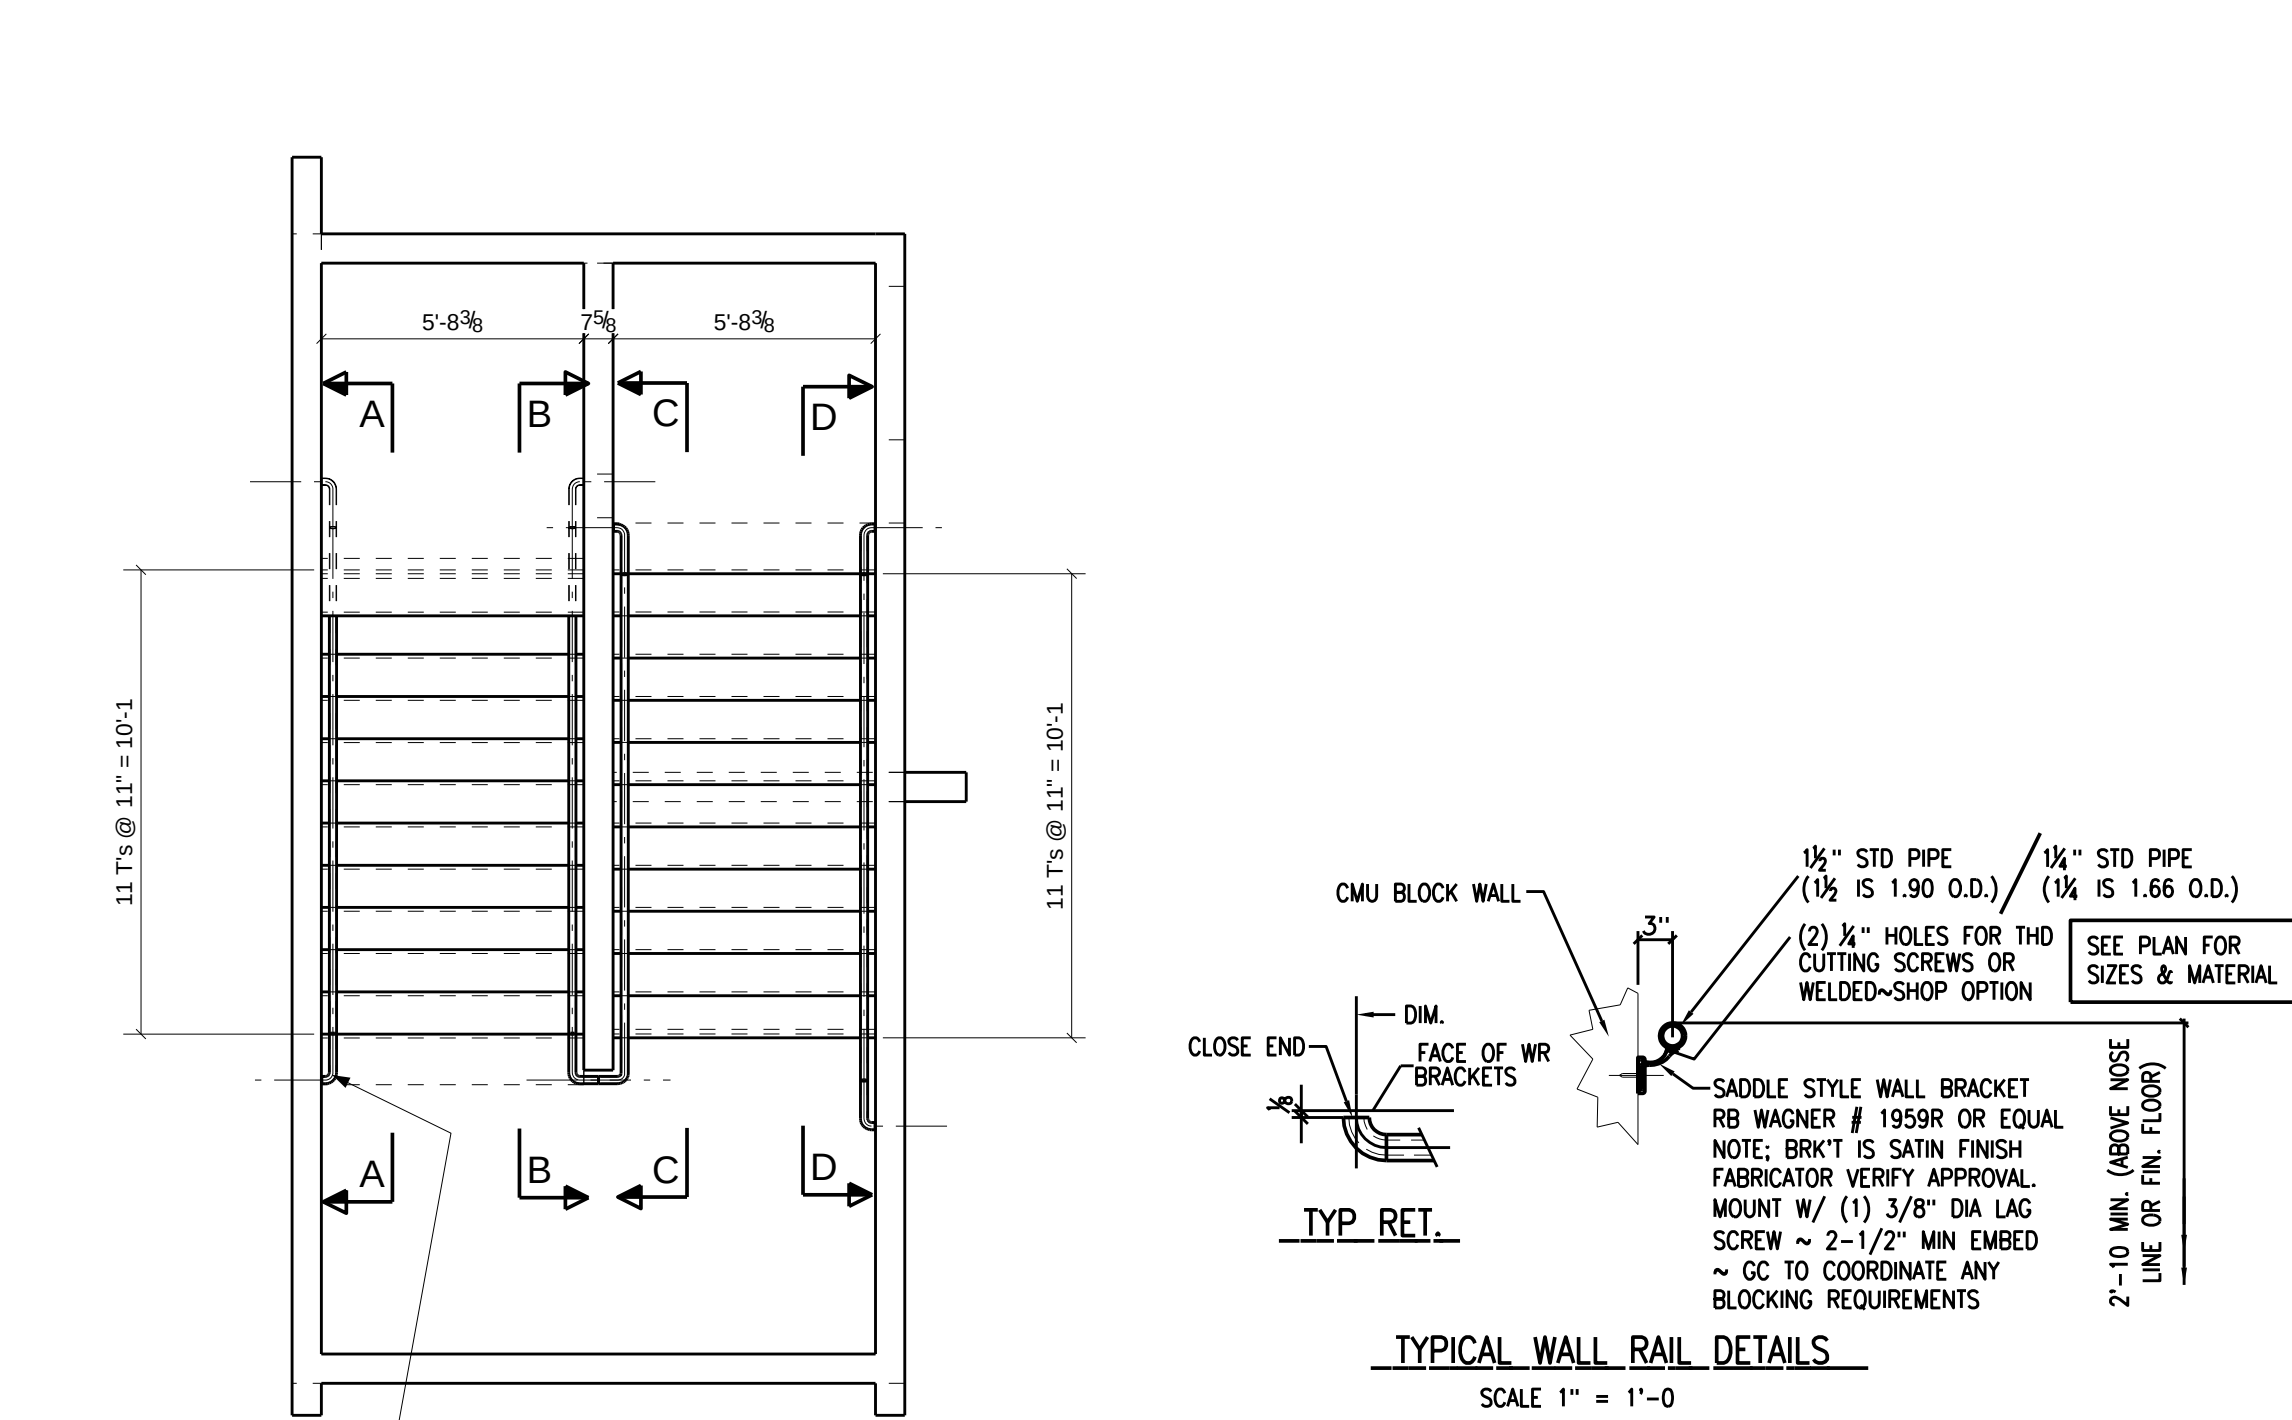


PLAN ~ STAIR S-10 ~ WALL RAIL

1:45

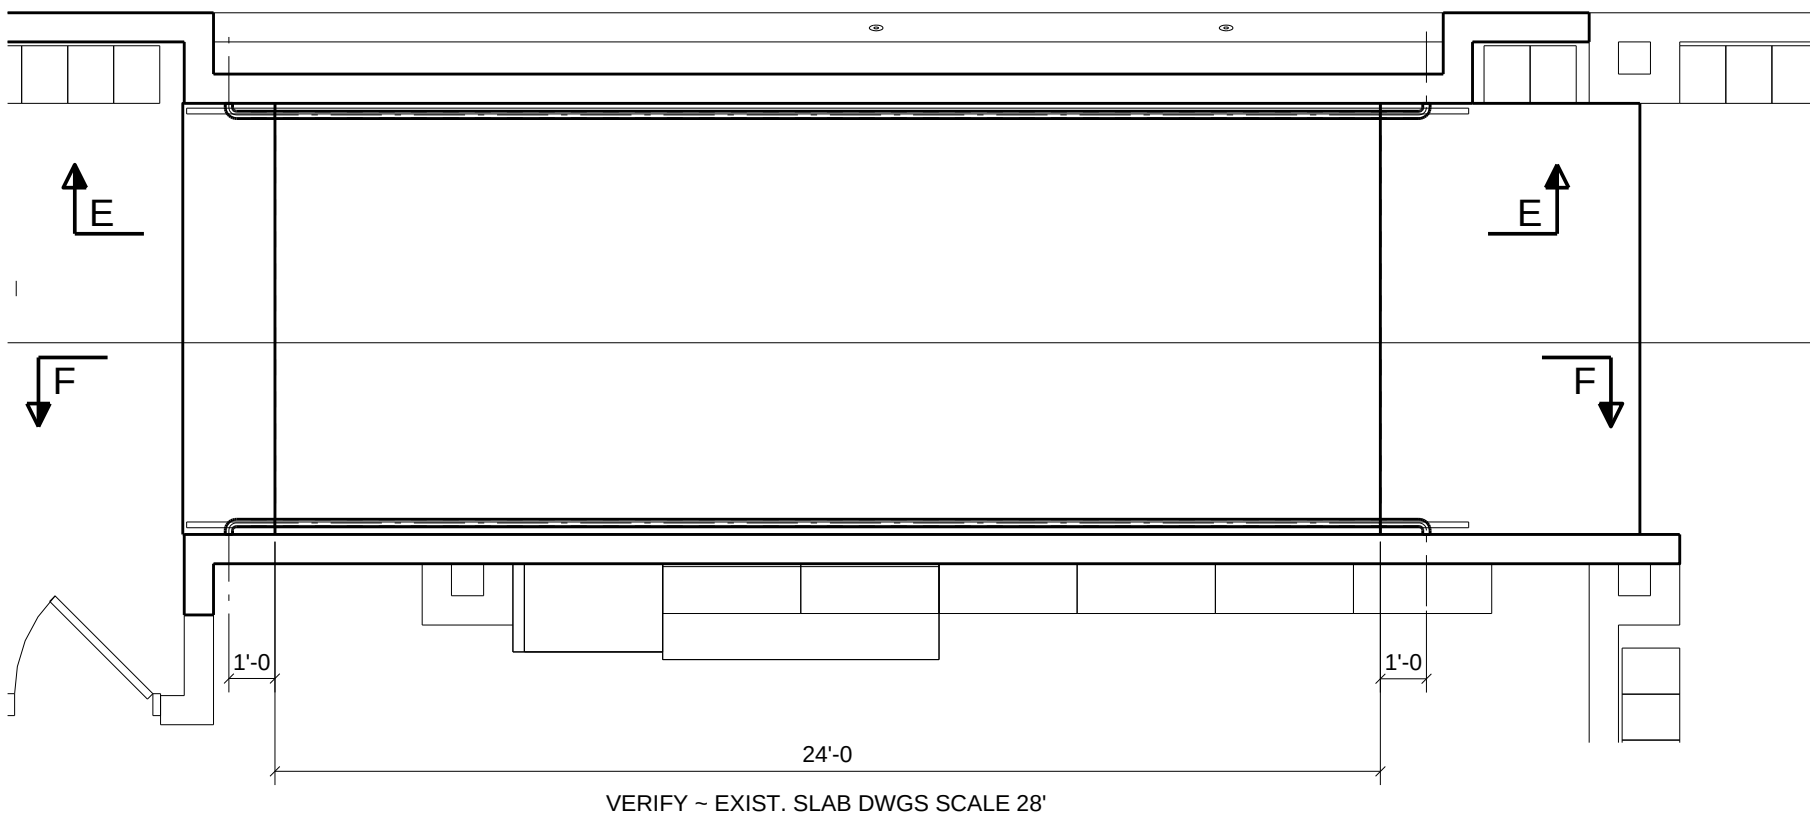


PLAN ~ RAMP 1018 ~ WALL RAIL


1:45

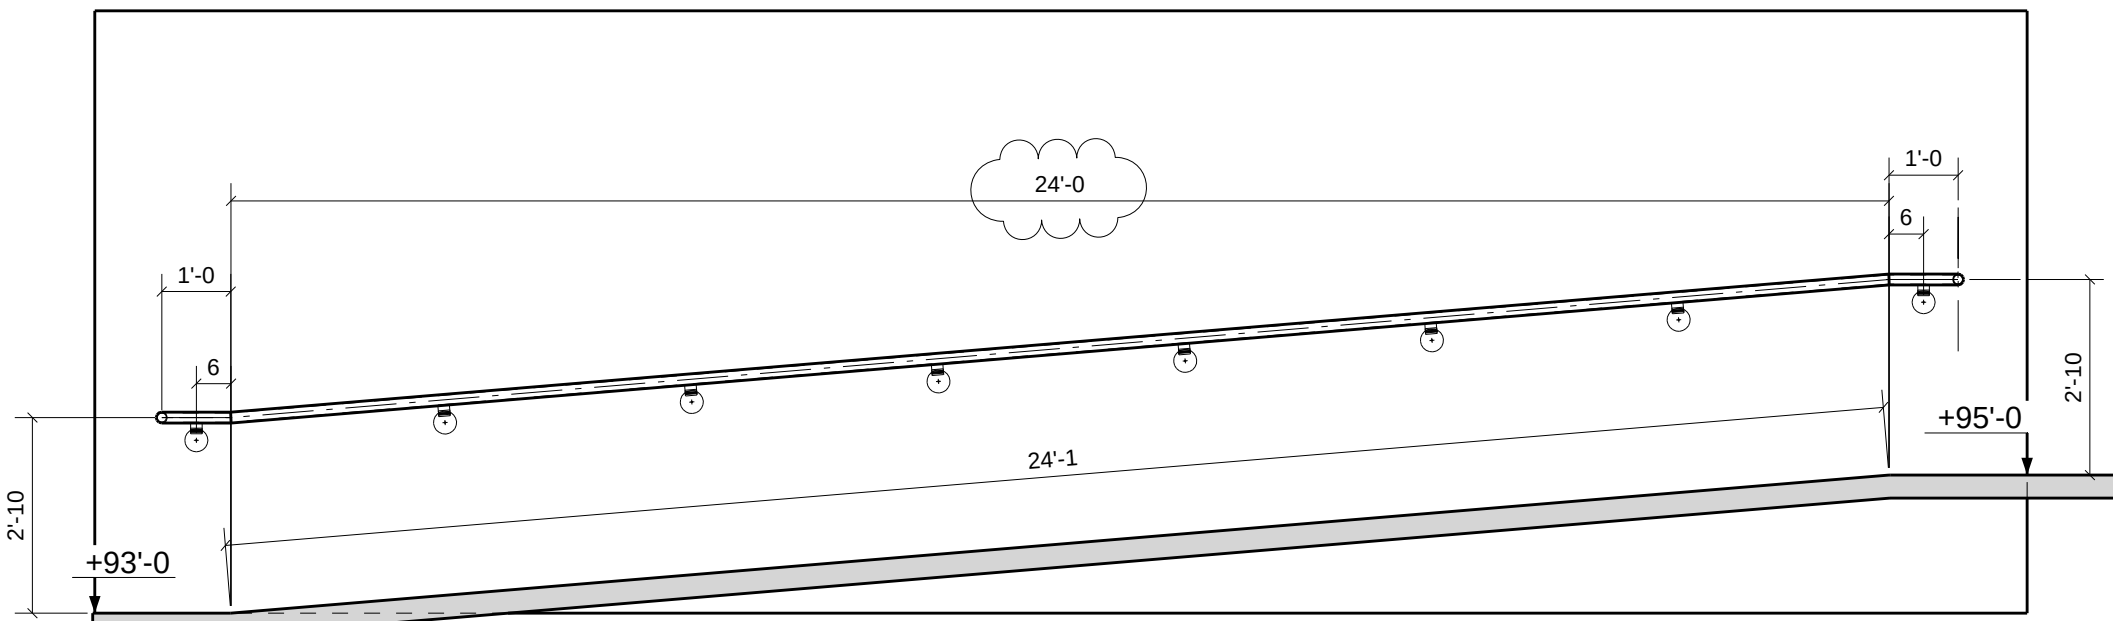


E - E

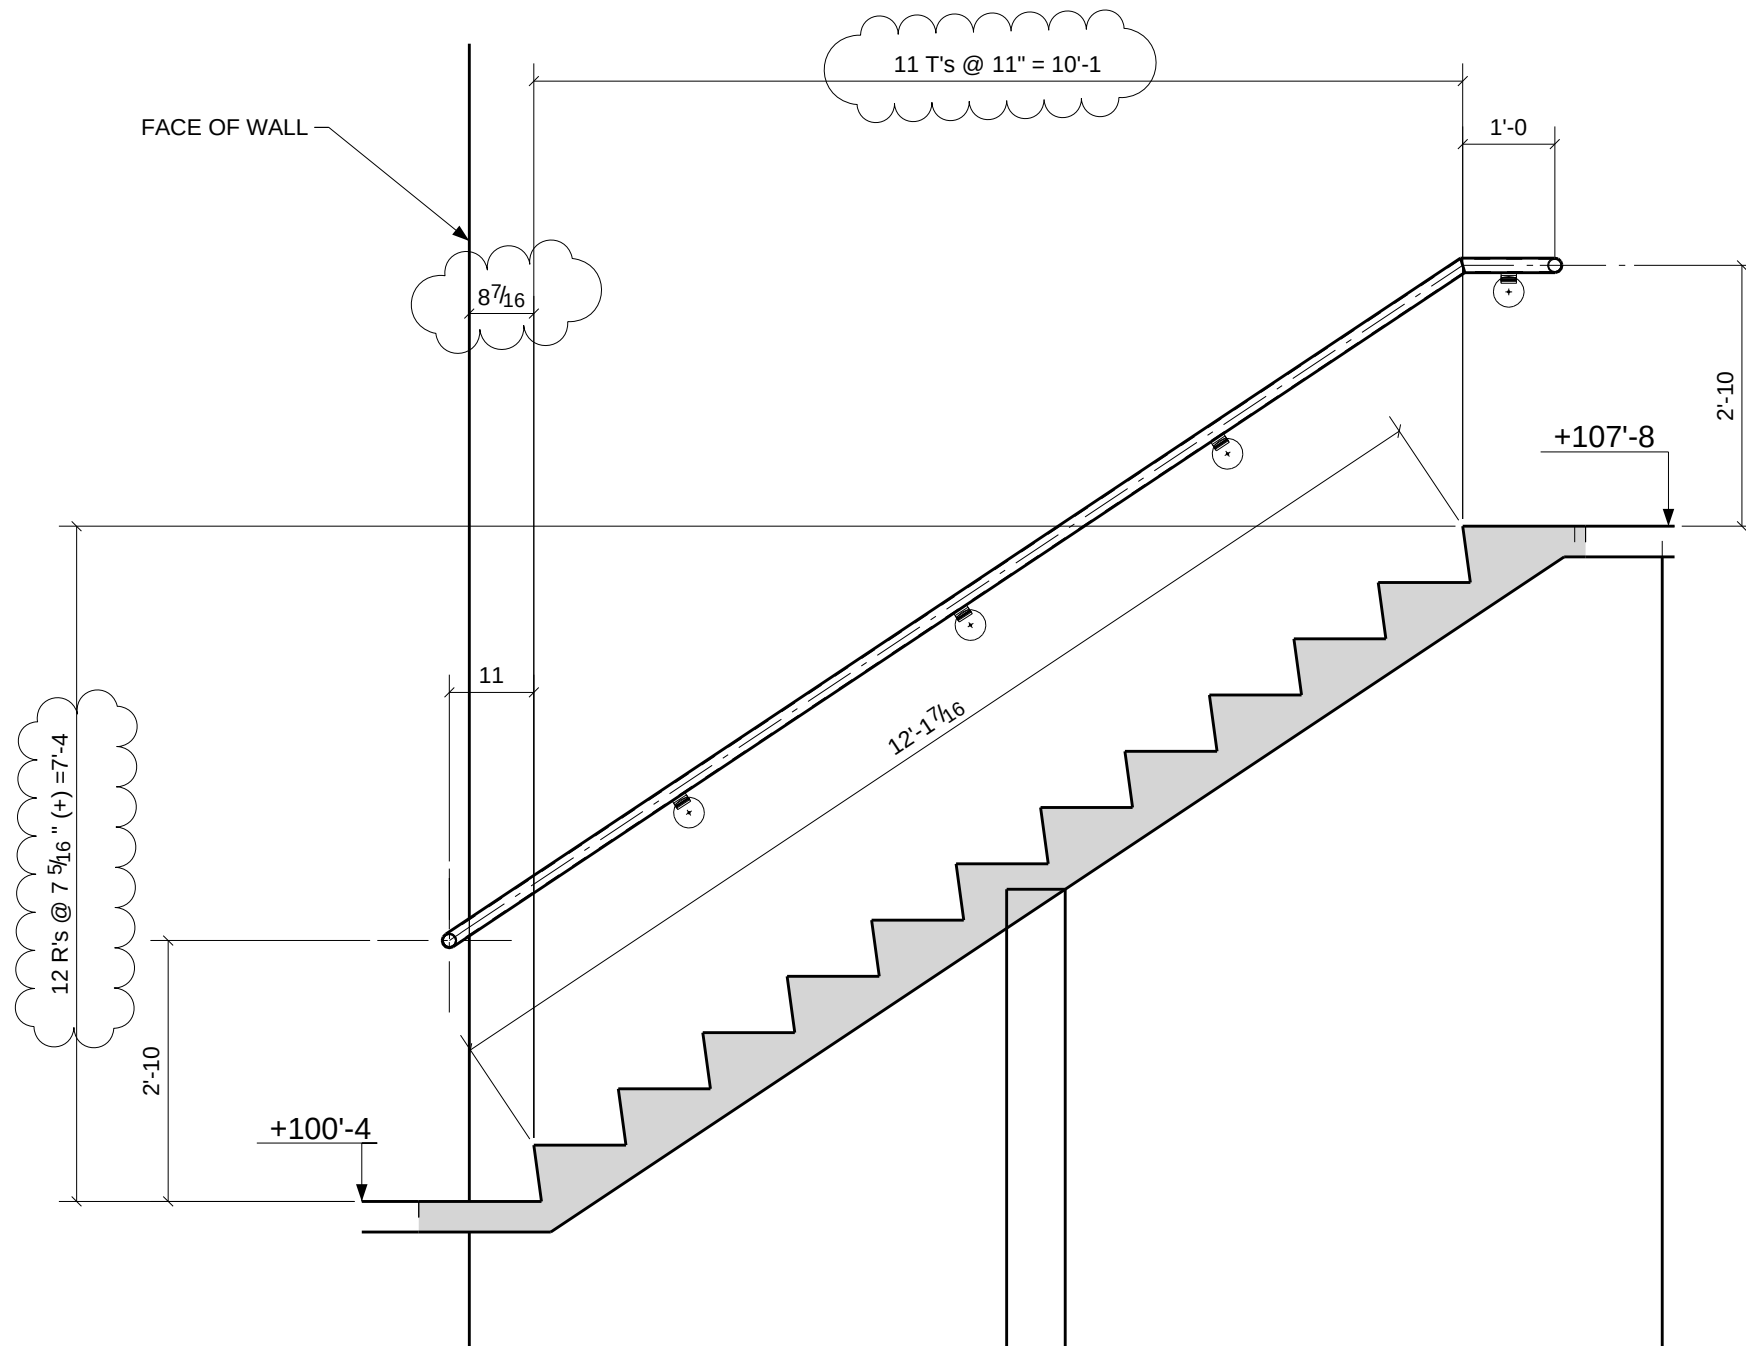


A - A

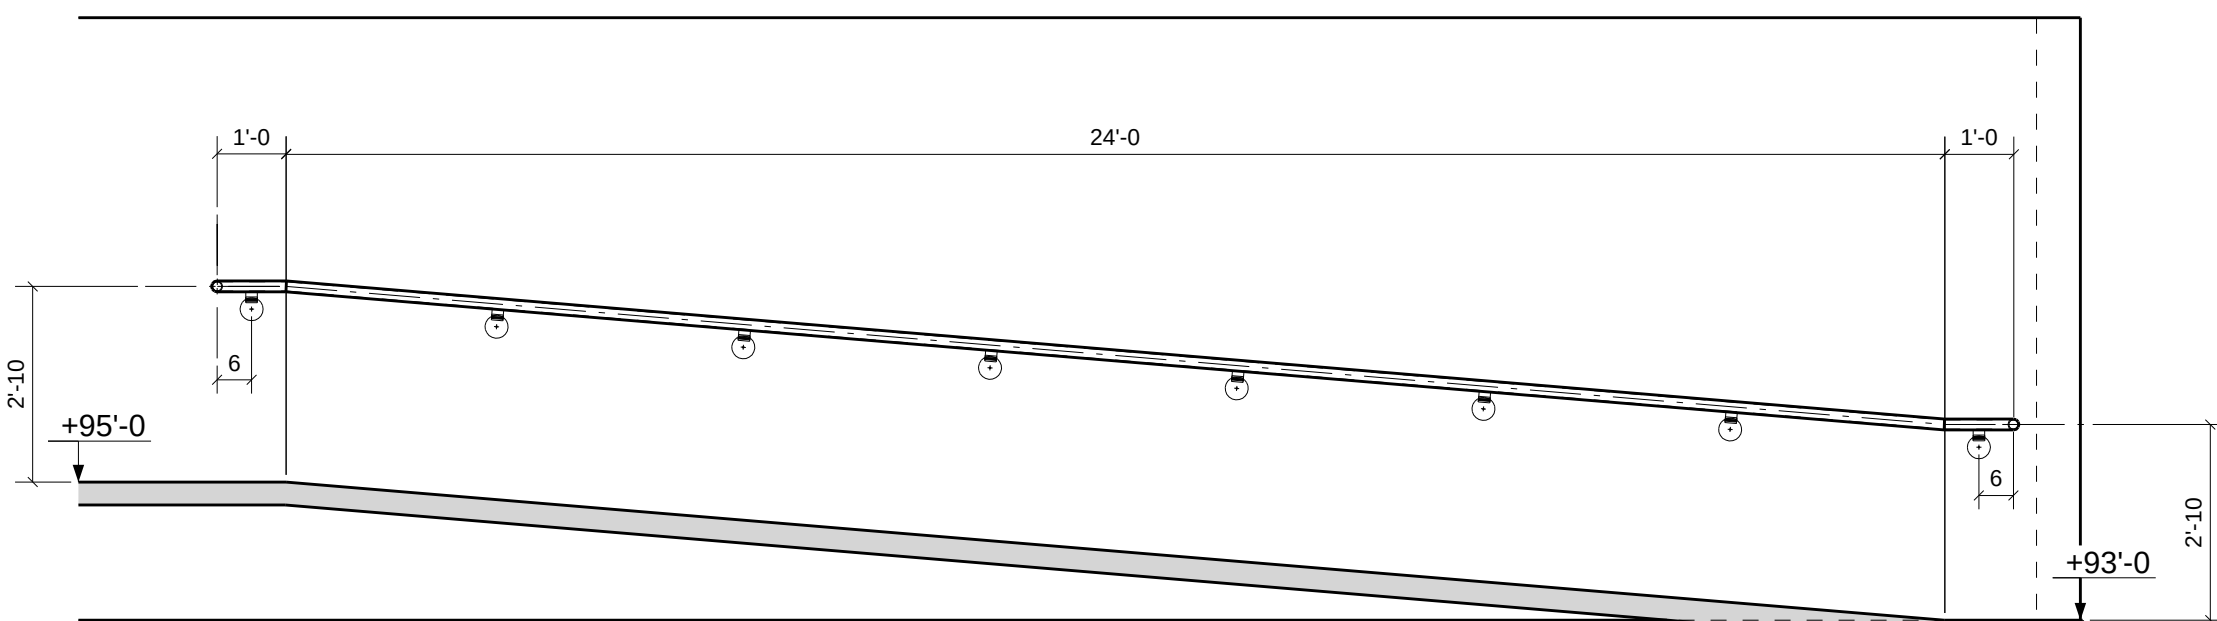

F - F

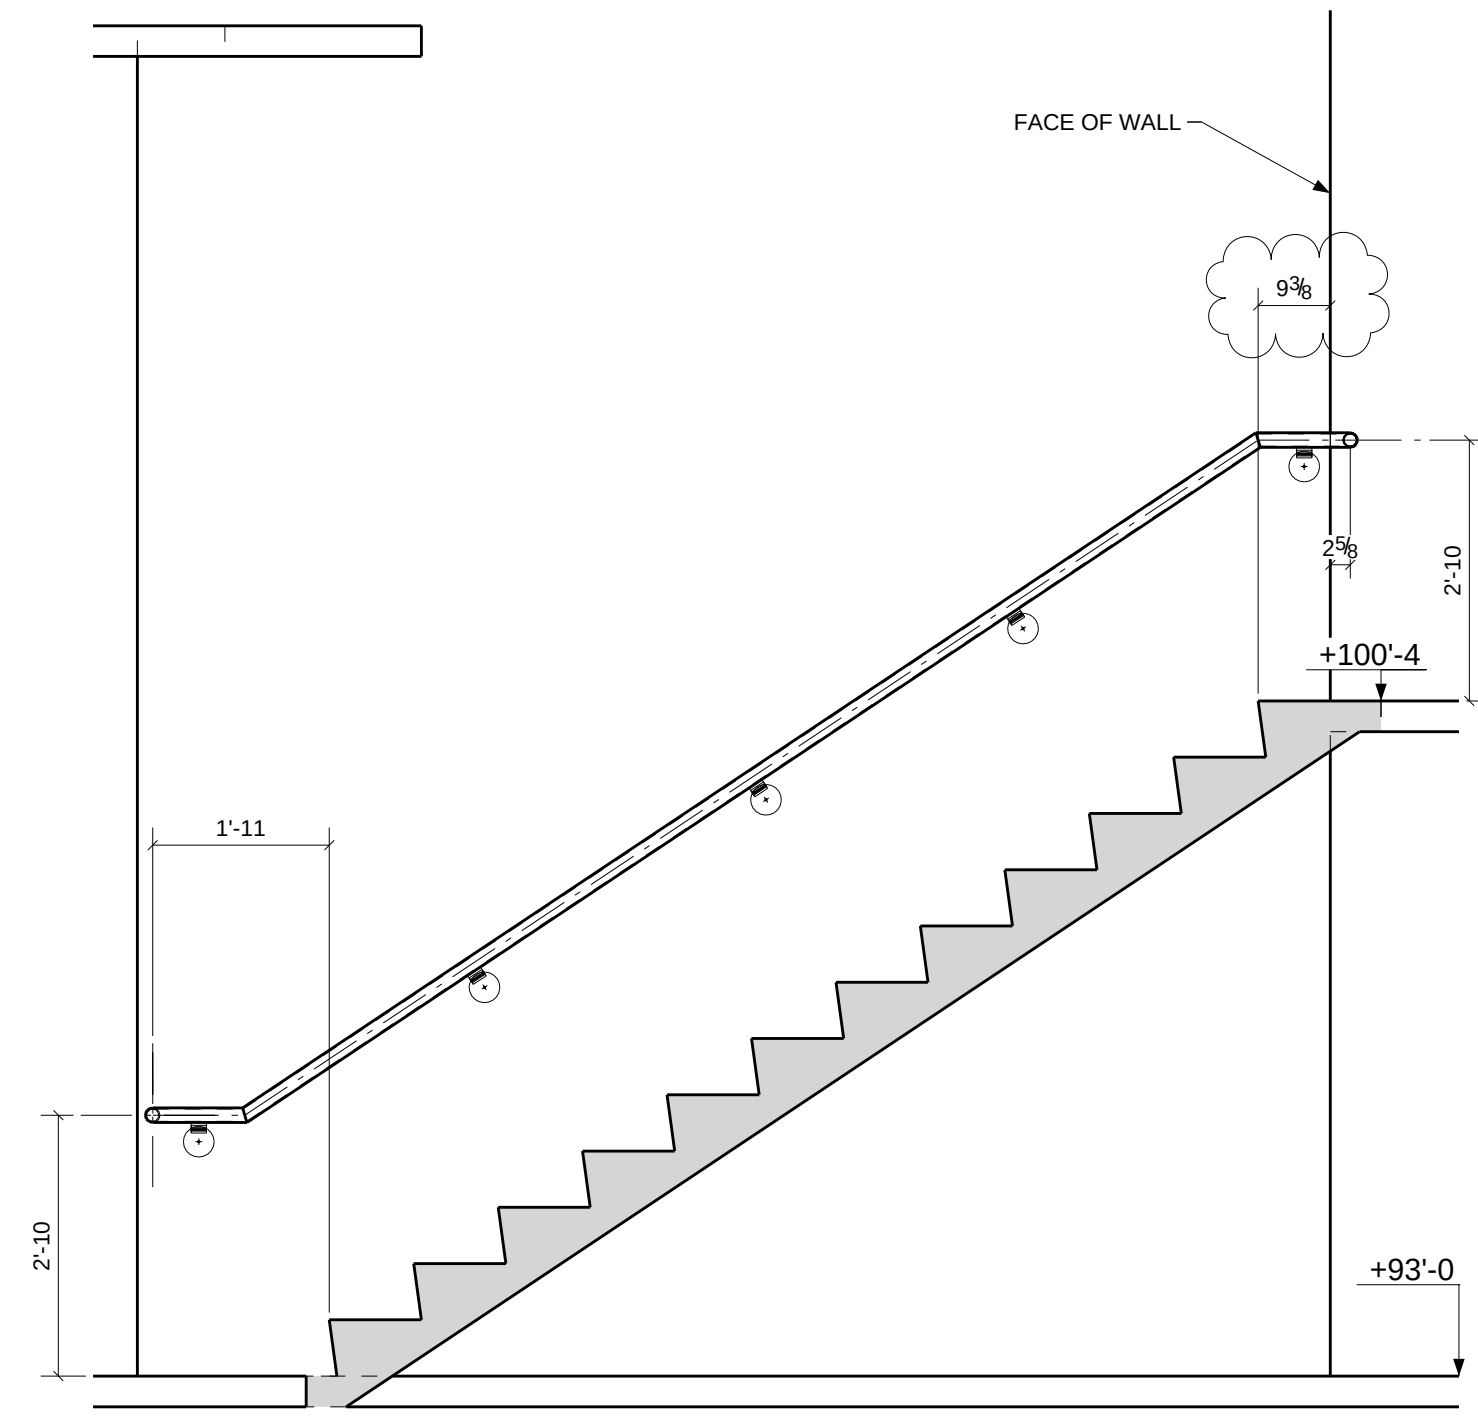

B - B

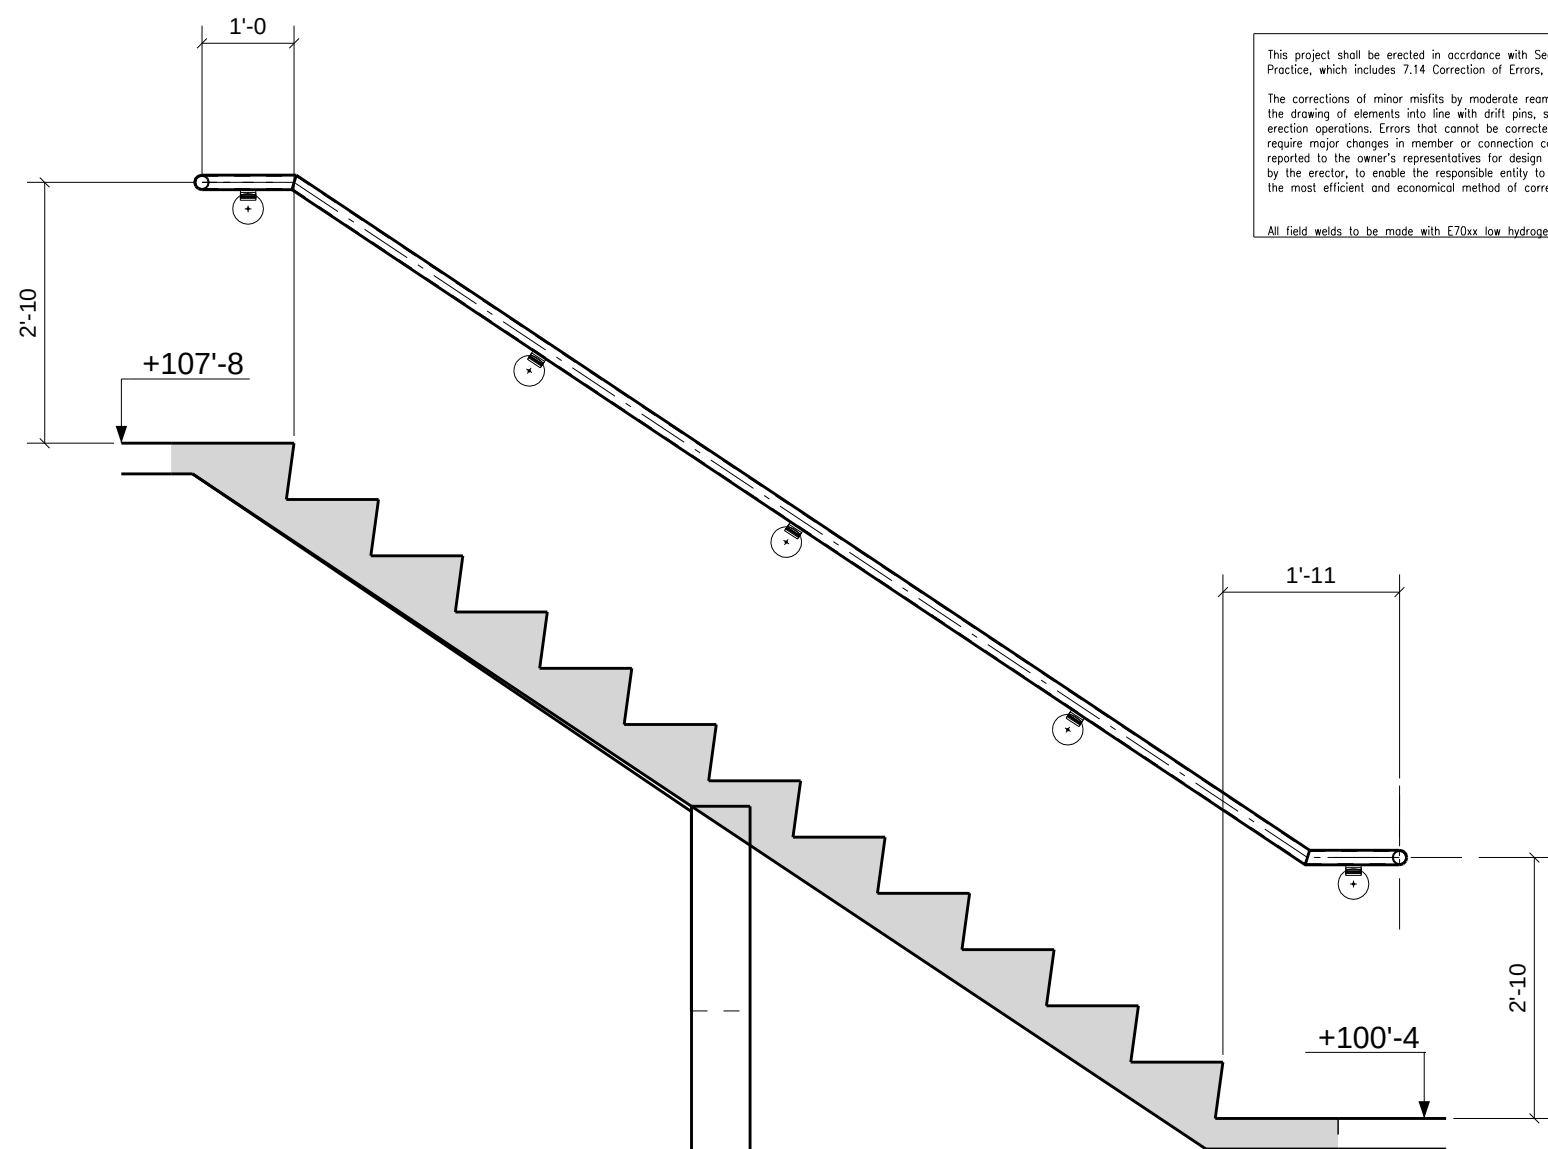



D - D


This project shall be erected in accordance with Section 7 of the ABC Code of Standard Practice, which includes 7.4 Correction of Errors, that states the following:

The correction of minor errors by moderate reworking, grinding, welding or cutting, and the drawing of materials into the work with pins, shall be considered to be normal operations. Errors that cannot be corrected using the foregoing means, or that require major changes to material or connection configurations, shall be promptly reported to the owner's representative for design and construction, not the fabricator by the erector, to enable the responsible party to either correct the error or approve the most efficient and economical method of correction to be used by others.

All steel welds to be made with E70xx low hydrogen electrodes.


A		For Approval & Field Survey		10/12/10	TMc	TAN
REV.	DESCRIPTION			DATE	DWN	CHK
GENERAL NOTES				JOB USE		
MATERIAL: A992 / A36 UN		ELECTRODES: E70XX LH		REF. DRG.		
HOLES: 13/16 DIA. UN		CONNS: -		SHOP		
SURFACE PREP. AND PAINT:				APPROVAL		
SSPC-SP-2						
GREY PRIMER DEVOE NA-195 (U.N.)						
DESCRIPTION: RAILS @ EXISTING STAIR S-9 & RAMP 1019						
PROJ. NAME		Hamilton High School Phase III			DRAWN BY TMc	
LOCATION		Hamilton City School District - Hamilton, OH			DATE 10/12/2010	
CONTRACTOR GC Contracting		ARCH./ENG. SHP			CHKD. BY TAN	
					DATE	
		Avenue Fabricating Inc.			JOB NO.	
		1281 Clough Pike			10-16	
		Batavia, OH 45103			DRG. NO.	
		(513) 752-1911			E105	
					REV. A	

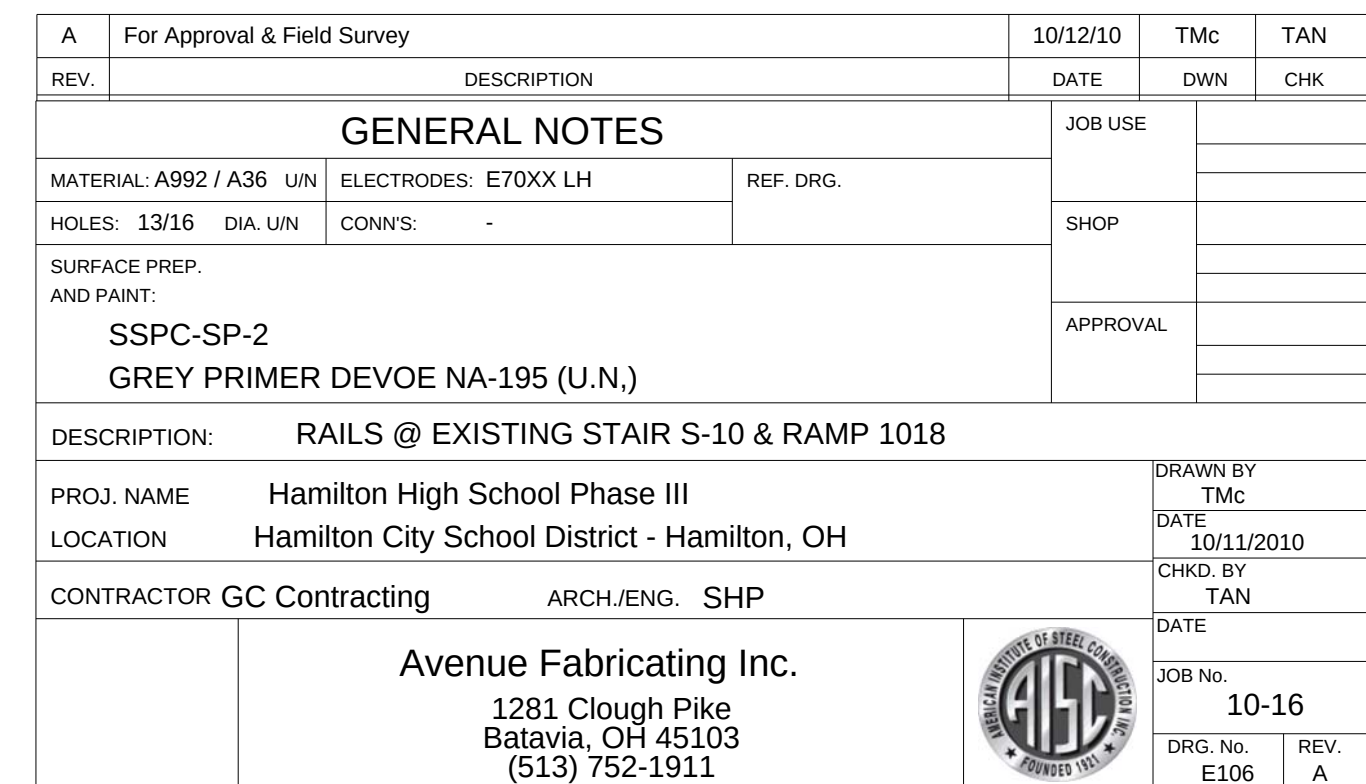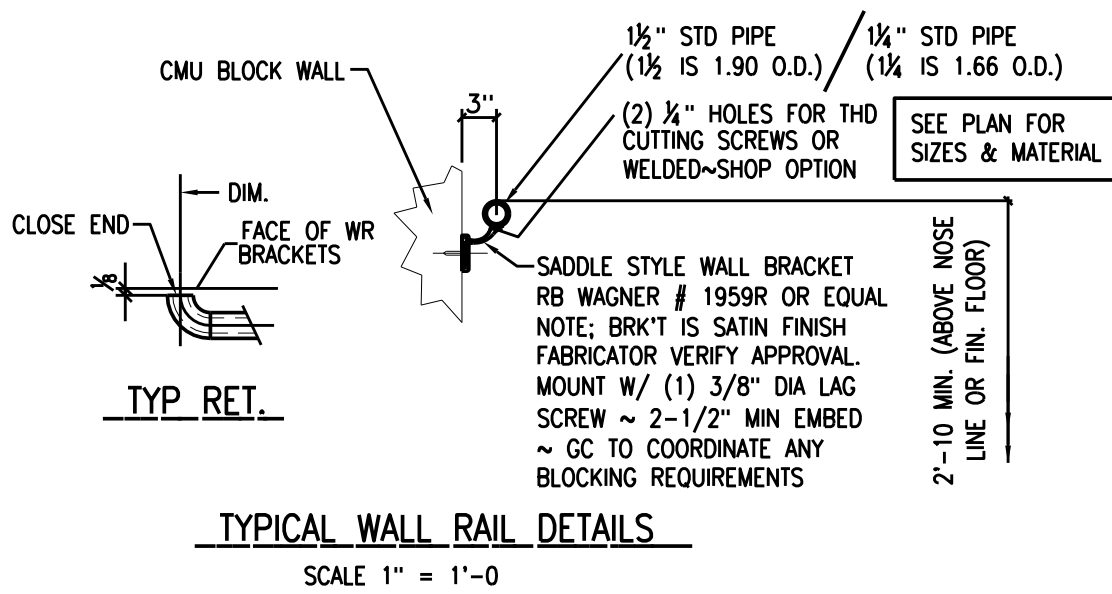

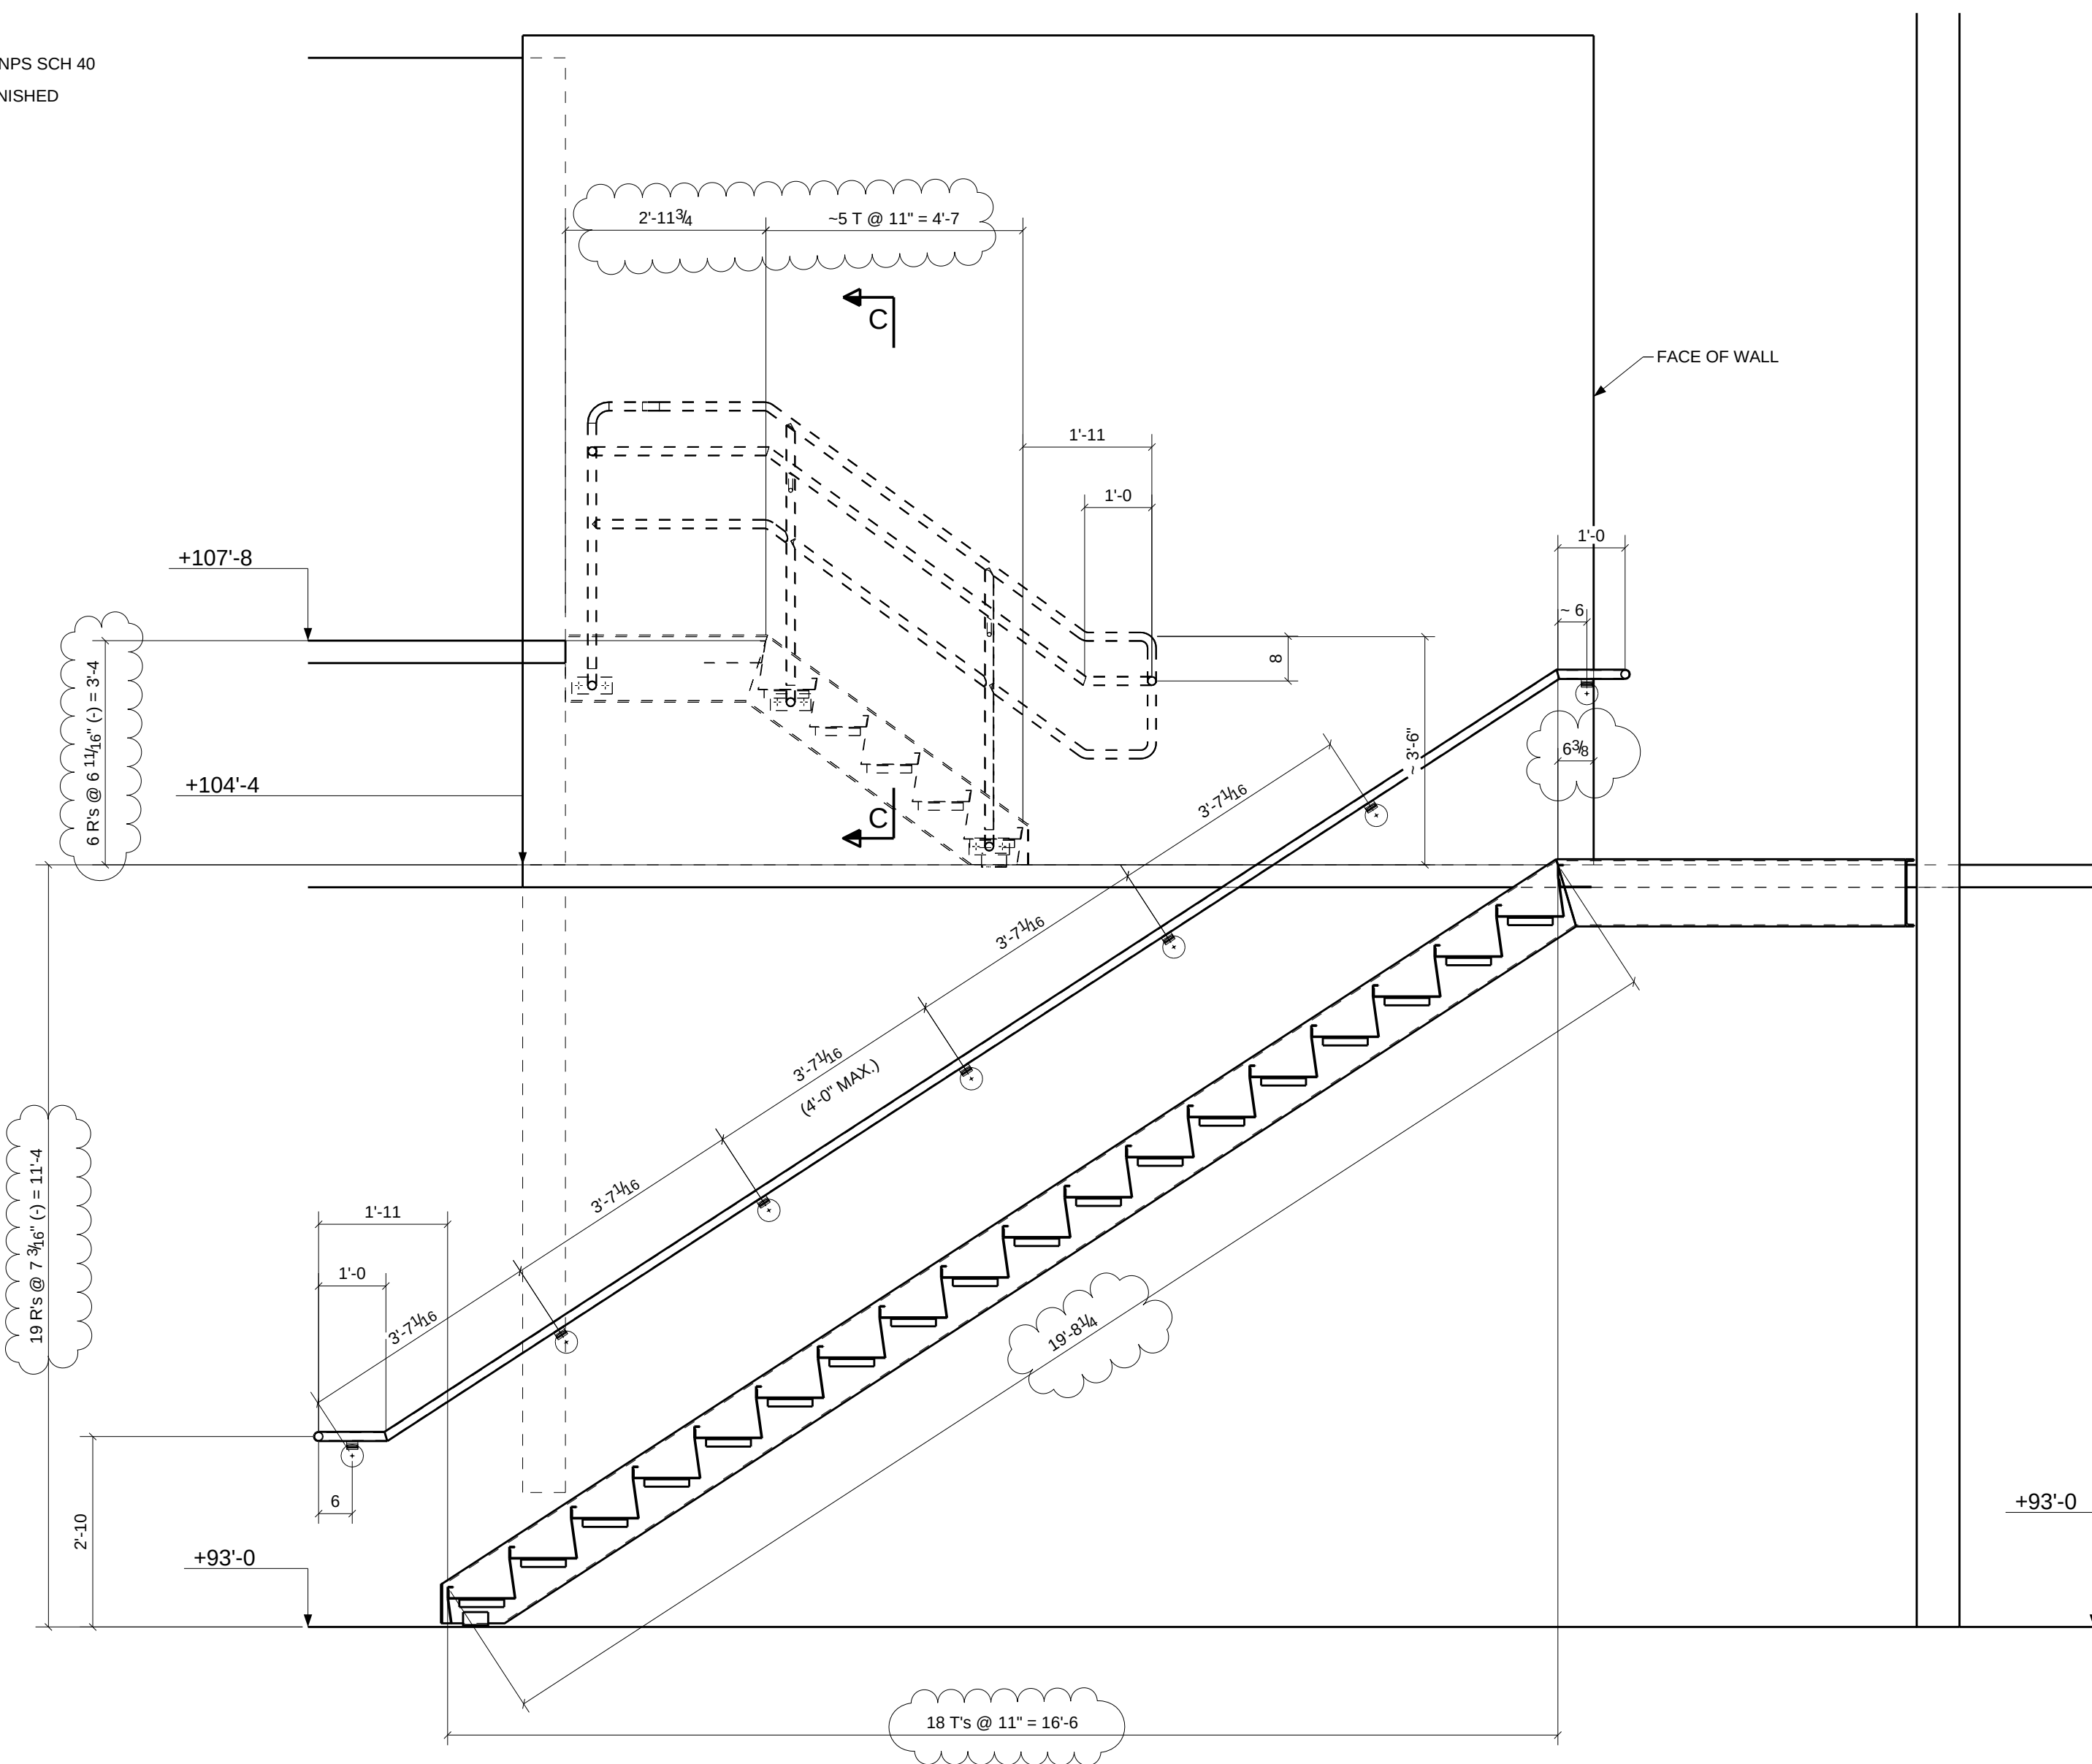

SECTION C - C
1:12

SECTION D - D
1:12

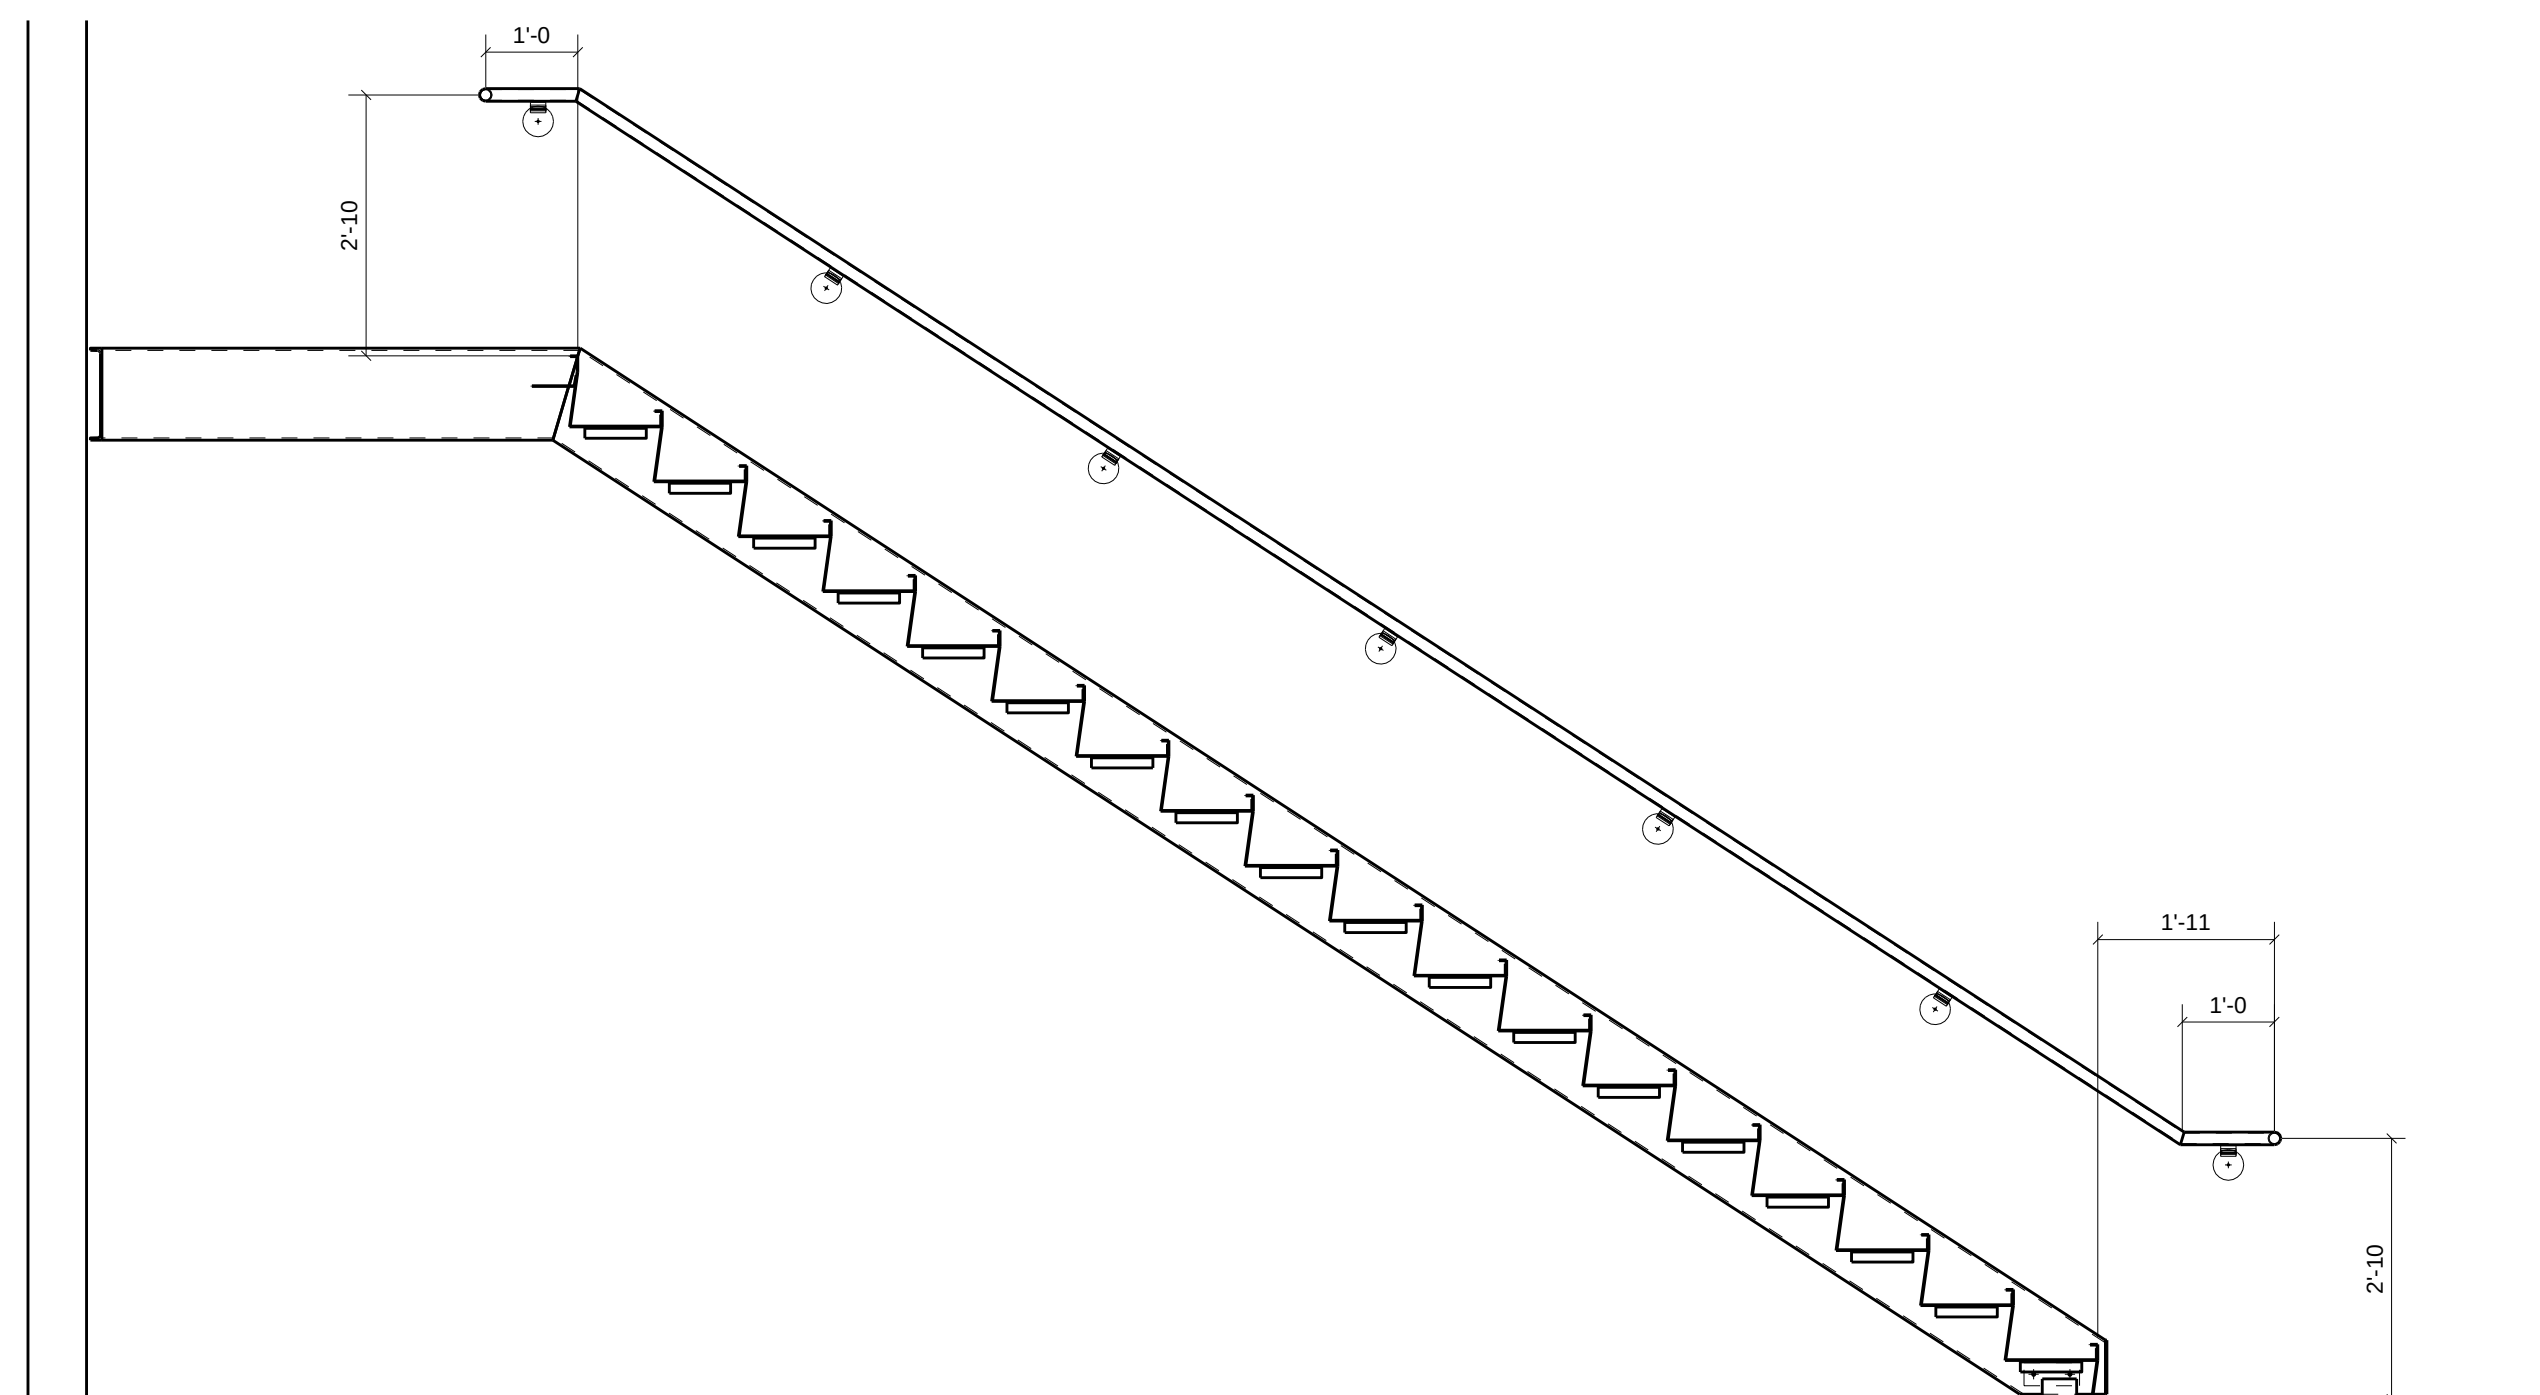

SECTION A - A


DRAWINGS PREPARED BY DETAILER FROM INFORMATION CONTAINED IN THE PROJECT DOCUMENTS WITH INSTRUCTIONS FROM THE FABRICATOR, DETAILER IS NOT RESPONSIBLE FOR THE QUALITY OF THE FABRICATION OR FOR ANY ISSUES WHICH MAY ARISE FROM THE USE OF THESE DRAWINGS. APPROVALS SHOULD BE OBTAINED FROM THE OWNER, ARCHITECT, ENGINEER, CONTRACTOR, WHICH EVER IS APPLICABLE. THE FABRICATOR SHOULD CHECK THE DETAIL DOCUMENTS FOR CORRECTNESS BEFORE RELEASING FOR FABRICATION. THE USE OF THE DETAILED DRAWINGS FOR FABRICATION CONSTITUTES ACCEPTANCE AND APPROVAL OF THE DRAWINGS, MATERIAL LIST OR CUT LIST, WHICH EVER APPLIES.

This project shall be erected in accordance with Section 7.14 of the ASCE Code of Standard Practice, which includes 7.14 Correction of Errors, that states the following:

The corrections of minor mistakes by moderate reaming, grinding, welding or cutting, and the drawing of elements into line with drill pins, shall be considered to be normal corrections. Operations of this type shall not be considered to be a redesign process, and shall not require major changes in member or connection configuration, shall be promptly reported to the owner's representatives for design and construction, and the fabricator by the erector. It entails the responsible entity to either correct the error or approve the most efficient and economical method of correction to be used by others.

All field welds to be made with E70XX low hydrogen electrodes

A	For Approval & Field Survey		10/12/2010	TMC	TAN
REV.	DESCRIPTION		DATE	DWN	CHK
GENERAL NOTES			JOB USE		
MATERIAL: A992 / A36 UIN		ELECTRODES: E70XX LH		REF. DRG.	
HOLES: 13/16 DIA. UIN		CONVNS: -		SHOP	
SURFACE PREP. AND PAINT:					
SSPC-SP-2 GREY PRIMER DEVOE NA-195 (U.N.)				APPROVAL	
DESCRIPTION: STAIR RAIL S-12 & 2205A					
PROJ. NAME	Hamilton High School Phase III			DRAWN BY TMC	
LOCATION	Hamilton City School District - Hamilton, OH			DATE 10/12/2010	
CONTRACTOR GC Contracting	ARCH/ENG. SHP			CHKD. BY TAN	
Avenue Fabricating Inc. 1281 Clough Pike Batavia, OH 45103 (513) 752-1911			DATE		
			JOB NO.		
			10-16		
			DRG. No. E107		

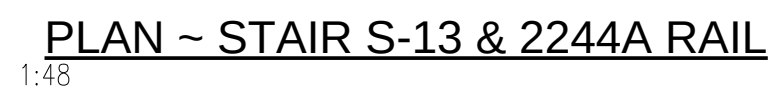


This project shall be erected in accordance with Section 7 of the ASCE Code of Standard Practice, which includes 7.1.4 Correction of Errors, and states the following:

The correctors of minor mistakes by moderate reaming, grinding, welding or casting, and the drawing of elements into line with drill pins, shall be considered to be normal construction operations. Errors that cannot be corrected using the foregoing means, or that require major changes in member or connection configuration, shall be promptly reported to the owner's representatives for design and construction, and the fabricator by the erector, to enable the responsible entity to either correct the error or approve the most efficient and economical method of correction to be used by others.


Field welds to be made with CTHD, low hydrogen electrodes

A		For Approval & Field Survey		10/12/2010		TmC		TAN			
REV.		DESCRIPTION				DATE		DWN		CHK	
GENERAL NOTES										JOB USE	
MATERIAL: A992 / A36 U/N			ELECTRODES: E70XX LH			REF. DRG.					
HOLES: 13/16 DIA. U/N			CONNS: -					SHOP			
SURFACE PREP: AND PAINT:								APPROVAL			
SSPC-SP-2											
GREY PRIMER DEVCOE NA-195 (U.N.)											
DESCRIPTION: STAIR RAIL S-13 & 2244A											
PROJ. NAME		Hamilton High School Phase III									
LOCATION		Hamilton City School District - Hamilton, OH									
CONTRACTOR GC Contracting				ARCH./ENG. SHP				DRAWN BY TmC			
								DATE 10/12/2010			
								CHKD. BY TAN			
								DATE			
Avenue Fabricating Inc. 1281 Cough Pike Batavia, OH 45103 (513) 752-1911								JOB NO. 10-16			
						DRG. No. F108		REV.			

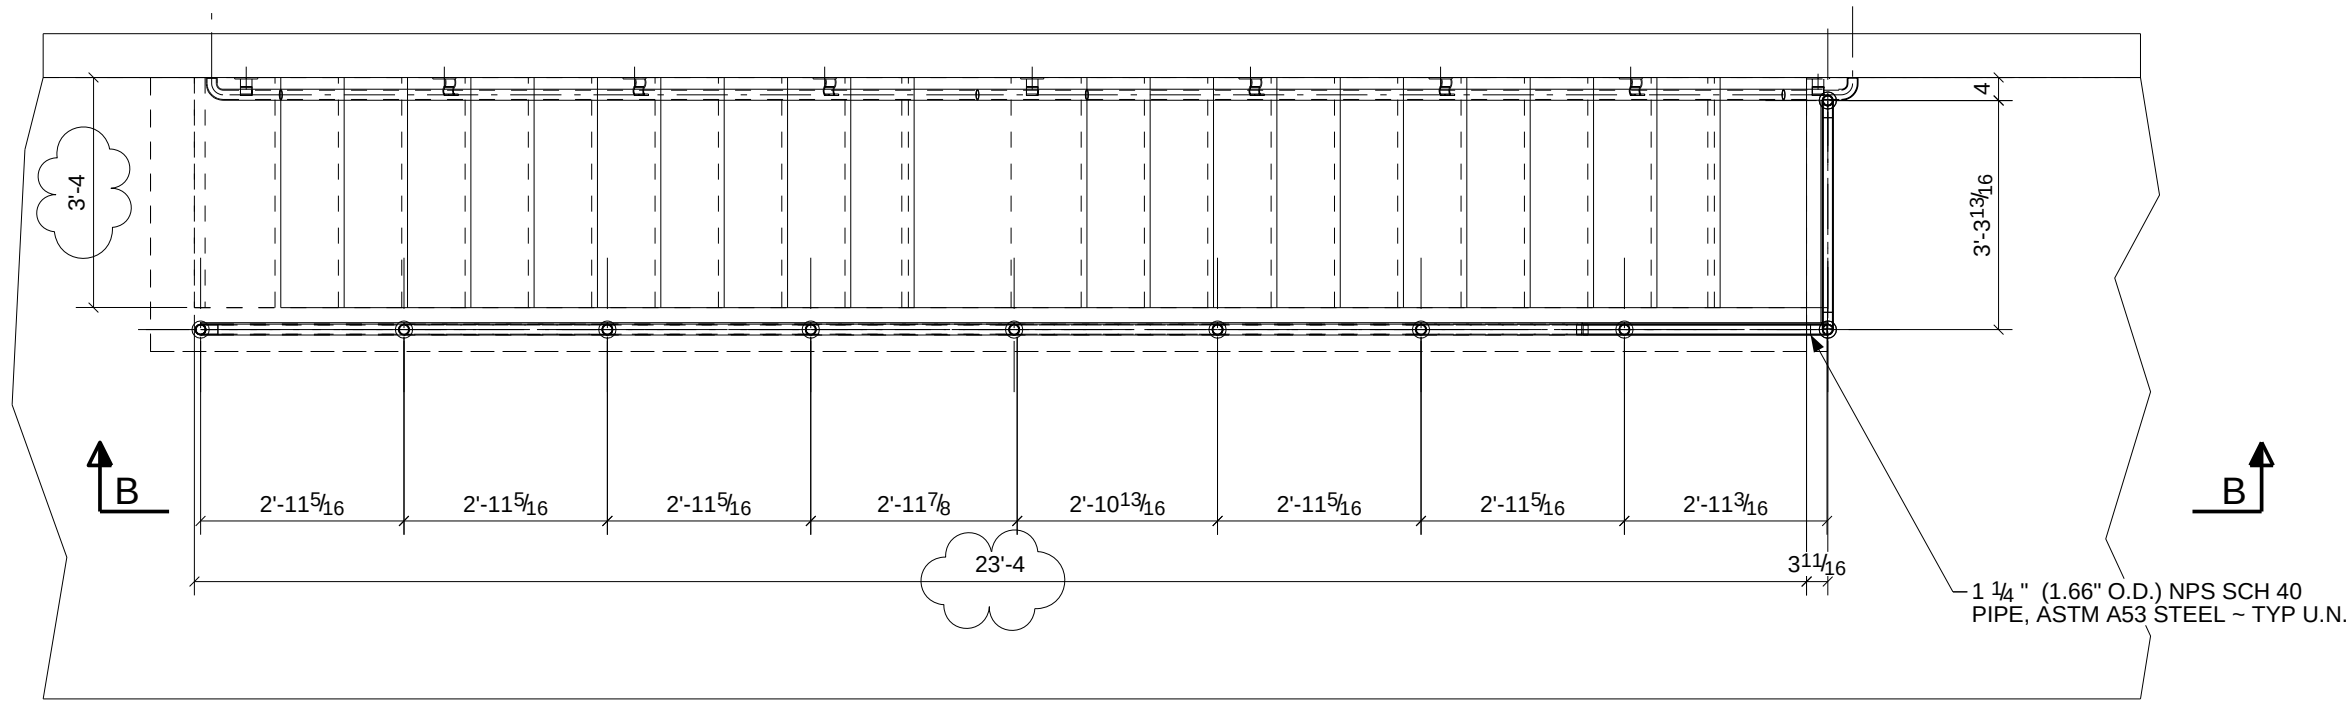


PLAN ~ STAIR S-14 ~ RAILING


FABRICATOR SHOULD CHECK ALL EXISTING STAIRS & WALLS AND FIELD VERIFY MEASUREMENTS AND MARK UP RETURNED SUBMITTALS TO DETAILER BEFORE RELEASING FOR FABRICATION.

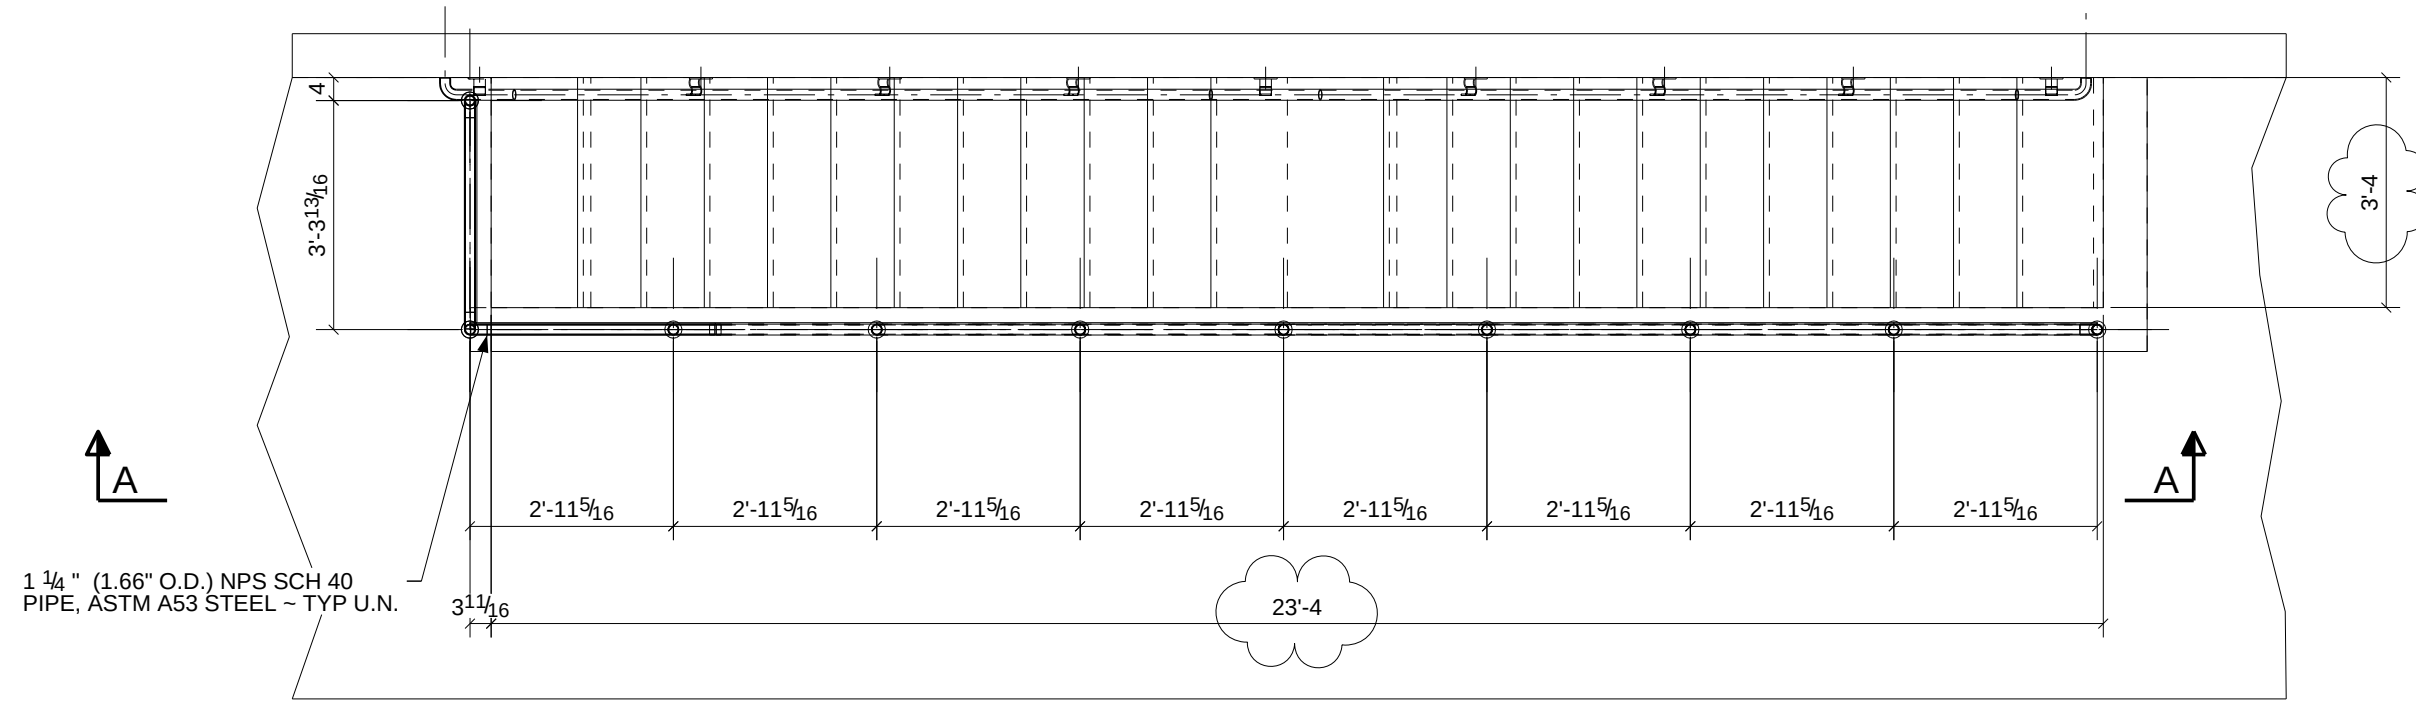


PLAN ~ STAIR S-11 ~ RAILING

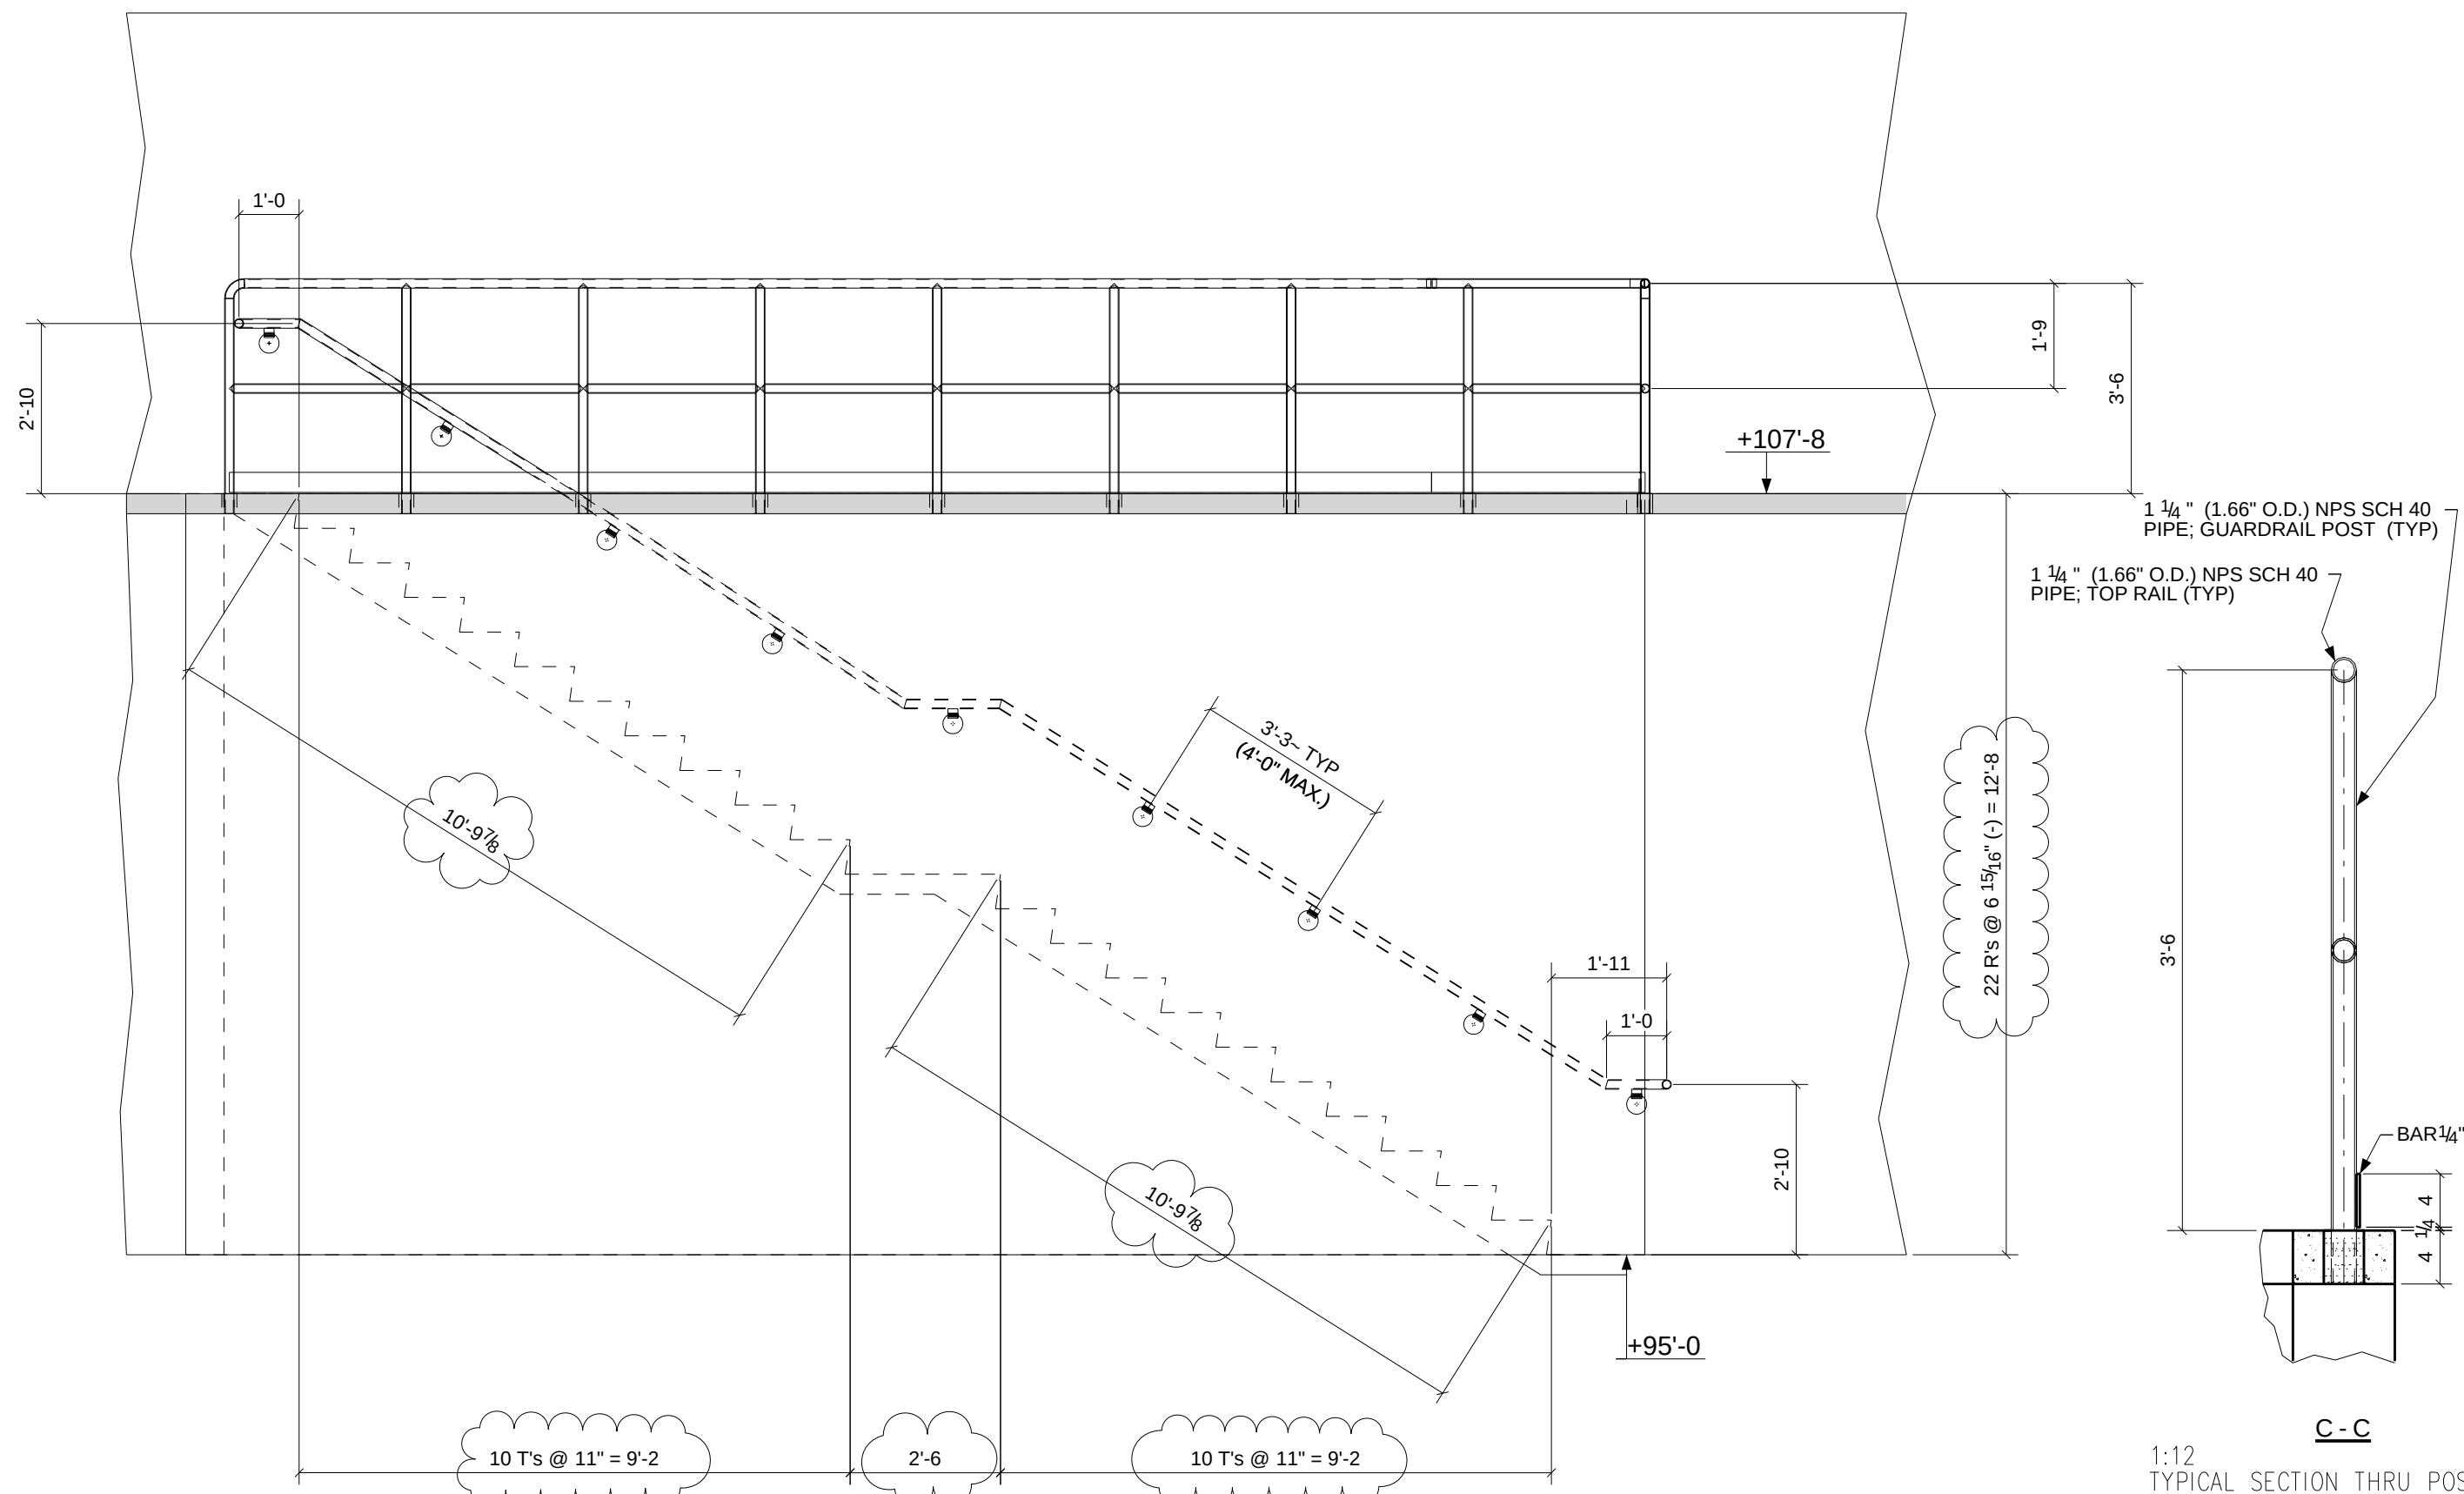

SECTION B - B

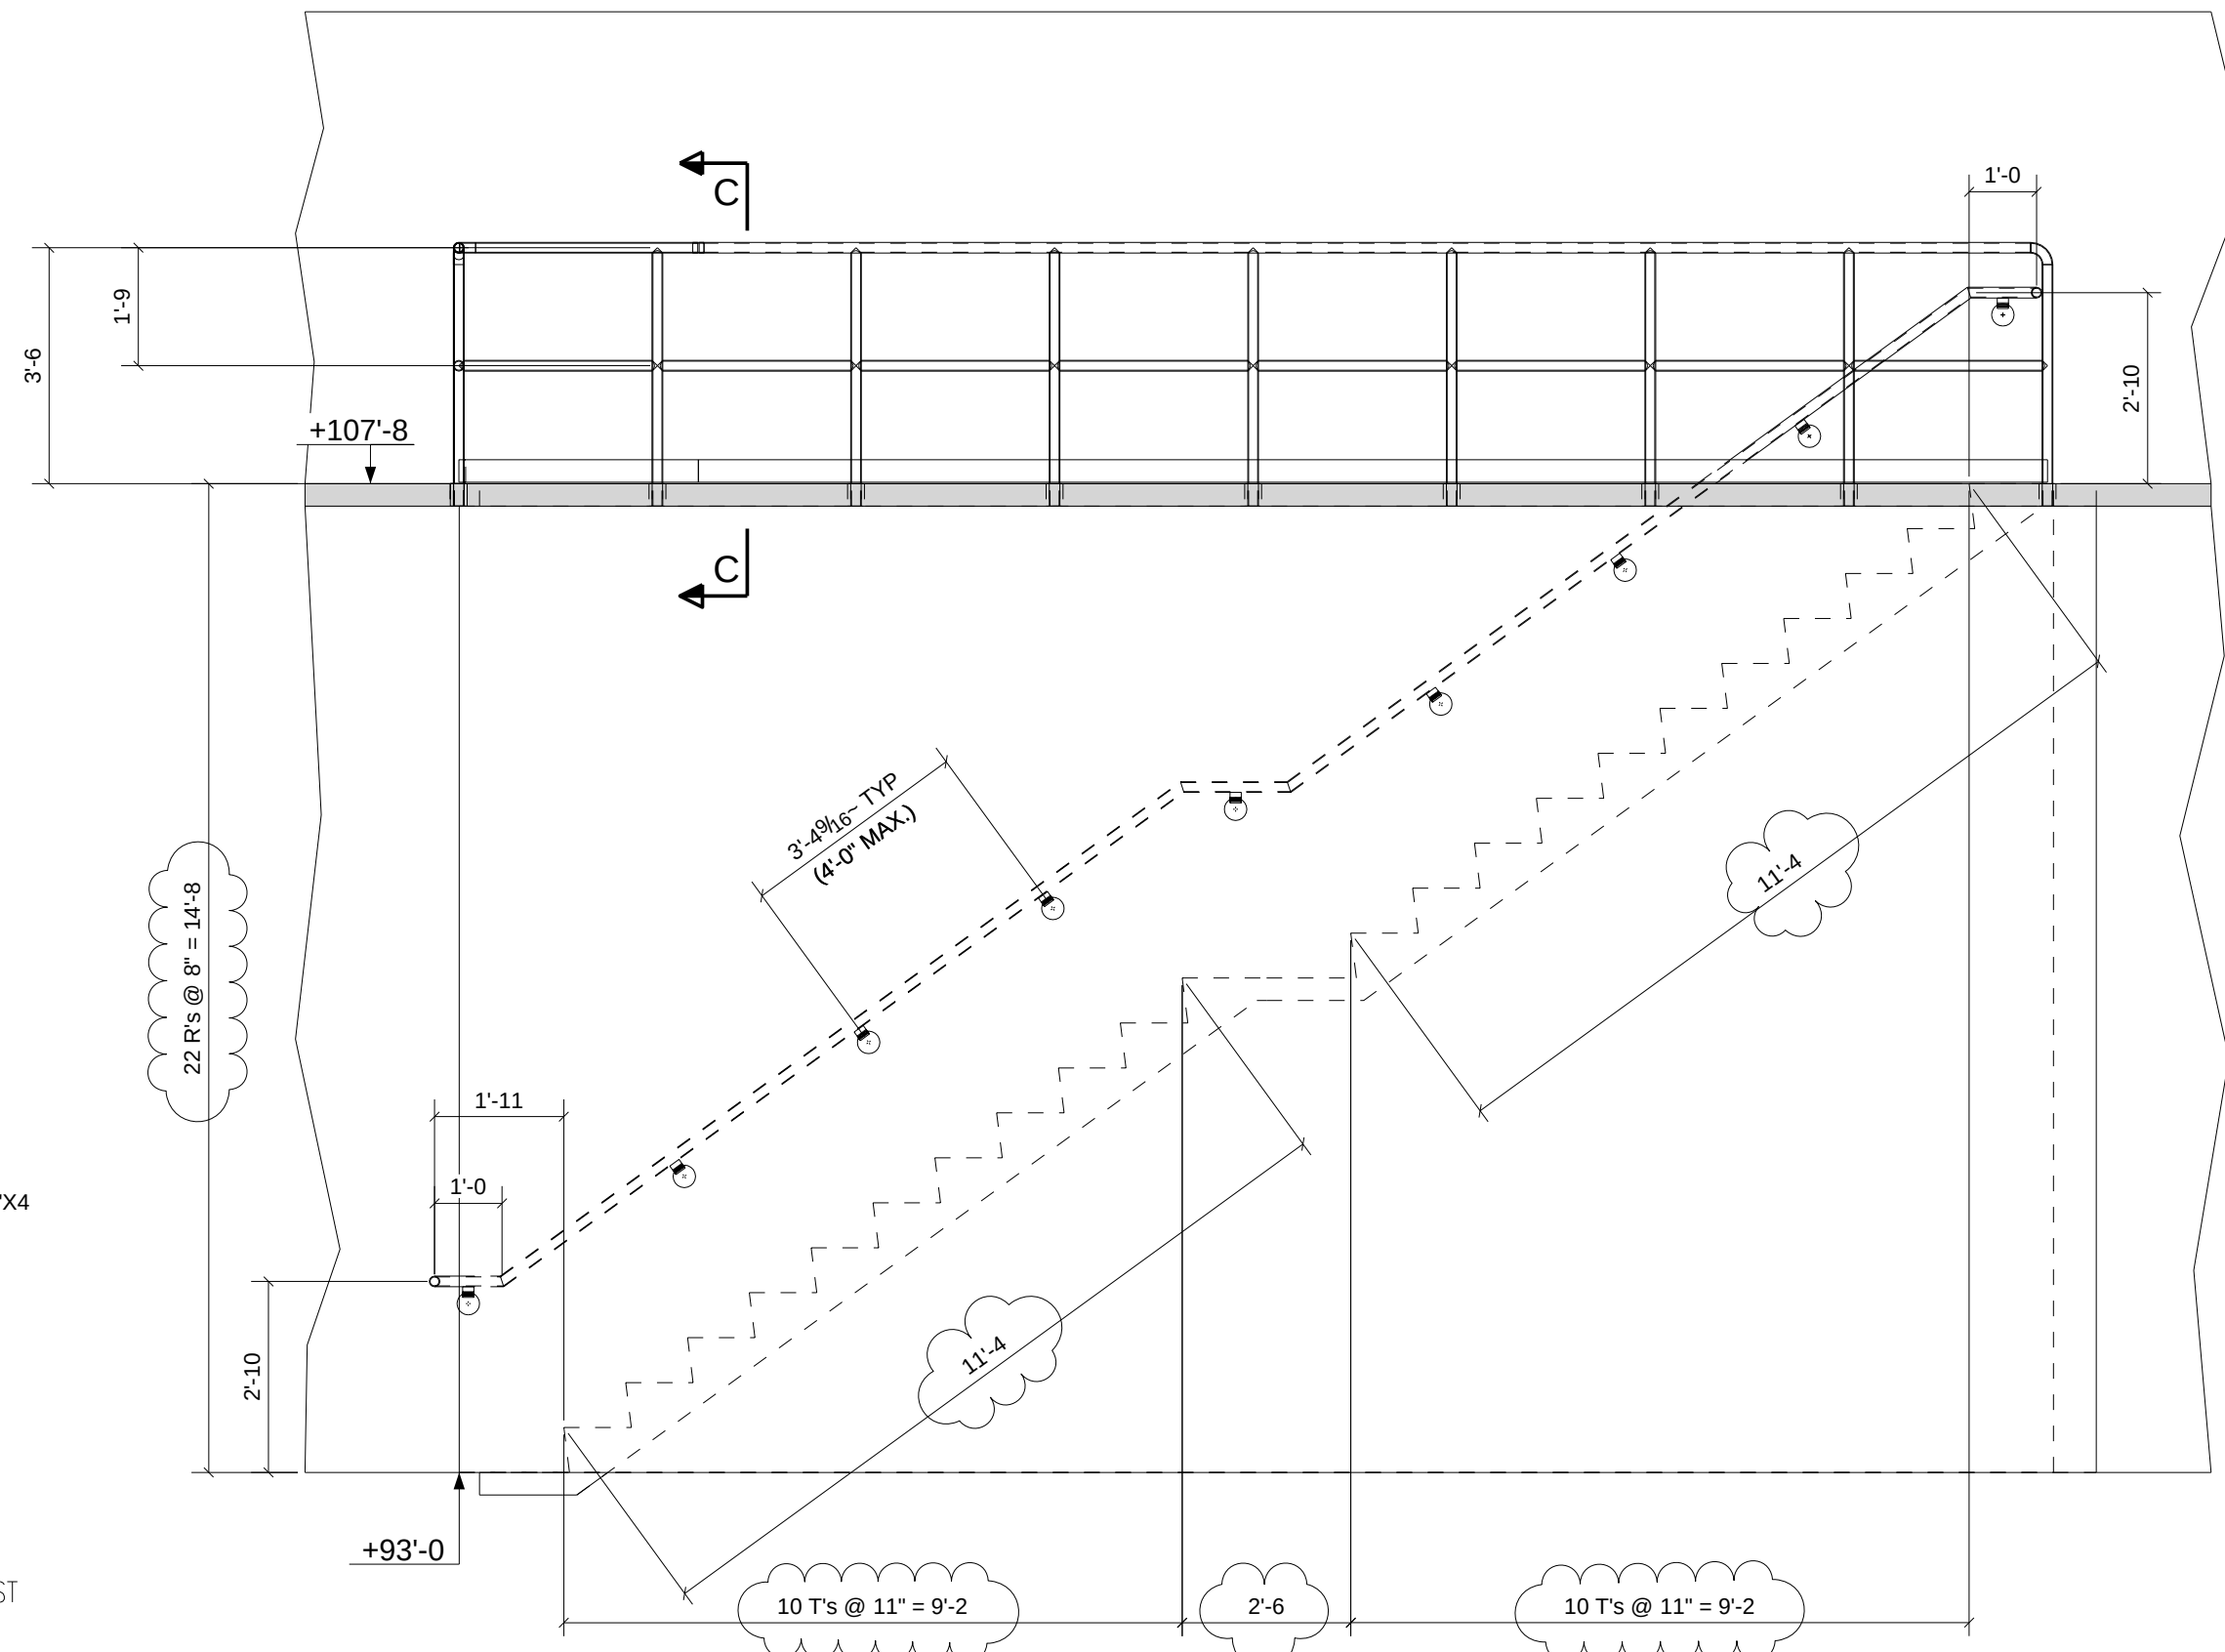

SECTION A - A

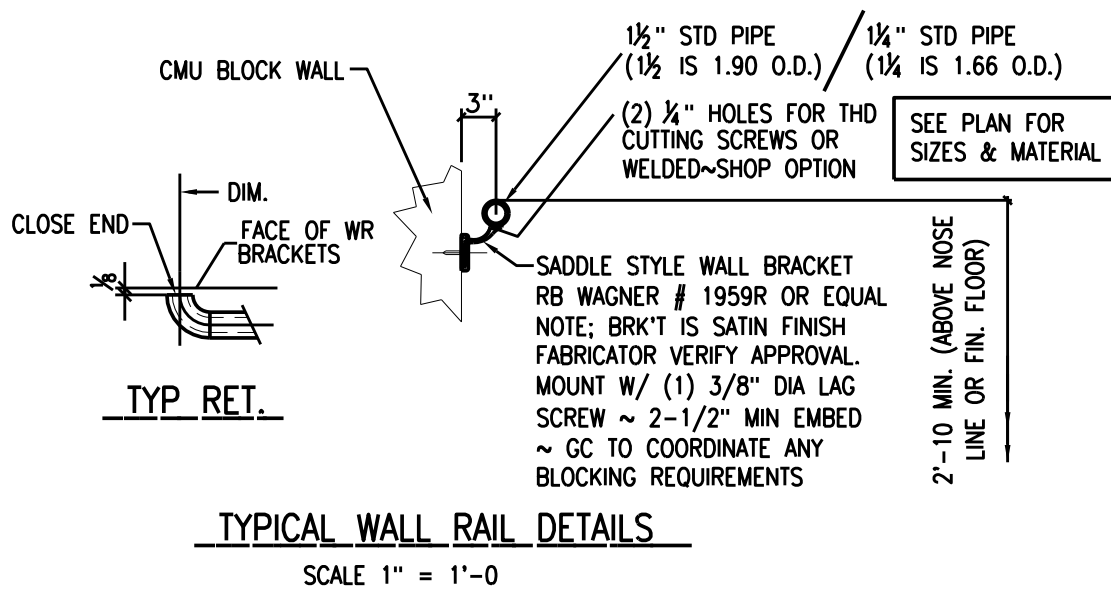

DRAWINGS PREPARED BY DETAILER FROM INFORMATION CONTAINED IN THE PROJECT DOCUMENTS WITH INSTRUCTIONS FROM THE FABRICATOR. DETAILER IS NOT RESPONSIBLE FOR ANY DESIGN, ENGINEERING OR CODE ISSUES WHICH MAY ARISE FROM THE USE OF THESE DRAWINGS. APPROVALS SHOULD BE OBTAINED FROM THE OWNER, ARCHITECT, ENGINEER, CONTRACTOR, WHICH EVER IS APPLICABLE. THE FABRICATOR SHOULD CHECK THE DETAIL DOCUMENTS FOR CORRECTNESS BEFORE RELEASING FOR FABRICATION. THE USE OF THE DETAILED DRAWINGS FOR FABRICATION CONSTITUTES ACCEPTANCE AND APPROVAL OF THE DRAWINGS, MATERIAL LIST OR CUT LIST, WHICH EVER APPLIES.



This project shall be erected in accordance with Section 7 of the NEC Code of Standard Practice, which includes 7.14 Connection of Erection, that states the following: The connection of metal shall be made by riveting, welding or bolting, and the welding of elements into the wall shall not be considered to be normal erection operations. Erection that cannot be corrected using the foregoing means, or that require major changes in member or connection configuration, shall be promptly reported to the architect representative for design and construction, and the fabricator shall be responsible for the correction. The architect representative shall be responsible for the most efficient and economical method of correction to be used by others.

All fasteners to be made with E70xx low hydrogen electrodes.


A		For Approval & Field Survey		10/12/10	TMc	TAN
REV.	DESCRIPTION			DATE	DWN	CHK
GENERAL NOTES				JOB USE		
MATERIAL: A992 / A36 UN		ELECTRODES: E70XX LH	REF. DRG.			
HOLES: 13/16 DIA. UN		CONNS: -		SHOP		
SURFACE PREP. AND PAINT:				APPROVAL		
SSPC-SP-2						
GREY PRIMER DEVCOE NA-195 (U.N.)						
DESCRIPTION: STAIR RAIL S-11 & S-14						
PROJ. NAME		Hamilton High School Phase III			DRAWN BY TMc	
LOCATION		Hamilton City School District - Hamilton, OH			DATE 10/12/2010	
CONTRACTOR GC Contracting		ARCH./ENG. SHP			CHKD. BY TAN	
					DATE	
		Avenue Fabricating Inc.			JOB NO.	
		1281 Clough Pike			10-16	
		Batavia, OH 45103			DRG. NO.	
		(513) 752-1911			E109	
					REV. A	

SECTION B - B

A				For Approval & Field Survey				10/12/10		TMC		TAN	
REV.		DESCRIPTION						DATE		DWN		CHK	
GENERAL NOTES MATERIAL: A992 / A36 UN ELECTRODES: E70XX LH REF. DRG. HOLES: 13/16 DIA. UN CONNS: - SURFACE PREP: AND PAINT: SSPC-SP-2 GREY PRIMER DEVCOE NA-195 (U.N.)										JOB USE			
										SHOP			
										APPROVAL			
DESCRIPTION: PLAN – MECH ROOM 102 – REMOVABLE GUARDRAIL													
PROJ. NAME		Hamilton High School Phase III											
LOCATION		Hamilton City School District - Hamilton, OH											
CONTRACTOR GC Contracting ARCH./ENG. SHP													
		Avenue Fabricating Inc. 1281 Clough Pike Batavia, OH 45103 (513) 752-1911								DRAWN BY		TMC	
										DATE		10/13/2010	
										CHKD. BY		TAN	
								DATE					
								JOB NO.		10-16			
								DRG. No.		REV. A			
								E110					

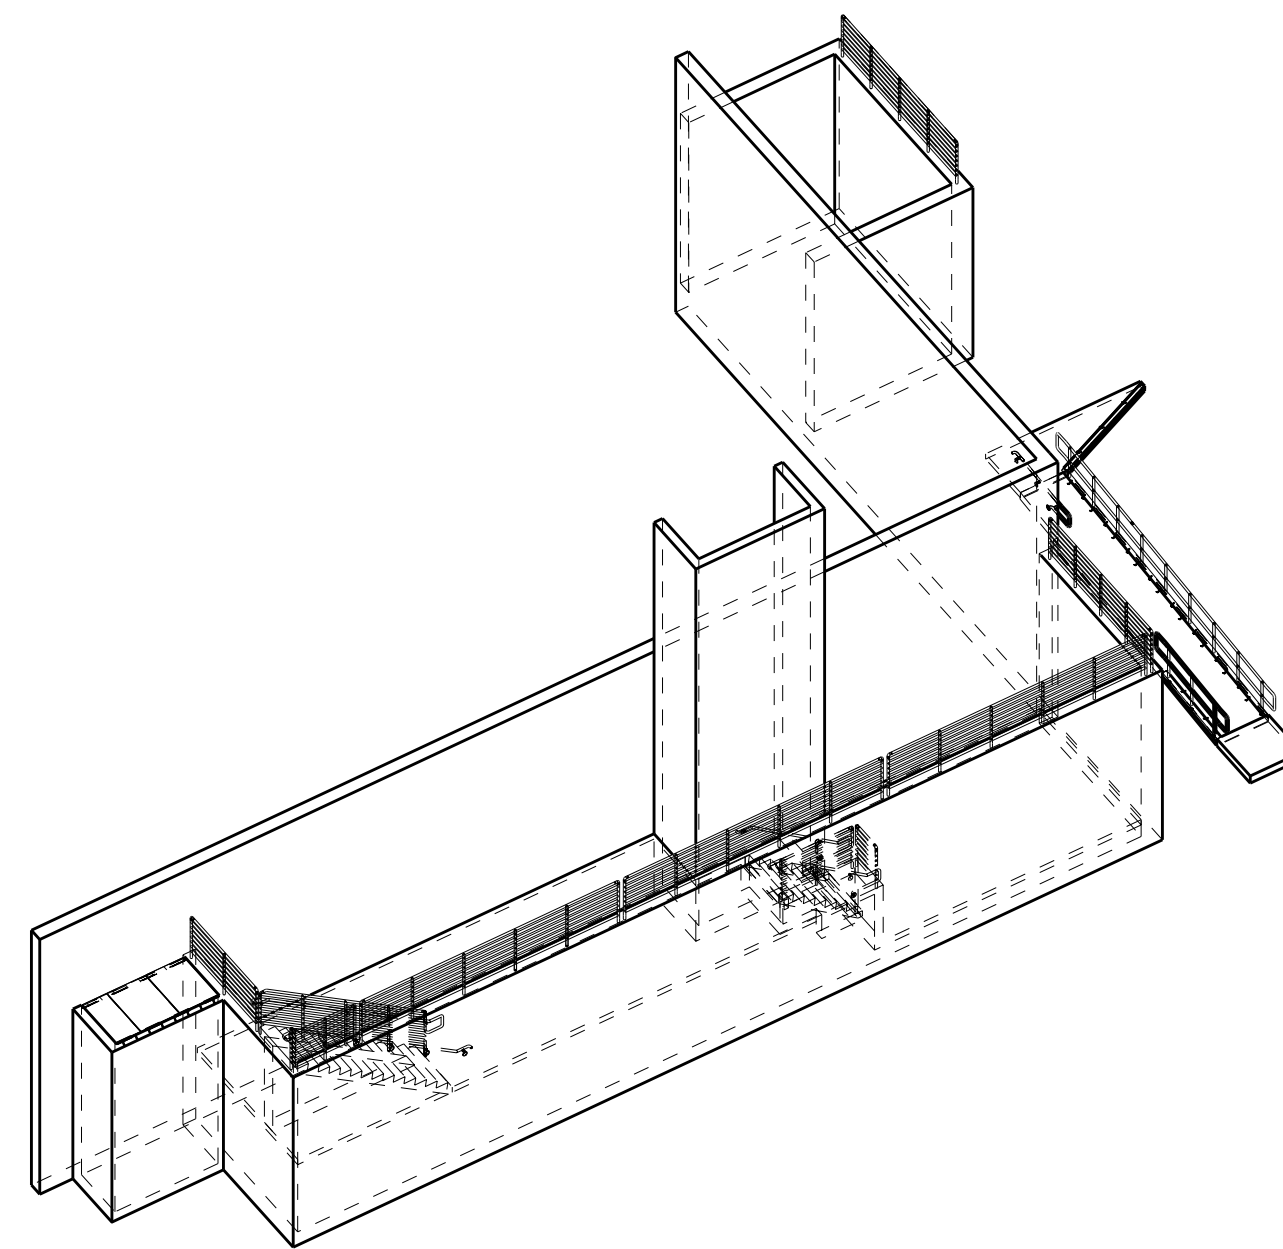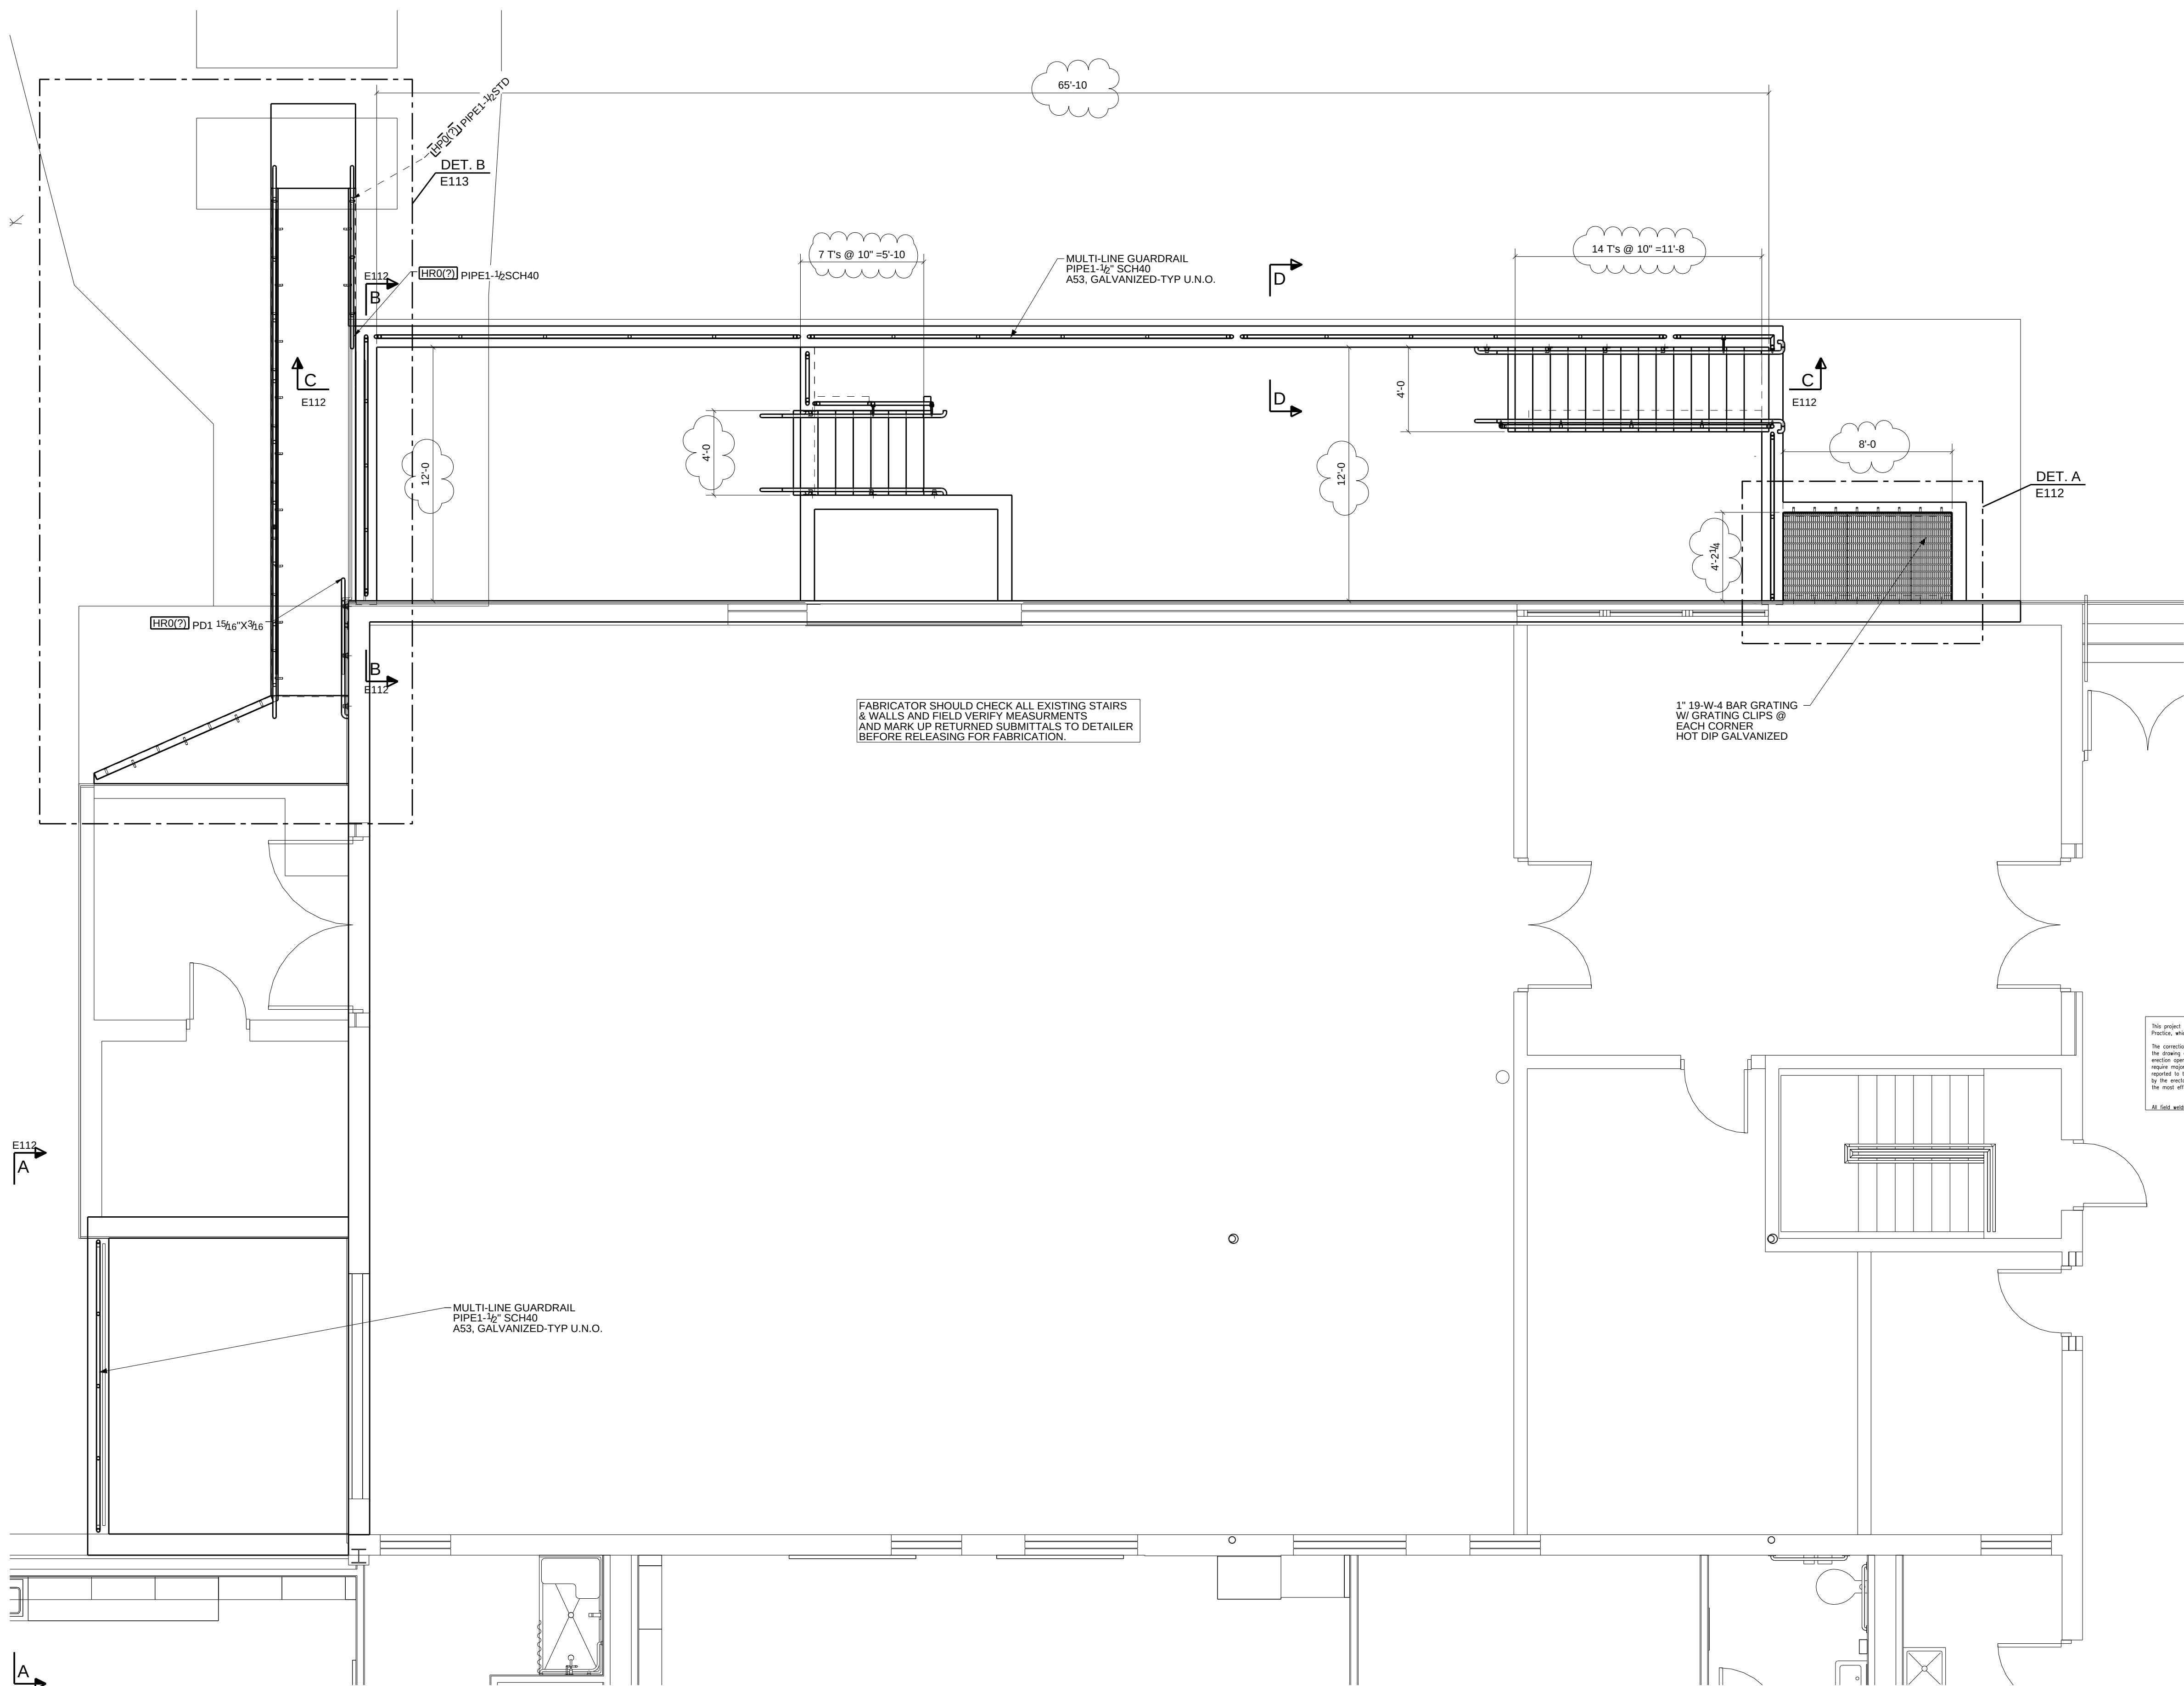

PERSPECTIVE VIEW

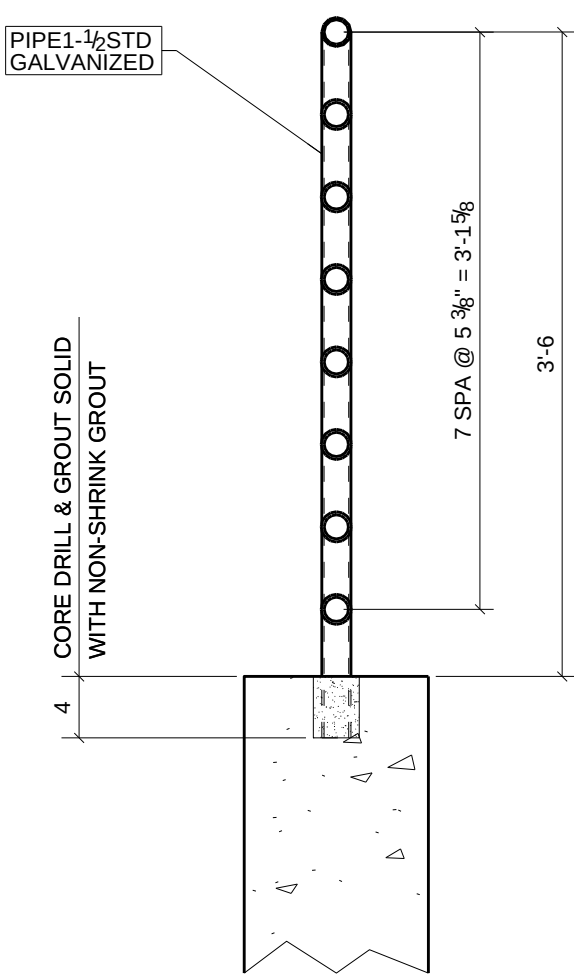


SECTION D - D
TYPICAL SECTION THRU GUARDRAIL

1-12
DRAWINGS PREPARED BY DETAILER FROM INFORMATION CONTAINED IN THE PROJECT DOCUMENTS WITH INSTRUCTIONS FROM THE FABRICATOR. DETAILER IS NOT RESPONSIBLE FOR ANY DESIGN, ENGINEERING OR CODE ISSUES WHICH MAY ARISE FROM THE USE OF THESE DRAWINGS. APPROVALS SHOULD BE OBTAINED FROM THE OWNER, ARCHITECT, ENGINEER, CONTRACTOR, WHICH EVER IS APPLICABLE. THE FABRICATOR SHOULD CHECK THE DETAIL DOCUMENTS FOR CORRECTNESS BEFORE RELEASING FOR FABRICATION. THE USE OF THE DETAILED DRAWINGS FOR FABRICATION CONSTITUTES ACCEPTANCE AND APPROVAL OF THE DRAWINGS, MATERIAL LIST OR CUT LIST, WHICH EVER APPLIES.


PLAN ~ AREAWAY: MULTILINE RAIL & GRATING ~ A107

A		For Approval & Field Survey		10/12/18		TMG	TAN
REV.	DESCRIPTION			DATE	DWN	CHK	
GENERAL NOTES					JOB USE		
MATERIAL: A992 / A36 UN		ELECTRODES: E70XX LH		REF. DRG.			
HOLES: 13/16 DIA. UN		CONNS: -		SHOP			
SURFACE PREP.					APPROVAL		
AND PAINT:							
SSPC-SP-2							
GREY PRIMER DEVOE NA-195 (U.N.)							
DESCRIPTION: PLAN ~ AREAWAY ~ A107 & DOCK RAMP ~ C100 (1 of 3)							
PROJ. NAME		Hamilton High School Phase III					
LOCATION		Hamilton City School District - Hamilton, OH					
CONTRACTOR GC Contracting				ARCH./ENG. SHP			
		Avenue Fabricating Inc.					
		1281 Clough Pike					
		Batavia, OH 45103					
		(513) 752-1911					
							
		JOB NO. 10-16					
		DRG. No. E111					
		REV. A					

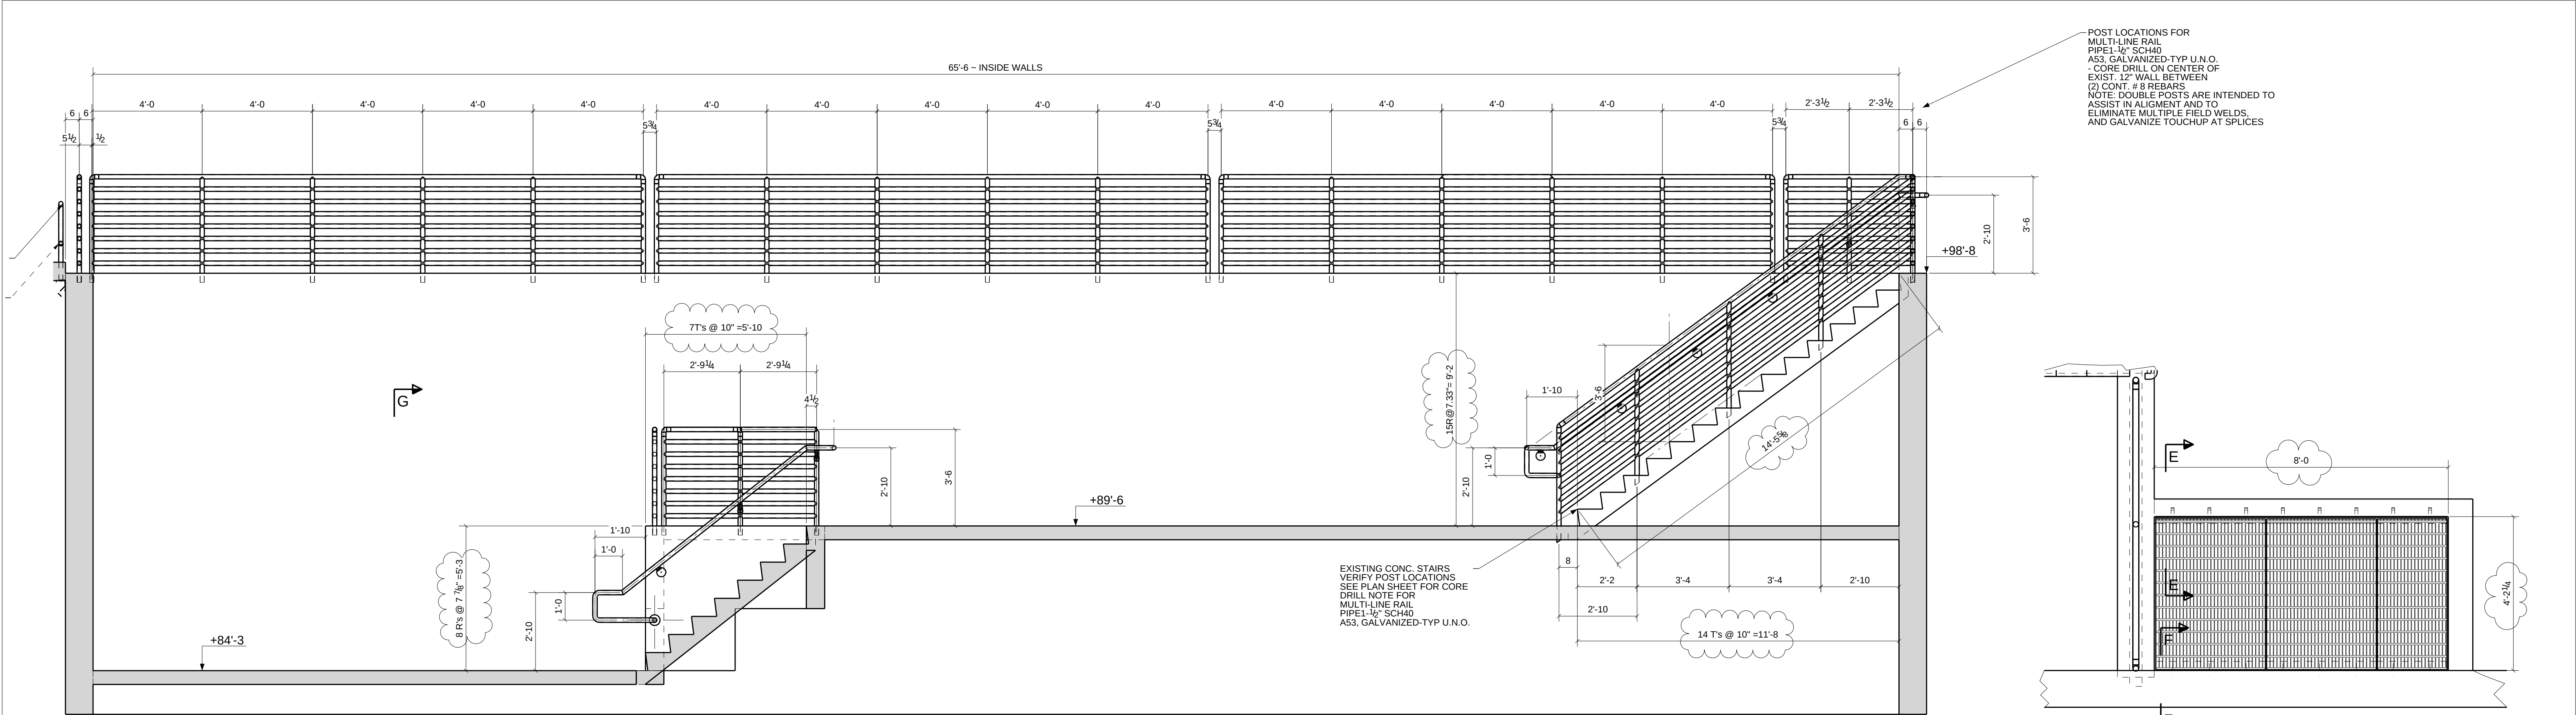


SECTION C - C

E111
1:32

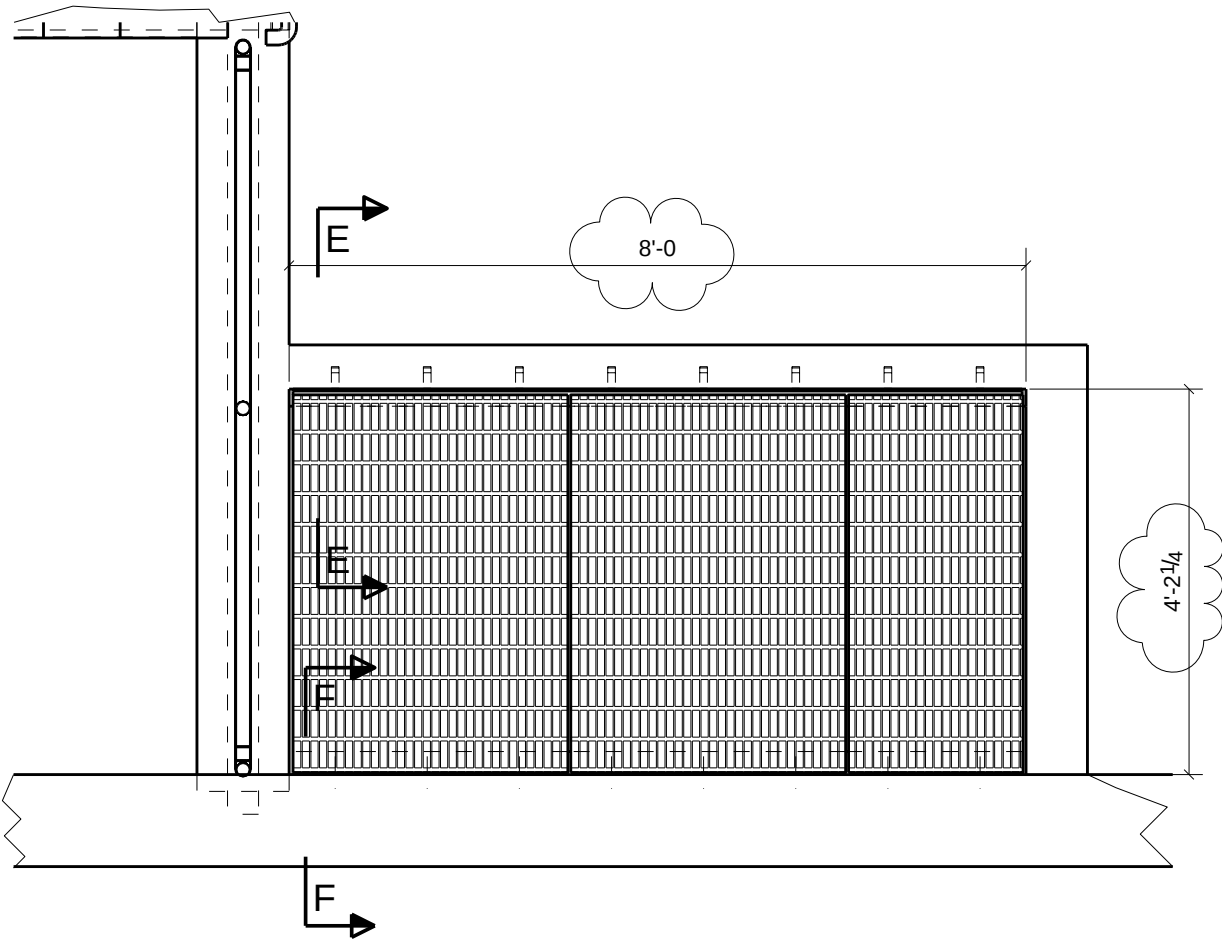


DETAILA

E111
1:24

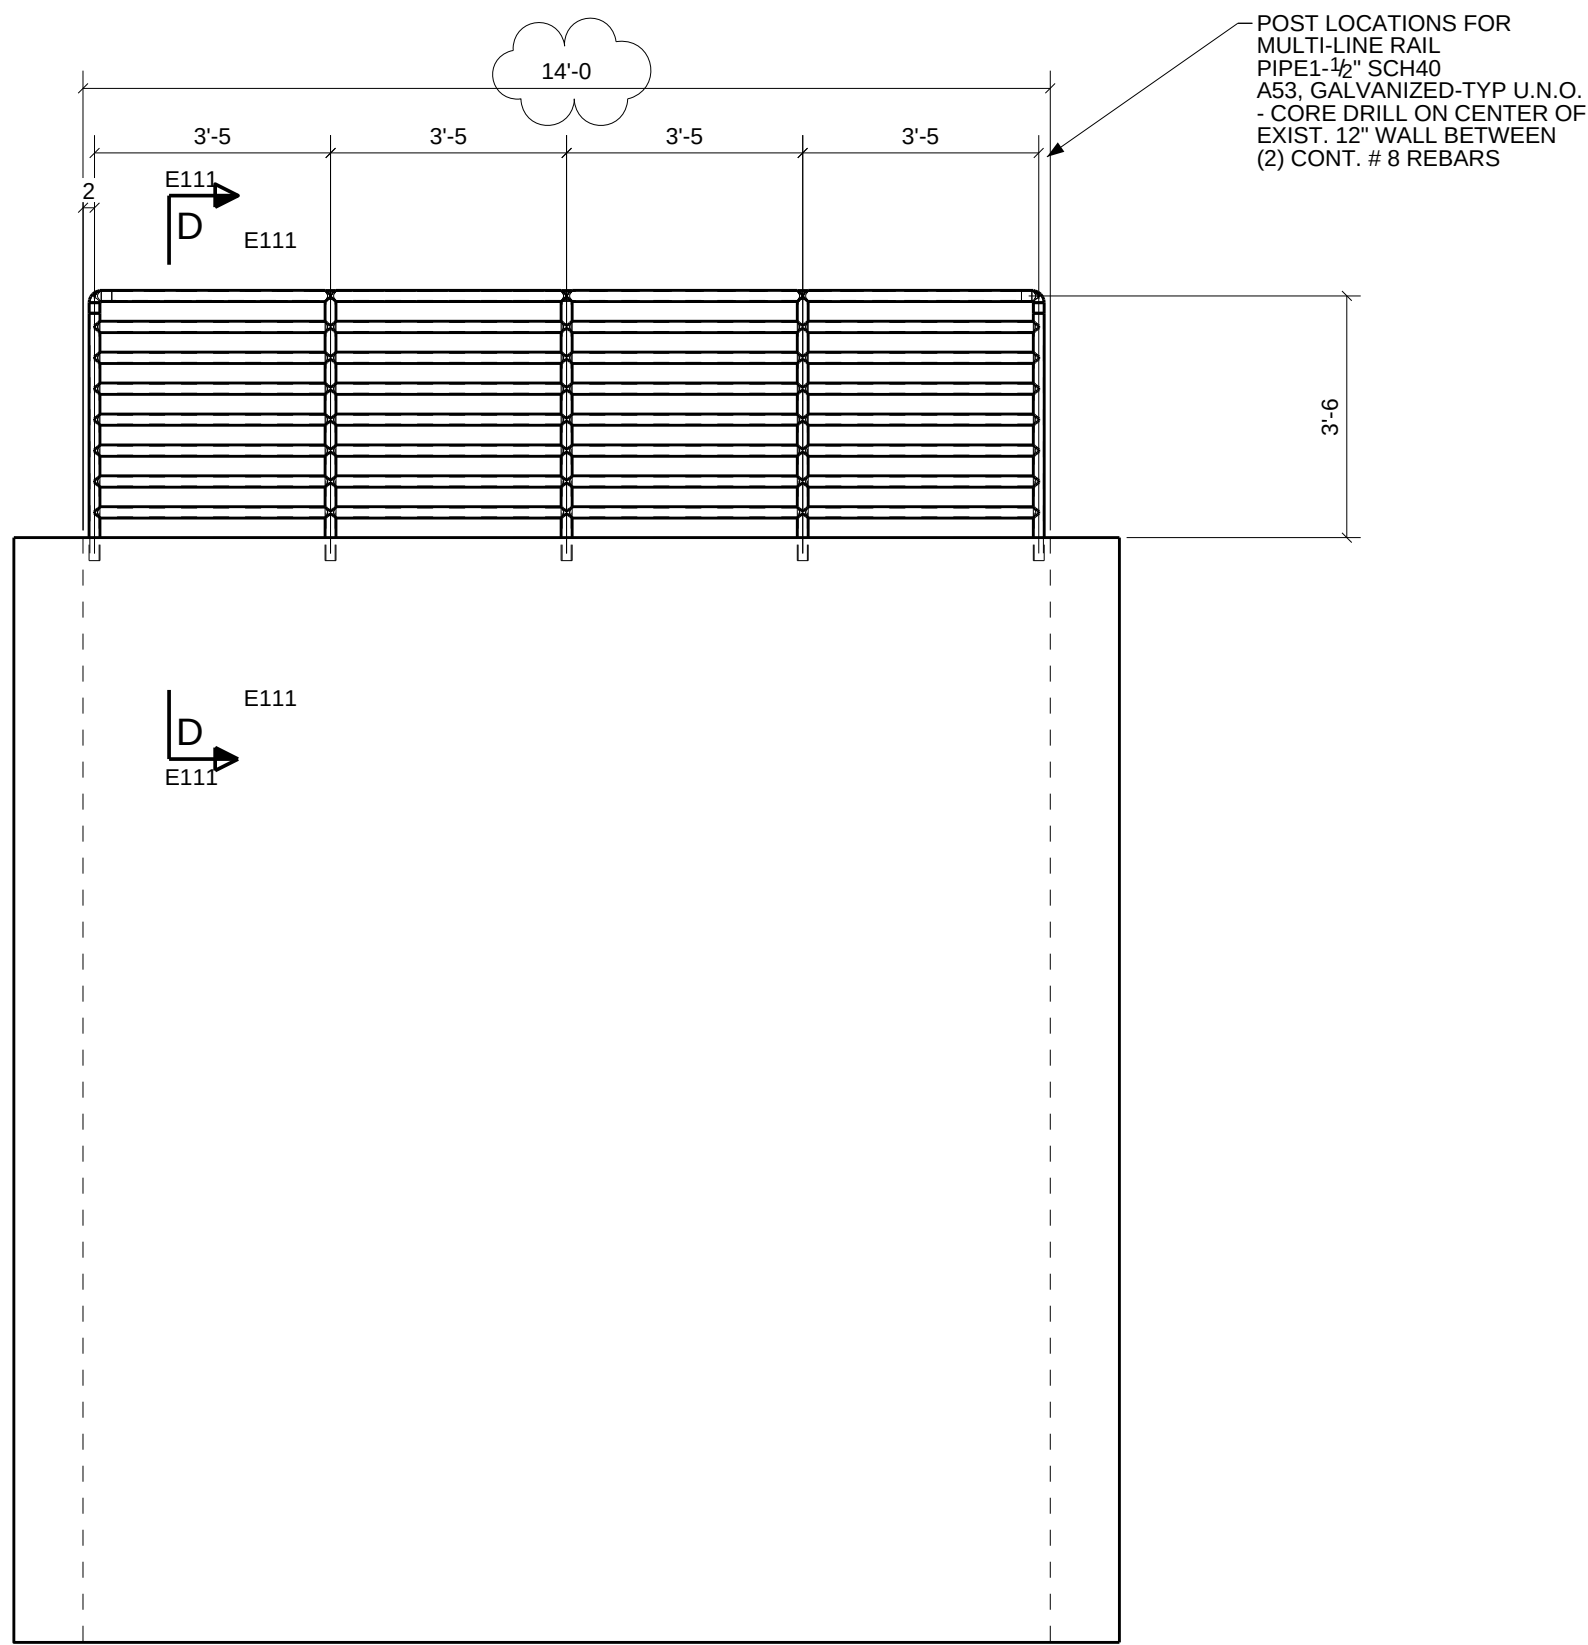


SECTION A - A

E111
1:32

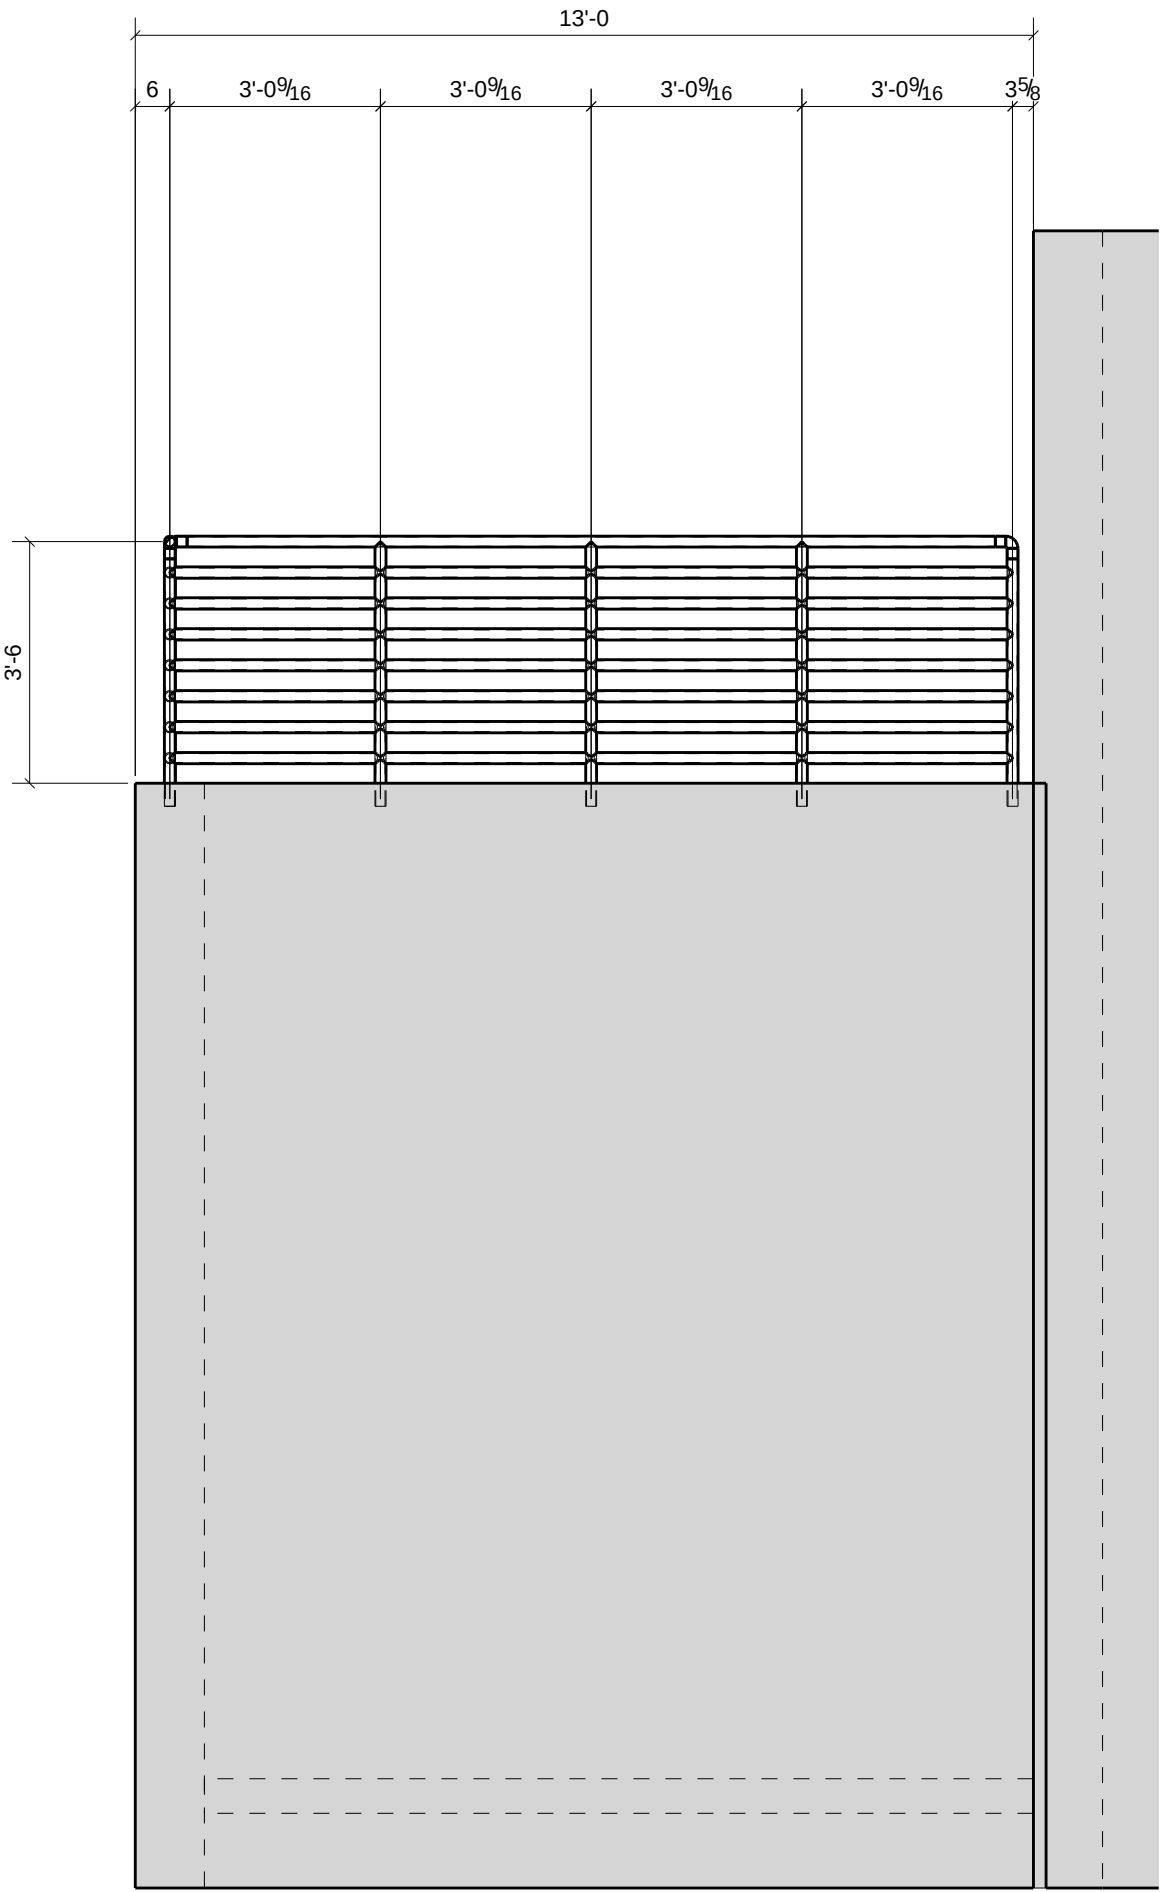


SECTION B - B

E111
1:32

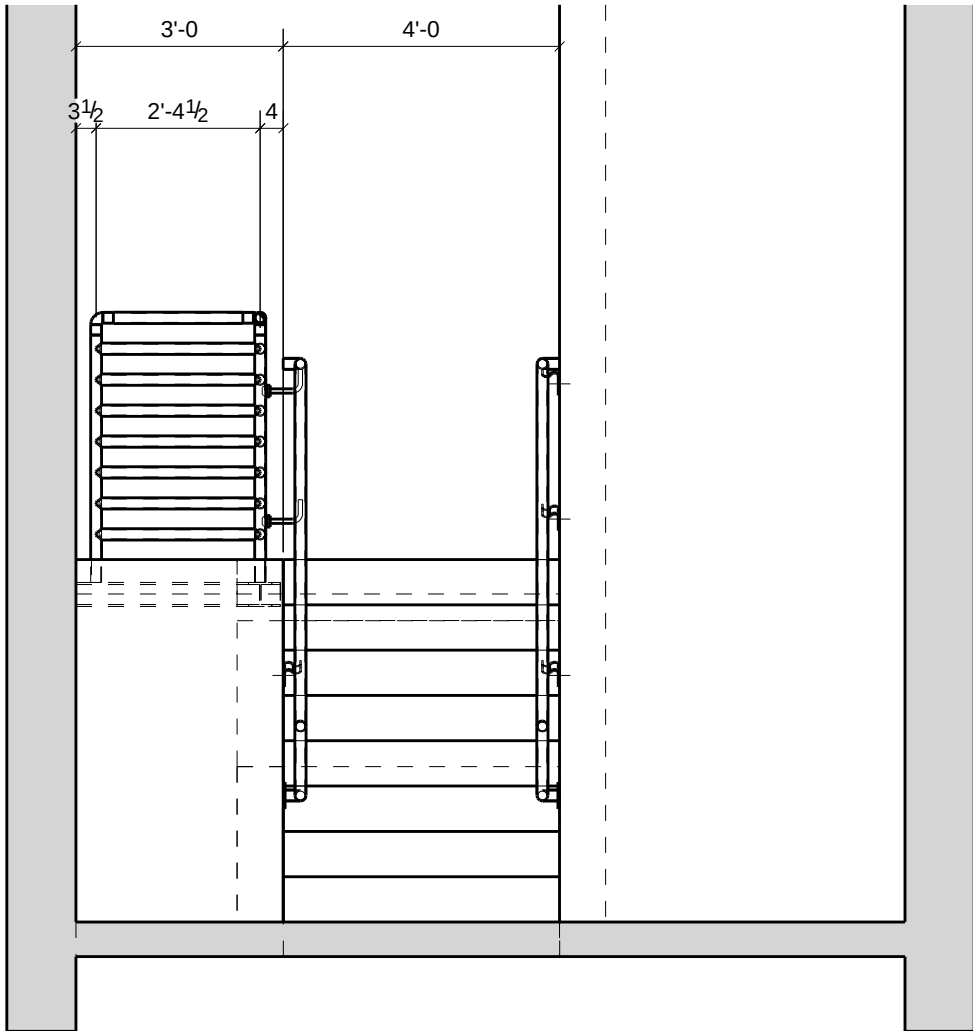


SECTION G - G

E112
1:32

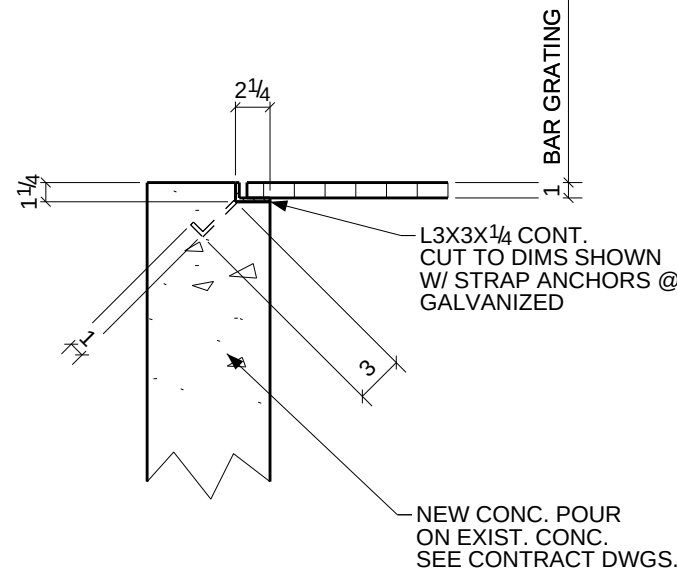

SECTION E - E


E112


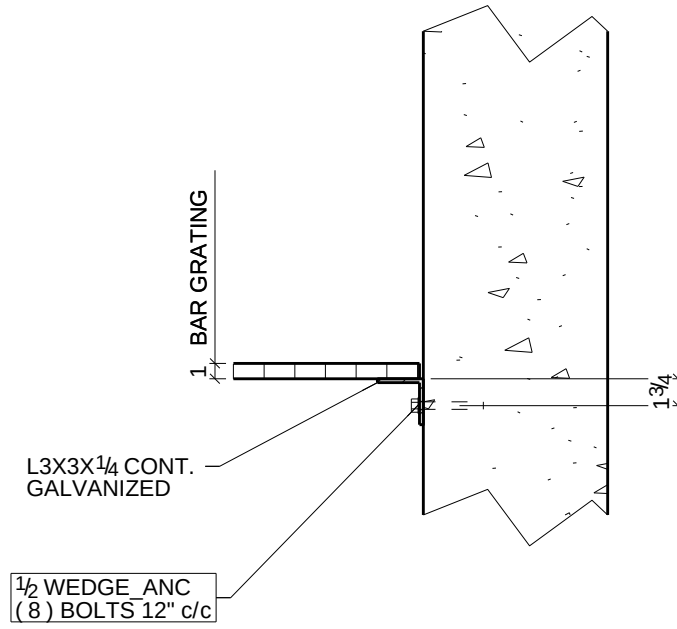


SECTION F - F

1:12

A	For Approval & Field Survey	10/12/18	TMc	TAN
REV.	DESCRIPTION	DATE	DWN	CHK
GENERAL NOTES		JOB USE		
MATERIAL: A992 / A36 UN		ELECTRODES: E70XX LH	REF. DRG.	
HOLES: 13/16 DIA. UN		CONNS: -		
SURFACE PREP. AND PAINT:			SHOP	
SSPC-SP-2			APPROVAL	
GREY PRIMER DEVOE NA-195 (U.N.)				
DESCRIPTION: PLAN ~ AREAWAY ~ A107 & DOCK RAMP ~ C100 (2 o f 3)				
PROJ. NAME Hamilton High School Phase III		DRAWN BY TMc		
LOCATION Hamilton City School District - Hamilton, OH		DATE 10/16/2010		
CONTRACTOR GC Contracting		ARCH./ENG. SHP		
Avenue Fabricating Inc.		DATE		
1281 Clough Pike		JOB No. 10-16		
Batavia, OH 45103		DRG. No. E112		
(513) 752-1911		REV. A		

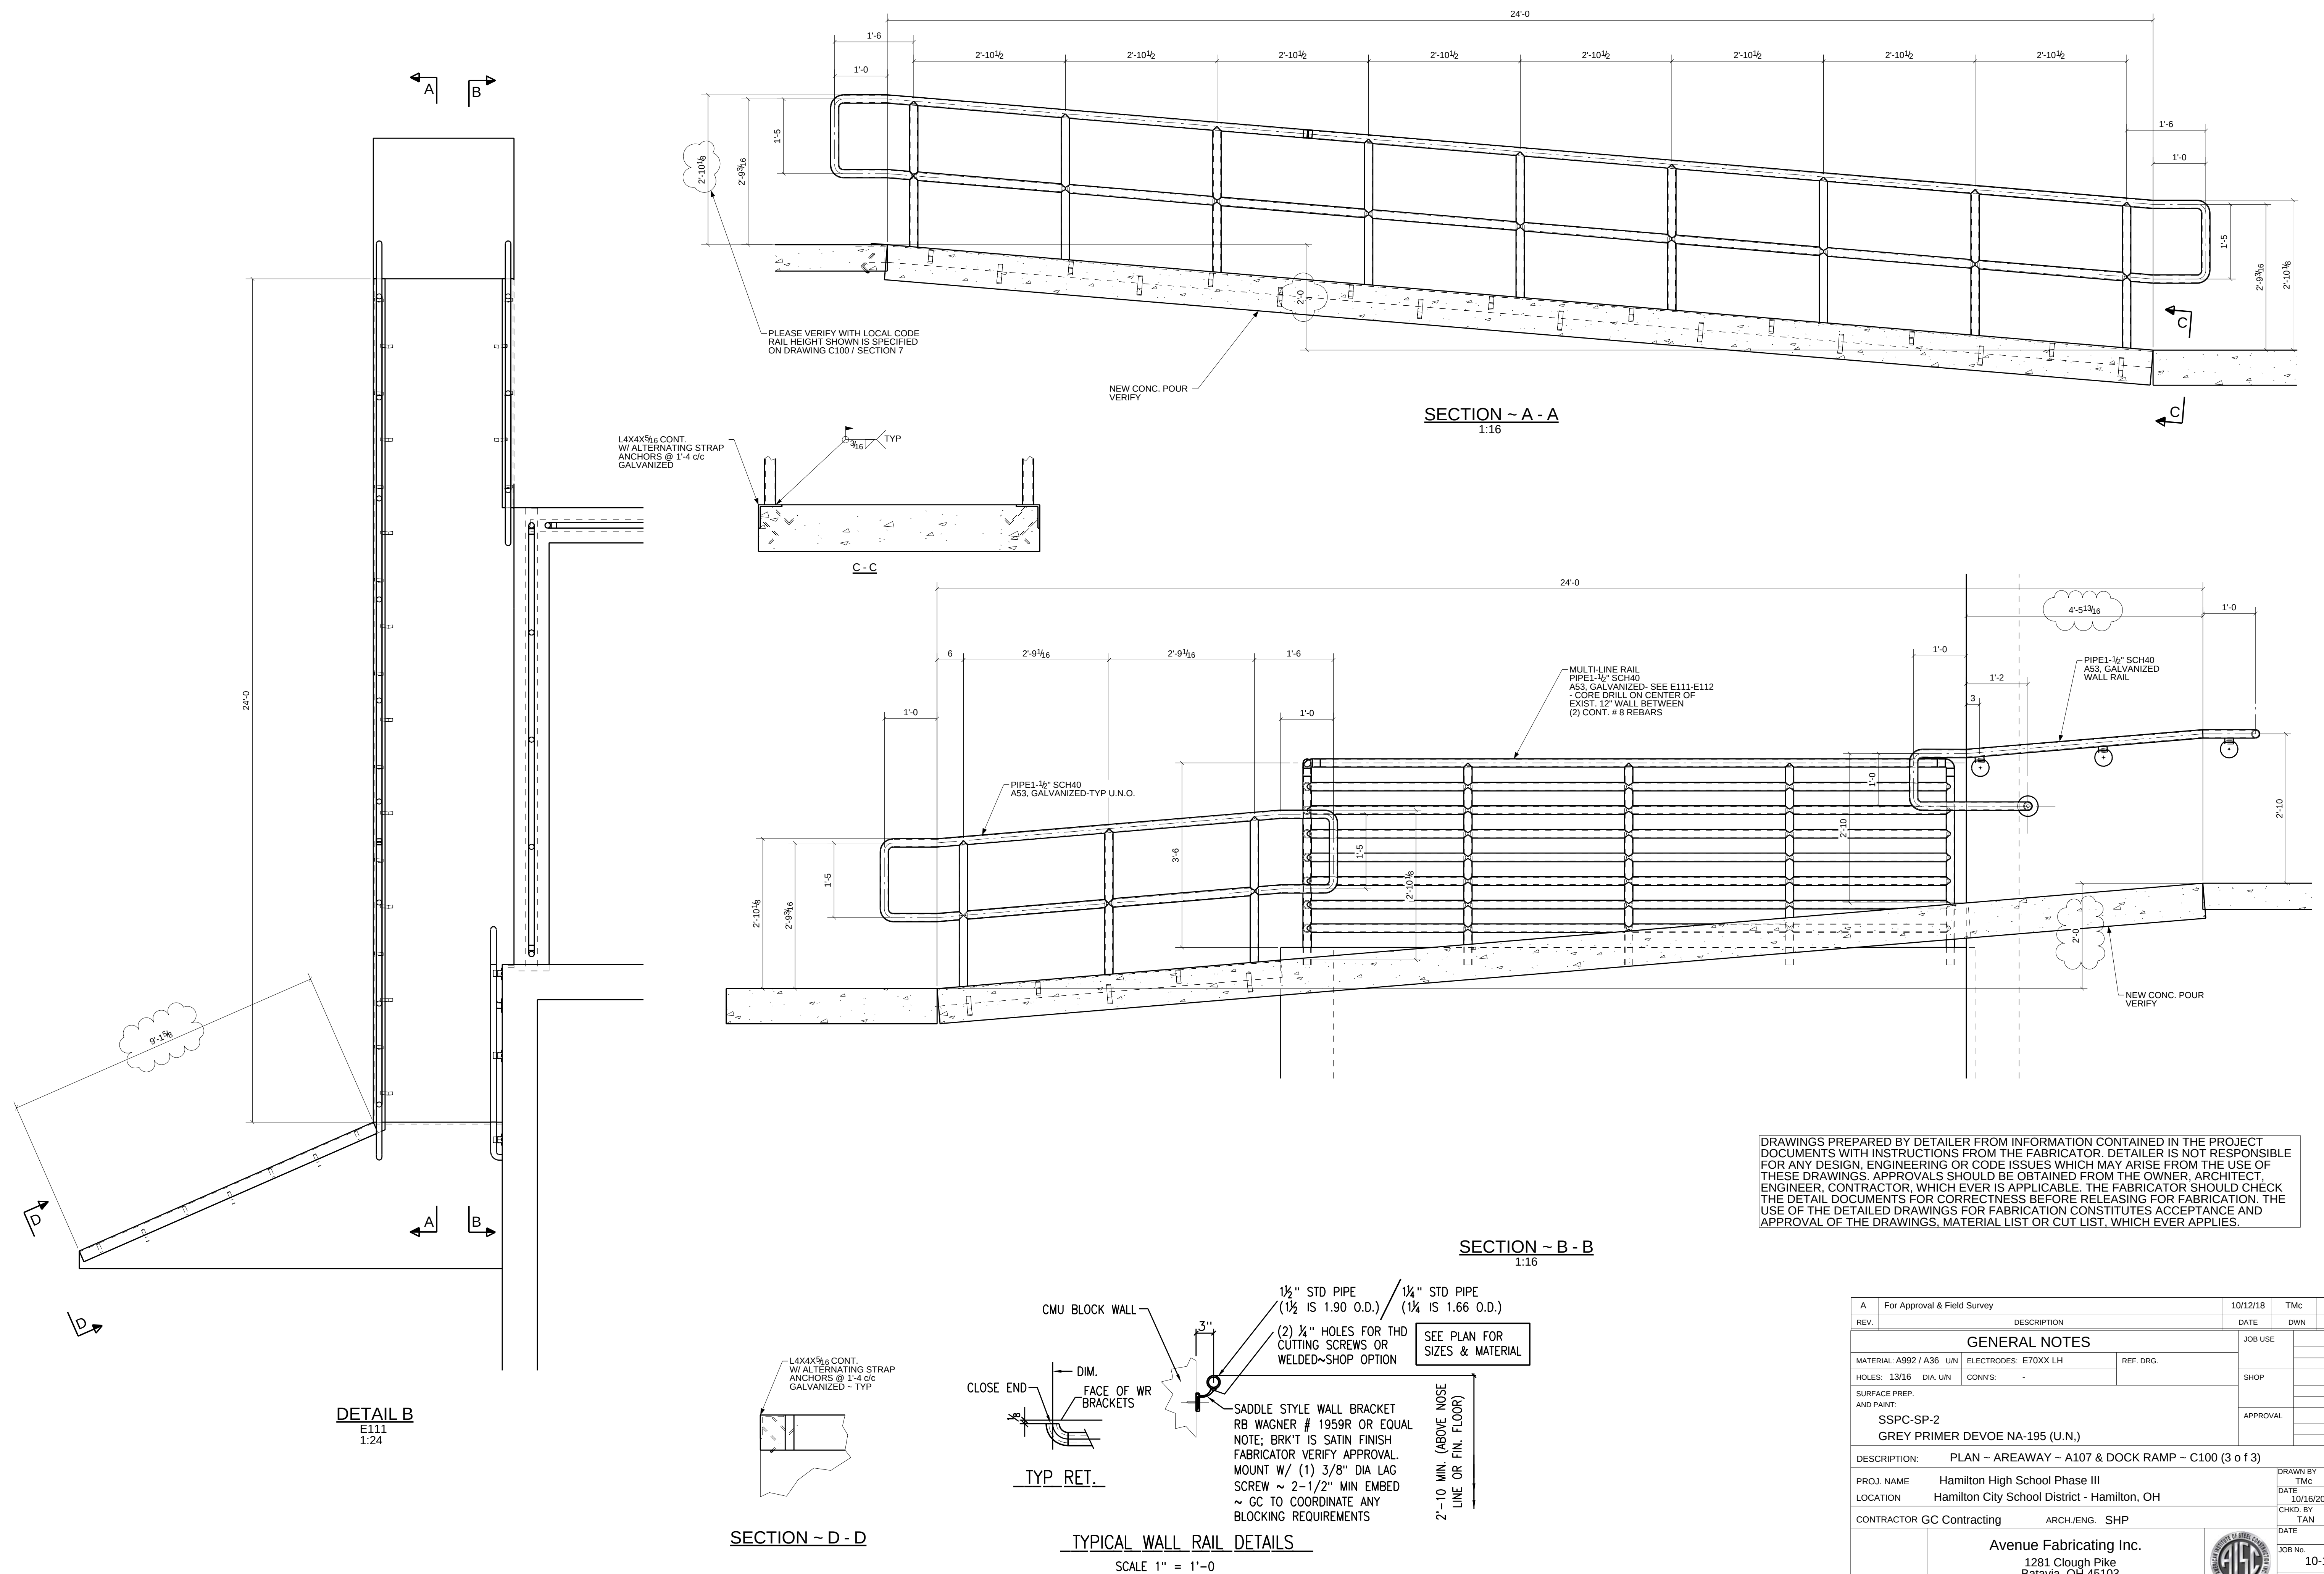


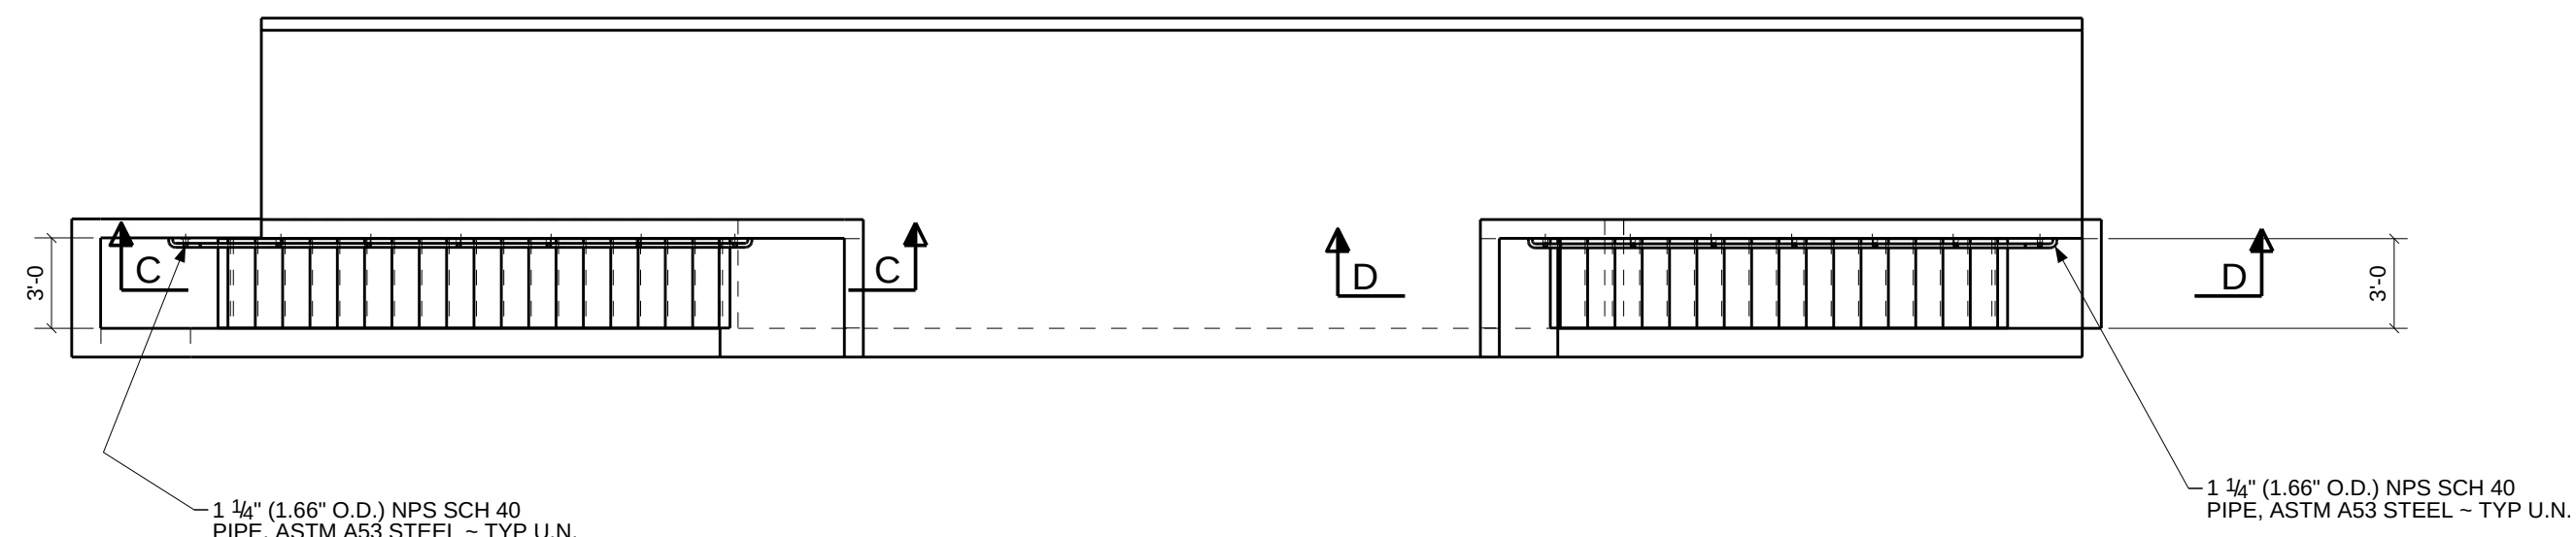
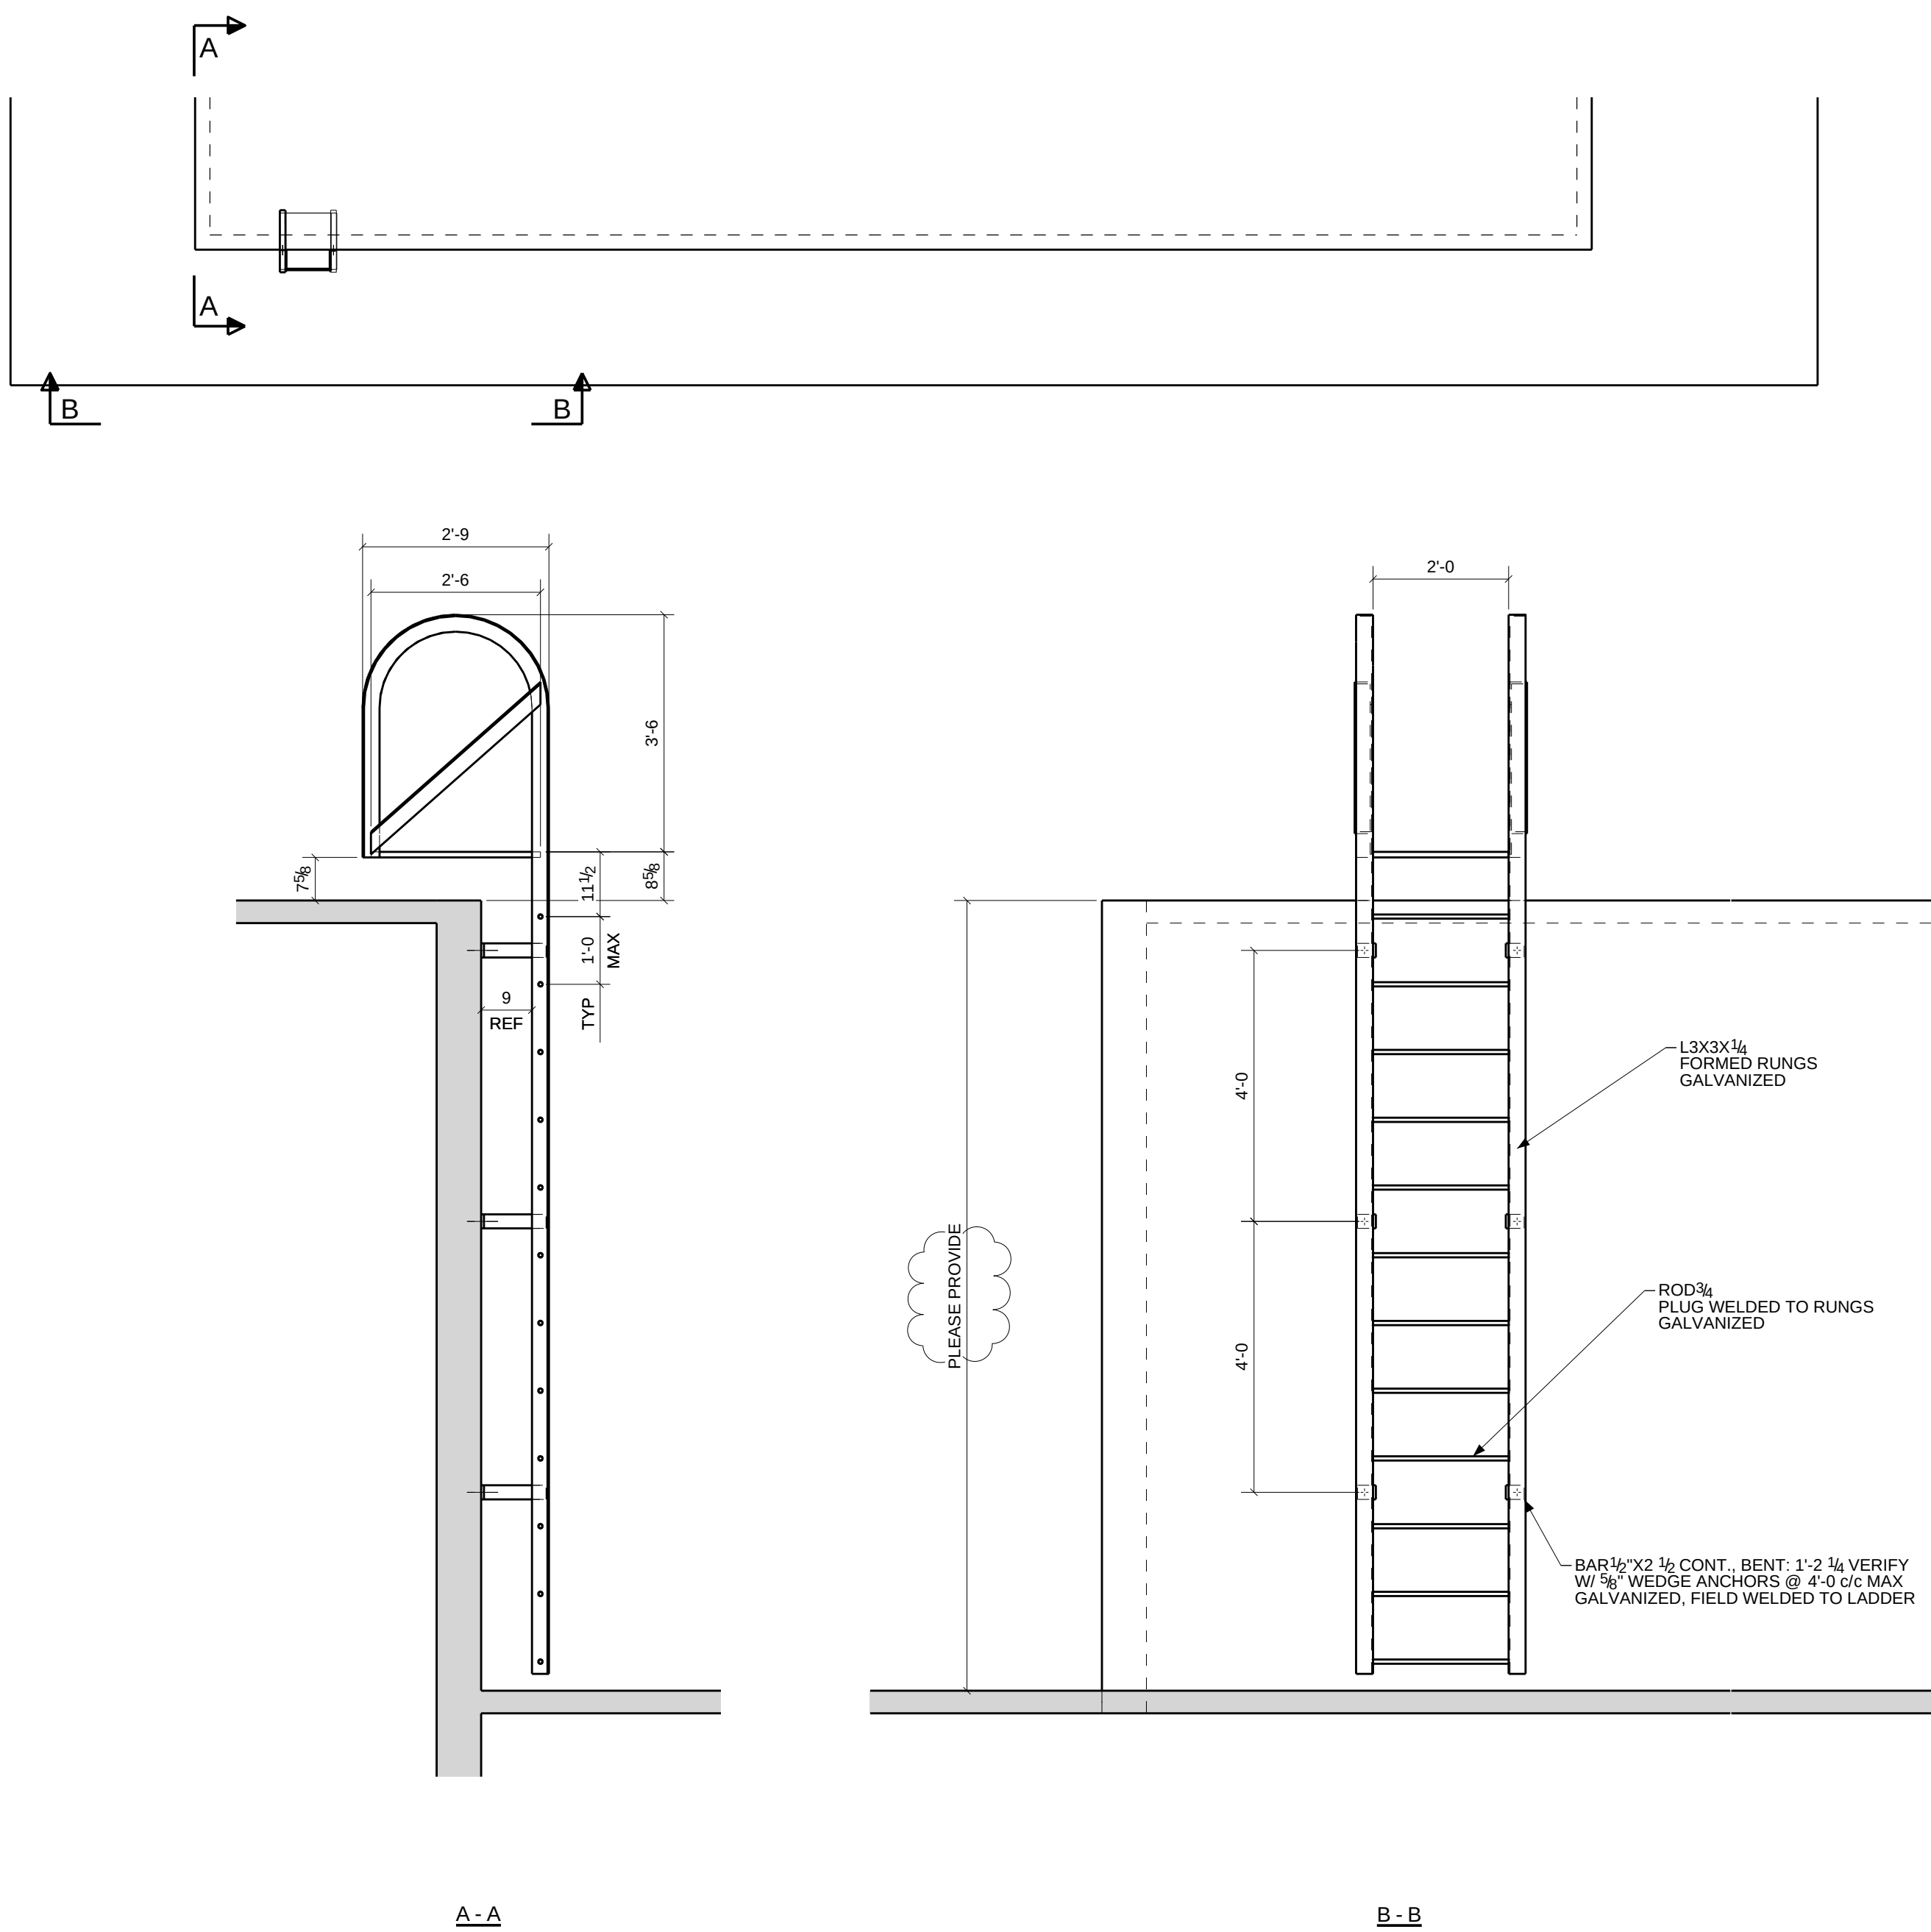


FABRICATOR SHOULD CHECK ALL EXISTING STAIRS & WALLS AND FIELD VERIFY MEASUREMENTS AND MARK UP RETURNED SUBMITTALS TO DETAILER BEFORE RELEASING FOR FABRICATION.

PARTIAL PLAN @ AUDITORIUM ~ EXISTING STAIRS S-6 & S-7: RAILING & LADDER @ EXIST. ROOF
1:72

DRAWINGS PREPARED BY DETAILER FROM INFORMATION CONTAINED IN THE PROJECT DOCUMENTS WITH INSTRUCTIONS FROM THE FABRICATOR. DETAILER IS NOT RESPONSIBLE FOR ANY DESIGN, ENGINEERING OR CODE ISSUES WHICH MAY ARISE FROM THE USE OF THESE DRAWINGS. APPROVALS SHOULD BE OBTAINED FROM THE OWNER, ARCHITECT, ENGINEER, CONTRACTOR, WHICH EVER IS APPLICABLE. THE FABRICATOR SHOULD CHECK THE DETAIL DOCUMENTS FOR CORRECTNESS BEFORE RELEASING FOR FABRICATION. THE USE OF THE DETAILED DRAWINGS FOR FABRICATION CONSTITUTES ACCEPTANCE AND APPROVAL OF THE DRAWINGS, MATERIAL LIST OR CUT LIST, WHICH EVER APPLIES.

This project shall be erected in accordance with Section 7 of the AISC Code of Standard Practice, which includes 7.14 Correction of Errors, that states the following:
The operation of minor quality by inspection, welding, grinding, cutting, and the welding of elements into line with all parts, shall be considered to be normal erection operations. Errors that cannot be corrected using the foregoing means, or that require major changes in member or connection configuration, and/or are prohibited by the erection specifications for design and construction, shall be fabricated by the erector. It is the erector's responsibility to either correct the error or approve the most efficient and economical method of correction to be used by others.
All field welds to be made with E70xx low hydrogen electrodes.

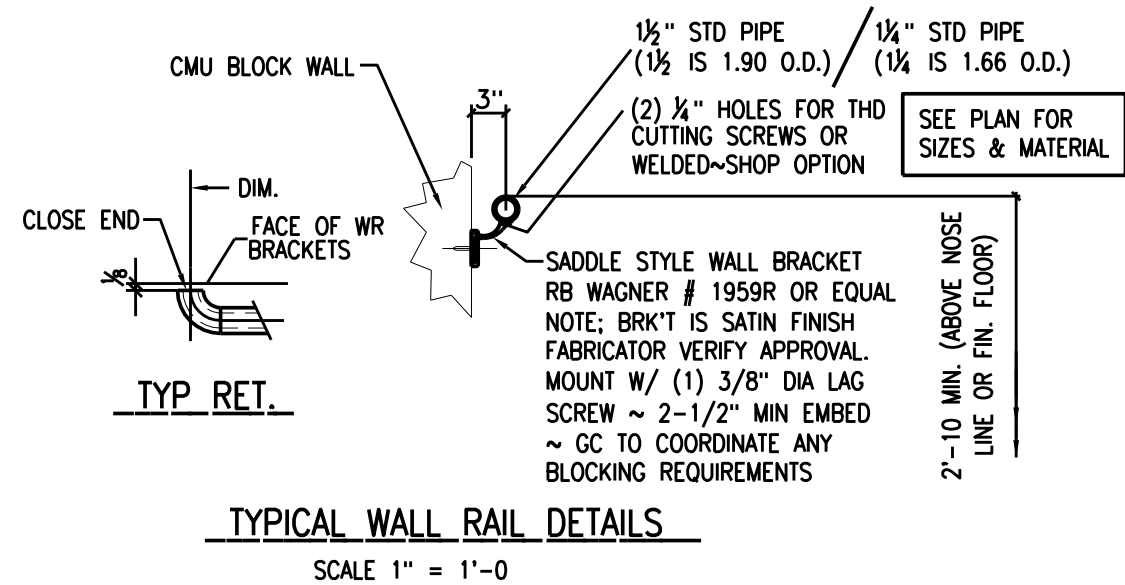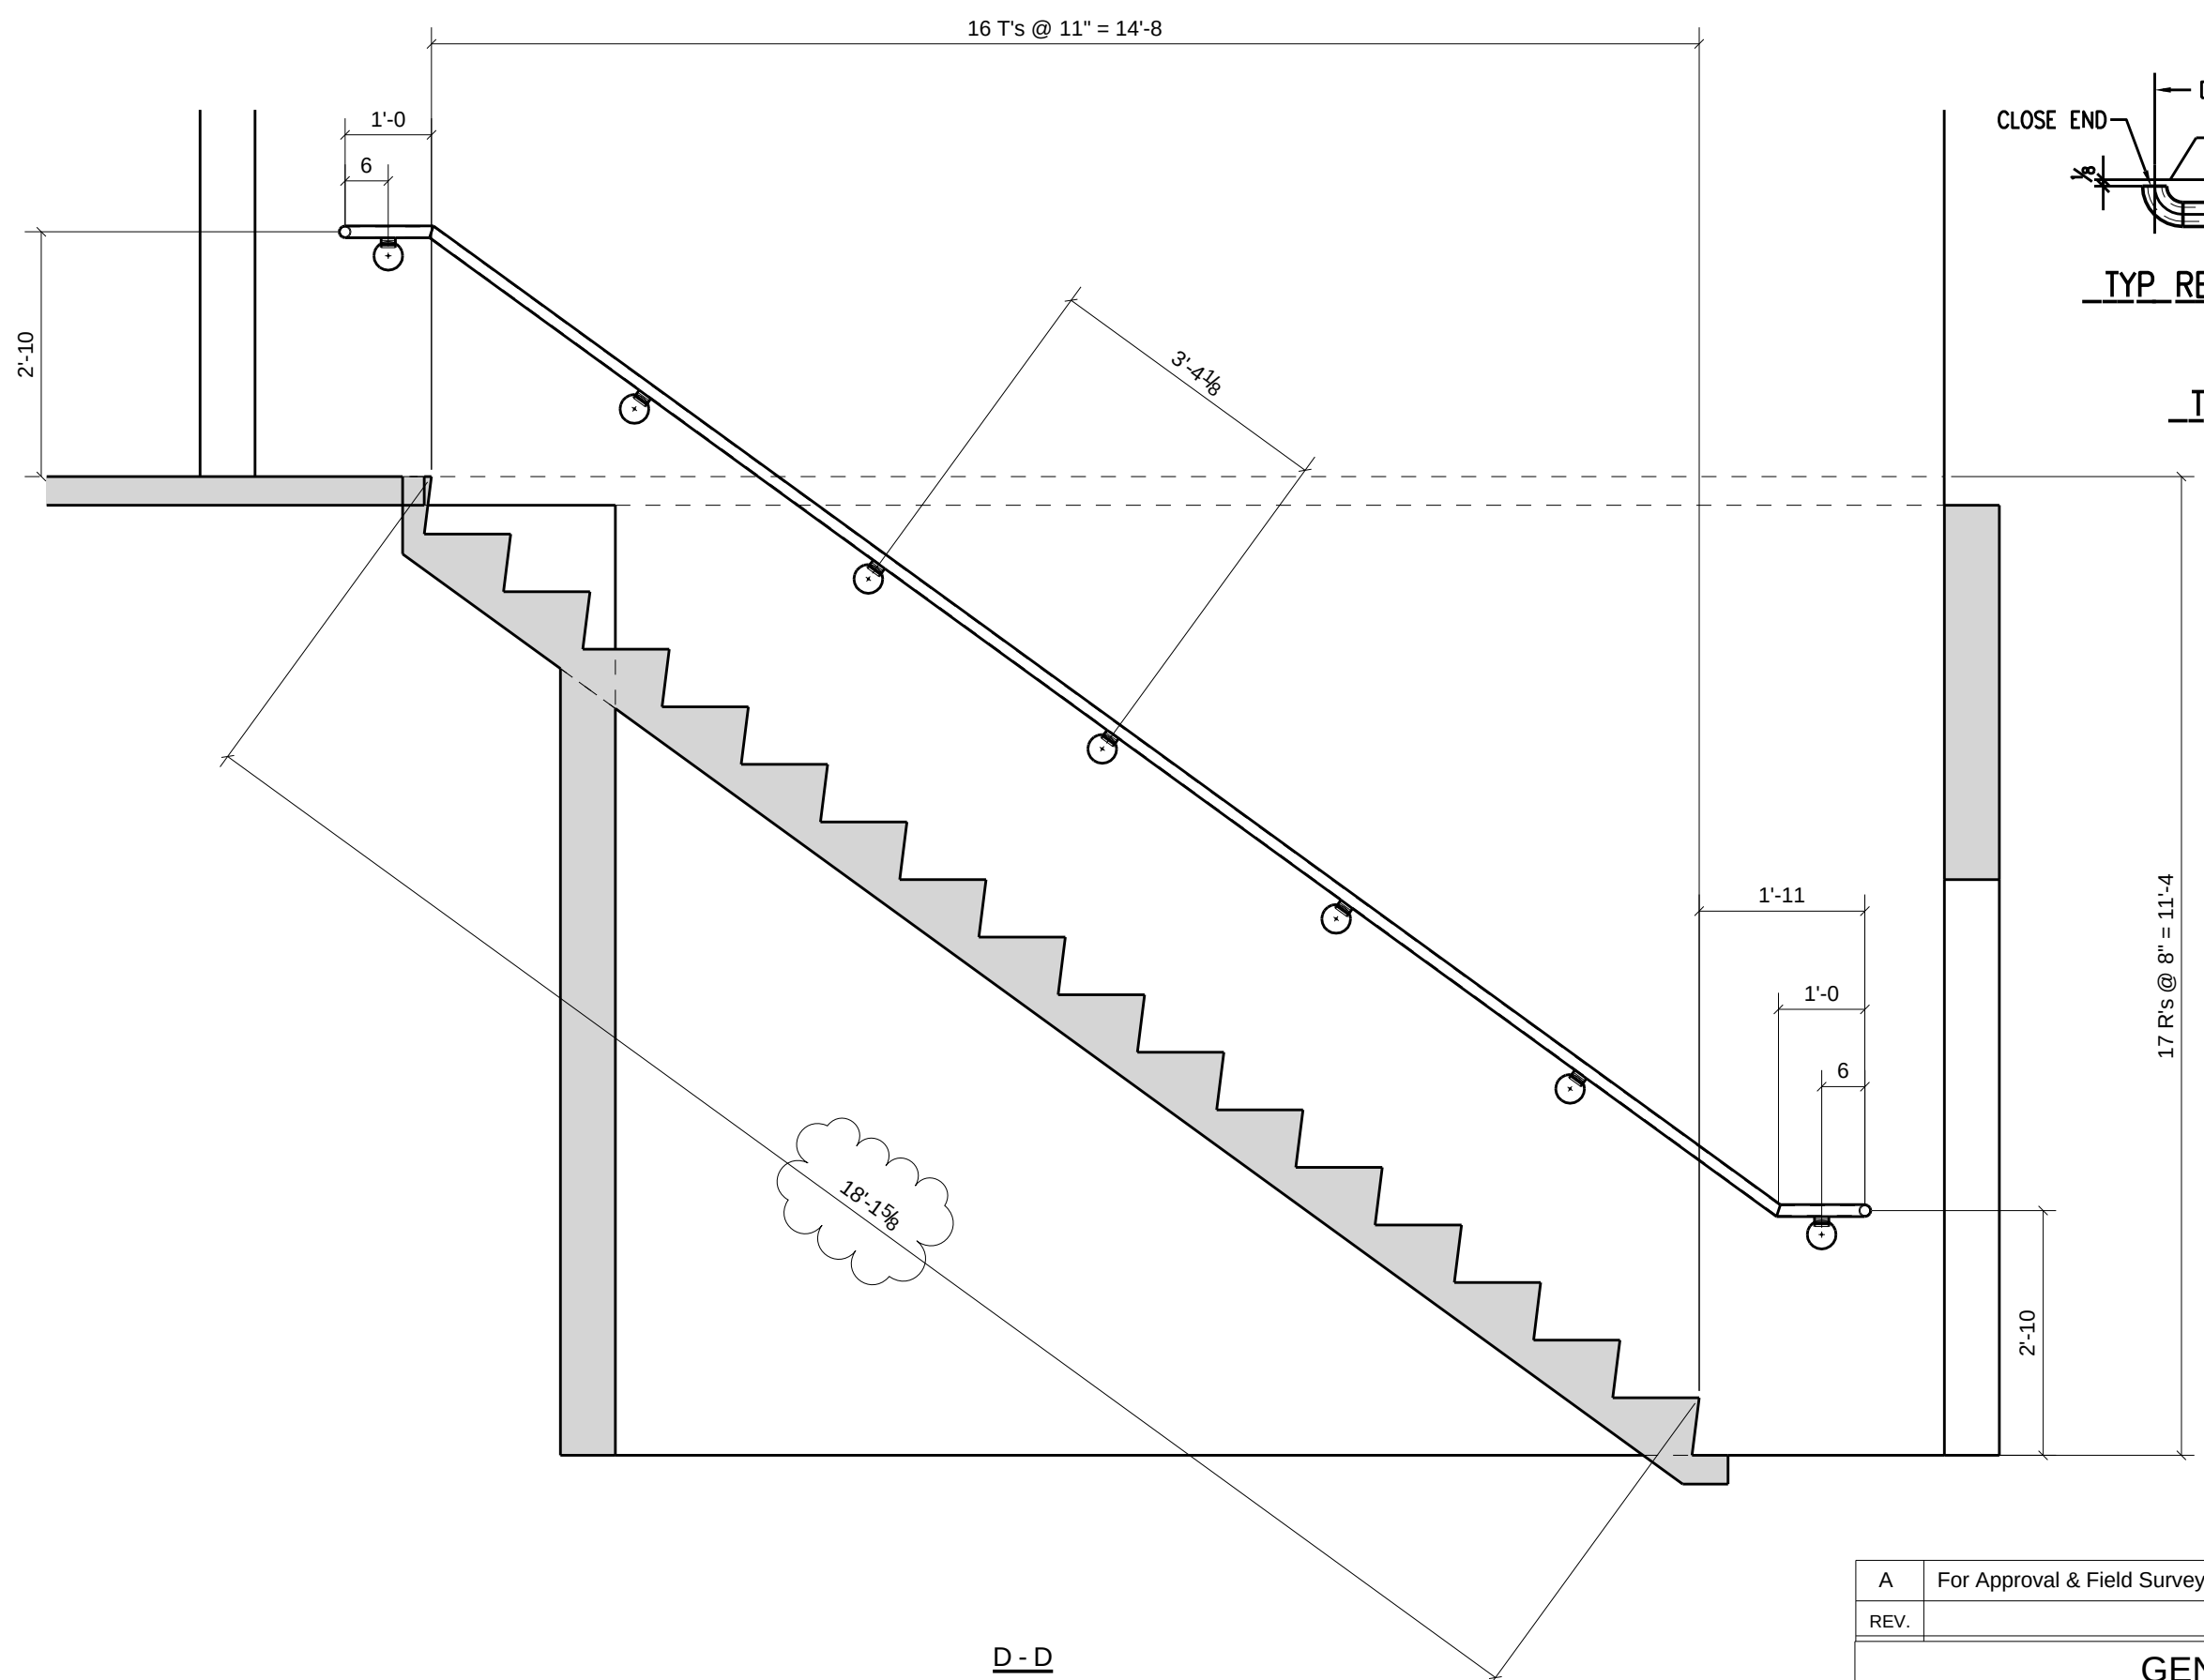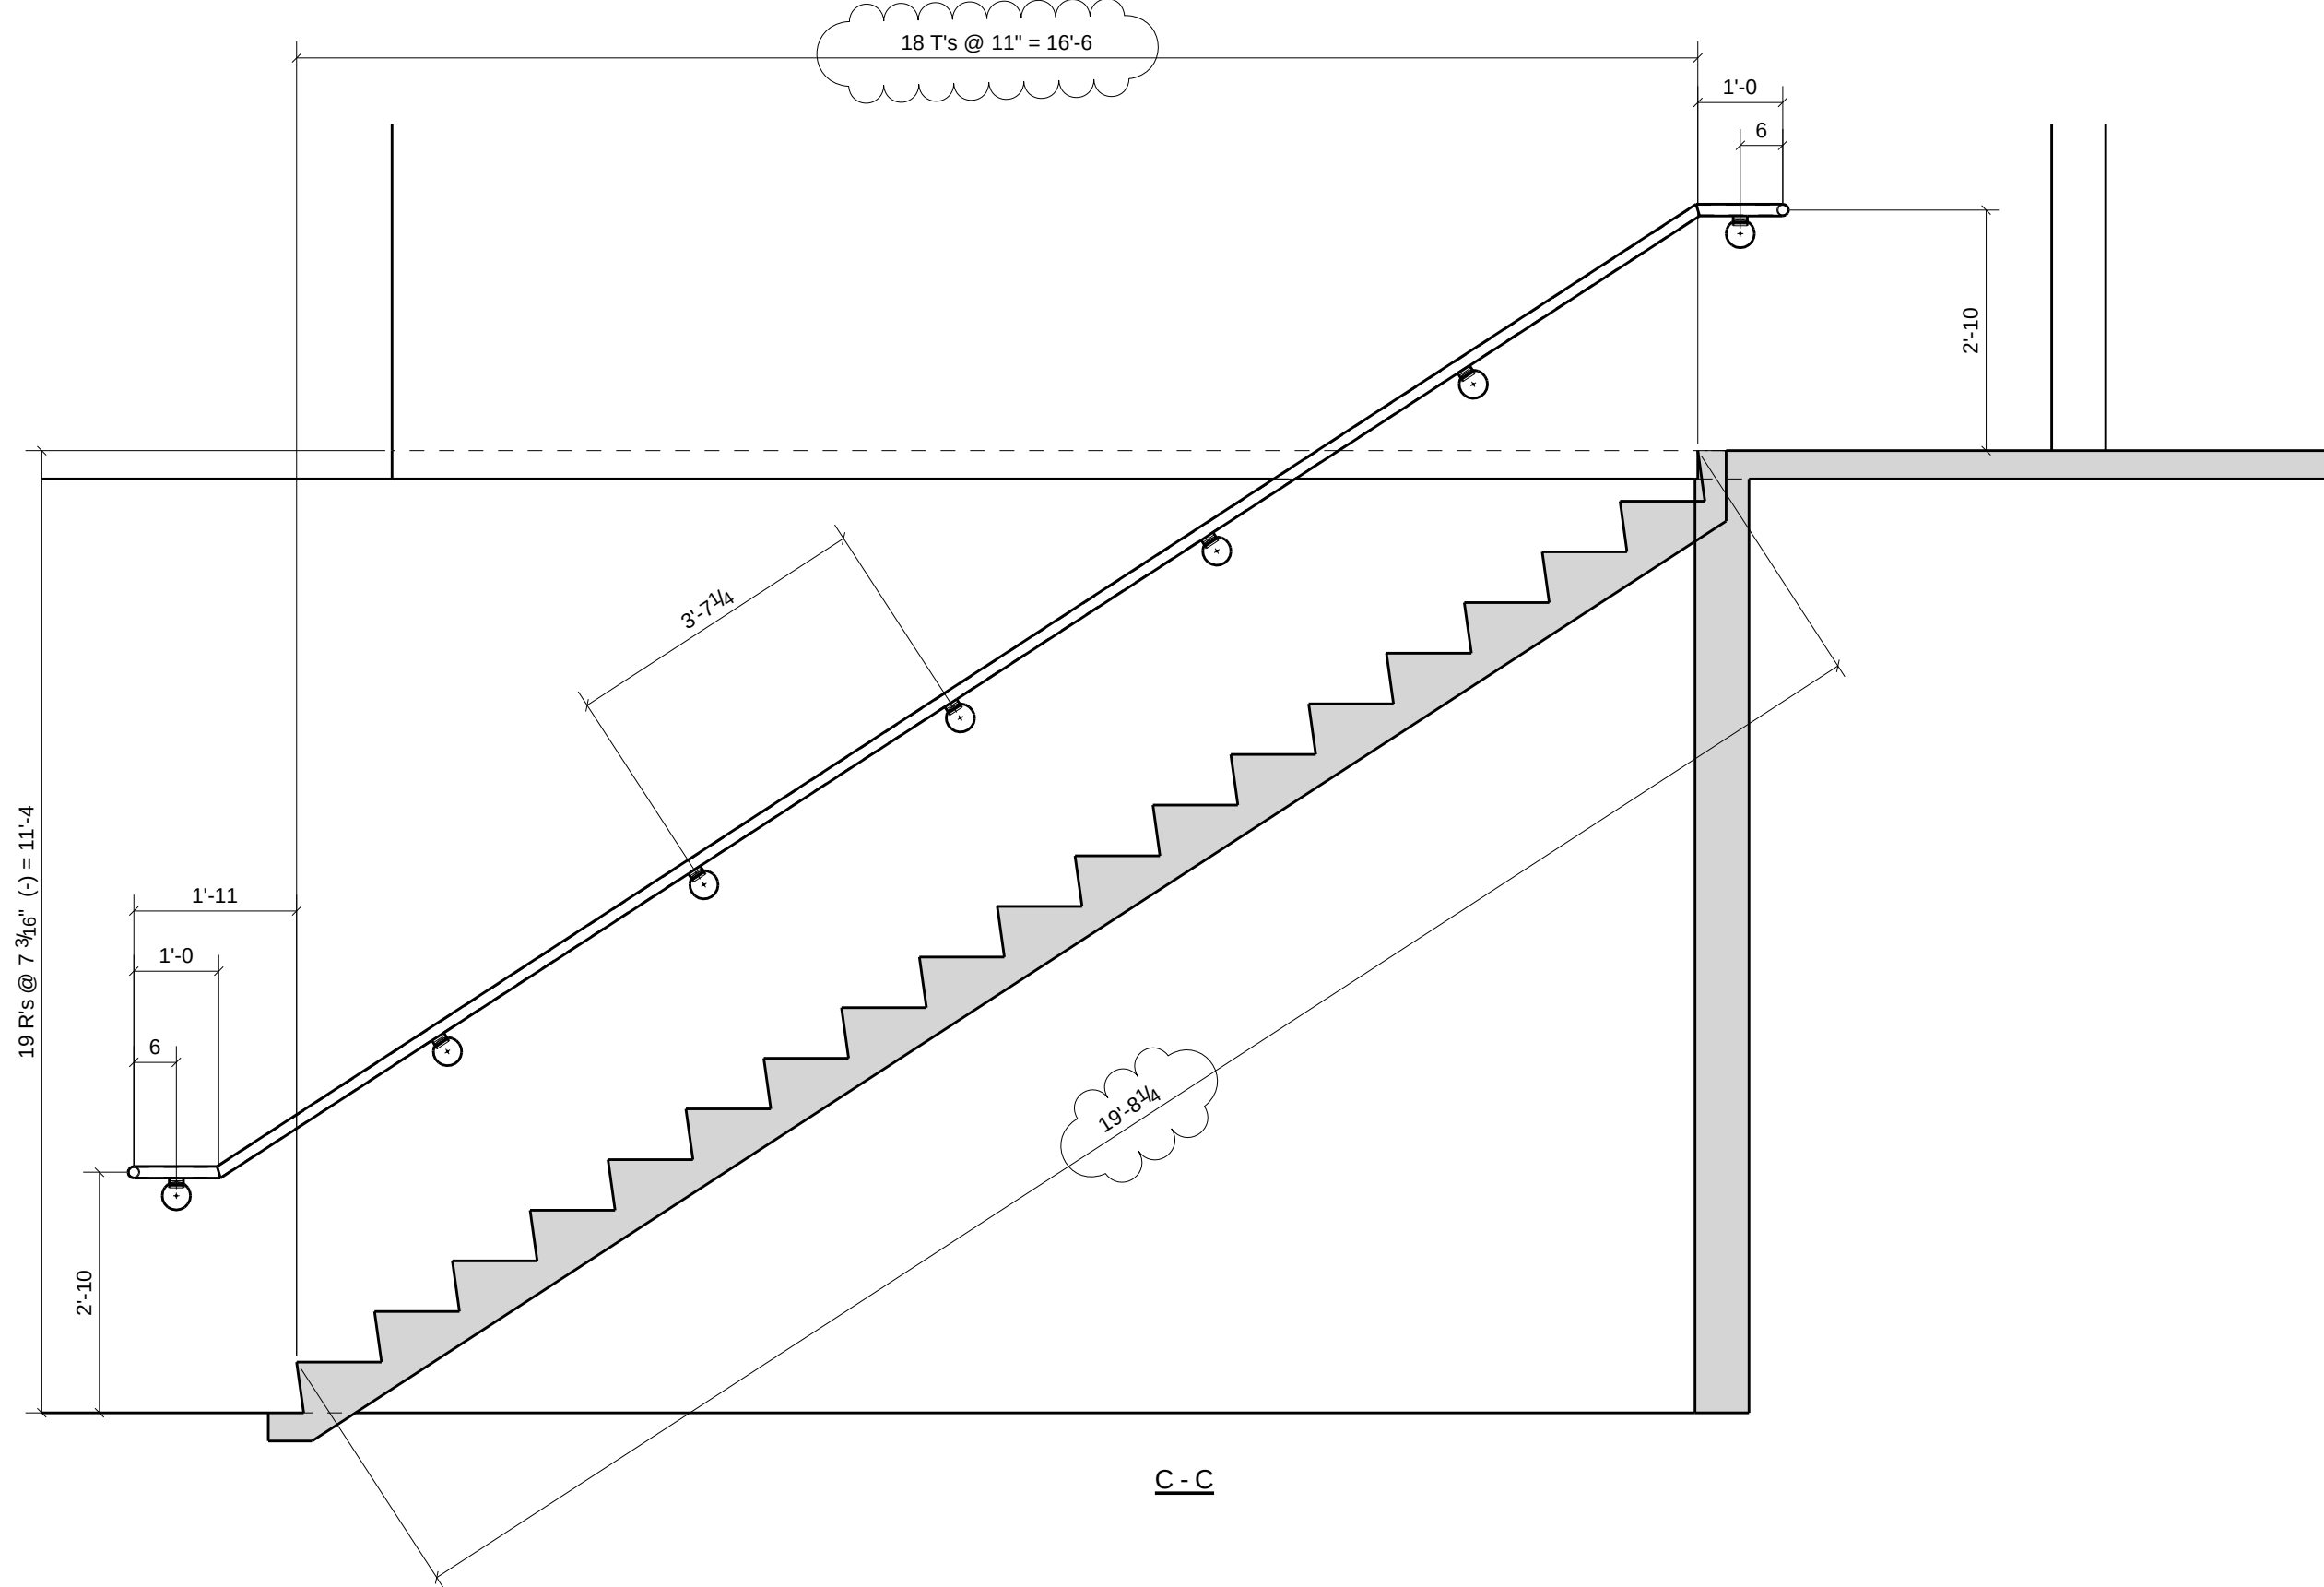

A	For Approval & Field Survey		10/12/18	TMG	TAN			
REV.	DESCRIPTION		DATE	DWN	CHK			
GENERAL NOTES			JOB USE					
			SHOP					
						APPROVAL		
MATERIAL: A992 / A36 UN ELECTRODES: E70XX LH REF. DRG.								
HOLES: 13/16 DIA. UN CONNS: -								
SURFACE PREP. AND PAINT:								
SSPC-SP-2								
GREY PRIMER DEVOE NA-195 (U.N.)								
DESCRIPTION: PLAN ~ STAIRS S-6, S-7, & ROOF LADDER								
PROJ. NAME Hamilton High School Phase III			DRAWN BY TMG					
LOCATION Hamilton City School District - Hamilton, OH			DATE 10/17/2010					
CONTRACTOR GC Contracting ARCH./ENG. SHP			CHKD. BY TAN					
Avenue Fabricating Inc. 1281 Clough Pike Batavia, OH 45103 (513) 752-1911			DATE					
			JOB NO.					
			10-16					
			DRG. No.					
			E114 REV. A					
								